



JOB NO. 780.030 PLOTTED 04/10/07 10:50 am DRAWING: D:\SCAPE\PLANS\SCAR-17 BY: csp

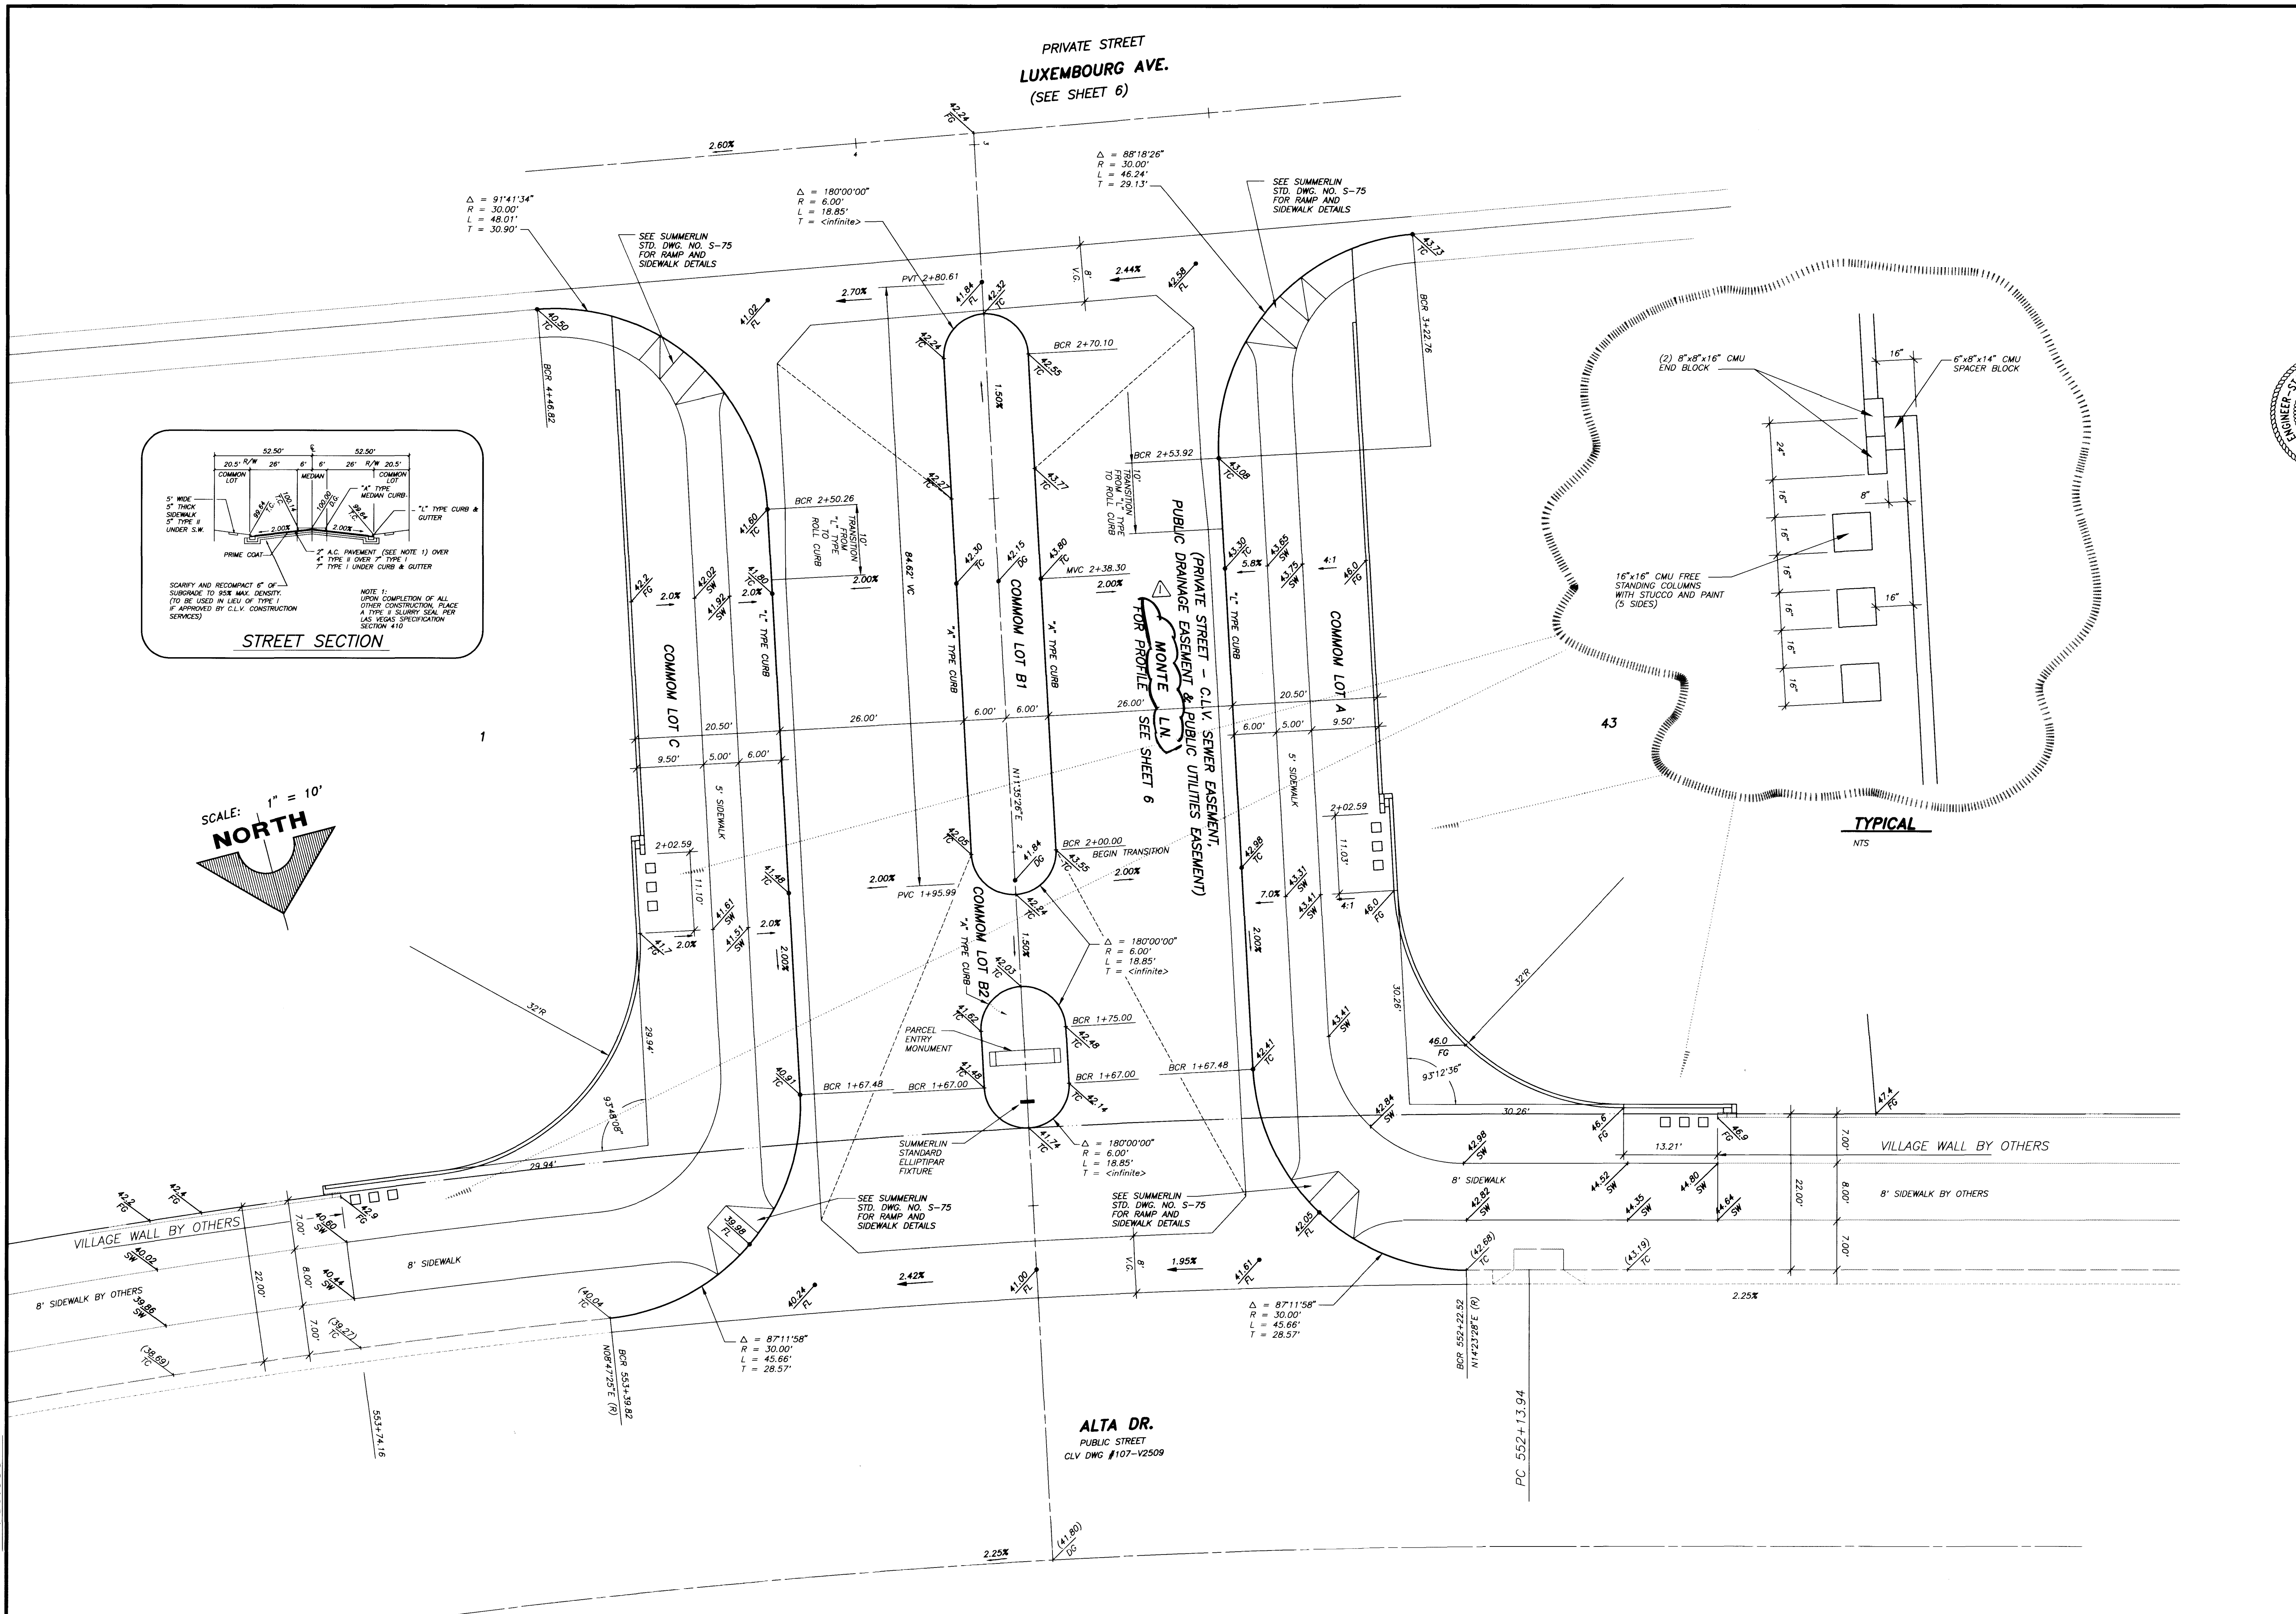

REVISION	DATE	DESCRIPTION	C.L.V. DATE
1	11/14/07	REVISED ST. NAMES	11/14/07
2	11/14/07	REVISED ST. NAMES	11/14/07
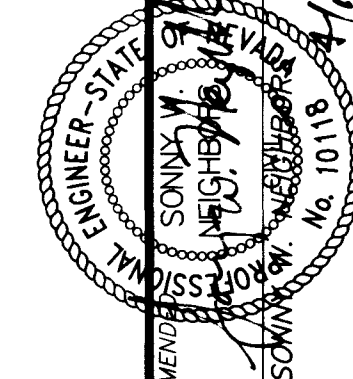

RECOMMENDED BY: SONNY WALLACE, INC. P.E. NO. 10118 DATE 11/14/07
 1555 SOUTH RAINBOW BLVD., LAS VEGAS, NEVADA 89102
 G. C. WALLACE, INC.
 Engineering/Architecture

BEAZER HOMES HOLDING CORPORATION OF NEVADA
 SCARLETT CANYON at SUMMERLIN
 ENTRANCE DETAILS
 SHEET 11 OF 18 SHEETS

107Y-4508

