
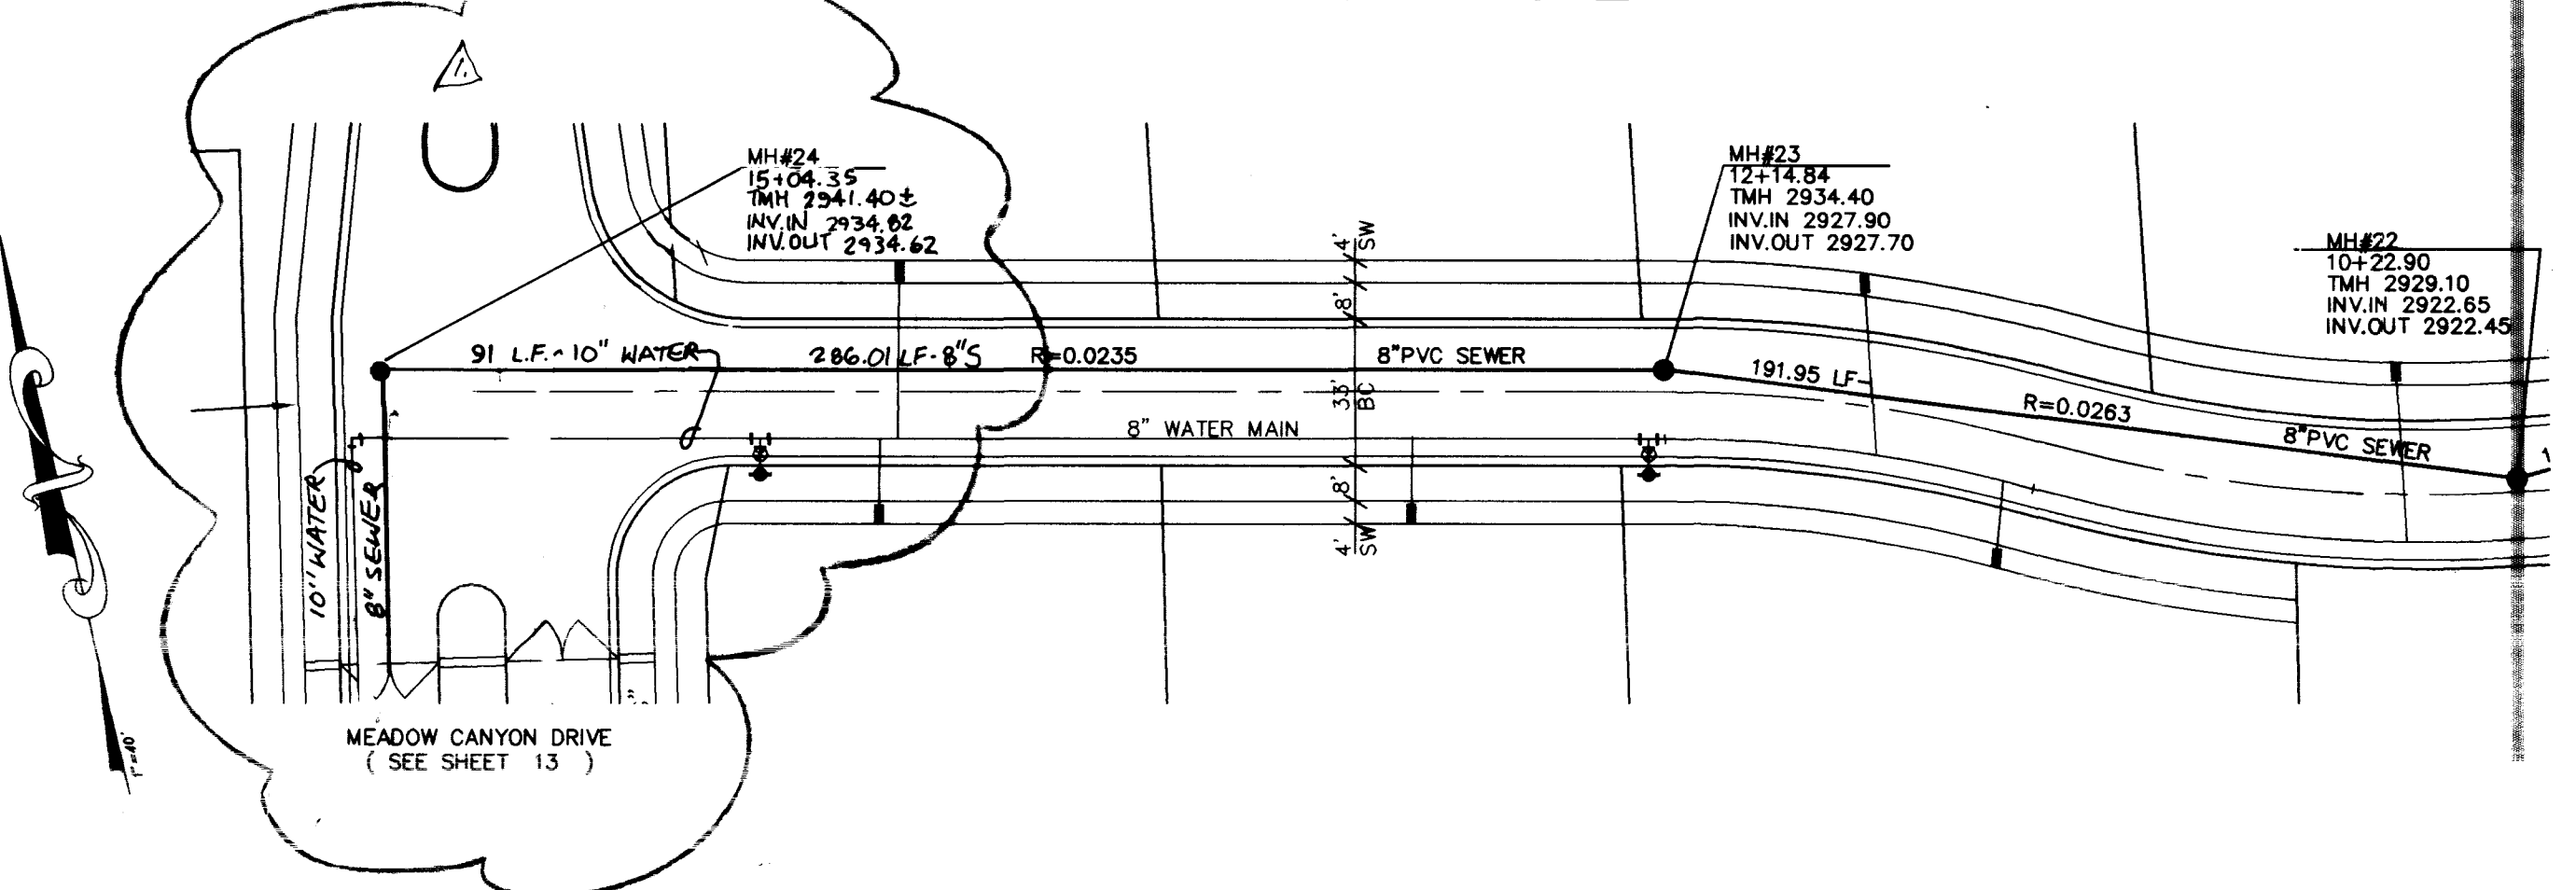


ROCKY MESA LANE (PRIVATE DRIVE AND CLV SEWER EASEMENT)

STONY RIDGE LANE (PRIVATE DRIVE AND CLV SEWER EASEMENT)

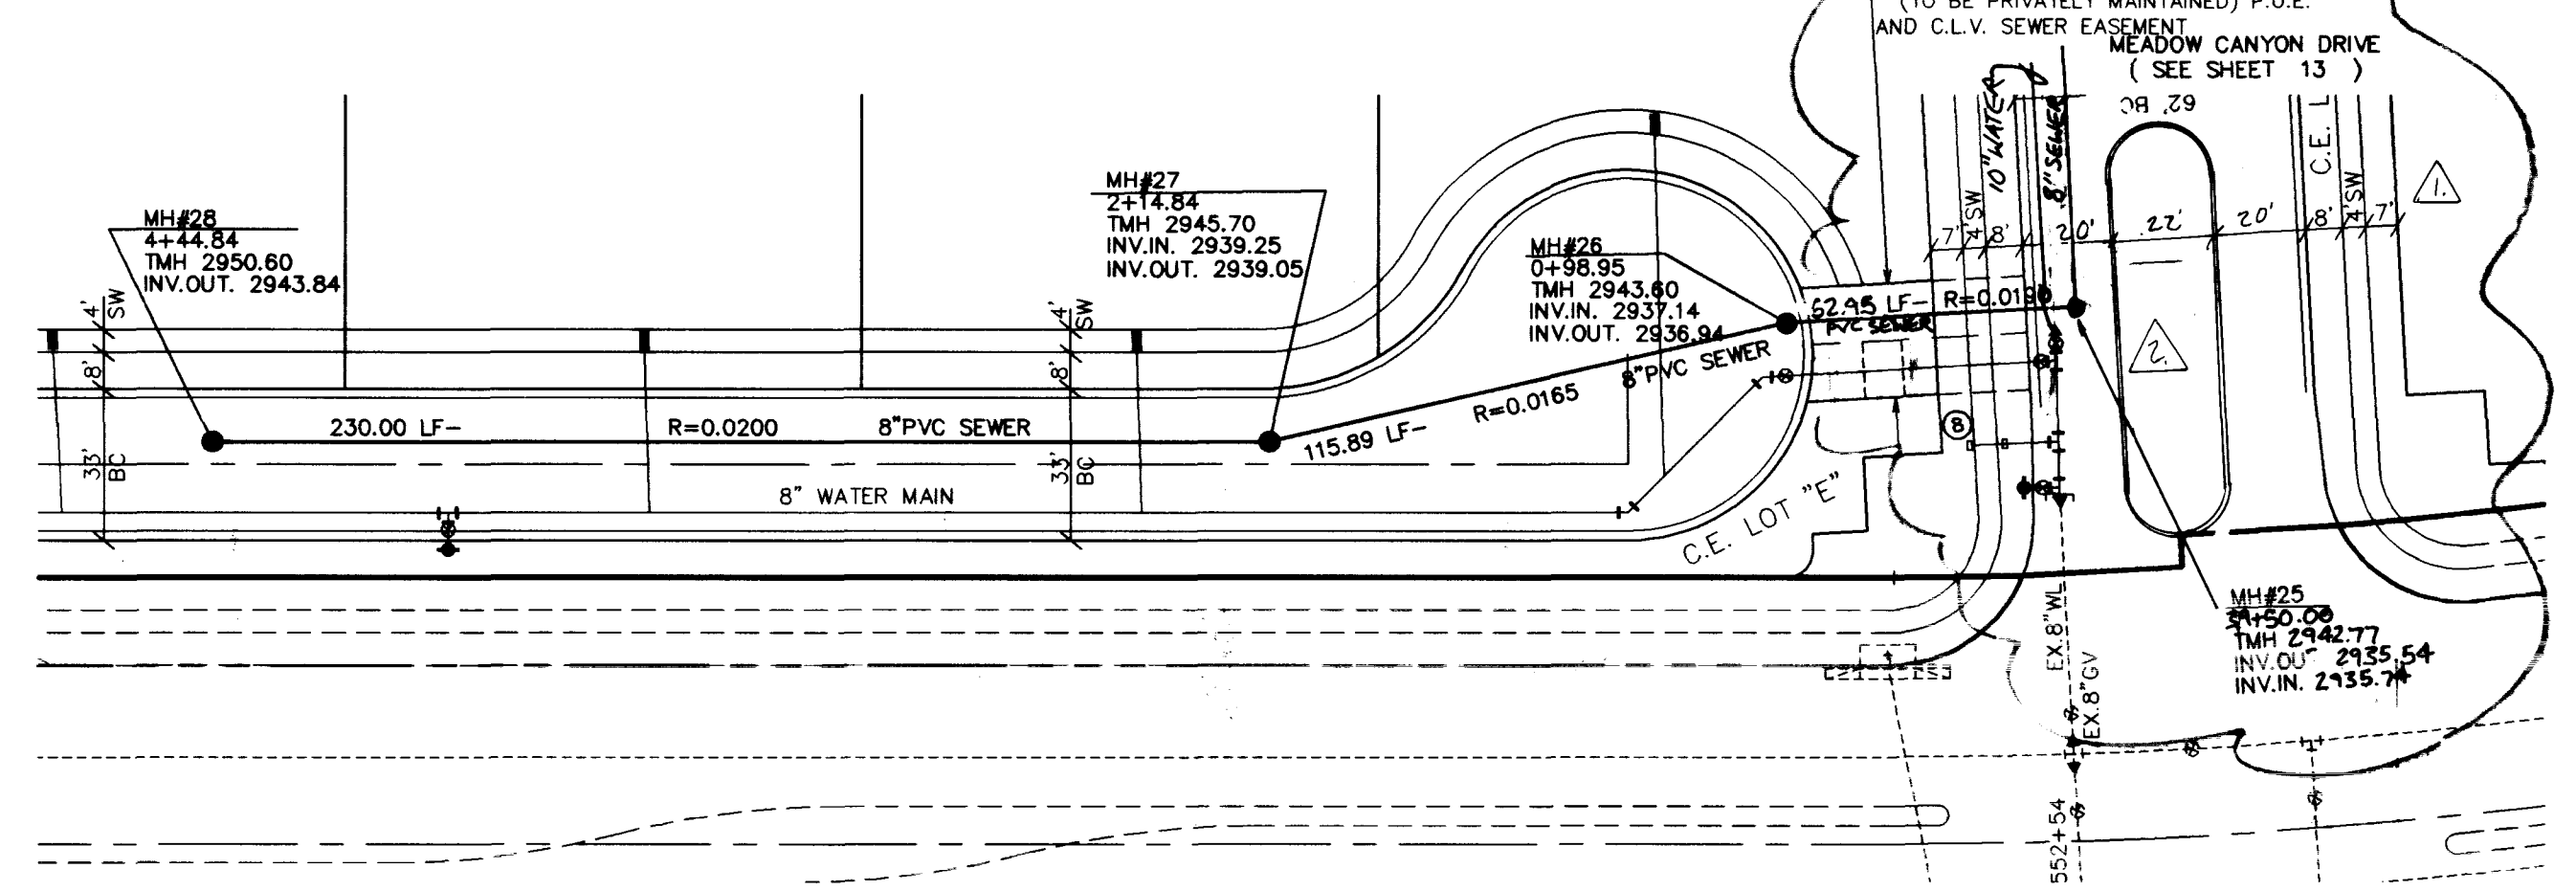

STA. 10+22.90 MATCHLINE - SEE SHEET 14 OF 156


BENCHMARK
 PROJECT DATUM SUMMERLIN
 CLV BENCHMARK NO. CLV0936SES
 RIVET AND PLATE IN TOP OF CURB NORTHEAST RETURN OF
 CHARESTON BOULEVARD AND HUALPAI.
 ELEVATION=2910.05 (SUMMERLIN DATUM)
 ELEVATION=887.6503 METERS(2912.23 FEET)=(NAVD 88 DATUM)

Avoid cutting underground utility lines. It's costly.
Call before you Dig
 1-800-227-2600

Avoid overhead power line contact
Call before you OVERHEAD
 1-702-593-6111

NOTE:
 ALL STATIONING IS BASED ON SEWER LENGTHS FROM MANHOLE TO MANHOLE.


NOTE: CONTRACTOR SHALL VERIFY HORIZONTAL AND VERTICAL LOCATION OF EXISTING UTILITIES AND NOTIFY THE DESIGN ENGINEER IMMEDIATELY OF ANY DISCREPANCIES PRIOR TO CONSTRUCTION.

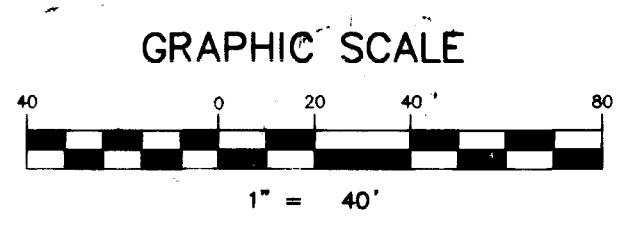

REV	DATE	BY	REVISION
3	5-98	MDM	REV ISLAND LOCATION
2	12-19-97	MDM	MOVE WATER & SEWER LINES


BRENTWOOD MEMBERS, L.L.C.
 CITY OF LAS VEGAS, NEVADA

CONSULTING ENGINEERS • PLANNERS • LAND SURVEYORS
 2727 SOUTH RAINBOW BOULEVARD
 LAS VEGAS, NEVADA 89102-5148 PHONE (702) 873-7550 FAX (702) 362-2597

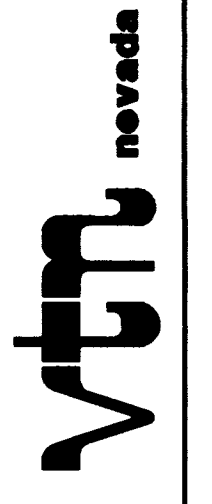

SEWER PLAN & PROFILE
STONY RIDGE LANE
ROCKY MESA LANE

STAR CANYON ESTATES
 PARCEL "P-Q"-SUMMERLIN VILLAGE 3

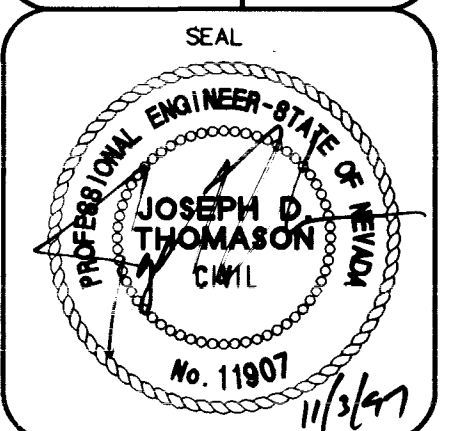


WO NO. **5165**
 BY **CG/DLG**
 DATE **MAY, 1997**
 SCALE HORIZ. 1"=40'
 VERT. 1"=4'
 SHEET **15** OF 15 SHEETS


H:\CAD\LAND\5165\516555P.dwg JUN 30 12:56:43 1997 PLOTTED BY TFA

7034

307Y-4526

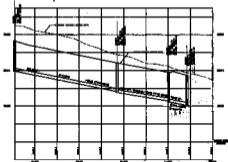


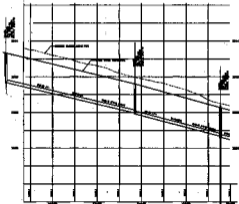














SEWER PLAN & PROFILE
 STORY RIDGE LANE
 ROCKY MESA LANE
 STAR CANYON ESTATE
