


SUMMERLIN

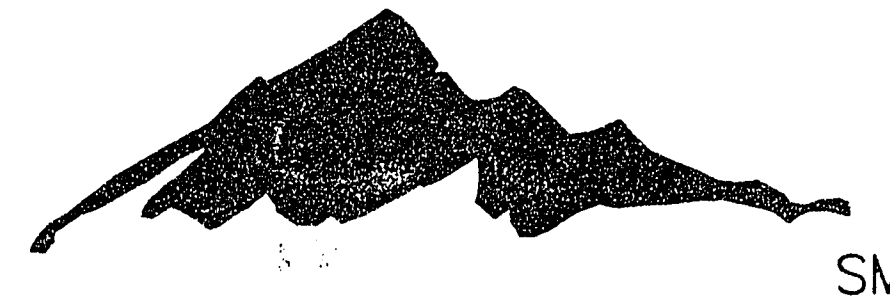

VILLAGE 11/12 THE ARBORS UNIT 2A IMPROVEMENTS

SAGEBERRY DRIVE FROM 900' W/O HUSITE DRIVE TO HUSITE DRIVE
LAURELGLEN DRIVE FROM HUSITE DRIVE TO 575.44' N/O ACACIA TREE DRIVE
ACACIA TREE DRIVE FROM LAURELGLEN DRIVE TO ANASAZI DRIVE
HUSITE DRIVE FROM ALTA DRIVE TO LAURELGLEN DRIVE
GREENMOOR LANE FROM HUSITE DRIVE TO ANASAZI DRIVE
ALTA DRIVE FROM HIGH SCHOOL PARCEL ENTRY TO TOWN CENTER DRIVE
ARBORDALE PLACE


1996

DEVELOPER

HOWARD HUGHES PROPERTIES,
LIMITED PARTNERSHIP, a
Delaware limited partnership.
By its sole general partner,
The HOWARD HUGHES CORPORATION,
a Delaware corporation

1645 VILLAGE CENTER CIRCLE, SUITE 200
LAS VEGAS, NEVADA 89134
OFFICE PHONE NO. (702) 791-4300
OFFICE FAX NO. (702) 791-4450

ENGINEER

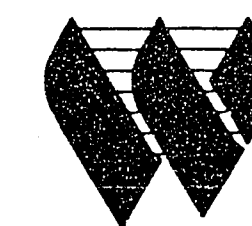

G.C. WALLACE, INC.
Engineering/Architecture
1555 SOUTH RAINBOW BLVD./LAS VEGAS, NEVADA 89102

- 1/08/97 ADD WATER STUB TO PARCEL NN-1 (FORMERLY PARCEL MM), ADJUST BULL NOSE AND D.I. DUE TO P.S. ENTRY ADJUSTMENT. DELETED WATER STUB TO PARCEL NN-2. SEE SHEETS 3, 6, 10, 11, 52, 54, 57, 58
- 11/25/96 MODIFIED UTILITIES AND MOVED & MODIFIED ENTRY TO PARCELS A-1 AND A-2 FROM STA 11+98.68 TO 12+78.28. ADJUSTED ARBORDALE PROFILE FROM 14+00 TO 15+98.75. SEE SHEETS 5, 7, 8, 9, 41, 42, 43, 47, 55, & 62
- 09/16/96 MOVE 12" WATER STUB TO PARCEL E ON GREENMOOR LANE FROM STA 19+86.00 TO 23+70.25. SEE SHEETS 36, 37, 55
- 08/23/96 MOVE FIRE HYDRANT ON HUSITE DRIVE FROM STA 17+50.00 TO 17+12.00. SEE SHEET 24
- 08/23/96 REVISED WATER STUB TO PARCEL ES-2 FROM STA 163+12.81 TO 165+29.50 AND DELETED 8" SEWER STUB. SEE SHEETS 23, 50, 53, 55
- 08/22/96 DELETED SEWER LATERAL ON HUSITE DRIVE TO PARCEL Y STA 165+56.80. SEE SHEET 51
- 08/22/96 REVISED DESIGN GRADE AND ELEVATIONS FROM STA 156+29.63 TO 177+18.16. SEE SHEETS 21, 22, 23, 24, 25, 28, 45, 46, 50, 51, 54
- 08/07/96 REMOVED WATER STUB TO H.S. ADD WATER STUB TO PARCEL MM. SEE SHEETS 8, 11
- 08/07/96 REVISED STORM DRAIN, SEWER AND WATER STUBS TO PARCEL P. SEE SHEETS 7, 8, 9, 30, 31
- 08/07/96 REVISED WATER STUB TO PARCEL Z AND CH-2. SEE SHEETS 8, 21, 22, 23
- 07/03/96 REVISED AC PAVEMENT FROM 2' TO 3". SEE SHEETS 57, 58
- 07/03/96 REVISED SEWER AND STORM DRAIN LATERALS INTO PARCEL C. SEE SHEET 43
- 07/03/96 REVISED TYPE 'B' D.I. TO TYPE 'C' MODIFIED D.I. SEE SHEETS 10, 15, 17, 18, 44, 45

VILLAGE 11/12 THE ARBORS - UNIT 2A

FINAL SUBMITTAL

SHEET 1 OF 64