


Job No. 62011.212

November 25, 1996 2:37:07 a.m. Drawing: C:\DWG\11-12\12A\2A-SEWER.DWG

Xrefs: MSTR-UTL.DWG

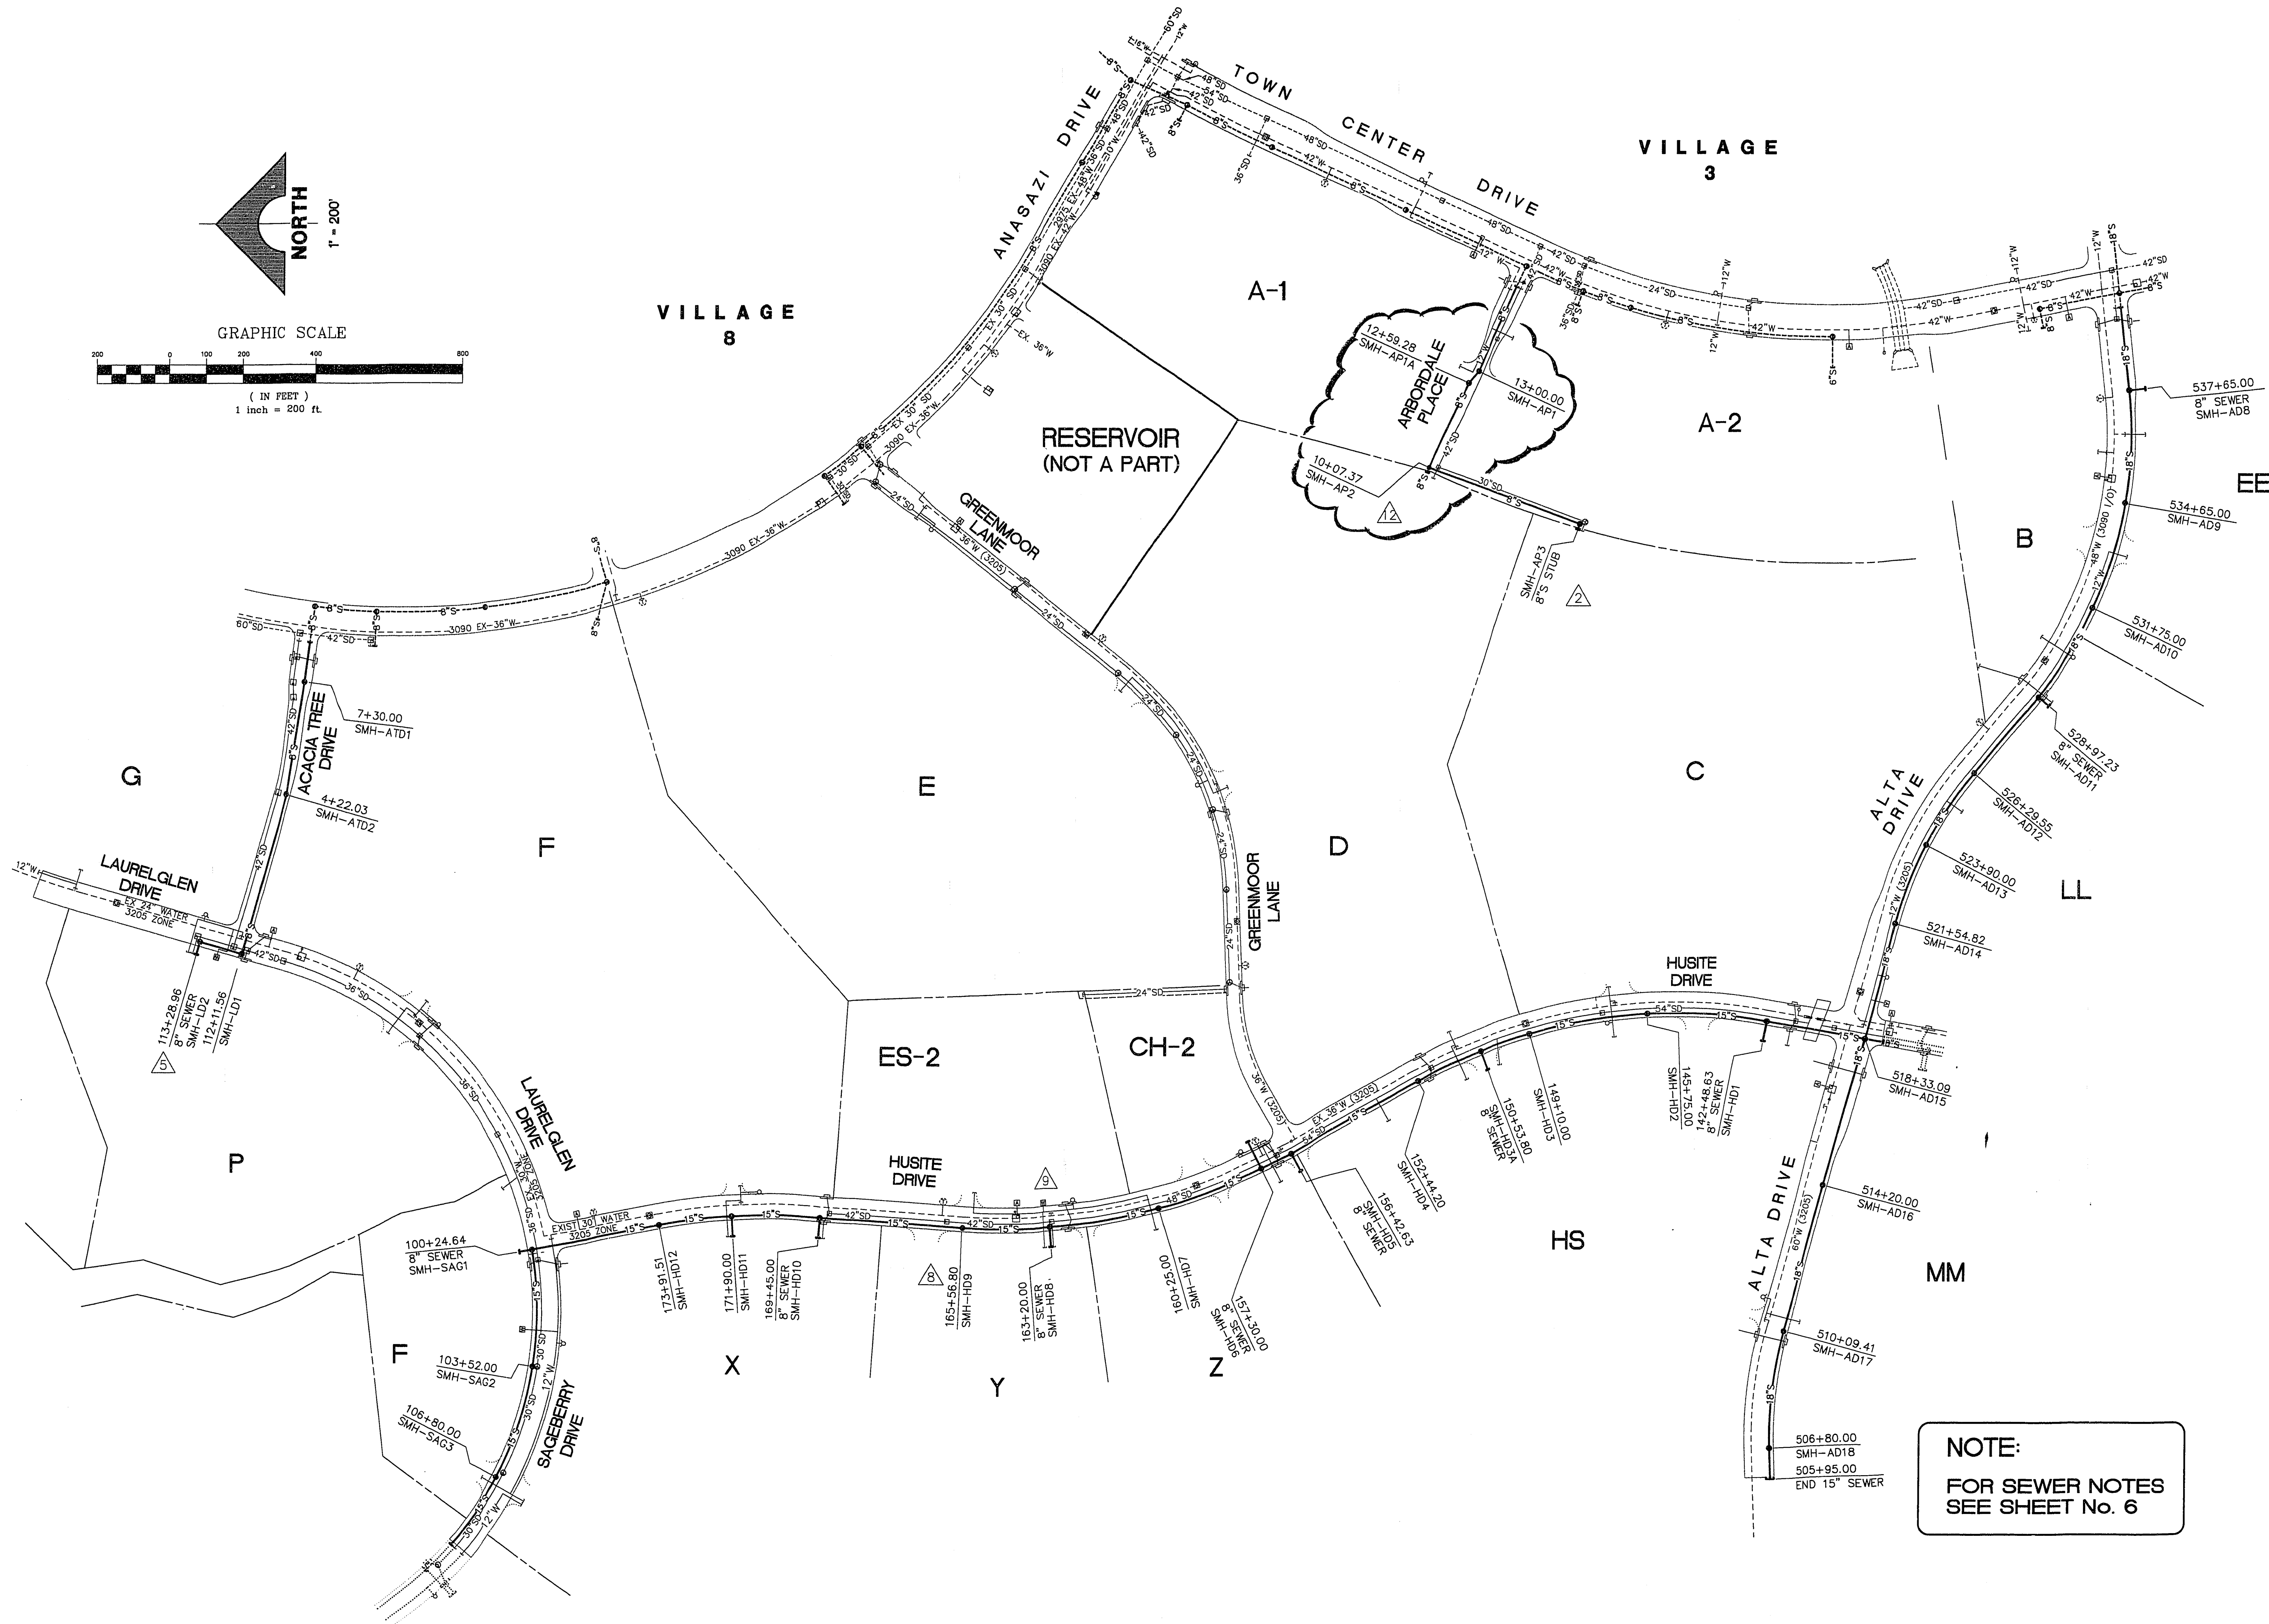

NOTE:
FOR SEWER NOTES
SEE SHEET No. 6

11/25/96 MODIFIED UTILITIES AND MOVE & MODIFY ENTRY TO PARCELS A-1 & A-2 FROM 11+19.68 TO 12+78.28

NO.	DATE	DESCRIPTION	APPROVAL
1	11/25/96	DELETED SEWER LATERAL TO PARCEL ES-2	BT
2	11/25/96	DELETED SEWER LATERAL TO PARCEL Y AT STA 105+56.80	BT
3	11/25/96	REVISED SEWER STUB TO PARCEL P	BT
4	11/25/96	REVISED SEWER STUB TO PARCEL C	BT

RECOMMENDED BY
CHRISTOPHER W. ANDERSON

DATE
11/25/96

BY
G.C. WALLACE, INC.

STATE OF NEVADA
REGISTERED PROFESSIONAL ENGINEER
CIVIL
NO. 5071
G.C. WALLACE, INC.

1595 SOUTH RAINBOW BLVD./LAS VEGAS, NEVADA 89102

SUMMERLIN

VILLAGE 11/12 THE ARBORS - UNIT 2A

MASTER UTILITY SEWER PLAN

SHEET

9

SHT 9 OF 64

FINAL SUBMITTAL