
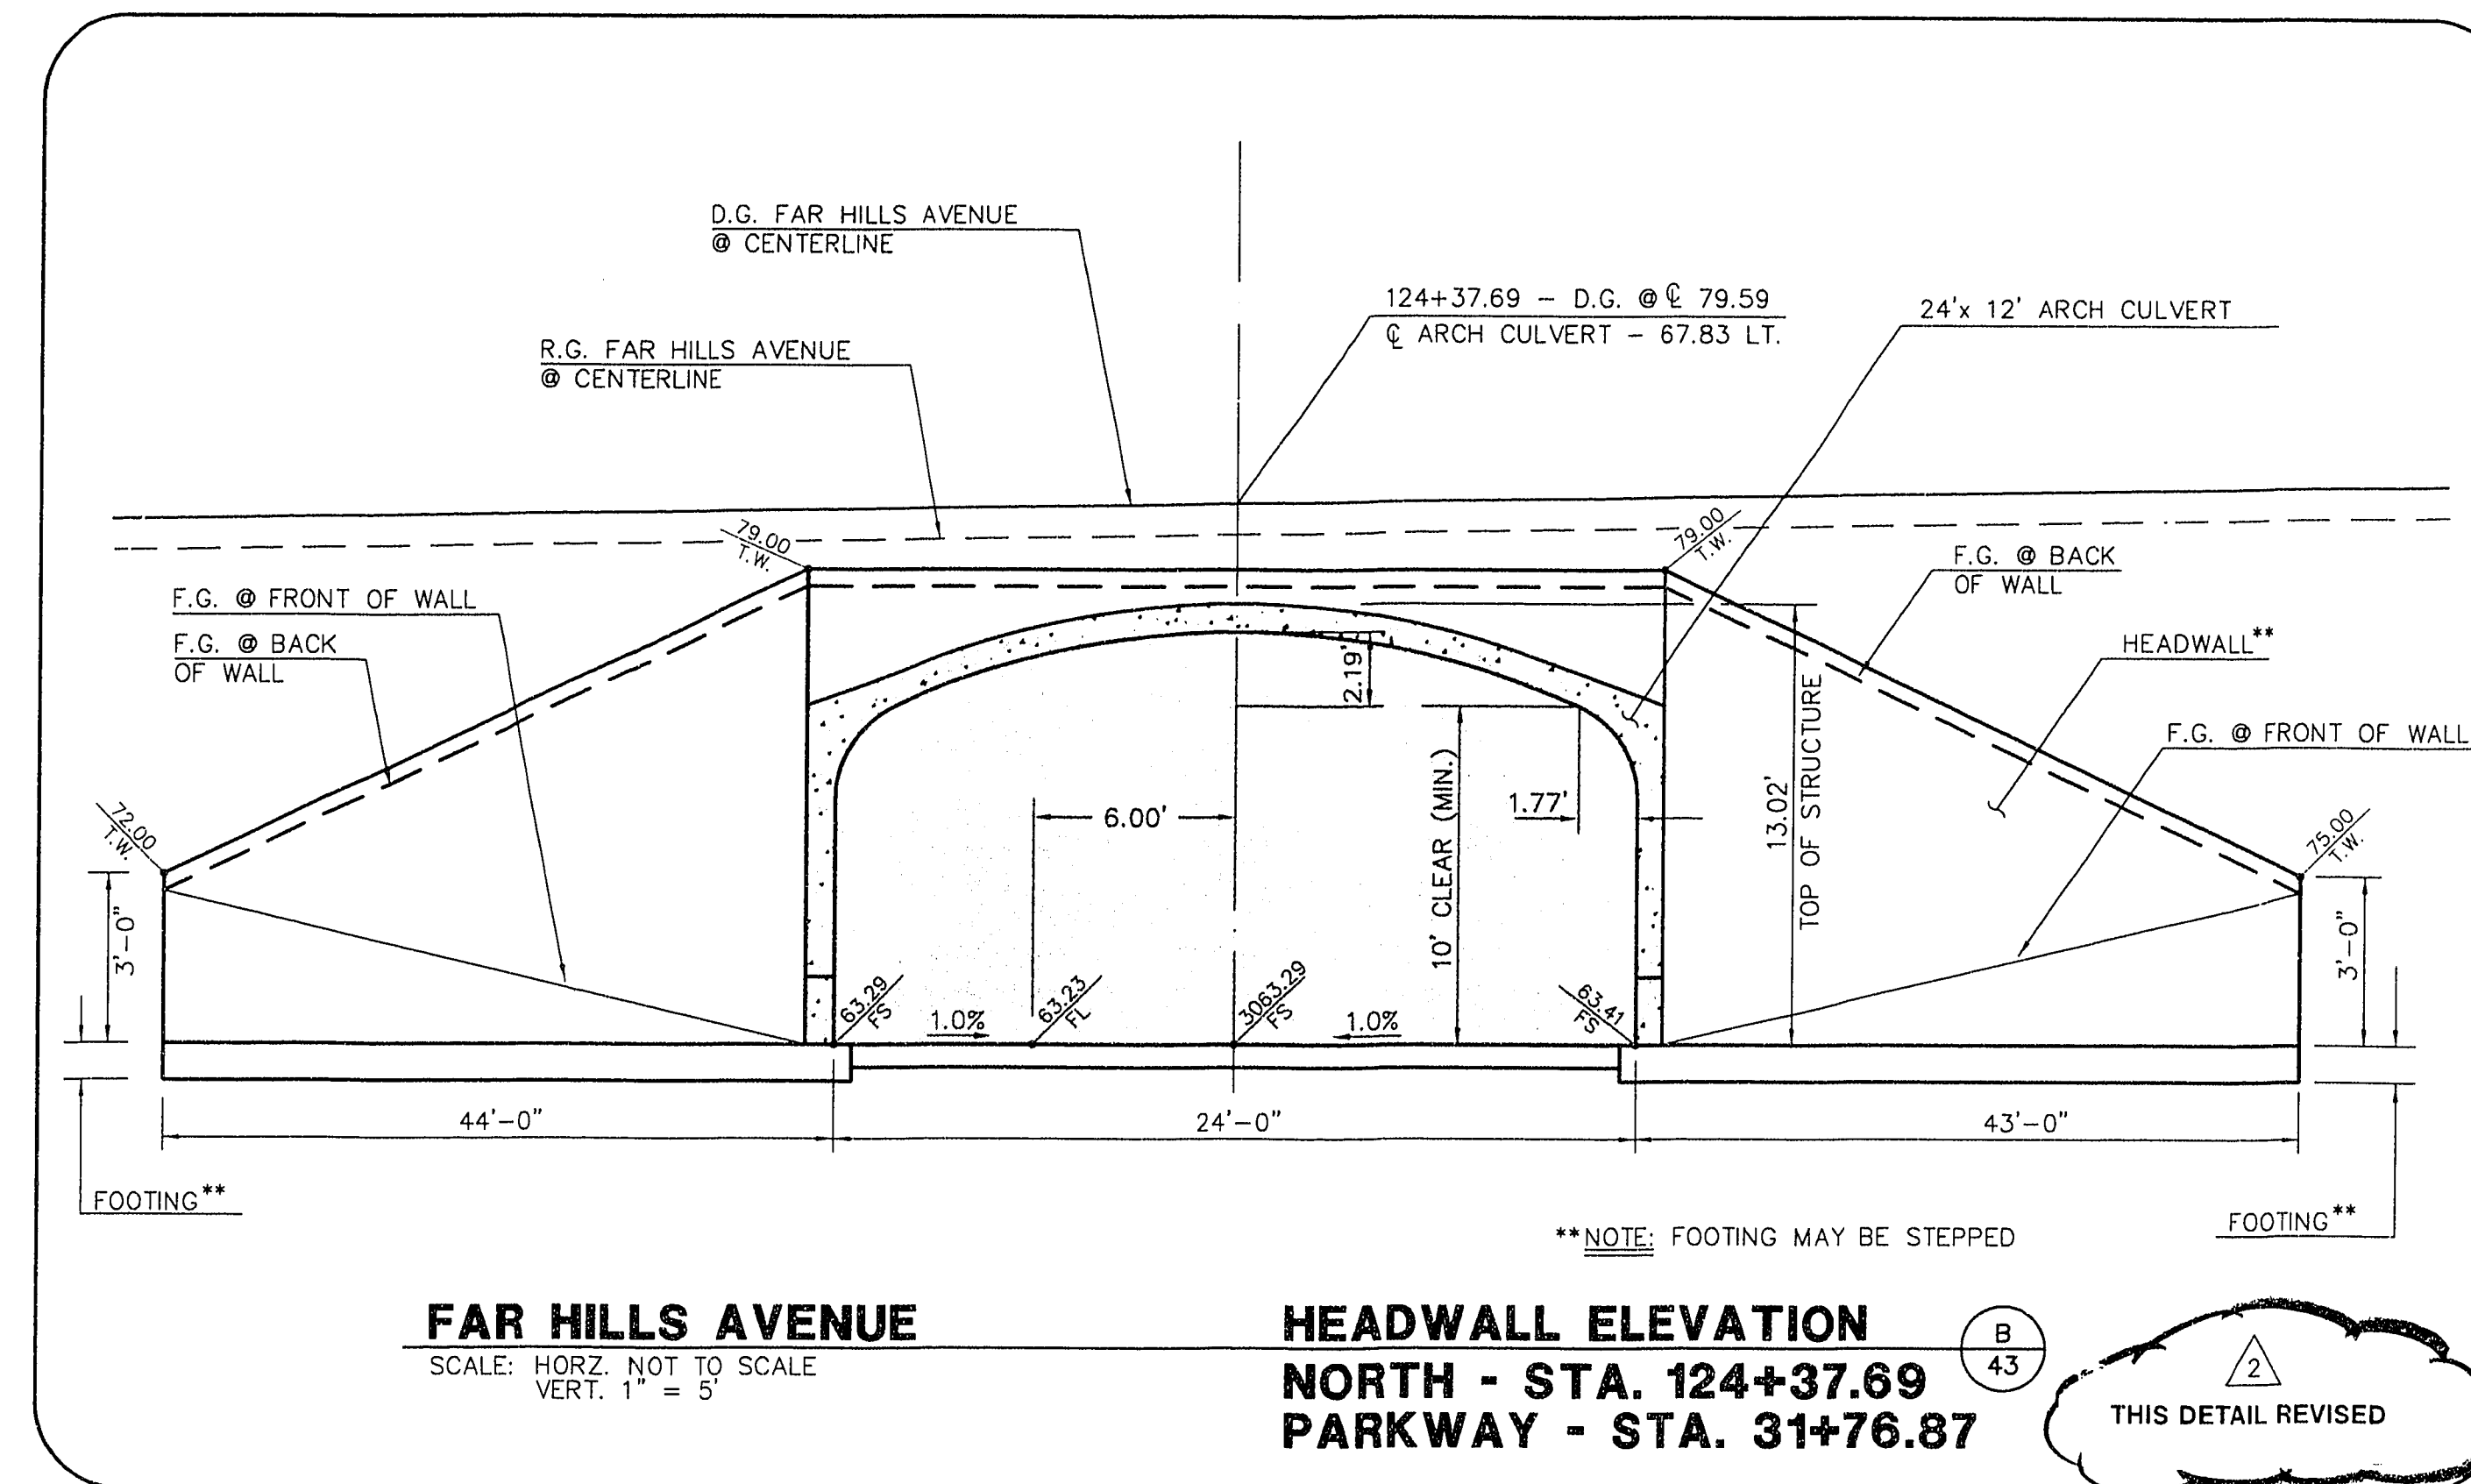




November 11, 1996 5:45:18 p.m. Drawing: C:\DWG\111-12\UNIT-2B\PAKWAY\FCB-SEC.DWG

JOB NO. 62011.213

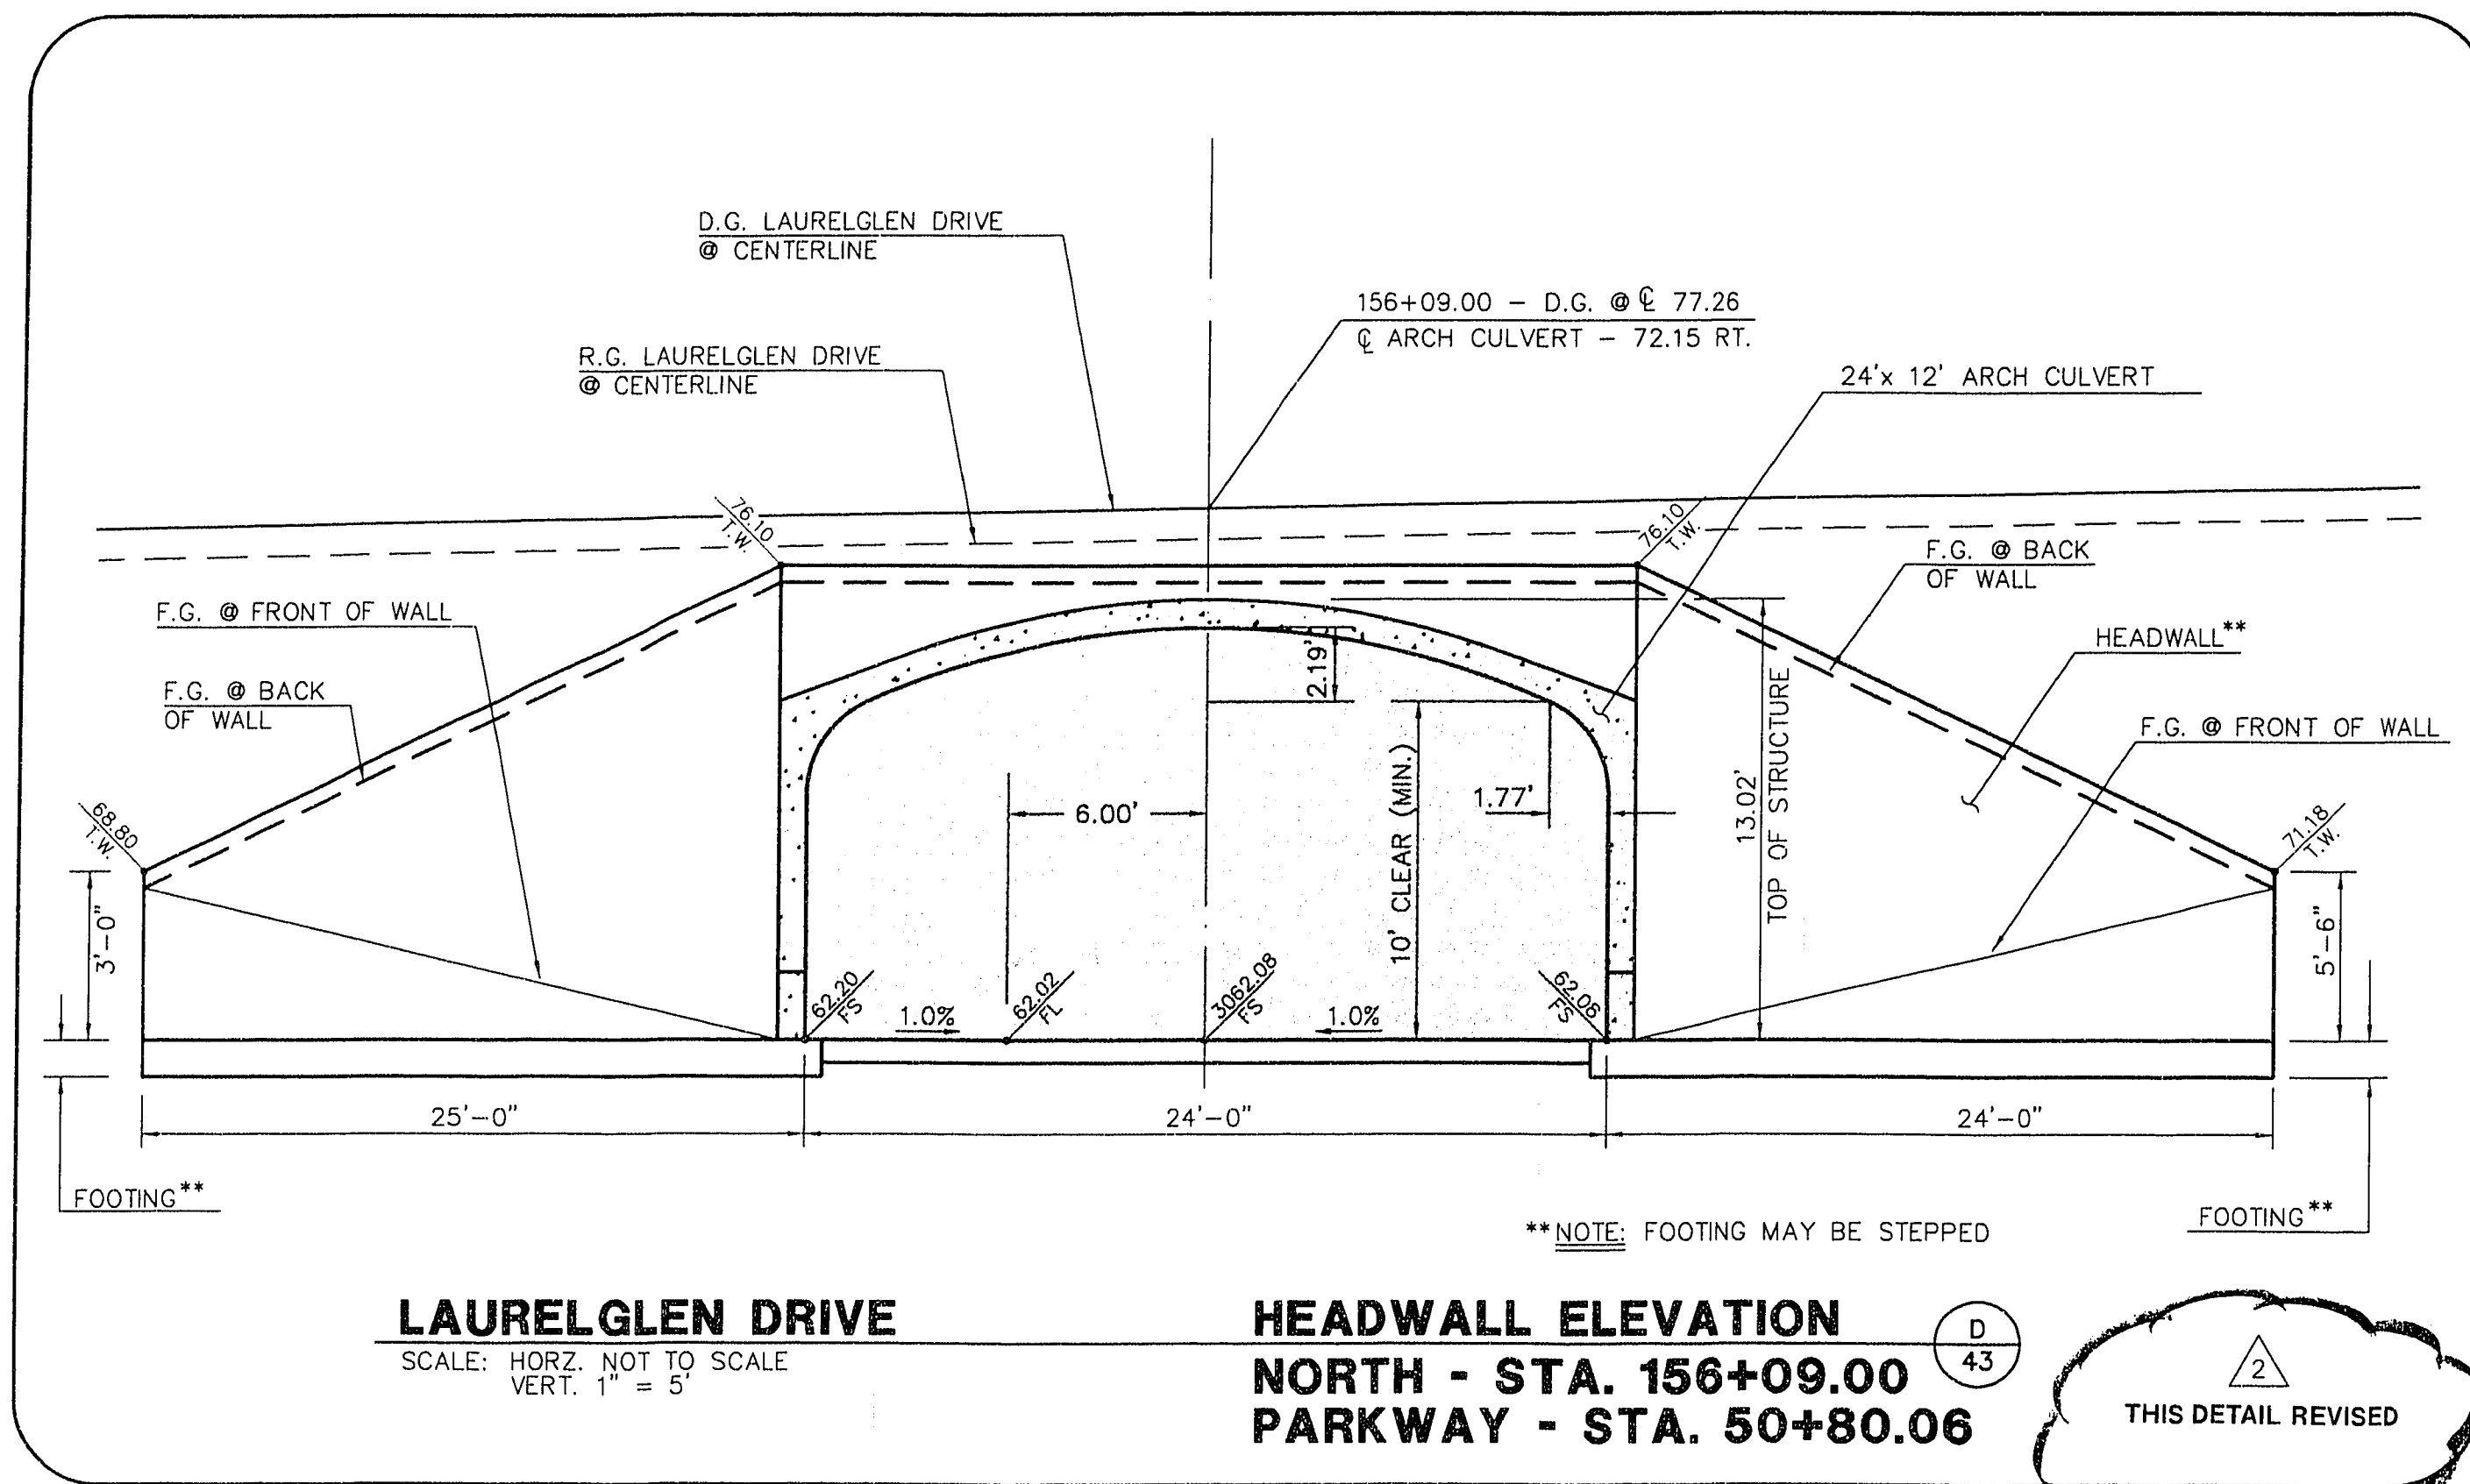

NOTE:  
THIS REINFORCED CONCRETE ARCH CULVERT AND HEADWALLS DESIGN AND STRUCTURAL CALCULATIONS SHALL BE SIGNED AND STAMPED BY A LICENSED PROFESSIONAL ENGINEER, REGISTERED IN THE STATE OF NEVADA, WHOSE SERVICES SHALL BE RETAINED BY THE CONTRACTOR.

APPROVAL OF THESE DESIGN DRAWINGS DOES NOT CONSTITUTE APPROVAL OF THIS ARCH CULVERT. DETAILS ARE PROVIDED HERE ONLY FOR GRADING AND HYDRAULIC RELATIONSHIP.

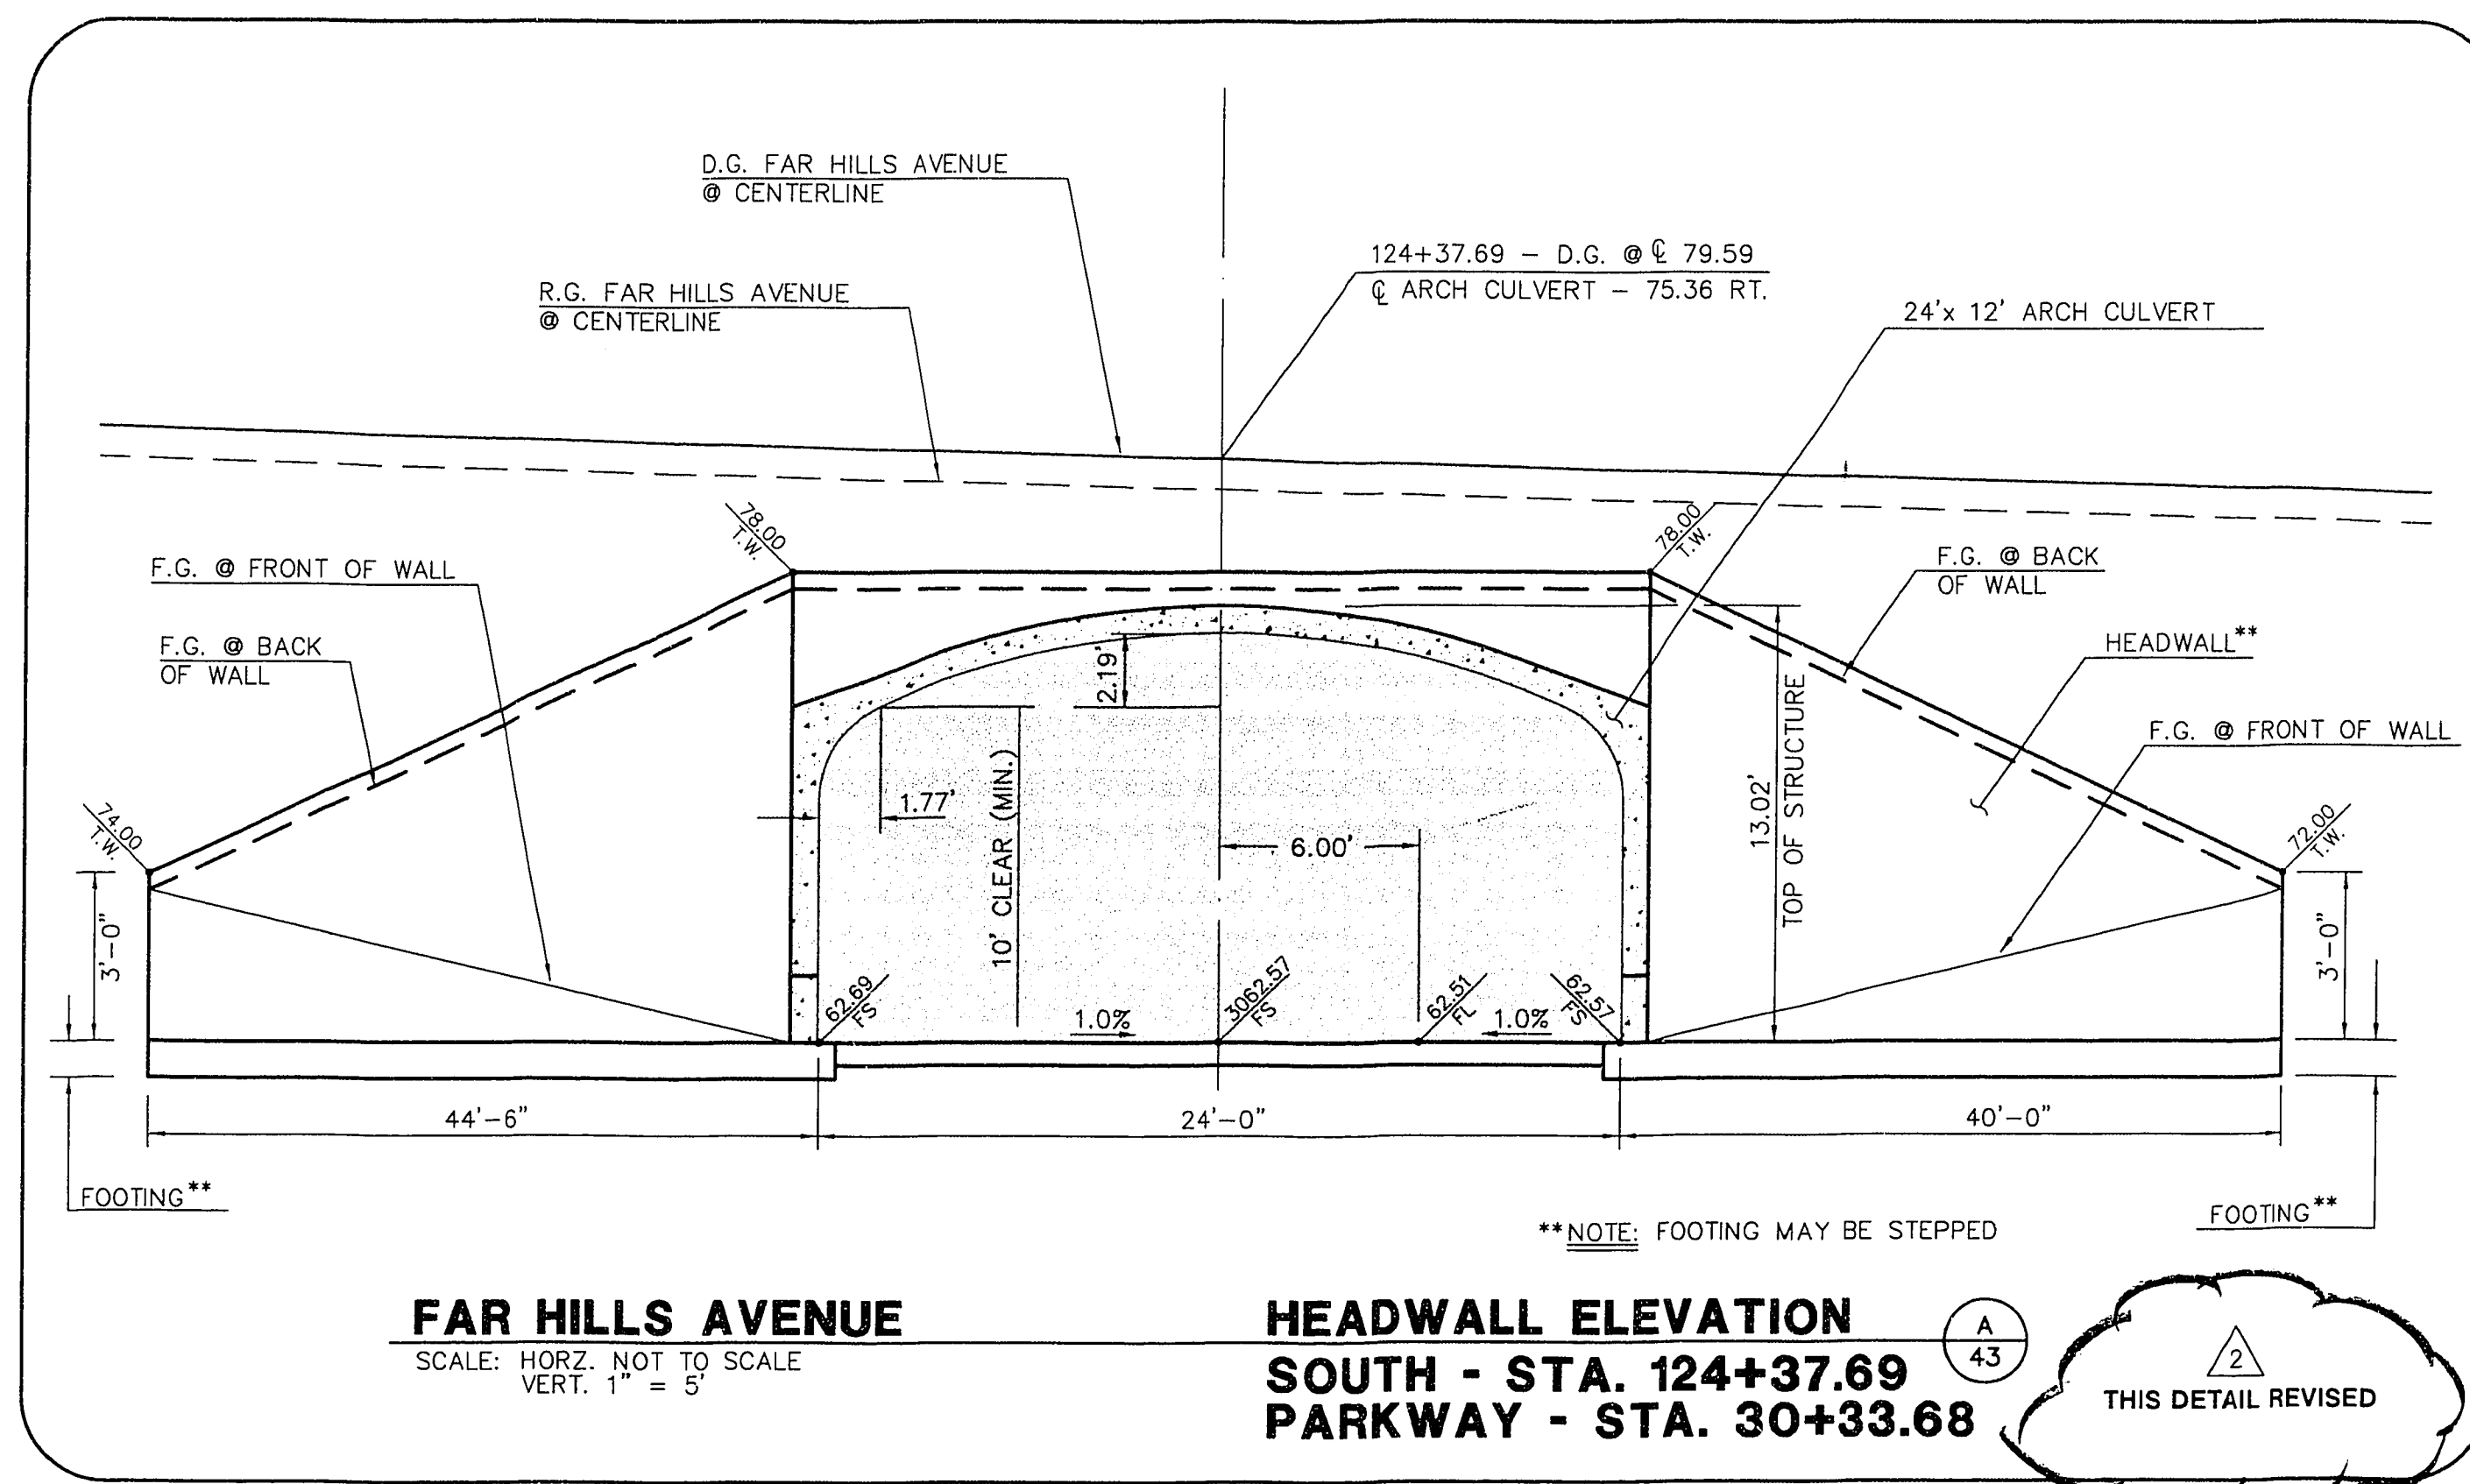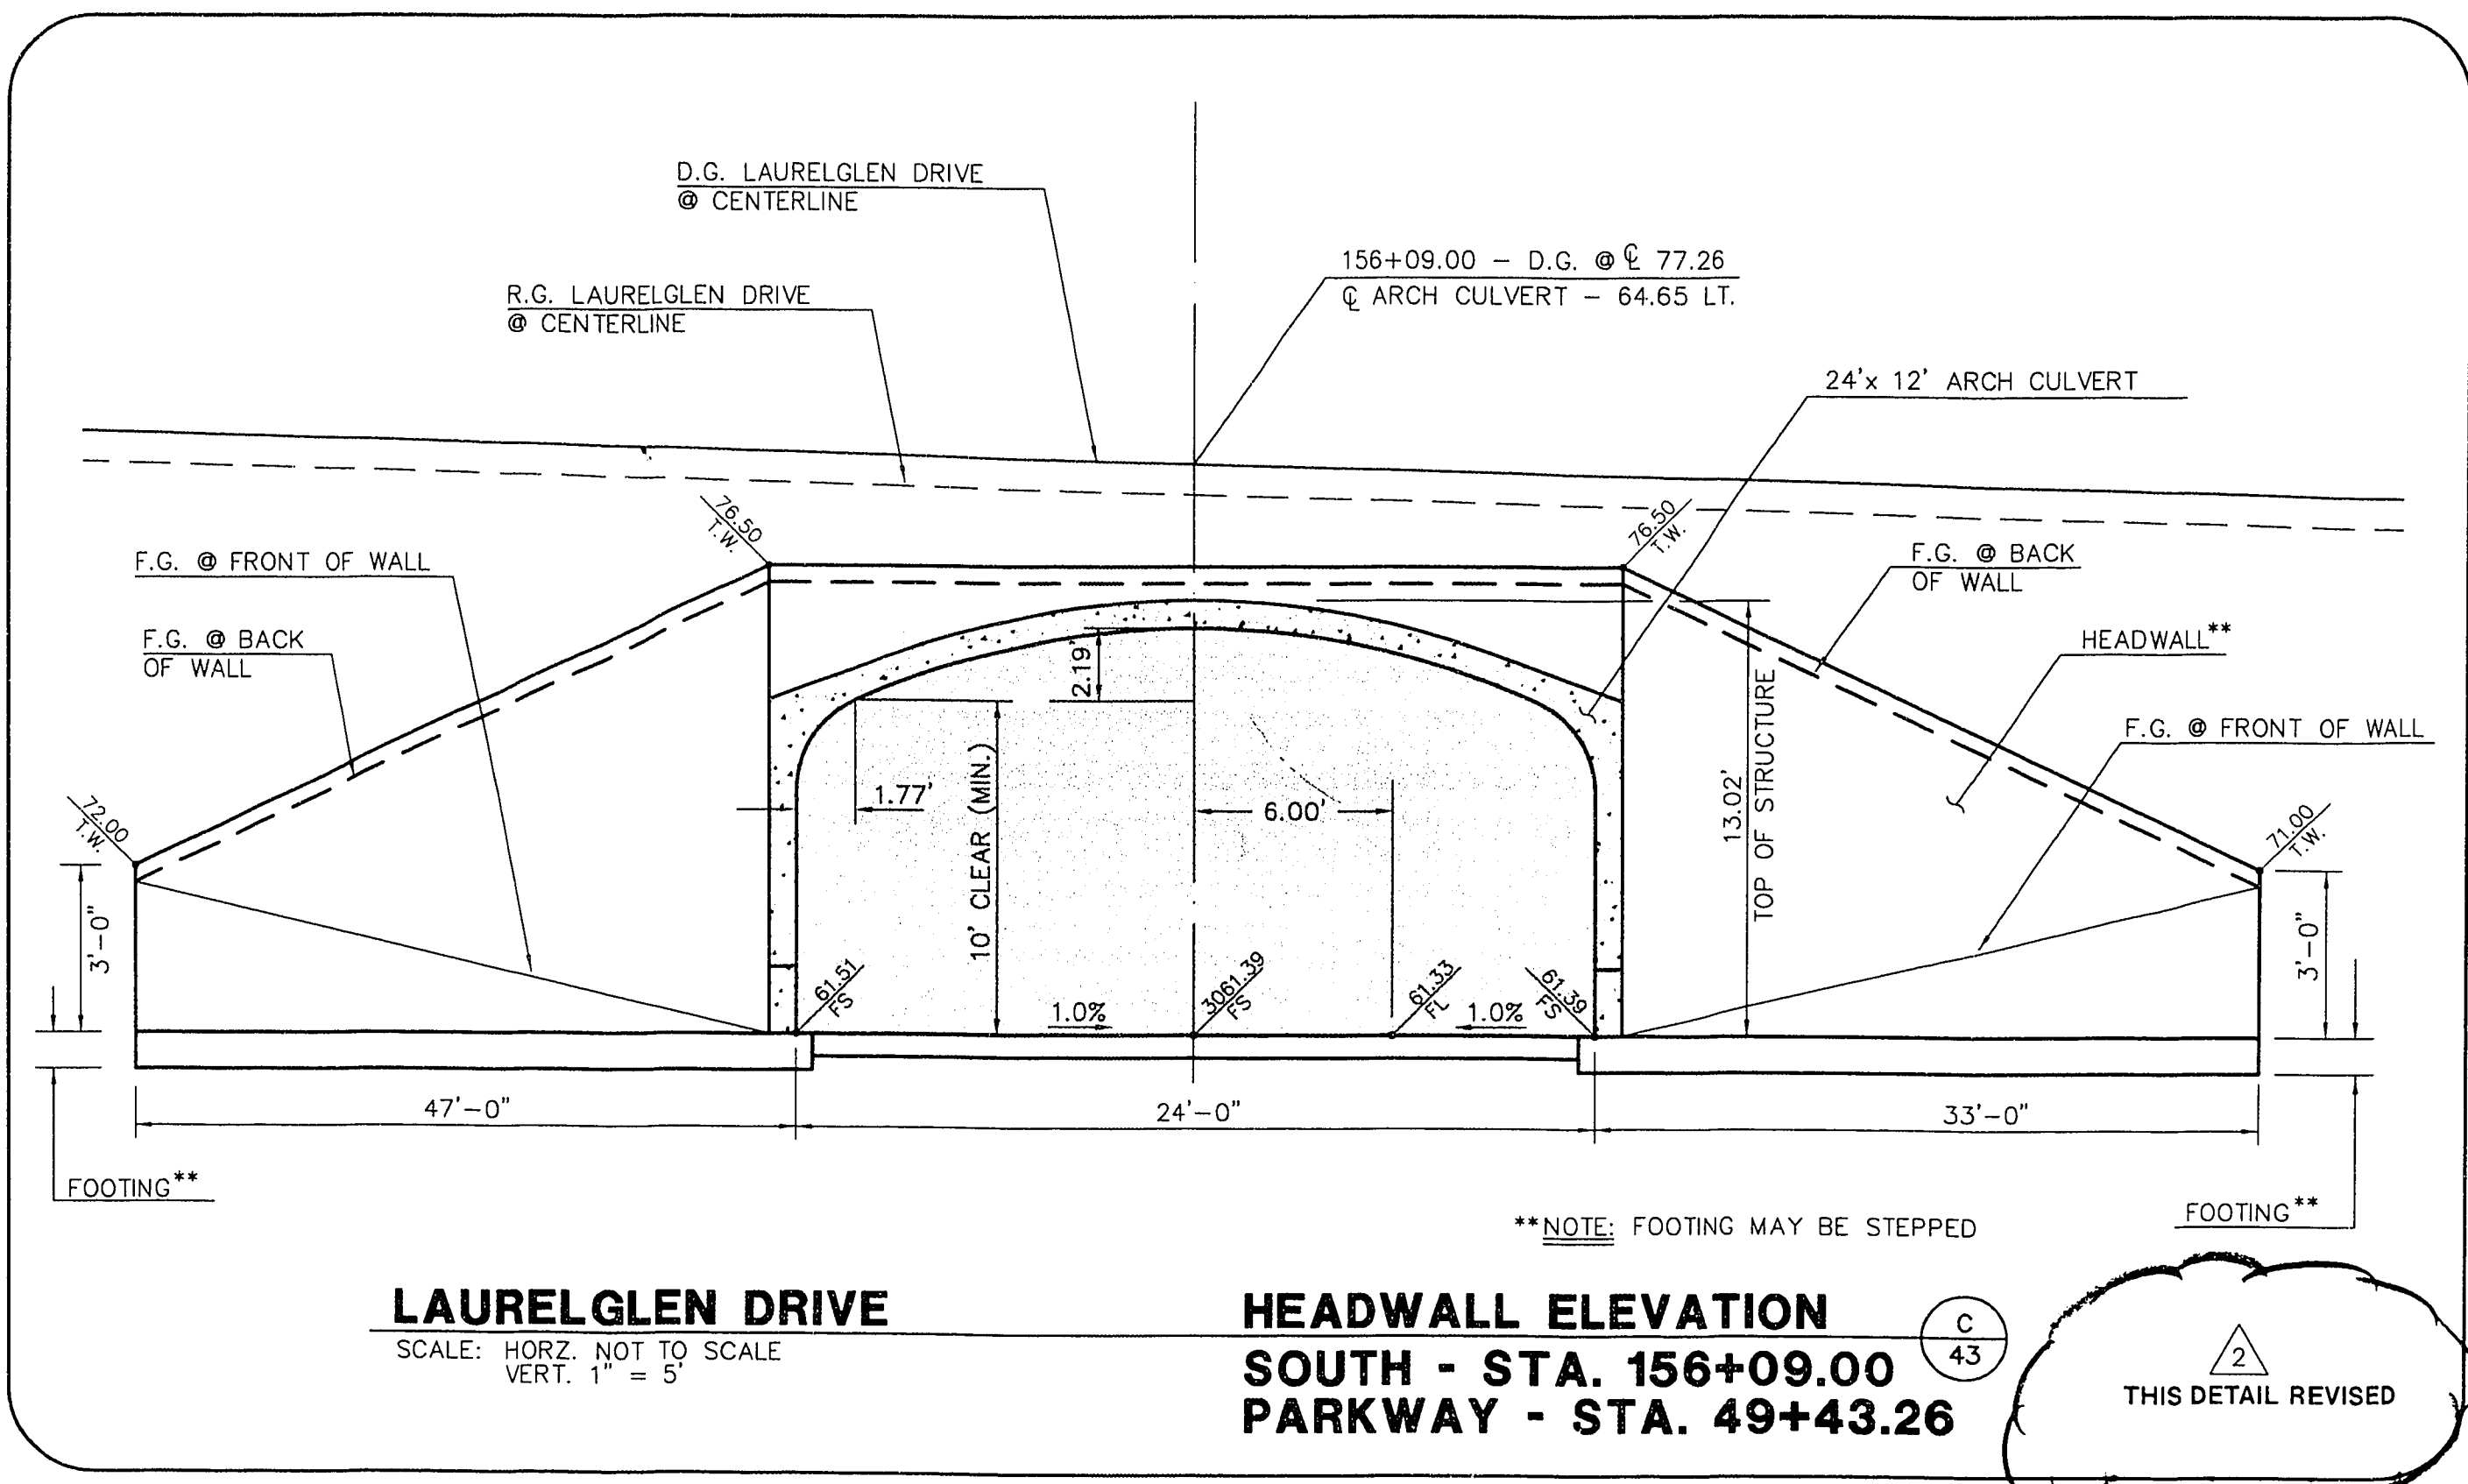

RECOMMENDED BY: CHRISTOPHER W. ANDERSON  
DATE: 9/07

REVISIONS:  
11/17/96 REV. UTIL. PER BASED ROUGH GRAD. [Signature]  
DATE: [Signature]

STATE OF NEVADA  
REGISTERED PROFESSIONAL ENGINEER  
ARCHITECTURE  
G. C. WALLACE, INC.  
Engineering/Architecture  
1555 SOUTH HANBURY BLVD./LAS VEGAS, NEVADA 89102

SUMMERLIN  
THE ARBORS AT SUMMERLIN  
VILLAGE 11/12 UNIT 2B IMPROVEMENTS  
24' X 12' ARCH CULVERTS  
HEADWALL ELEVATIONS

SHEET  
**43**  
SHT 43 OF 46

ISSUE TO CONSTRUCT 10/07/96

FINAL SUBMITTAL