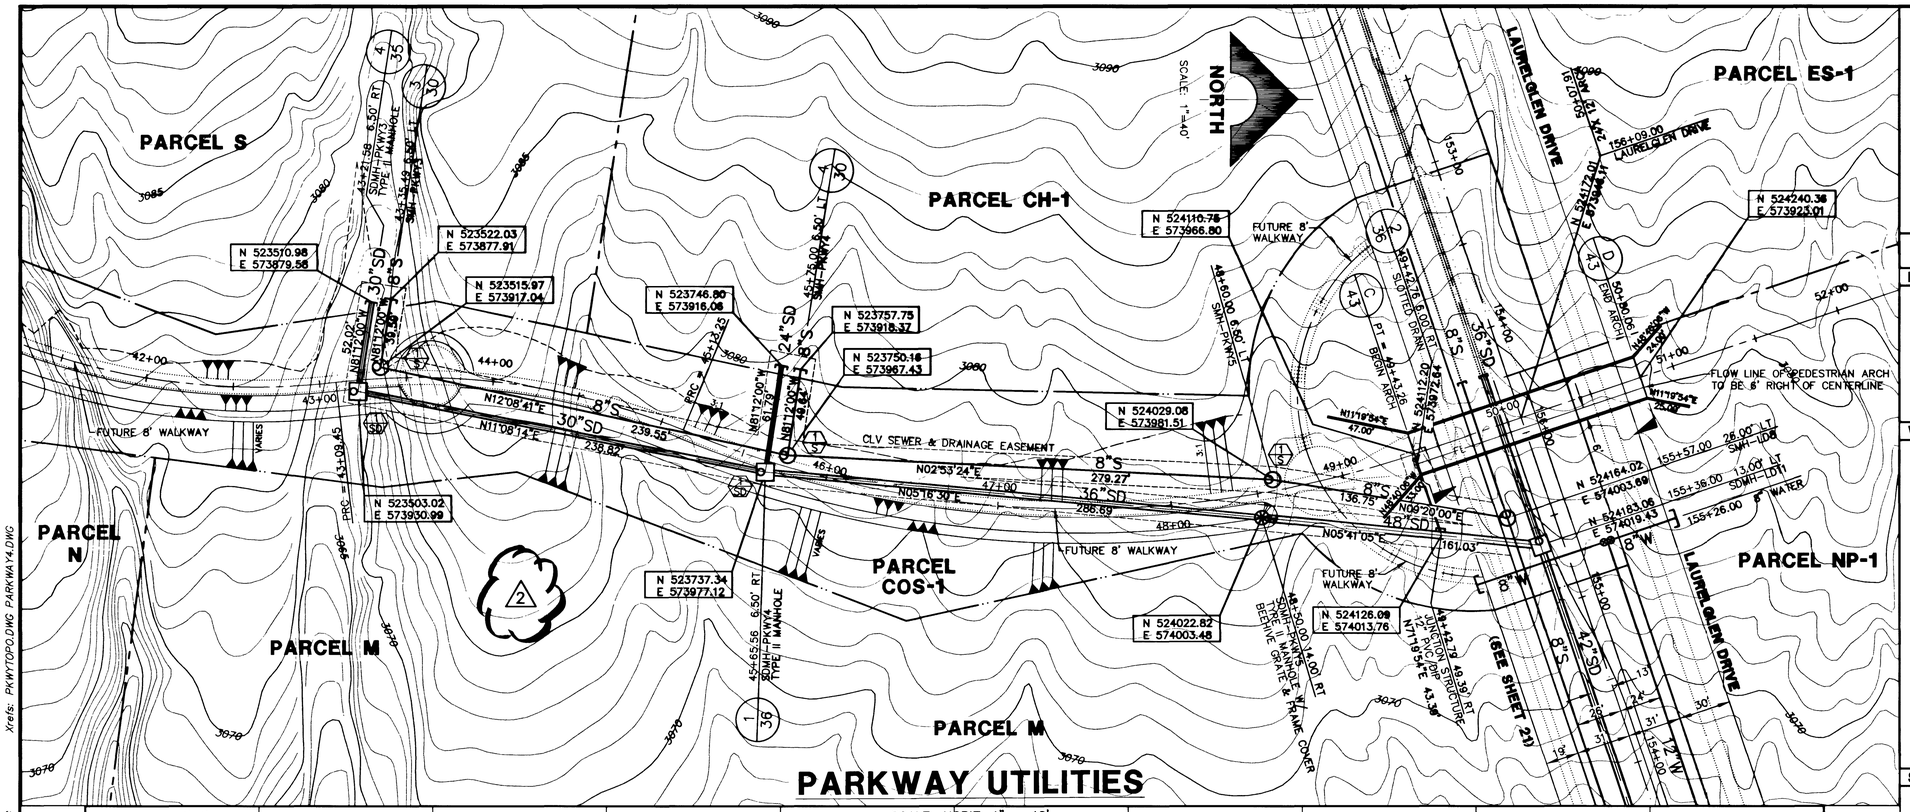

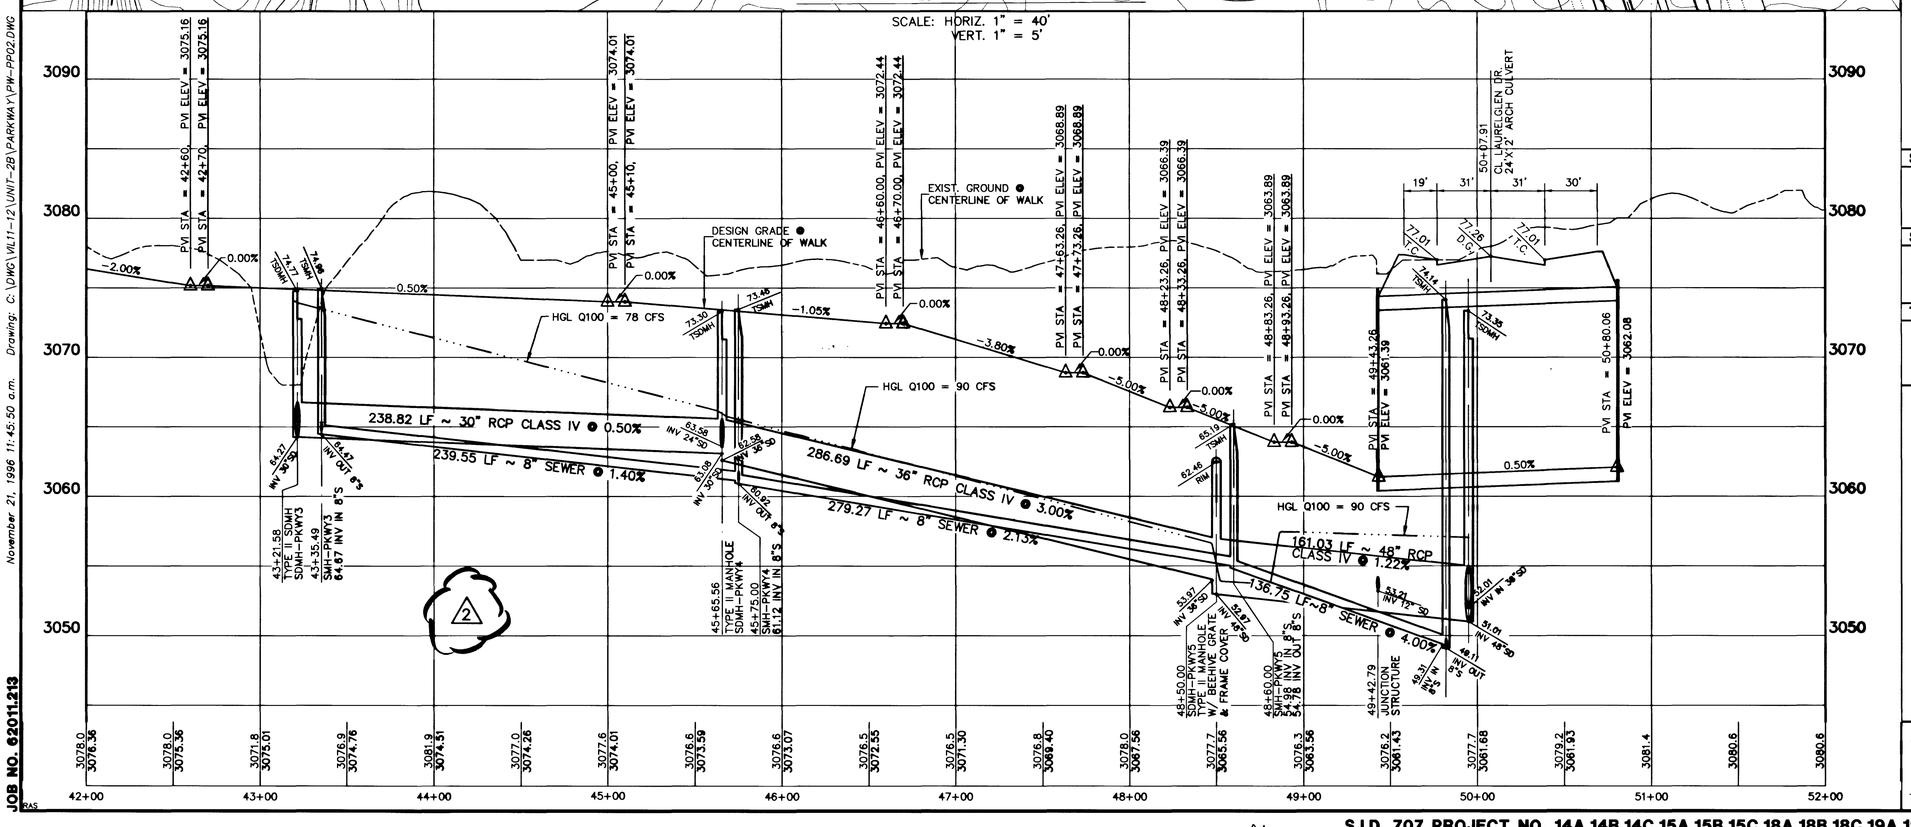

CONSTRUCTION NOTES

IMPROVEMENTS

- INSTALL "A" TYPE CURB (S-50 / S)
- INSTALL "L" TYPE CURB & GUTTER (S-47 / S)
- INSTALL AC PAVEMENT PER SECTION SHEETS
- INSTALL CROSSWALK (S-78 / S)
- INSTALL DEPRESSED CURB (S-75 / S)

WATER

INSTALL WATER PIPES PER UDAC STD.

- INSTALL 12" DIA. GATE VALVE & BOX (U-34 / S)
- INSTALL 8" DIA. GATE VALVE & BOX (U-34 / S)
- INSTALL 12"X12"X12" TEE
- INSTALL 12"X12"X12"X12" CROSS
- INSTALL 12"X12" ELBOW
- INSTALL 12"X12"X8" TEE
- INSTALL 12"X12"X8"X6" CROSS
- INSTALL 2" TEMP. BLOW-OFF & CAP (U-32 / S)
- INSTALL FIRE HYDRANT ASSEMBLY COMPLETE PER (U-33 / S)
- IRRIGATION SLEEVE (U-18 / S)
- GATE VALVE MUST BE IN THE CLOSED POSITION PRIOR TO REMOVAL OF CAP.

STORM DRAIN

INSTALL STORM DRAIN PIPES PER SUMMERLIN STD. U-20

- INSTALL STORM DRAIN MANHOLE (D1-D10 / S)
- INSTALL 4' TYPE "A" DROP INLET (D-12 / S)
- INSTALL TYPE "B" DROP INLET (D-13 / S)
- INSTALL TYPE "C" MODIFIED DROP INLET (SEE PLANS FOR LENGTH) (D-14 / S)
- INSTALL 6' TYPE "A" DROP INLET (D-12 / S)

SEWER

INSTALL SEWER PIPES PER SUMMERLIN STD. U-20

- INSTALL SEWER MANHOLE (SD1-8 / CLV)

STREET LIGHTING

- INSTALL STREET LIGHT, SEE ELECTRICAL PLANS (E-2 / S)
- STREET LIGHT OR COMMON TRENCH, SEE ELECTRICAL PLANS

TRAFFIC

- INSTALL 2-3" CONDUIT
- INSTALL NO. 5 PULLBOX (E-32 / S)

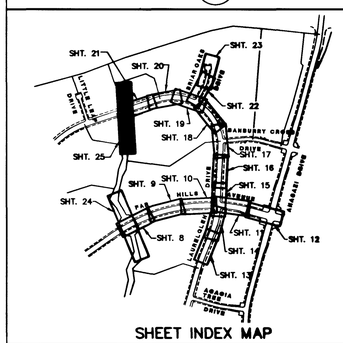

SHEET INDEX MAP

APPROVAL:
ORIGINALLY SIGNED 9/13/96
LAS VEGAS VALLEY WATER DISTRICT — DATE 11/26/96

DATE	DESCRIPTION
11/7/96	REV. UTIL. PER PASCO ROUGH GRAD.

FINAL SUBMITTAL

RECOMMENDED: CHRISTOPHER W. ANDERSON — DATE
R.P.E. NO. 5071

STATE OF NEVADA REGISTERED PROFESSIONAL ENGINEER CHRISTOPHER W. ANDERSON 5071

G.C. WALLACE, INC. Engineering/Architecture 1555 SOUTH RAINBOW BLVD./LAS VEGAS, NEVADA 89102

SUMMERLIN
THE ARBORS AT SUMMERLIN
VILLAGE 11/12 UNIT 2B IMPROVEMENTS
PARKWAY UTILITIES OFF LAURELGLEN DRIVE
PLAN & PROFILE

SHEET 25 OF 46

ISSUE TO CONSTRUCT 10/07/96

JOB NO. 62011.213

Xrefs: PKWYTOPO.DWG PARKWAY4.DWG

Drawing: C:\DWG\VL11-12\UNIT-2B\PARKWAY\PW-PP02.DWG

November 21, 1996 11:45:50 a.m.

S.I.D. 707 PROJECT NO. 14A,14B,14C,15A,15B,15C,18A,18B,18C,19A,19B,19C,20A,20B,20C, & 52

307Y-4463-2B

11-32-106

 
PARKWAY UTILITIES
CONSTRUCTION NOTES
SHEET INDEX MAP
C. WALLACE, INC.
SHEET
25
11-32-106