
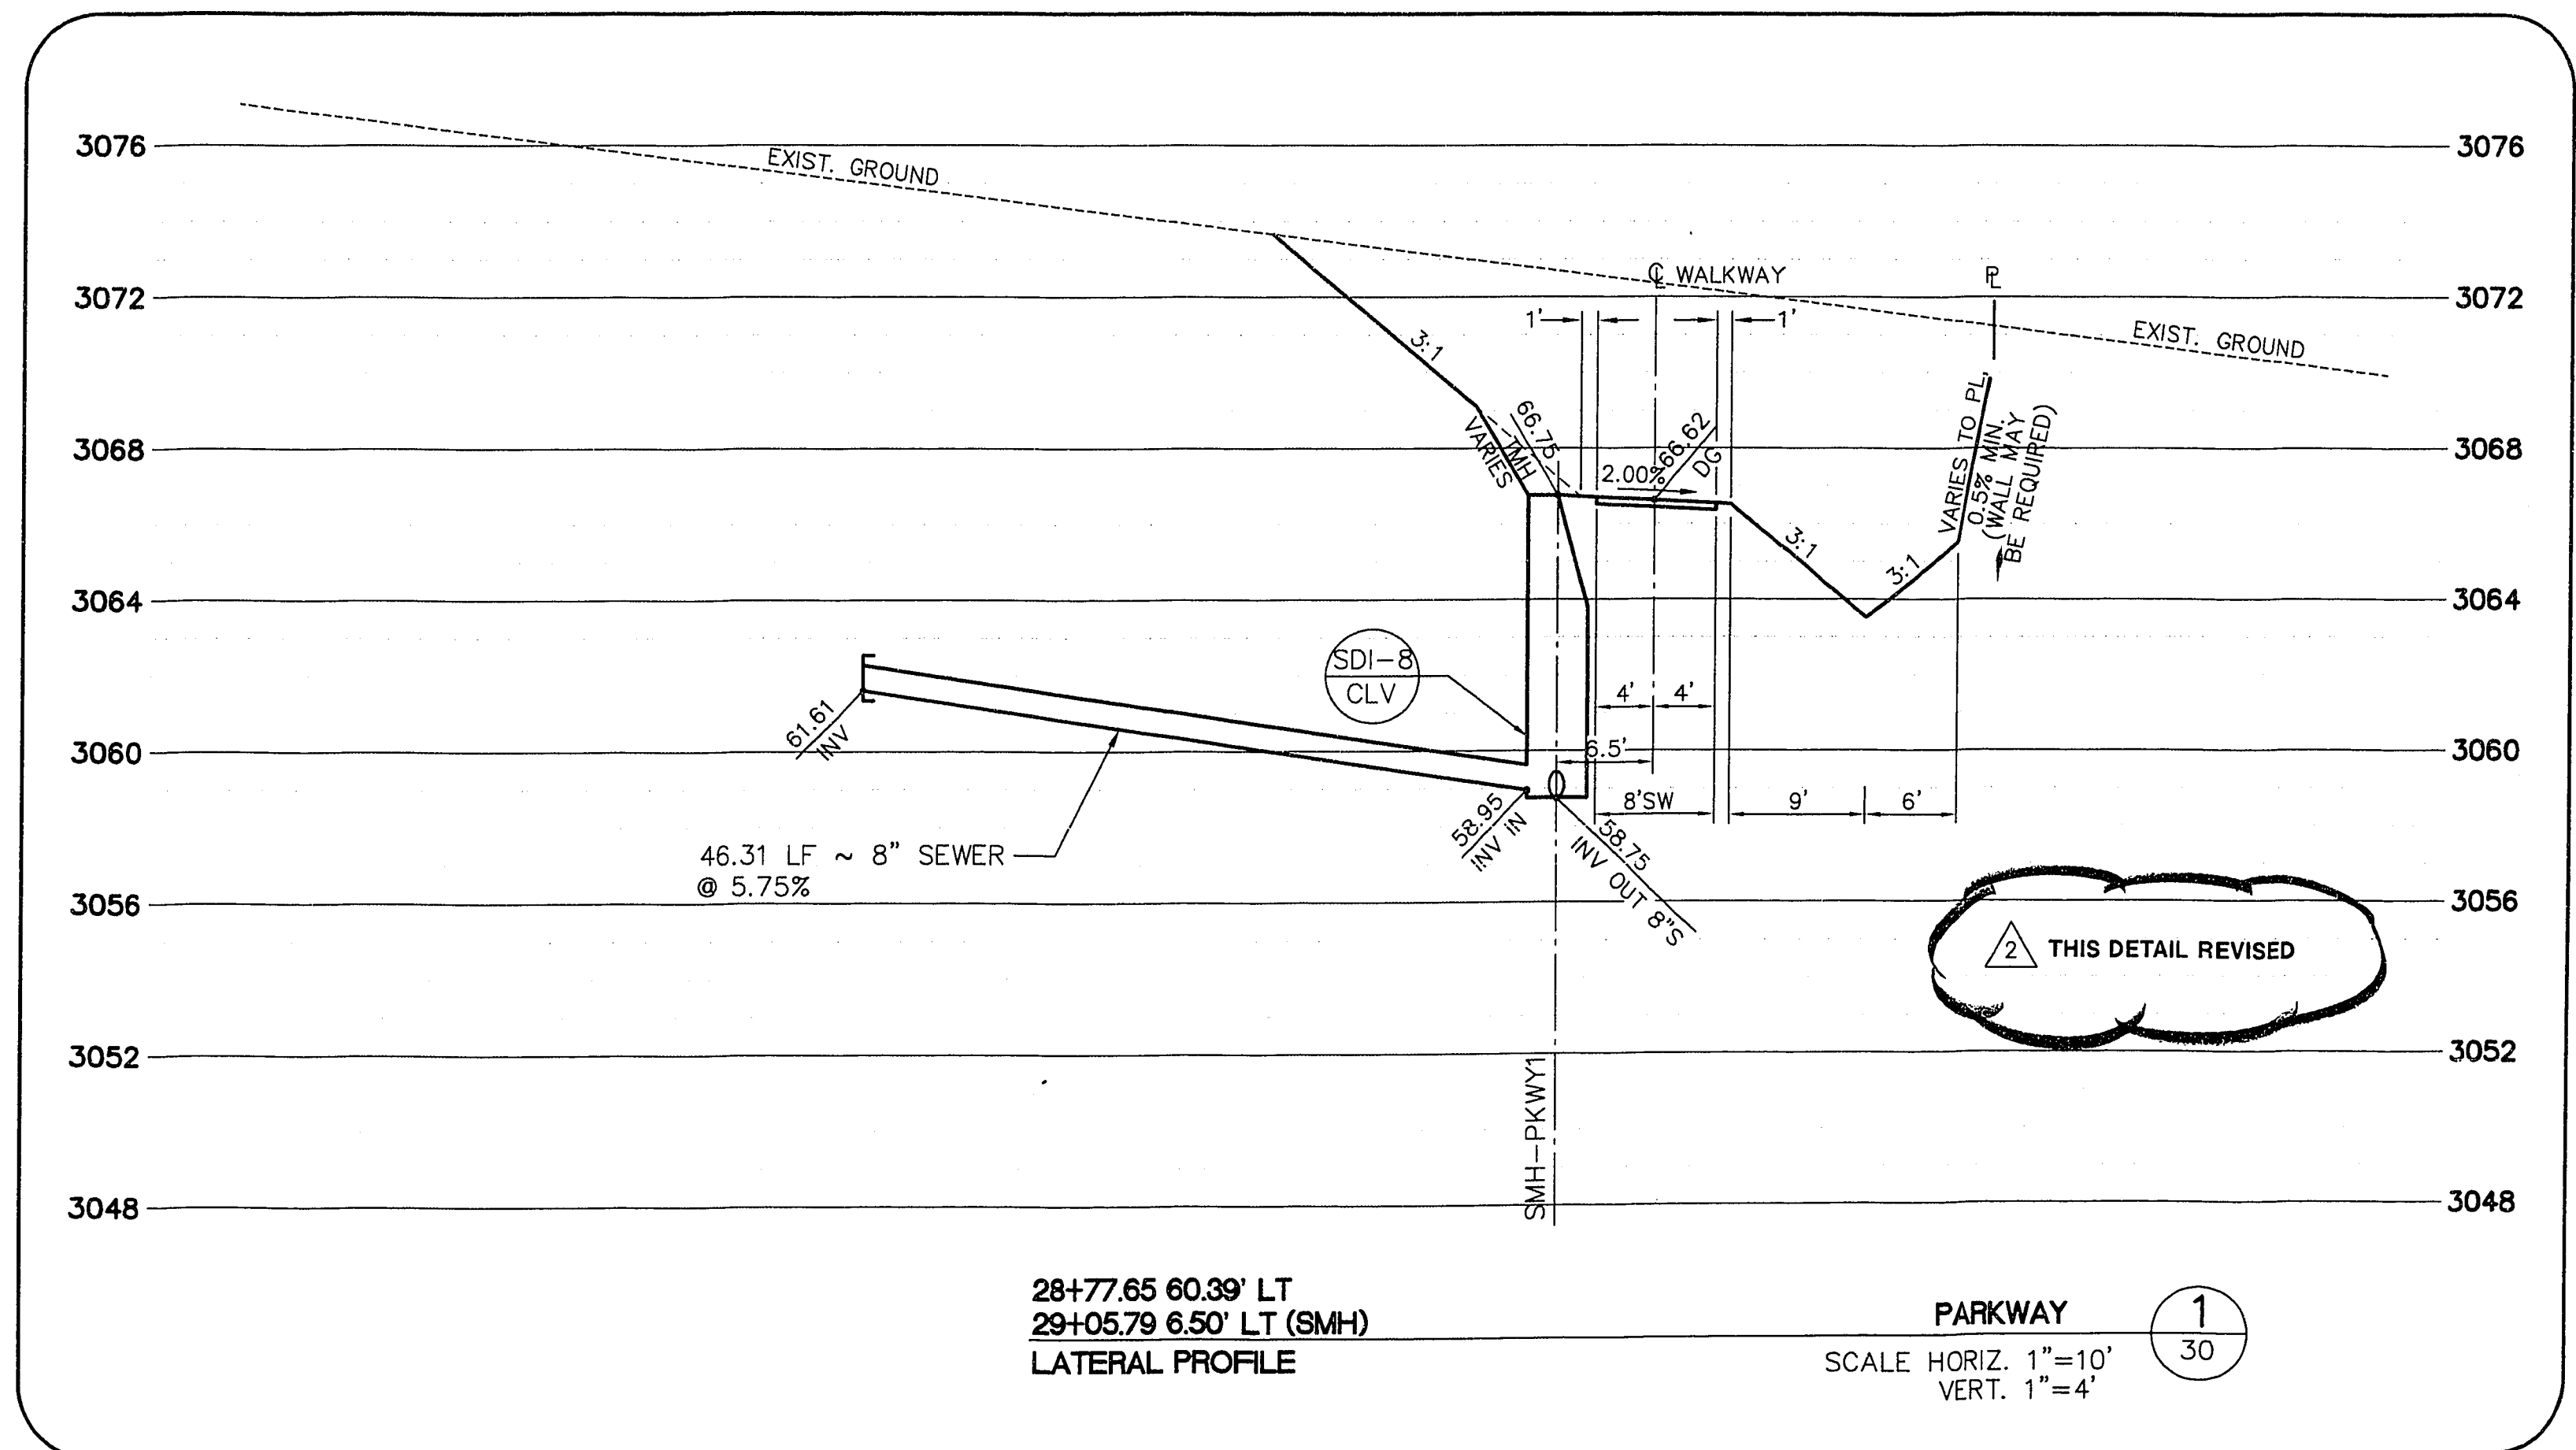
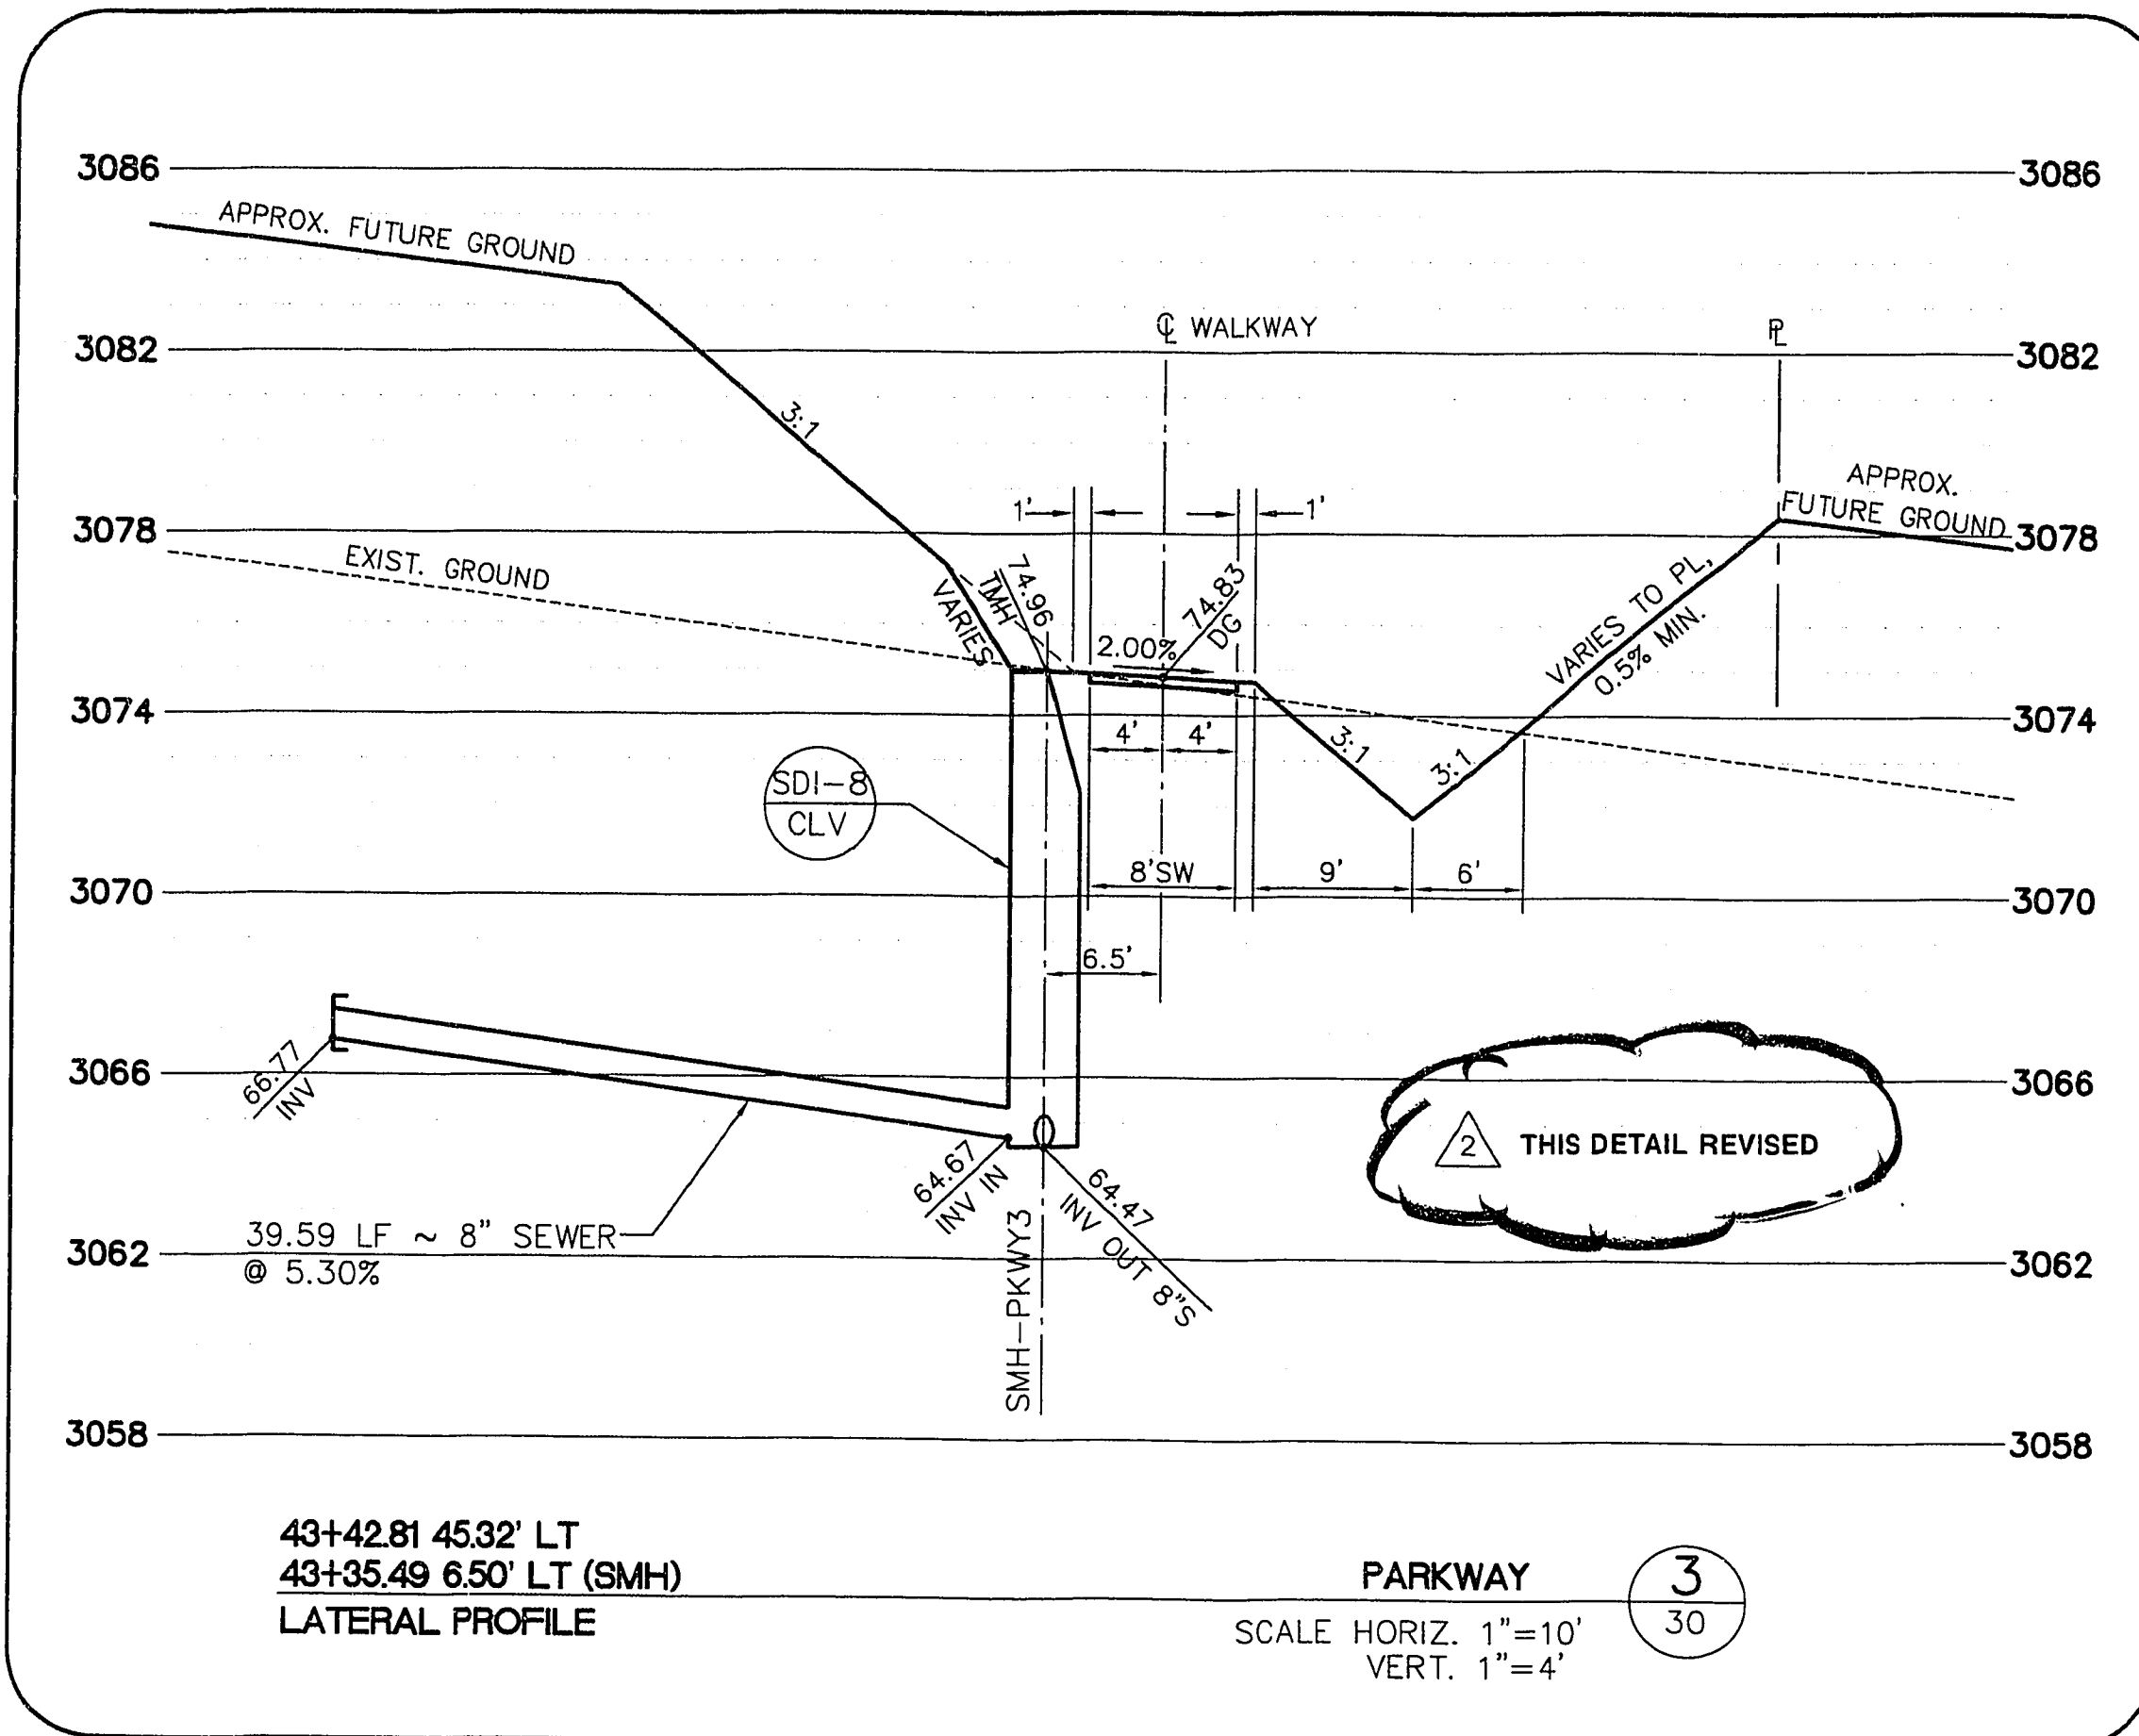
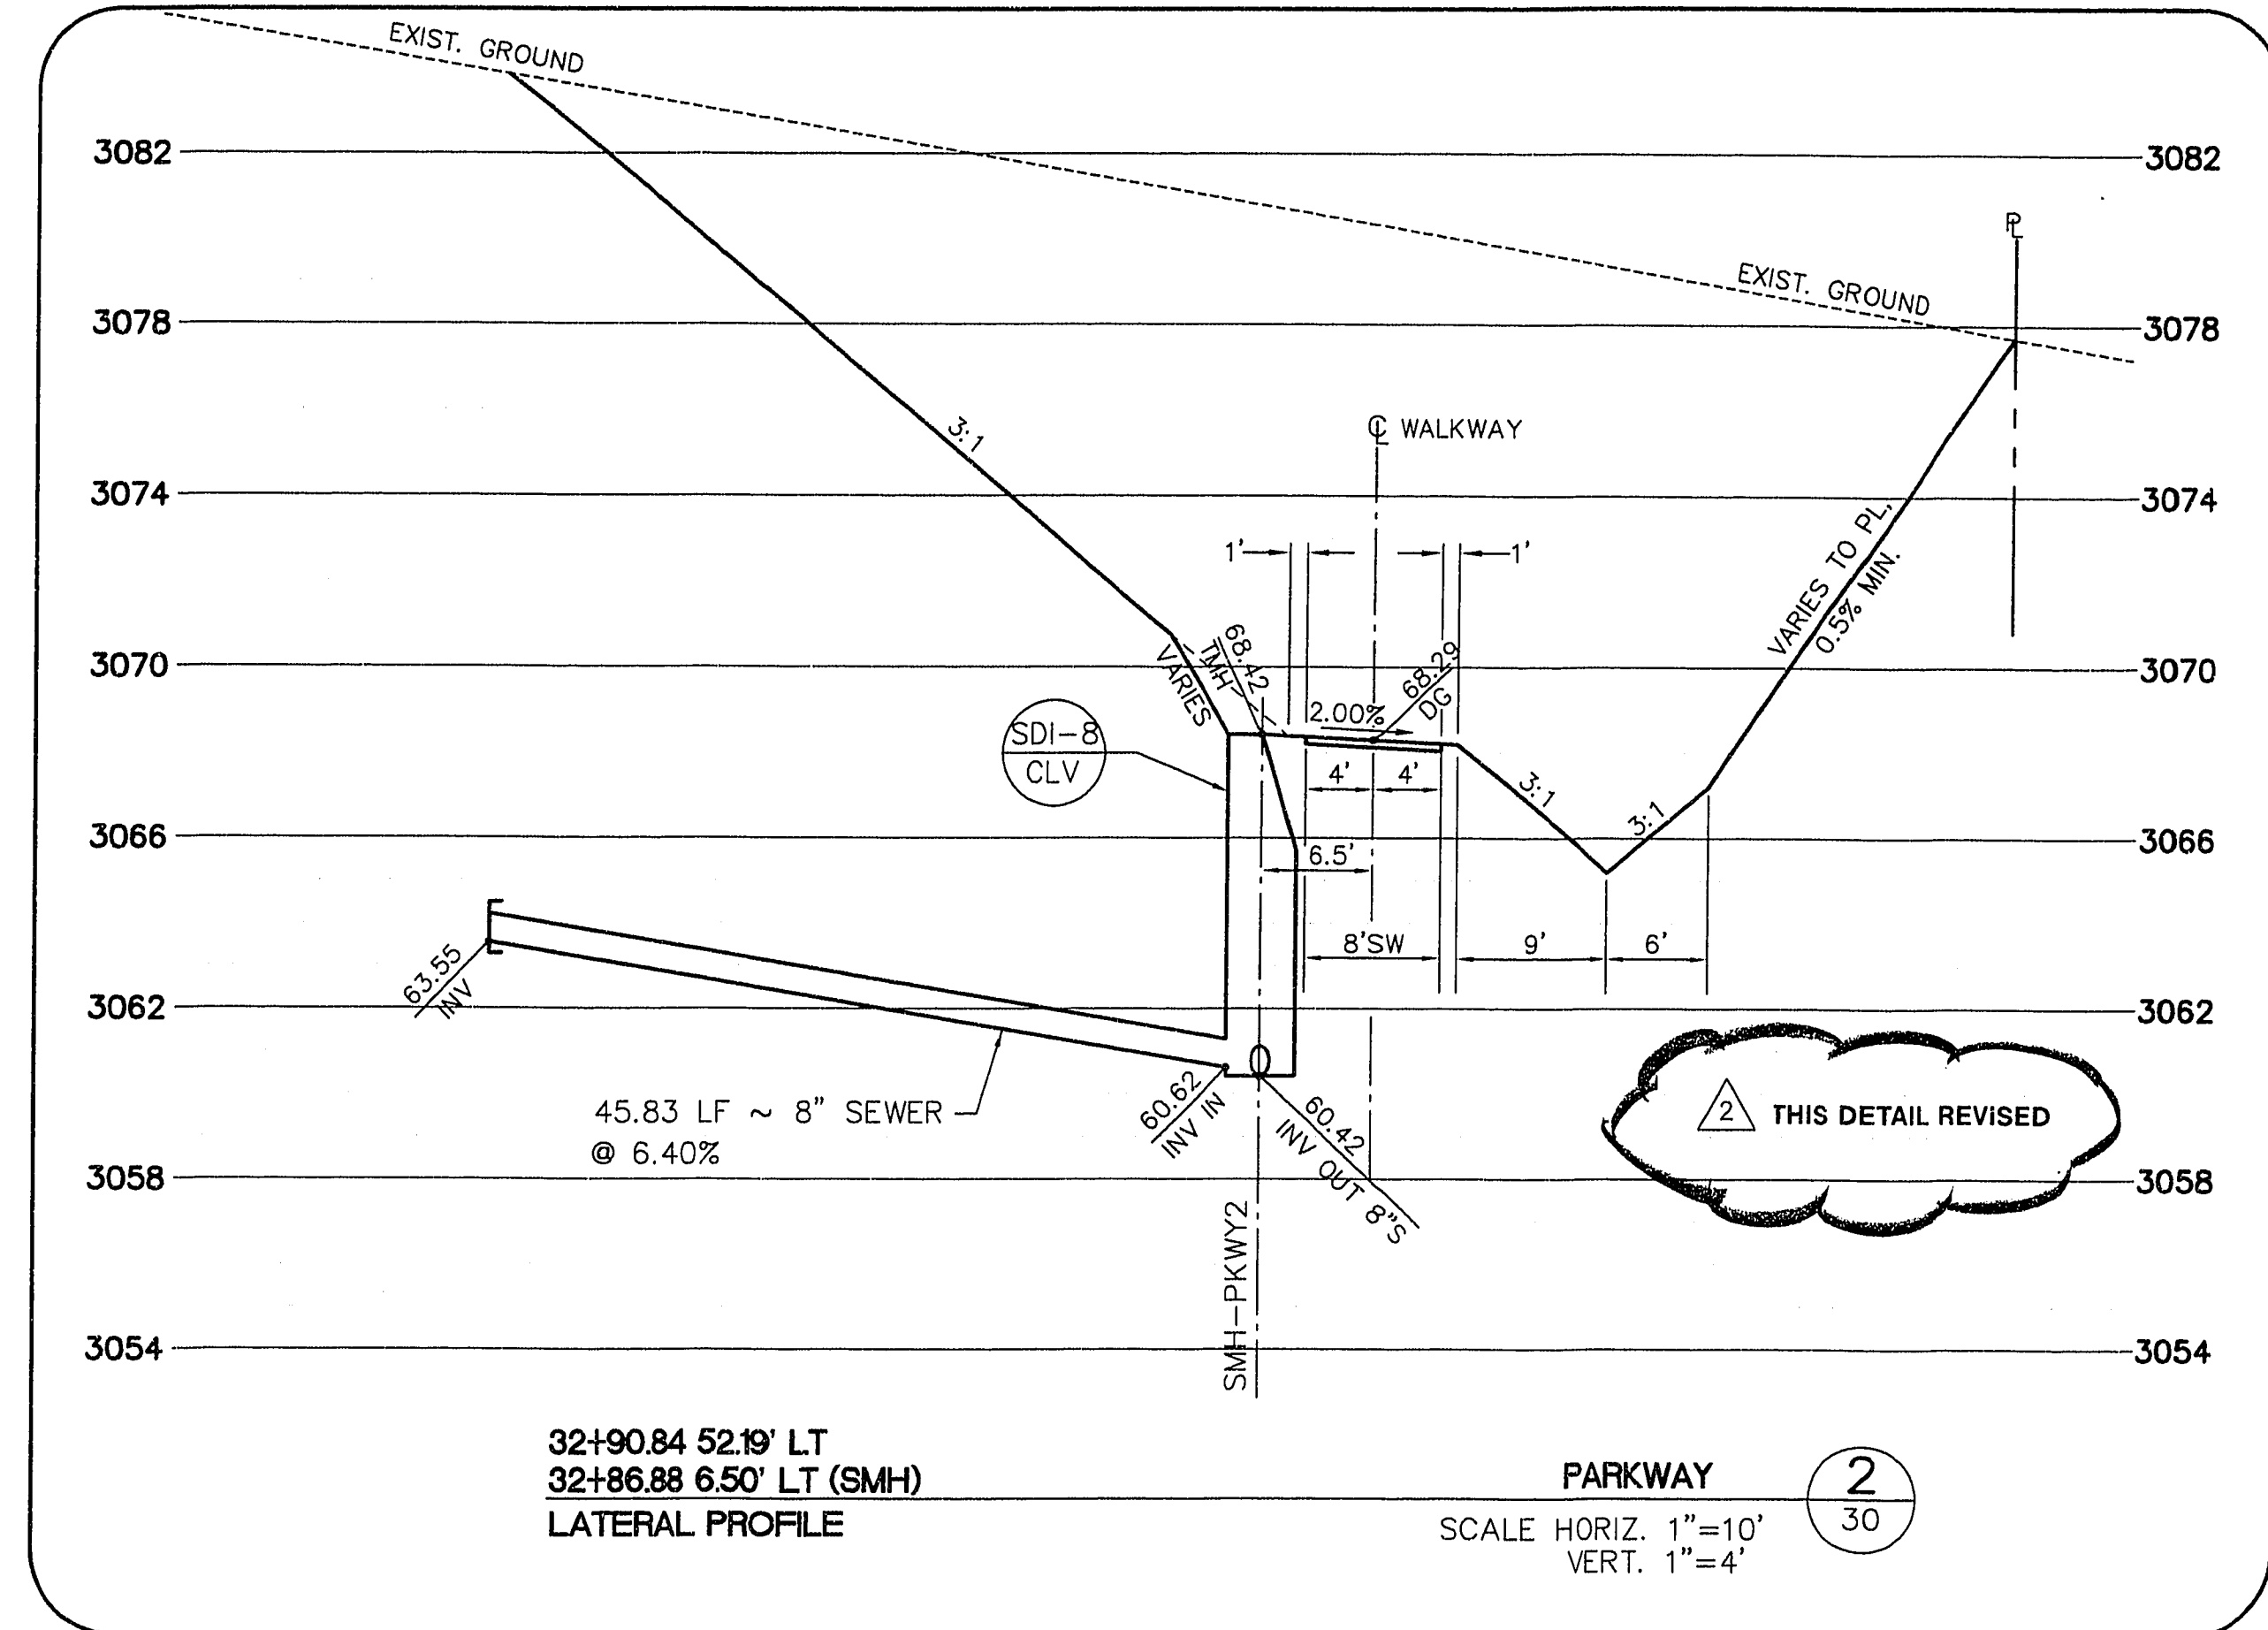


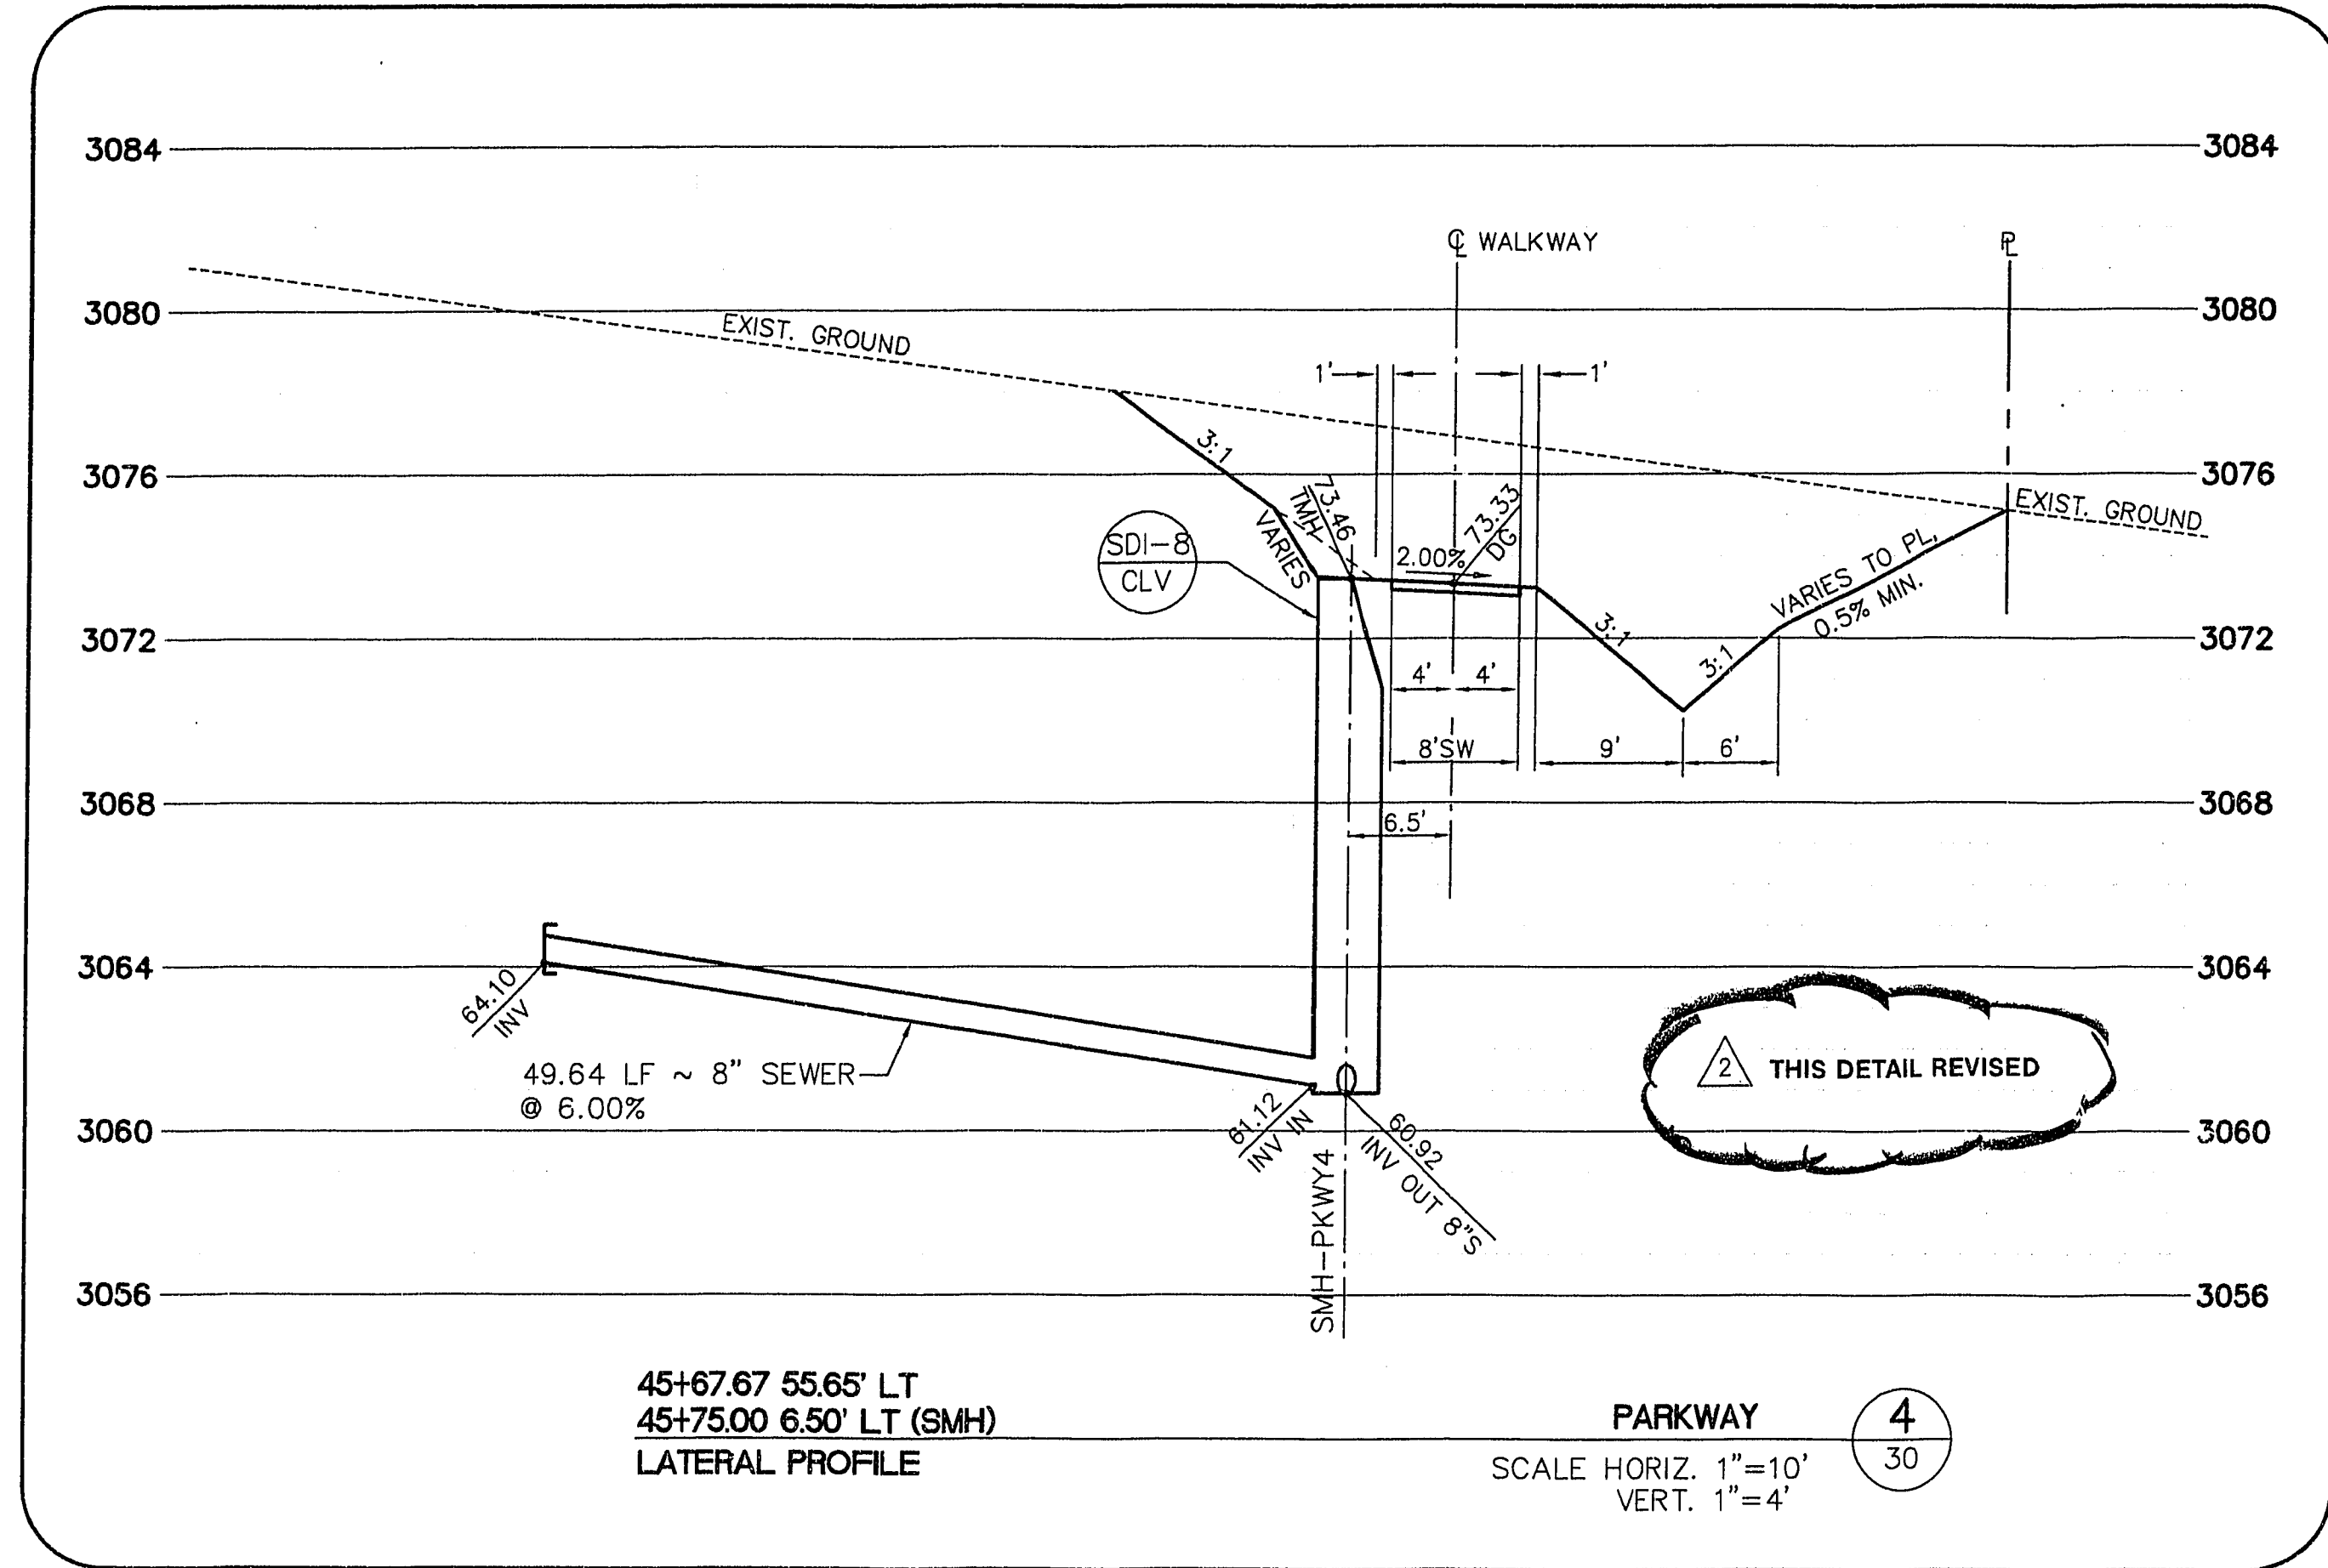

RECOMMENDED	DATE	REV.	DESCRIPTION
CHRISTOPHER W. ANDERSON	11/7/96	1	REV. UTIL. PER PASSED ROUGH GRAD.
CHRISTOPHER W. ANDERSON	11/7/96	2	REV. UTIL. PER PASSED ROUGH GRAD.
REGISTERED PROFESSIONAL ENGINEER - STATE OF NEVADA
G.C. WALLACE, INC.
Engineering/Architecture
1555 SOUTH HANBOW BLVD/LAS VEGAS, NEVADA 89102
SUMMERLIN
THE ARBORS AT SUMMERLIN
VILLAGE 11/12 UNIT 2B IMPROVEMENTS
PARKWAY
SEWER LATERALS
SHEET
30
SHT 30 OF 46
ISSUE TO CONSTRUCT 10/07/96
FINAL SUBMITTAL