
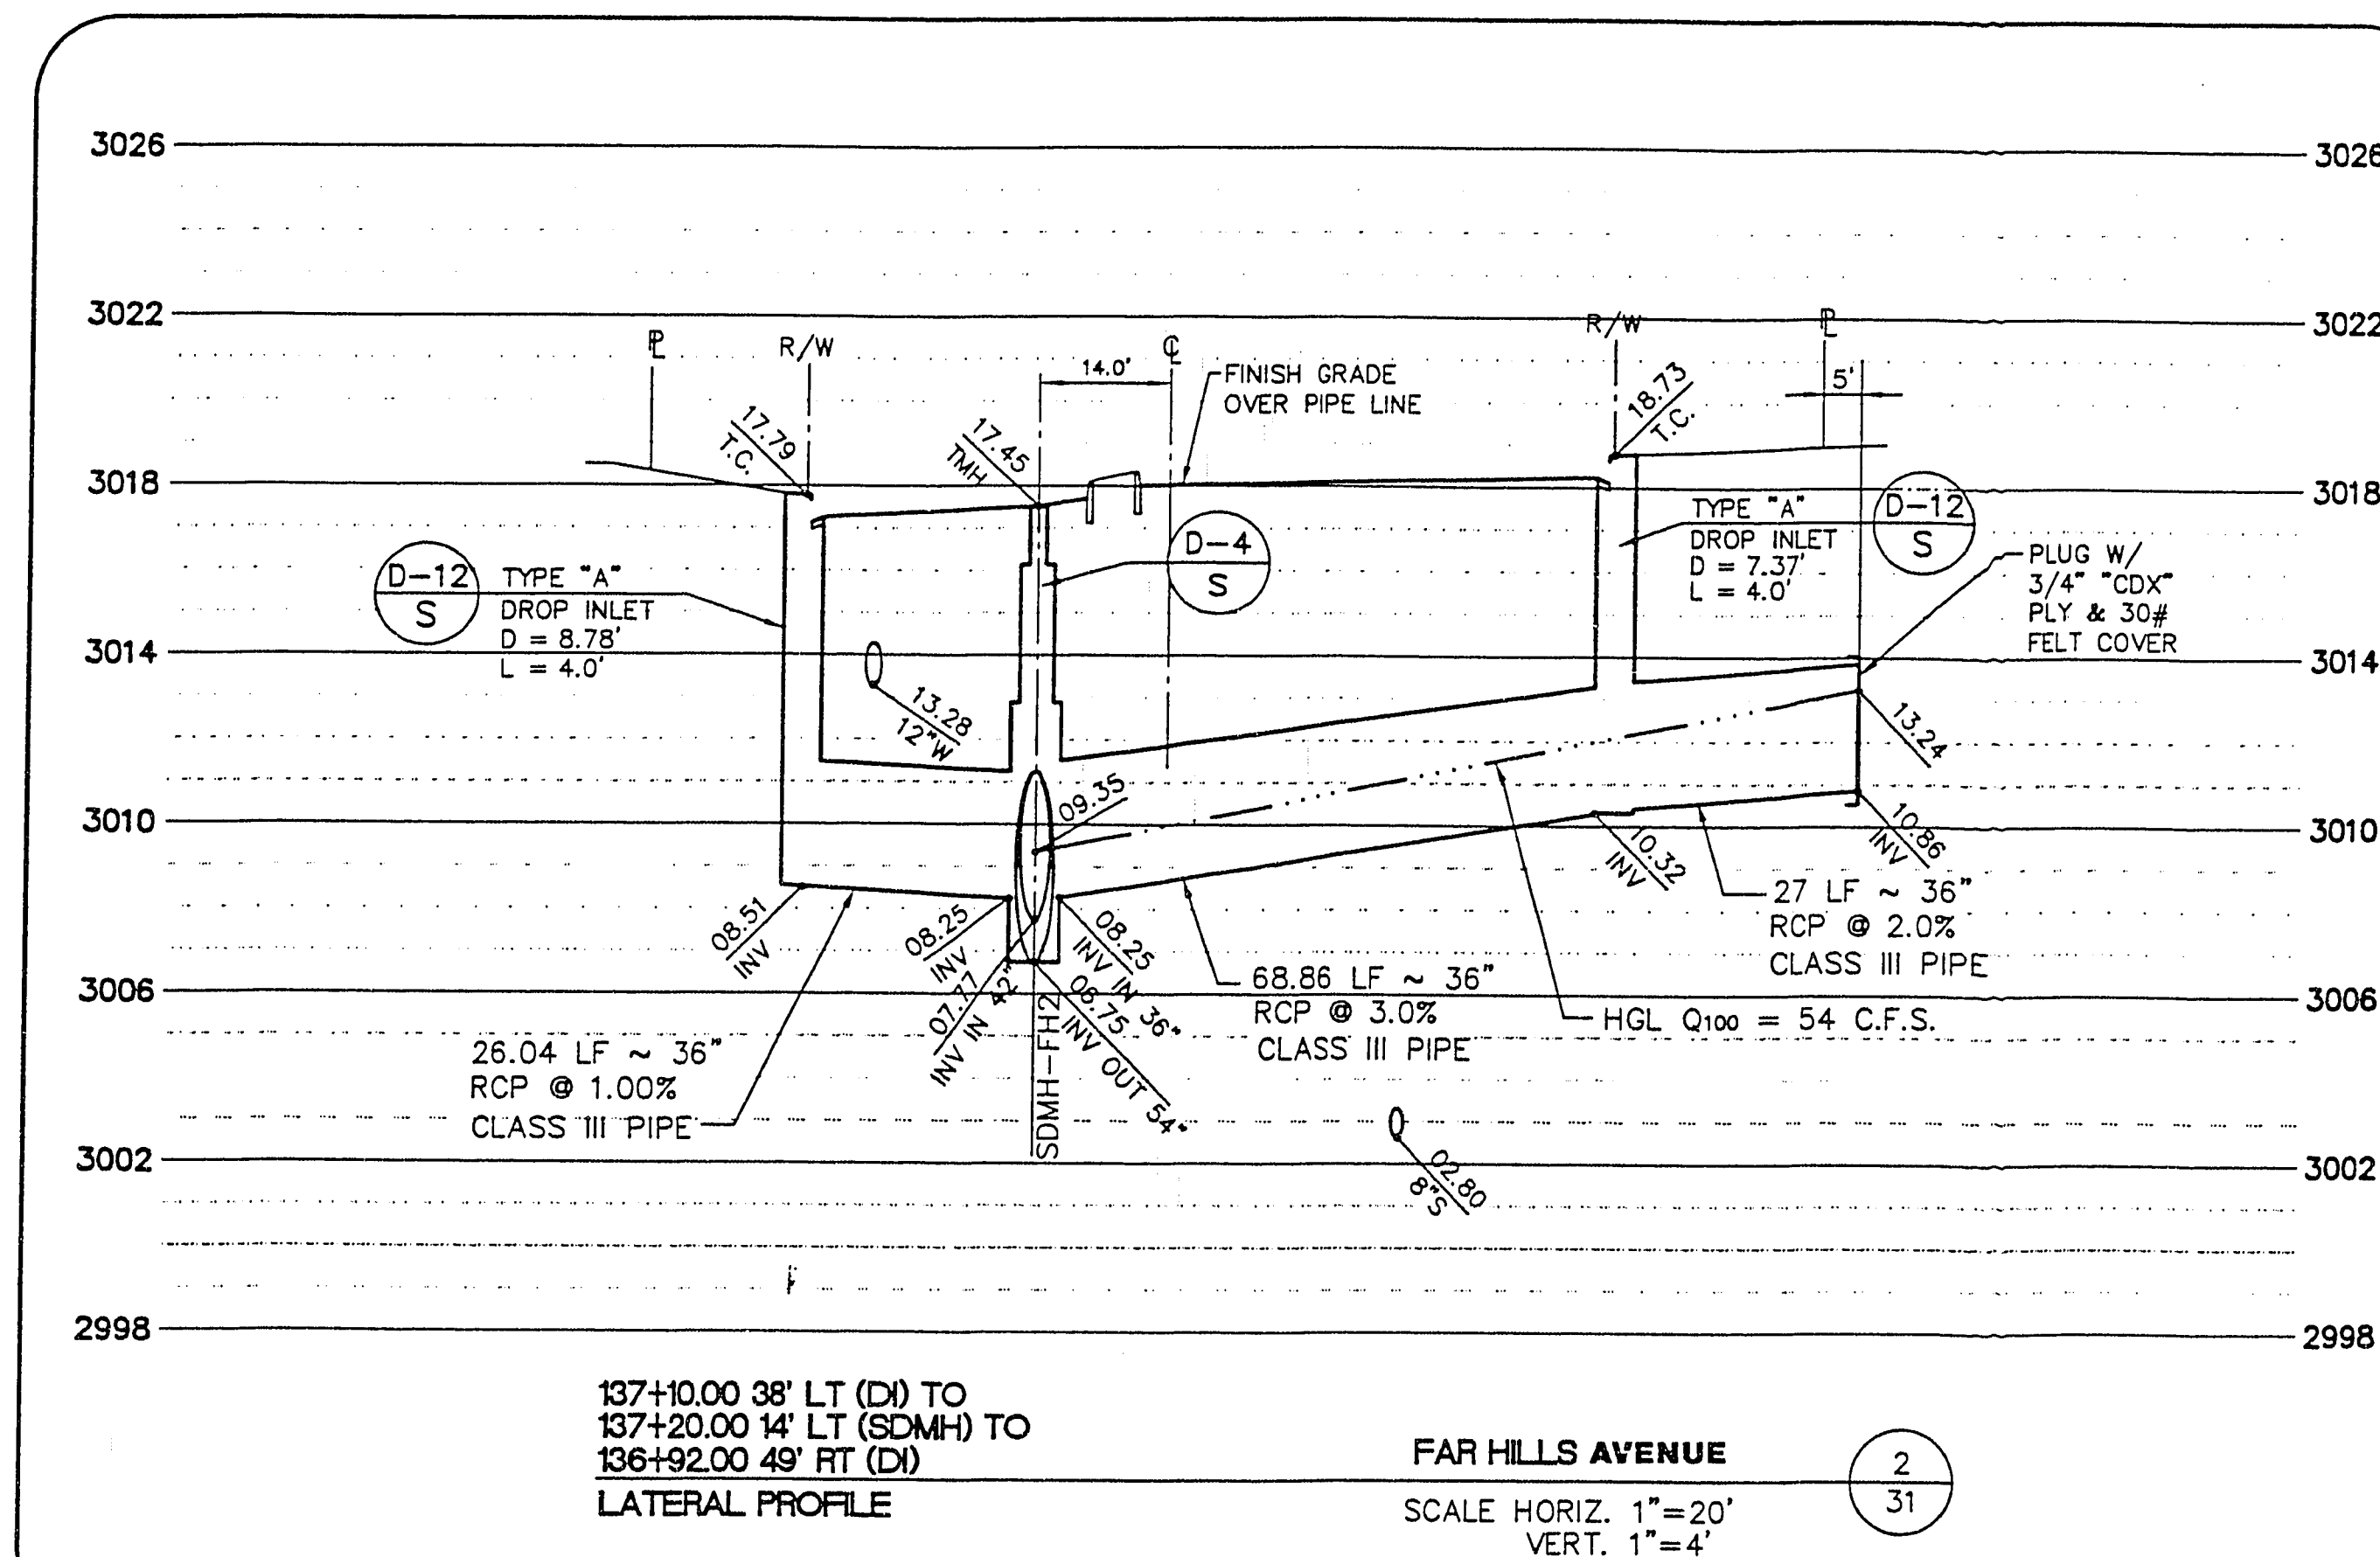
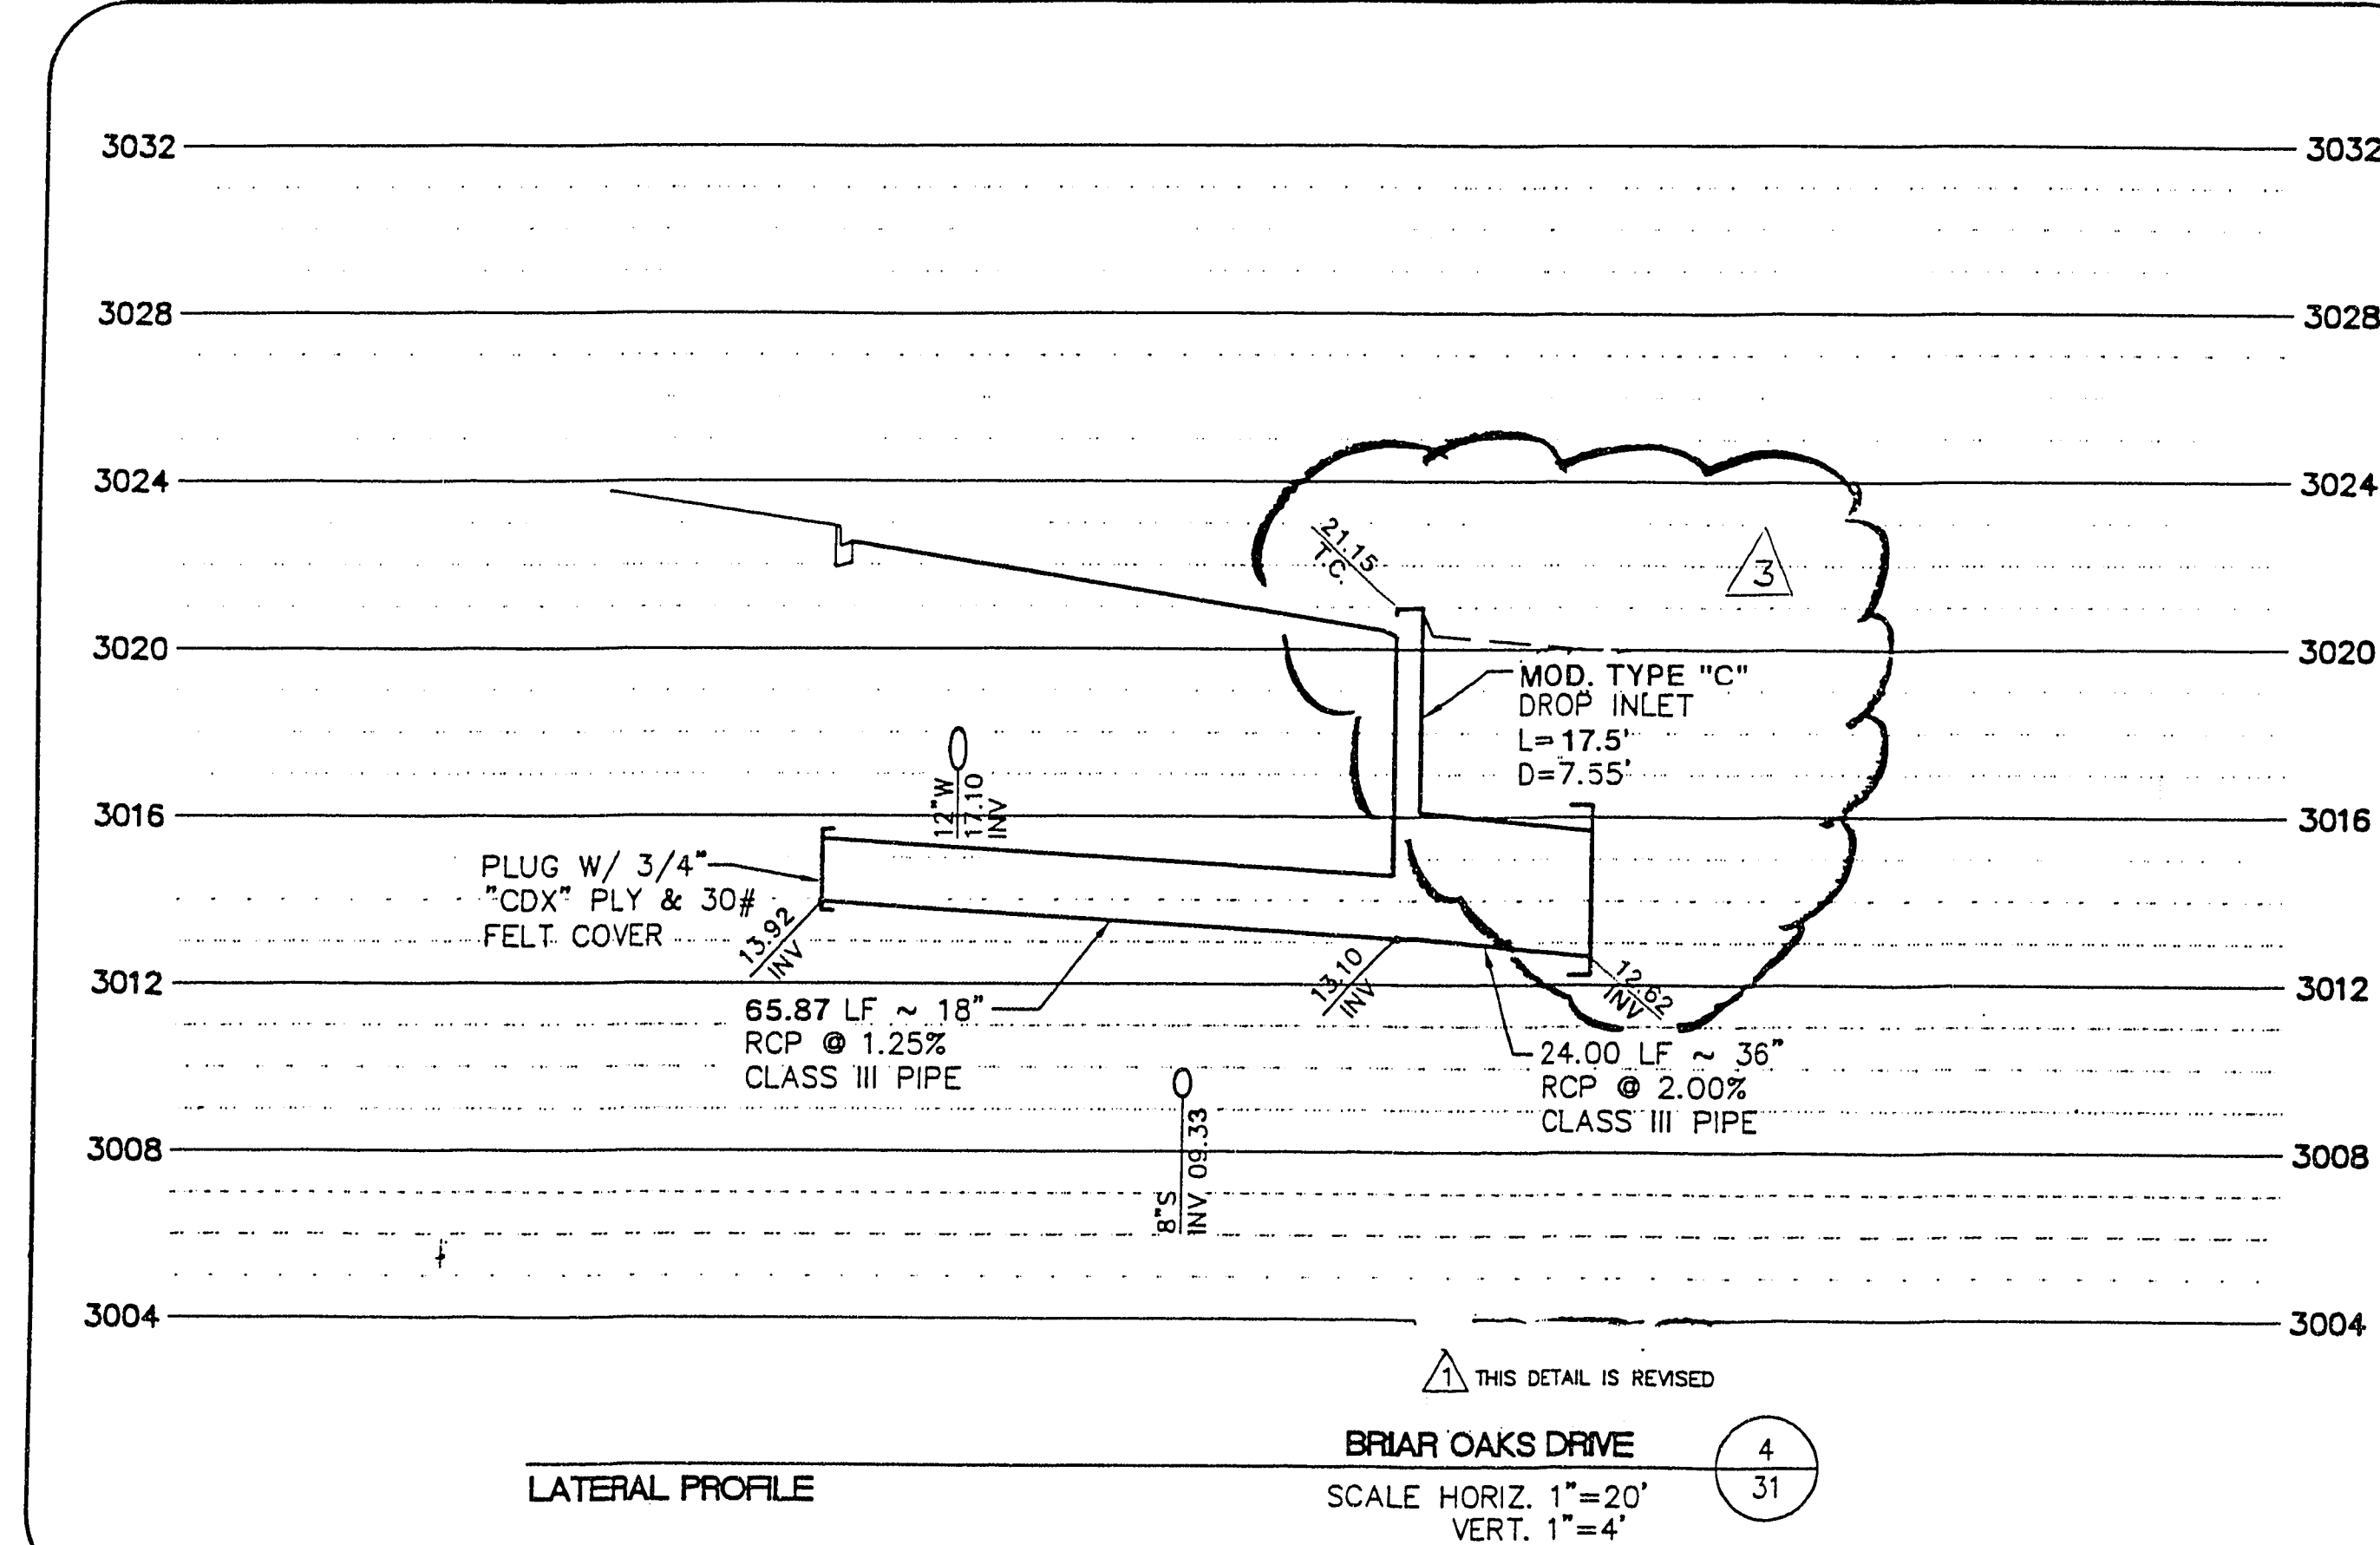
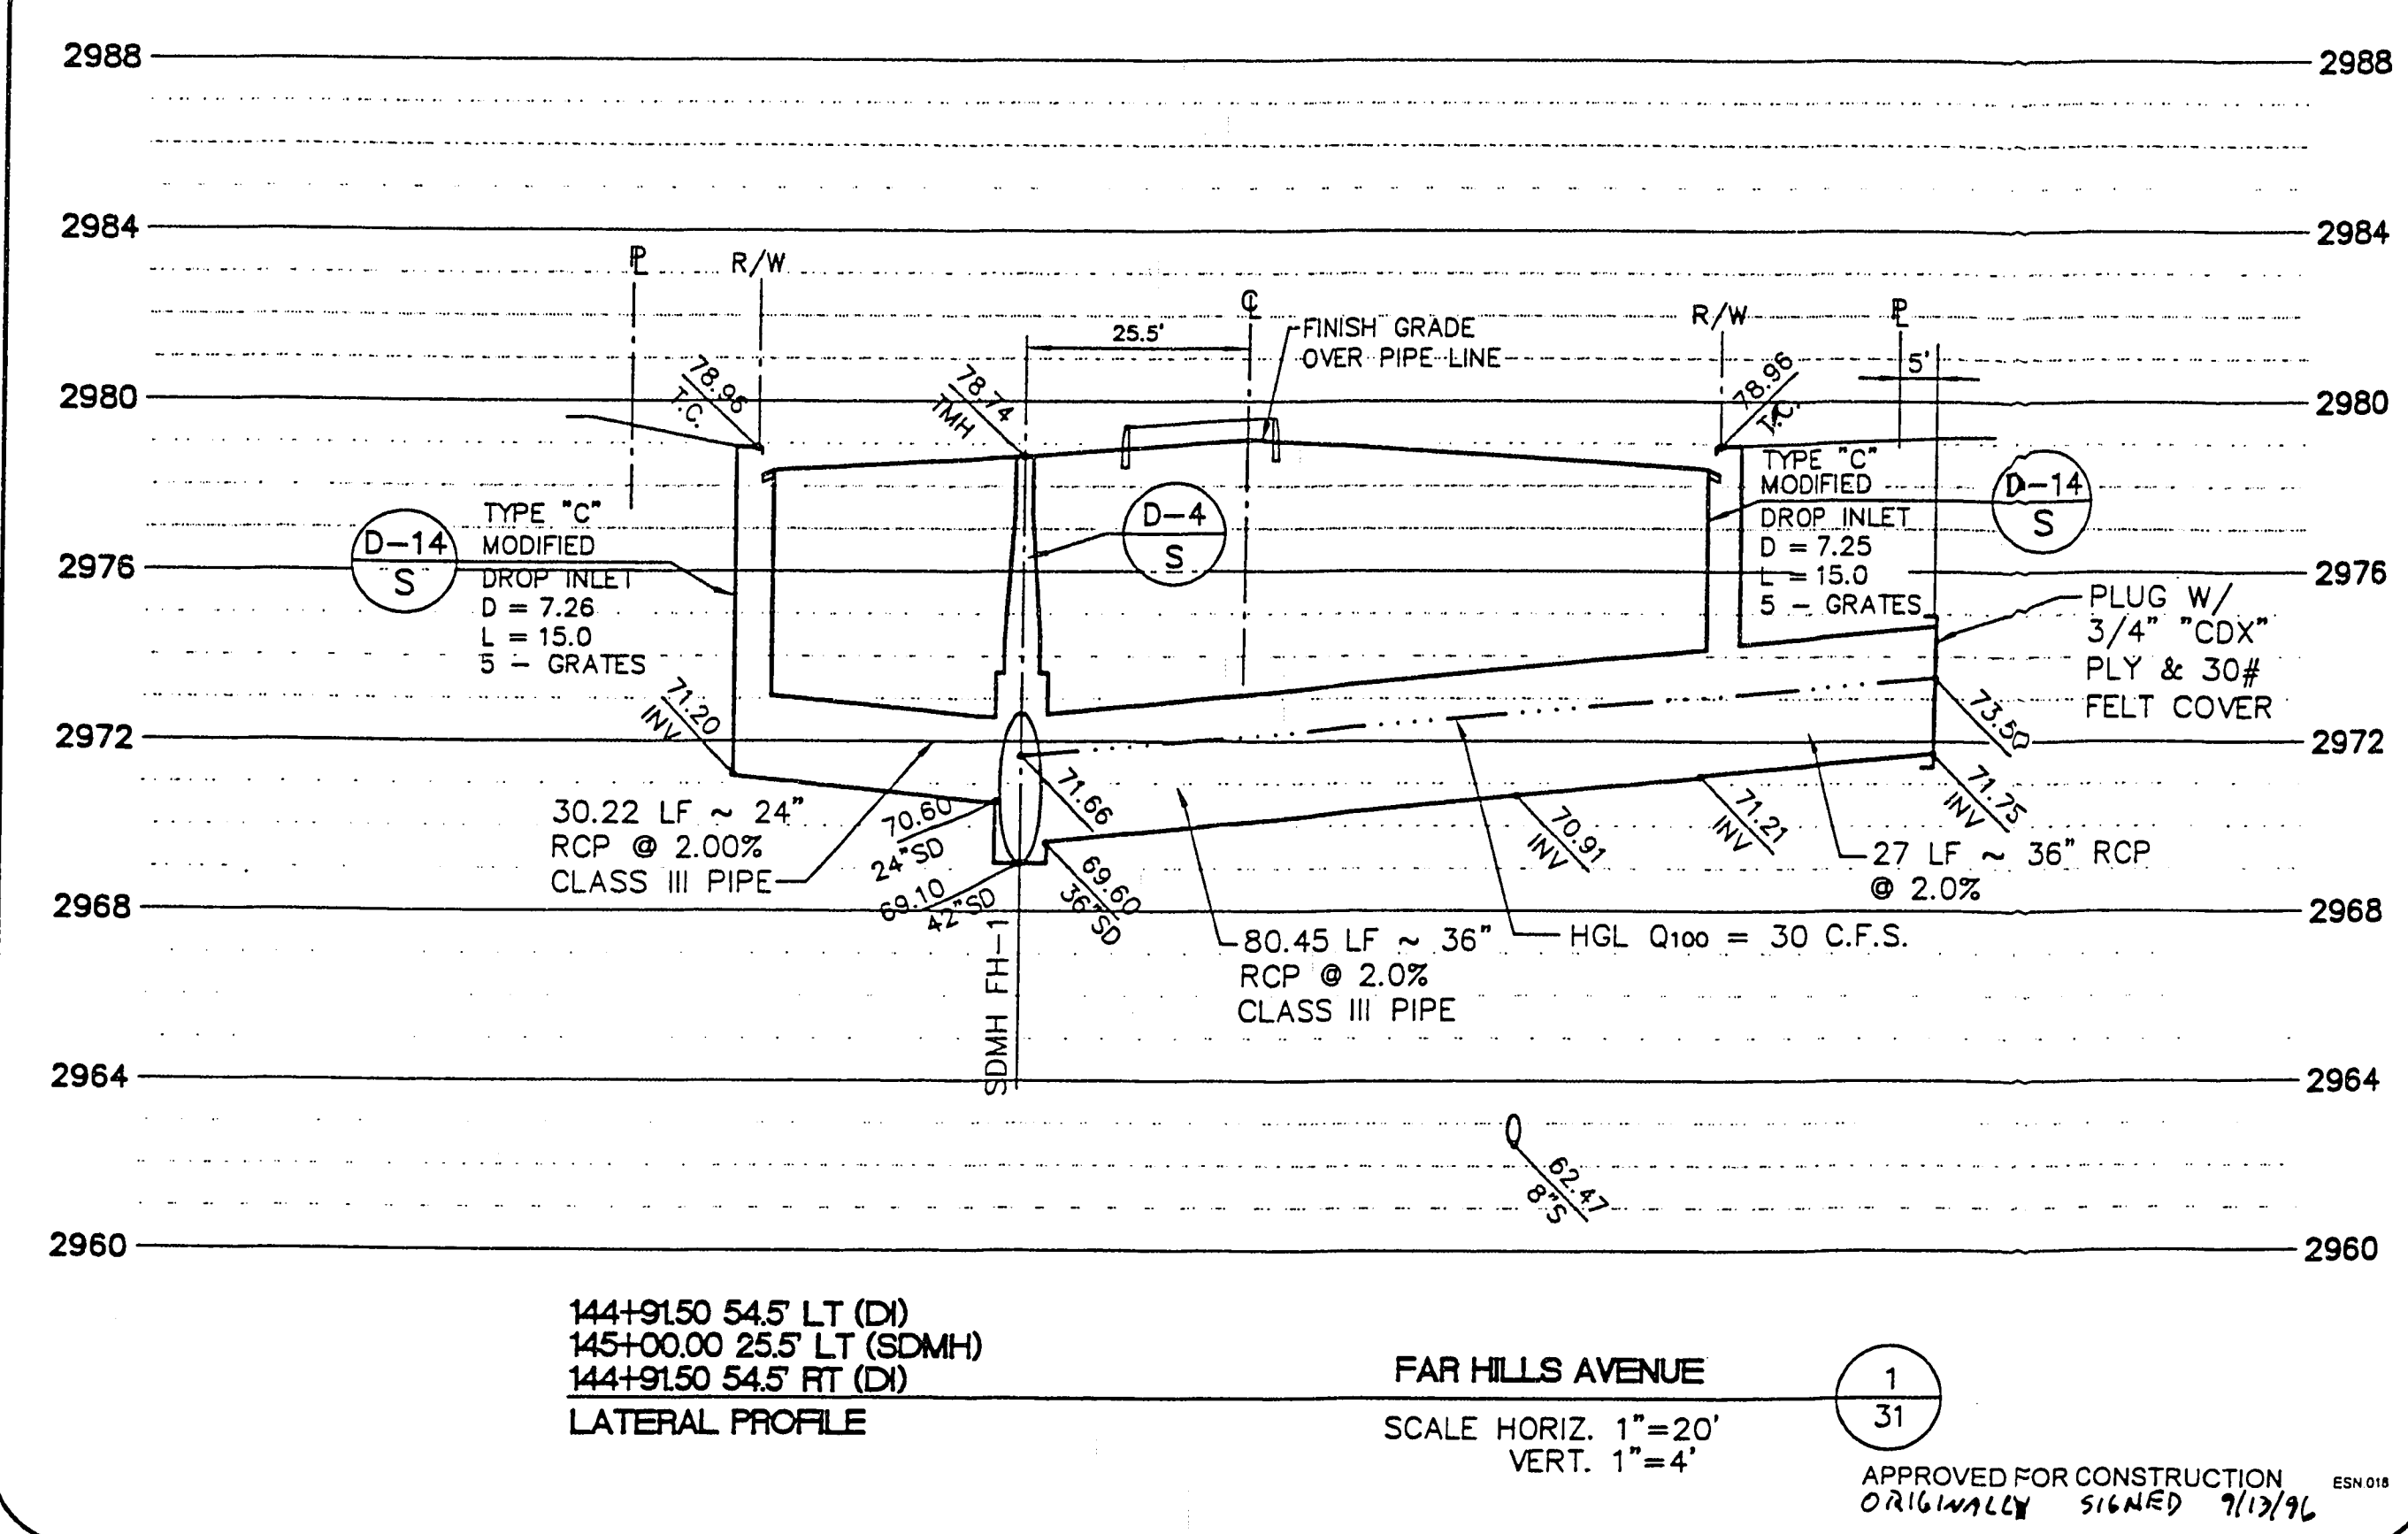


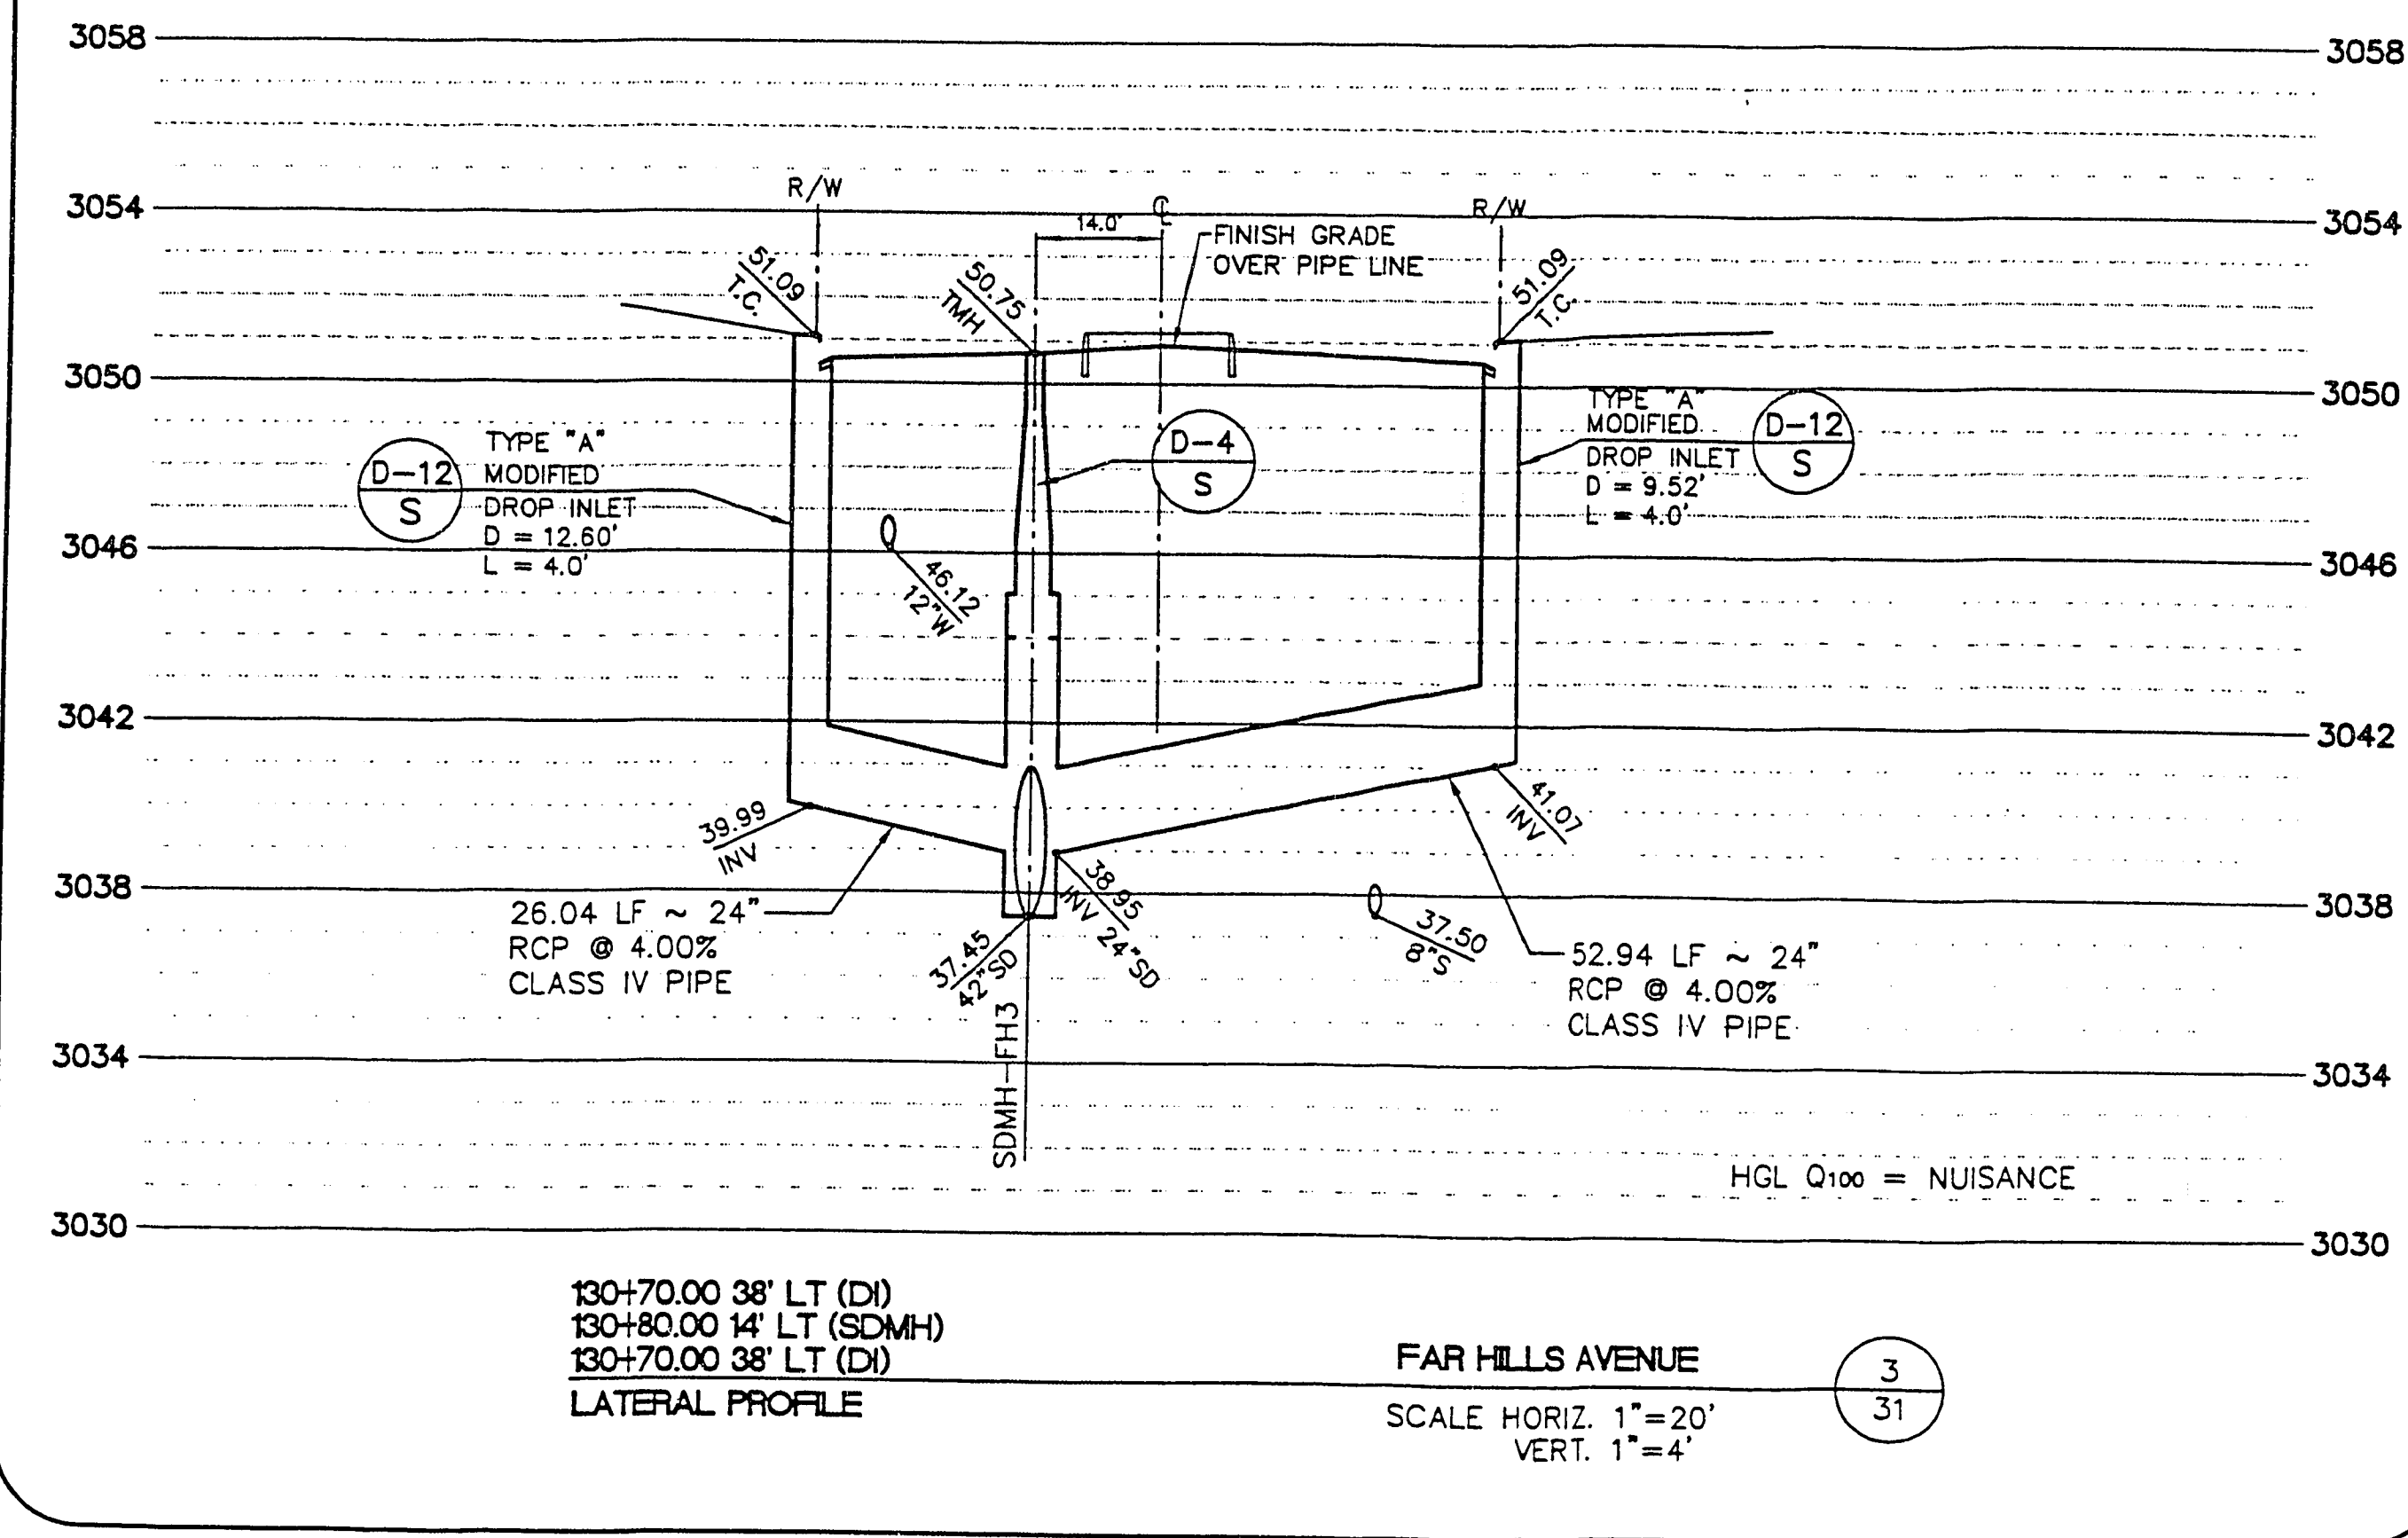

RECOMMENDED BY: CHRISTOPHER W. ANDERSON
DATE: 11/14/96
R.P.E. NO. 5071

APPROVED FOR CONSTRUCTION
ORIGINAL SIGNED 11/14/96
DATE: 11/14/96

THE ARBORS AT SUMMERLIN
VILLAGE 11/12 UNIT 2B IMPROVEMENTS
FAR HILLS AVENUE - BRIAR OAKS DRIVE
STORM DRAIN LATERALS

ISSUE TO CONSTRUCT 10/07/96

SHEET
31
SHT 31 OF 45

FINAL SUBMITTAL