22-2-144

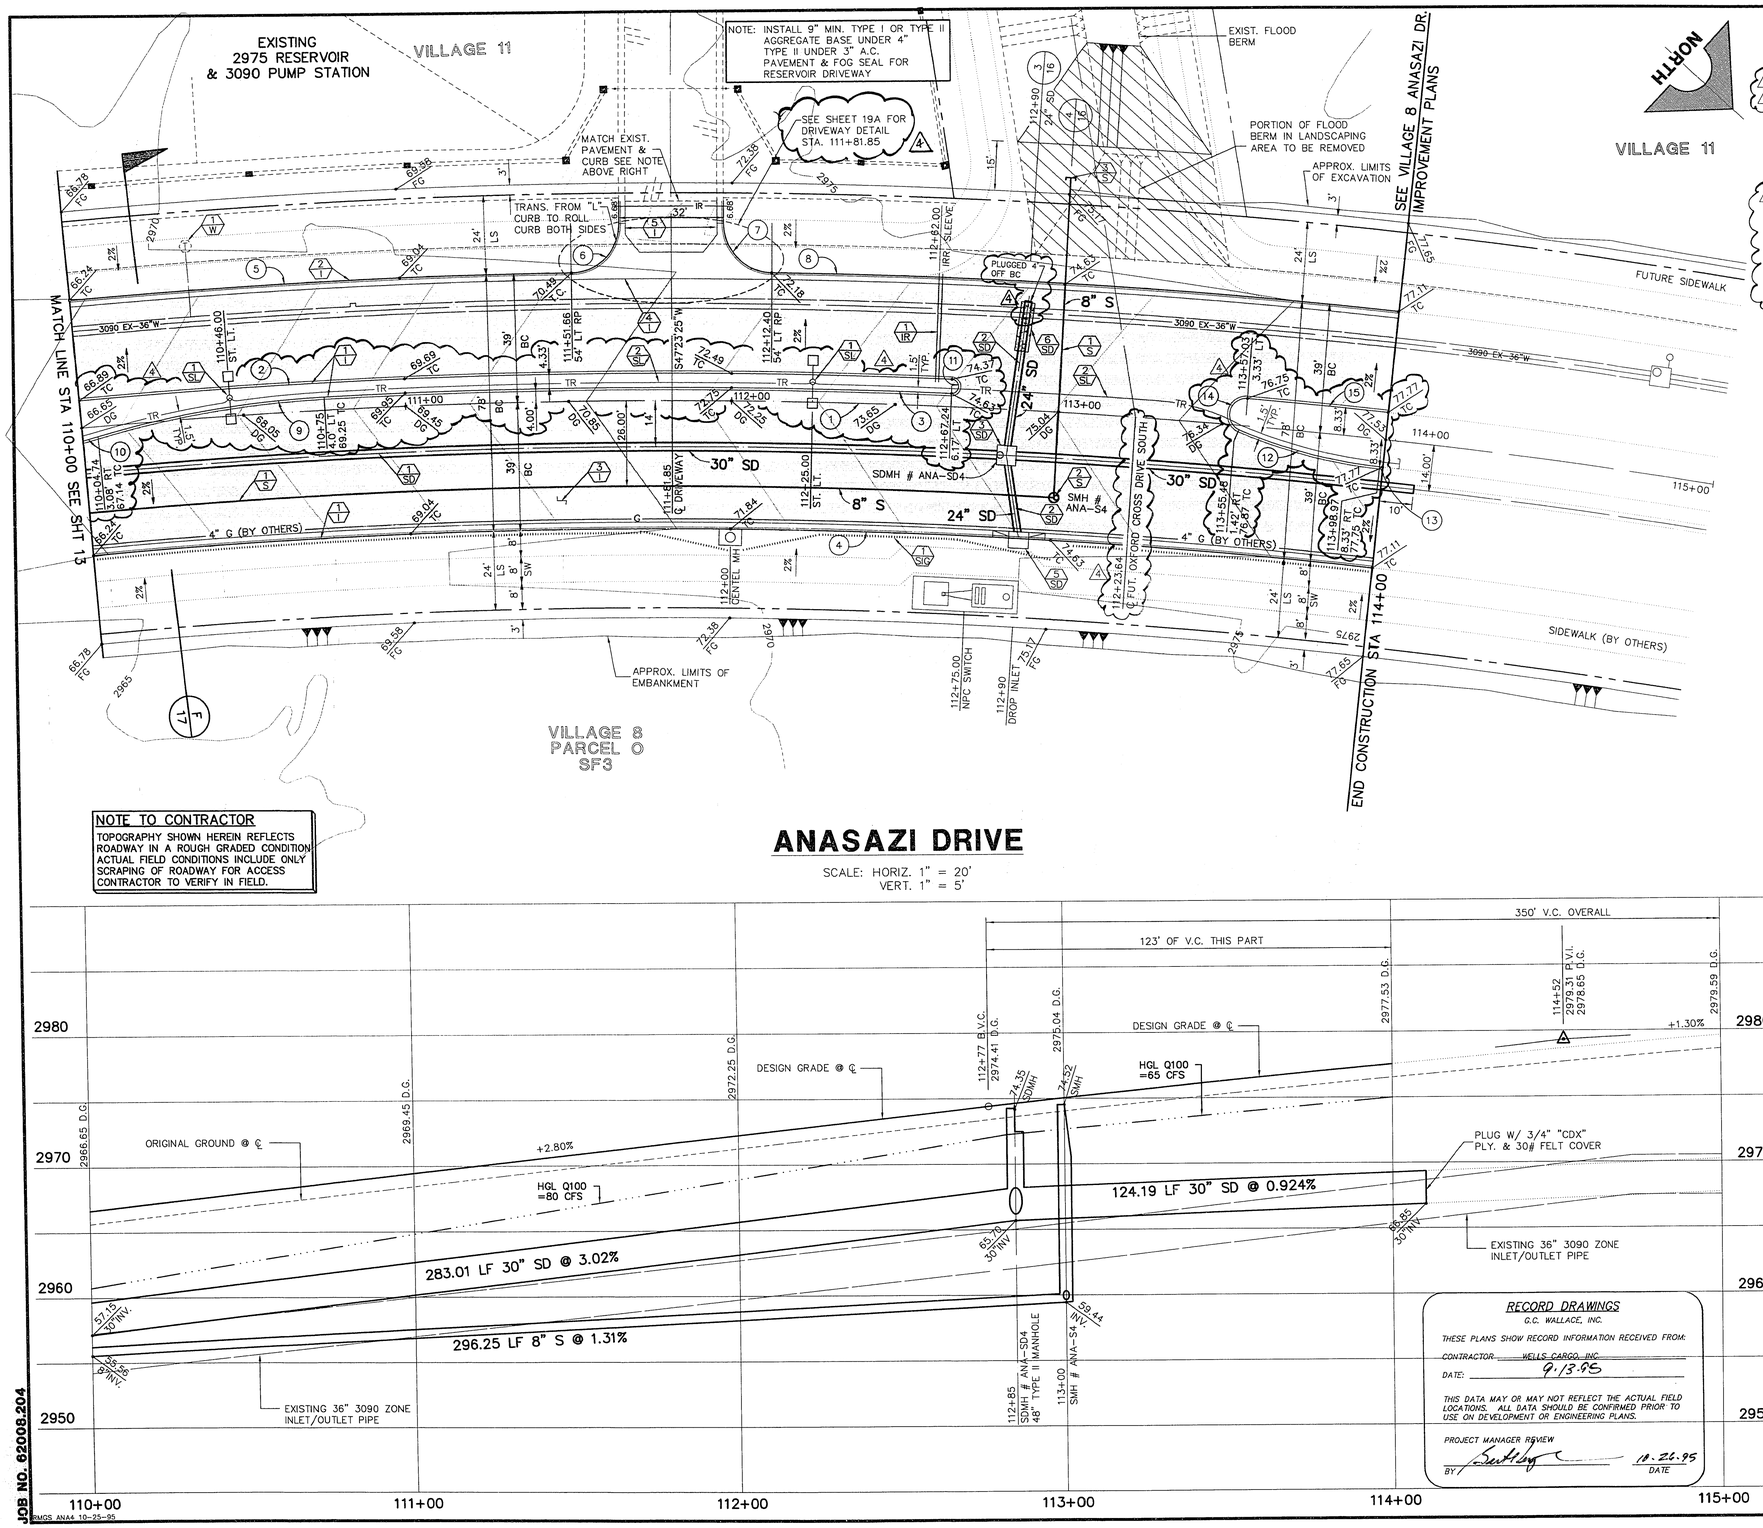

CURVE DATA

(1) INDICATES CURVE NUMBER

NO.	Δ	R	L	T	DESCRIPTION
1	11°27'33"	2000.00'	400.00'	200.67'	CENTERLINE
2	07°39'21"	2008.33'	268.35'	134.37'	ISBC
3	05°30'27"	2004.00'	192.63'	96.39'	ISBC
4	11°27'33"	1961.00'	392.20'	196.76'	BC
5	04°20'41"	2039.00'	154.62'	77.35'	BC
6	89°08'08"	15.00'	23.34'	14.78'	BC
7	89°08'06"	15.00'	23.34'	14.78'	BC
8	05°23'05"	2039.00'	191.63'	95.89'	BC
9	13°31'12"	300.00'	70.79'	35.56'	ISBC
10	00°55'07"	300.00'	4.81'	2.40'	ISBC
11	180°00'00"	2.17'	6.80'	infinite	ISBC
12	116°50'31"	150.00'	44.09'	22.21'	ISBC
13	00°01'45"	1991.67'	1.02'	0.51'	ISBC
14	16°57'23"	5.00'	14.13'	31.49'	ISBC
15	01°13'51"	2008.33'	43.15'	21.57'	ISBC

BC = BACK OF CURB
ISBC = ISLAND BACK OF CURB

CONSTRUCTION NOTES

IMPROVEMENTS

- (1/1) INSTALL "A" TYPE CURB (S-50 / S)
- (2/1) INSTALL "L" TYPE CURB & GUTTER (S-50 / S)
- (3/1) INSTALL AC PAVEMENT PER SECTION SHT. 17
- (4/1) INSTALL DRIVEWAY CROSS GUTTER (S-61 / S)
- (5/1) INSTALL DEPRESSED CURB & GUTTER (1 / 16)

WATER

- (1/W) ADJUST EXIST. TEST STATION TO GRADE

STORM DRAIN

- (1/SD) INSTALL 30" DIA. STORM DRAIN PIPE (U-20 / S)
- (2/SD) INSTALL 24" DIA. STORM DRAIN PIPE (U-20 / S)
- (3/SD) INSTALL STORM DRAIN MANHOLE (01,04 / S)
- (5/SD) INSTALL 6' TYPE "A" DROP INLET (D-12 / S)
- (6/SD) INSTALL CONCRETE ENCASEMENT

SEWER

- (1/S) INSTALL 8" DIA. SEWER PIPE (U-20 / S)
- (2/S) INSTALL SEWER MANHOLE (SD1-8 / CLV)
- (3/S) INSTALL PLUG

STREET LIGHTING

- (1/SL) INSTALL STREET LIGHT, SEE ELECTRICAL PLANS (E-2 / S)
- (2/SL) STREET LIGHT OR COMMON TRENCH, SEE ELECTRICAL PLANS

IRRIGATION

- (1/IR) INSTALL 2-4" SDR 35 PVC IRRIG. SLEEVES (U-18 / S)

TRAFFIC

- (1/SIG) INSTALL 2" INTERCONNECT

NO.	DESCRIPTION	DATE	APPROVAL
1	ADD PKY DETAIL. REVISE MEDIAN ISLAND AND ADD FUTURE OXFORD CROSS DR. SOUTH	10/25/95	
2	REMOVE OXFORD 24" STUB	5/15/95	

RECOMMENDED
BERT A. HUGHES
10259
R.P.E. NO.
DATE 11-2-95

REGISTERED PROFESSIONAL ENGINEER
STATE OF NEVADA
BERT A. HUGHES
CIVIL
10259

G.C. WALLACE, INC.
Engineering/Architecture
1555 SOUTH RAINBOW BLVD./LAS VEGAS, NEVADA 89102

SUMMERLIN
TOWN CENTER DRIVE - UNIT 3
ANASAZI DRIVE
PLAN & PROFILE
STA 110+00 TO 114+00

SHEET
14
SHT 14 OF 19

NOTE TO CONTRACTOR

TOPOGRAPHY SHOWN HEREIN REFLECTS ROADWAY IN A ROUGH GRADED CONDITION. ACTUAL FIELD CONDITIONS INCLUDE ONLY SCRAPING OF ROADWAY FOR ACCESS CONTRACTOR TO VERIFY IN FIELD.

ANASAZI DRIVE

SCALE: HORIZ. 1" = 20'
VERT. 1" = 5'

RECORD DRAWINGS
G.C. WALLACE, INC.
THESE PLANS SHOW RECORD INFORMATION RECEIVED FROM:
CONTRACTOR: WELLS CARGO, INC.
DATE: 9.13.95
THIS DATA MAY OR MAY NOT REFLECT THE ACTUAL FIELD LOCATIONS. ALL DATA SHOULD BE CONFIRMED PRIOR TO USE ON DEVELOPMENT OR ENGINEERING PLANS.
PROJECT MANAGER REVIEW
BY: [signature] DATE: 10.26.95

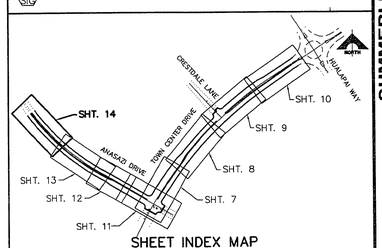

SHEET INDEX MAP

APPROVAL:

LAS VEGAS VALLEY WATER DISTRICT — DATE

JOB NO. 62008.204

107-V2310