22-2-145

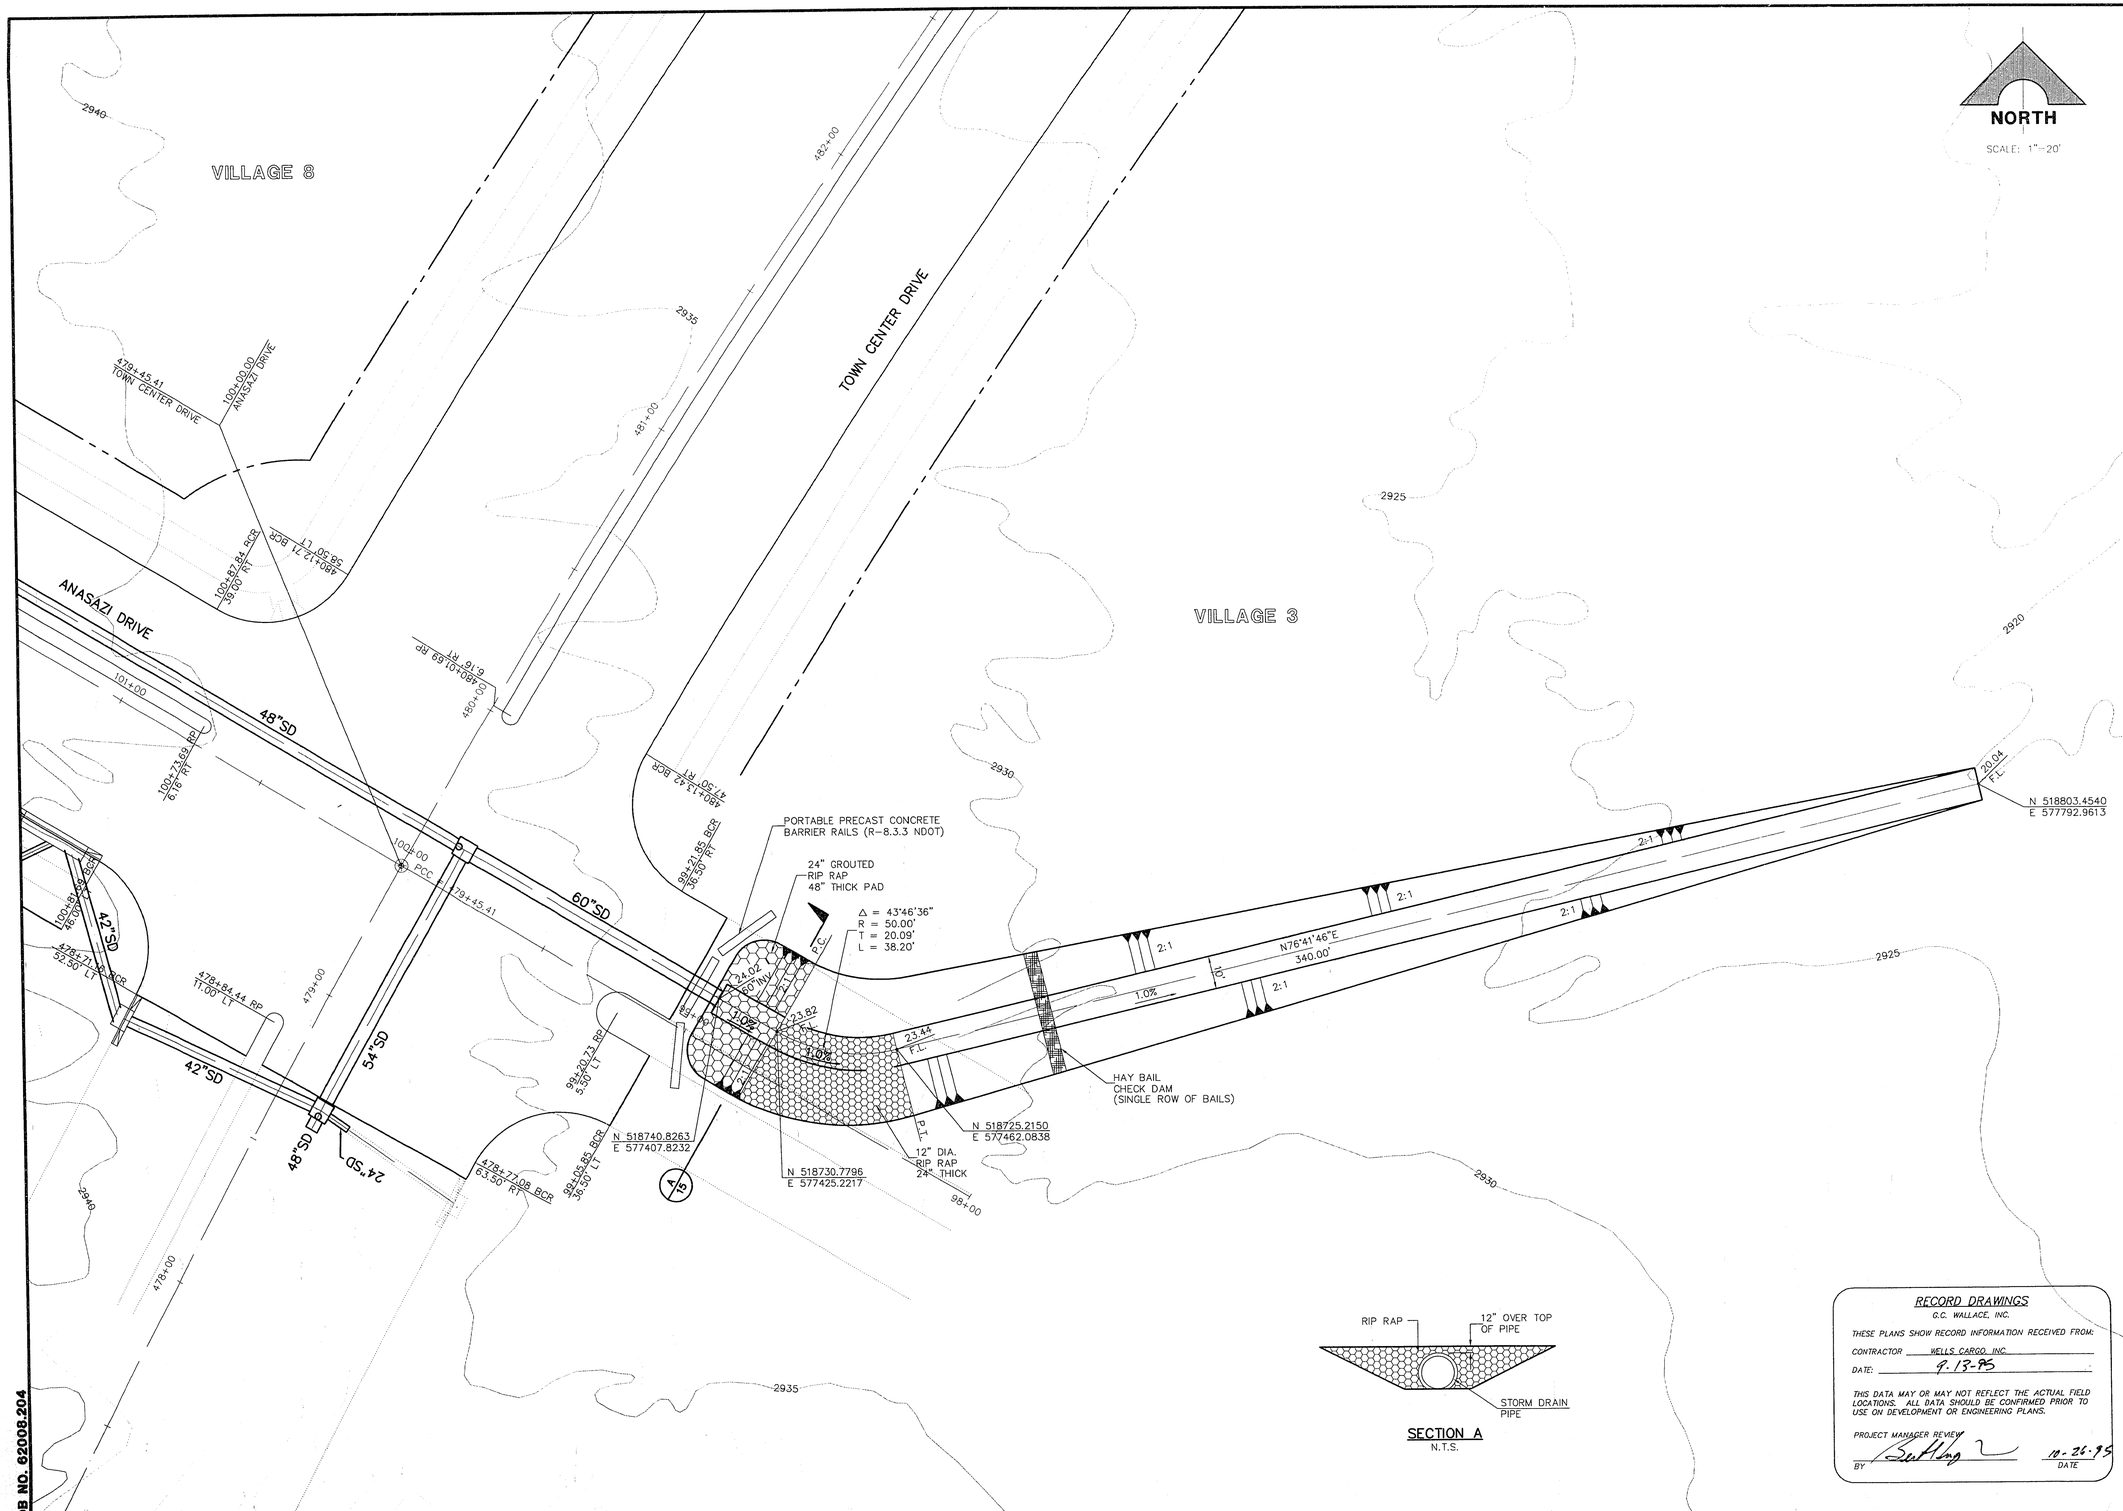

RECORD DRAWINGS
G.C. WALLACE, INC.
THESE PLANS SHOW RECORD INFORMATION RECEIVED FROM:
CONTRACTOR WELLS CARGO, INC.
DATE: 9-13-95
THIS DATA MAY OR MAY NOT REFLECT THE ACTUAL FIELD LOCATIONS. ALL DATA SHOULD BE CONFIRMED PRIOR TO USE ON DEVELOPMENT OR ENGINEERING PLANS.
PROJECT MANAGER REVIEW
BY
10-26-95
DATE

REV.	DATE	DESCRIPTION	DATE	APPROVAL

RECOMMENDED
BERT A. HUGHES
R.P.E. NO. 10259
DATE 11/29/94

REGISTERED PROFESSIONAL ENGINEER-STATE OF NEVADA
BERT A. HUGHES
CIVIL
10259

G.C. WALLACE, INC.
Engineering/Architecture 1555 SOUTH RAINBOW BLVD/LAS VEGAS, NEVADA 89102

SUMMERLIN
TOWN CENTER DRIVE - UNIT 3
DRAINAGE CHANNEL

SHEET
15
SHT 15 OF 19

JOB NO. 62008.204
L.G. TCUSCHAN 11-17-94

107-V2310