



DATE: 01/10/2007 11:55 AM
 DRAWING: 107Y-4483-2A
 PROJECT: 107Y-4483-2A

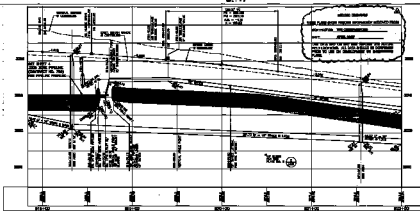

APPROVAL: *[Signature]*
 DATE: 01/10/2007

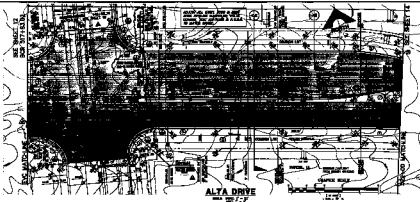