


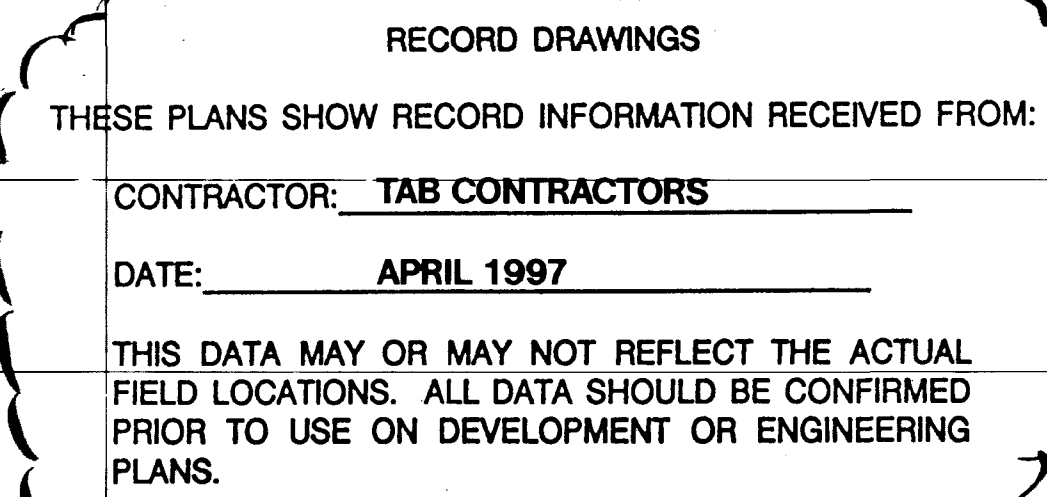

NOTE:  
FOR TRAFFIC SIGNAL CONDUIT SEE SIGNAGE AND  
STRIPING PLAN 1, SHEET 60.

## IMPROVEMENTS

- WATER**

- |                                                                                     |                                                                        |                                                                                     |
|-------------------------------------------------------------------------------------|------------------------------------------------------------------------|-------------------------------------------------------------------------------------|
|                                                                                     | INSTALL WATER PIPES PER SUMMERLIN STD. U-20                            |                                                                                     |
|  | INSTALL 12" DIA. GATE VALVE & BOX                                      |  |
|  | INSTALL 8" DIA. GATE VALVE & BOX                                       |  |
|  | INSTALL 12"x12"x12" TEE                                                |                                                                                     |
|  | INSTALL 12"x12"x12"x12" CROSS                                          |                                                                                     |
|  | INSTALL 12"x12" ELBOW                                                  |                                                                                     |
|  | INSTALL 12"x12"x8" TEE                                                 |                                                                                     |
|  | INSTALL 12"x12"x8"x6" CROSS                                            |                                                                                     |
|  | INSTALL 2" TEMP. BLOW-OFF & CAP                                        |  |
|  | INSTALL FIRE HYDRANT ASSEMBLY COMPLETE PER                             |                                                                                     |
|  | IRRIGATION SLEEVE                                                      |  |
|  | EXISTING GATE VALVE MUST BE IN CLOSED POSITION PRIOR TO REMOVAL OF CAP |                                                                                     |

**STORM DRAIN**

- |                                                   |                                                                |
|---------------------------------------------------|----------------------------------------------------------------|
| INSTALL STORM DRAIN PIPES PER SUMMERLIN STD. U-20 |                                                                |
| 1<br>SD                                           | INSTALL STORM DRAIN MANHOLE                                    |
| 2<br>SD                                           | INSTALL 4' TYPE "A" DROP INLET                                 |
| 3<br>SD                                           | INSTALL TYPE "B" DROP INLET                                    |
| 4<br>SD                                           | INSTALL TYPE "C" MODIFIED DROP INLET<br>(SEE PLANS FOR LENGTH) |
| 5<br>SD                                           | INSTALL 6' TYPE "A" DROP INLET                                 |

**SEWER**

- INSTALL SEWER PIPES PER SUMMERLIN STD. U-20
- INSTALL SEWER MANHOLE
- SD1-8  
CLV

## STREET LIGHTING

- |                                                                                       |                                                     |                                                                                       |
|---------------------------------------------------------------------------------------|-----------------------------------------------------|---------------------------------------------------------------------------------------|
|  | INSTALL STREET LIGHT, SEE ELECTRICAL PLANS          |  |
|  | STREET LIGHT OR COMMON TRENCH, SEE ELECTRICAL PLANS |                                                                                       |

**TRAFFIC**

- 1  
SIG INSTALL 2-3" CONDUIT
- 2  
SIG INSTALL NO. 5 PULLBO.



**APPROVAL:**

127076 5/31/96  
LAS VEGAS VALLEY WATER DISTRICT DATE



**ALTA DRIVE  
PLAN & PROFILE  
STA 522+00 TO 527+00.00**

SHEET

14

SHT 14 OF 65

**FINAL SUBMITTAL**

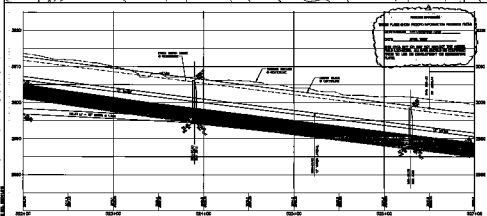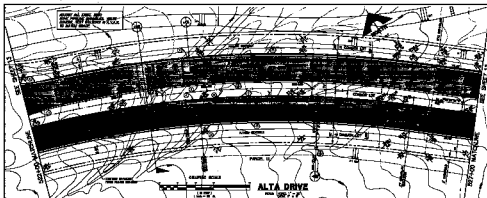






1074-4483-2A

14