

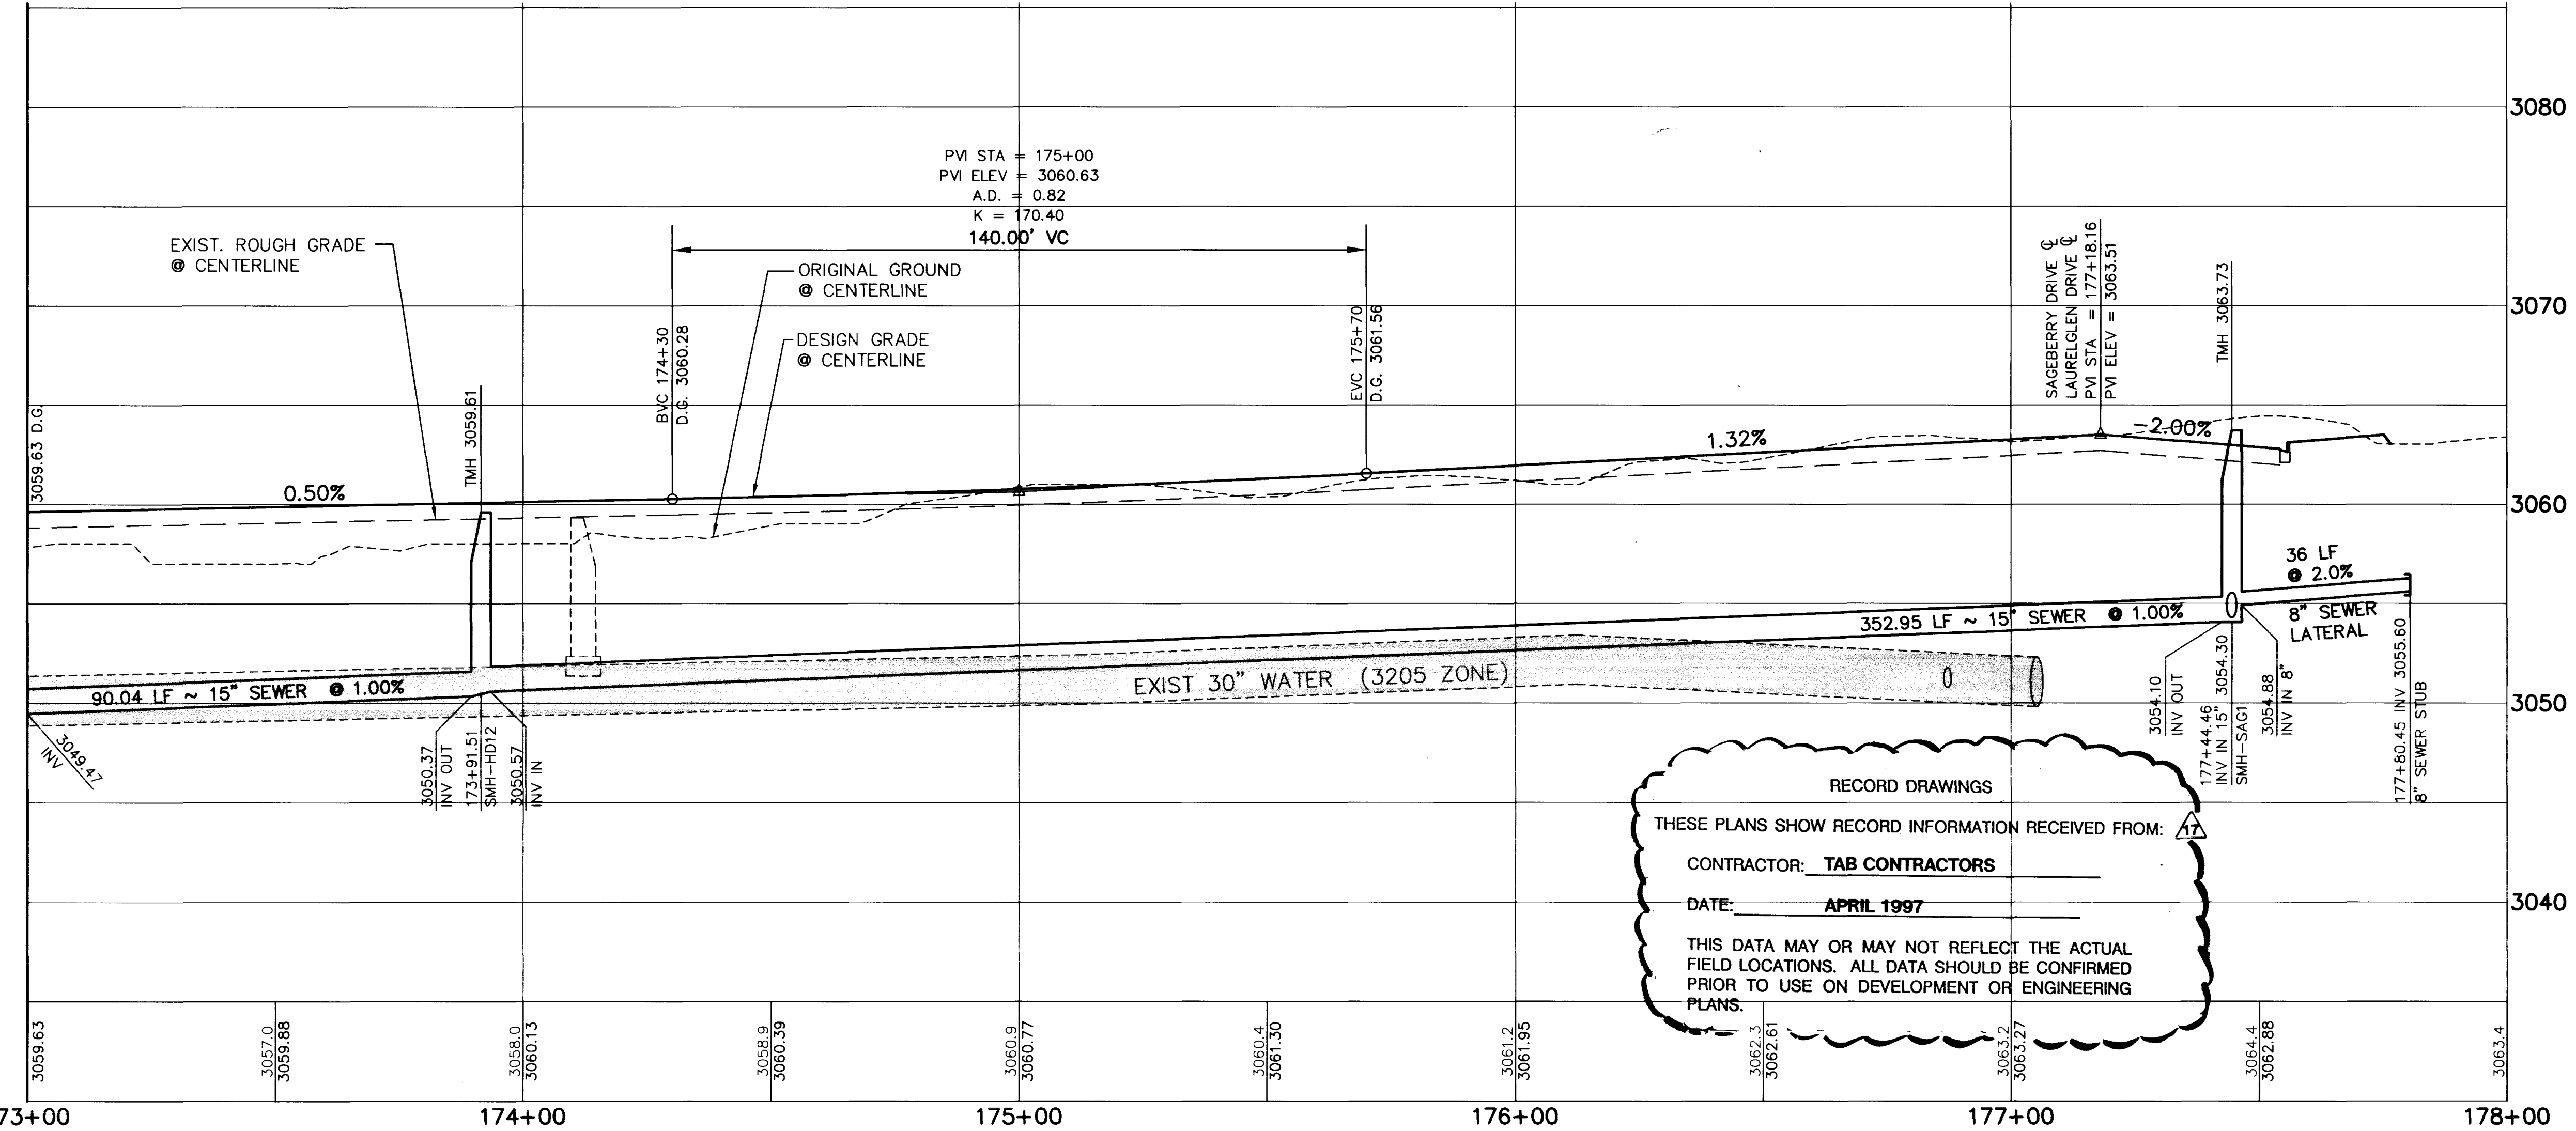
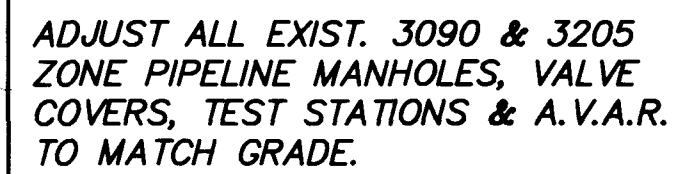


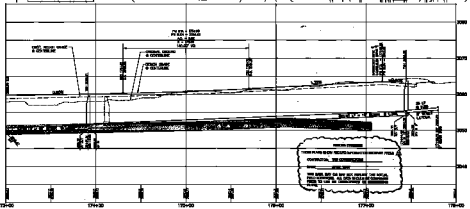

1274 Jb 8-28-96
LAS VEGAS VALLEY WATER DISTRICT DATE

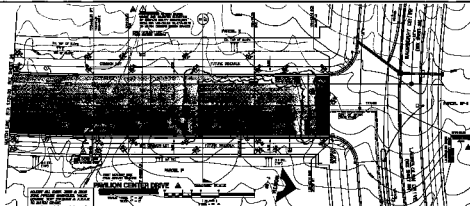



