


DATE: 10-01-96
JOB NO. 62011.212
DCN NO. UNIT 2A - 2
AGENCY NO.

GCW APPROVAL	DATE		
SUMMERLIN APPROVAL	DATE	AGENCY APPROVAL	DATE

PLEASE REVIEW AND FORWARD A COPY OF SIGNED NOTICE TO GCW

REVISION DESCRIPTION: REVISE SOUTHERLY DROP INLET ON ALTA DRIVE STA. 529+09.23 FROM 6' MODIFIED TYPE "C" TO 12' TYPE "A".

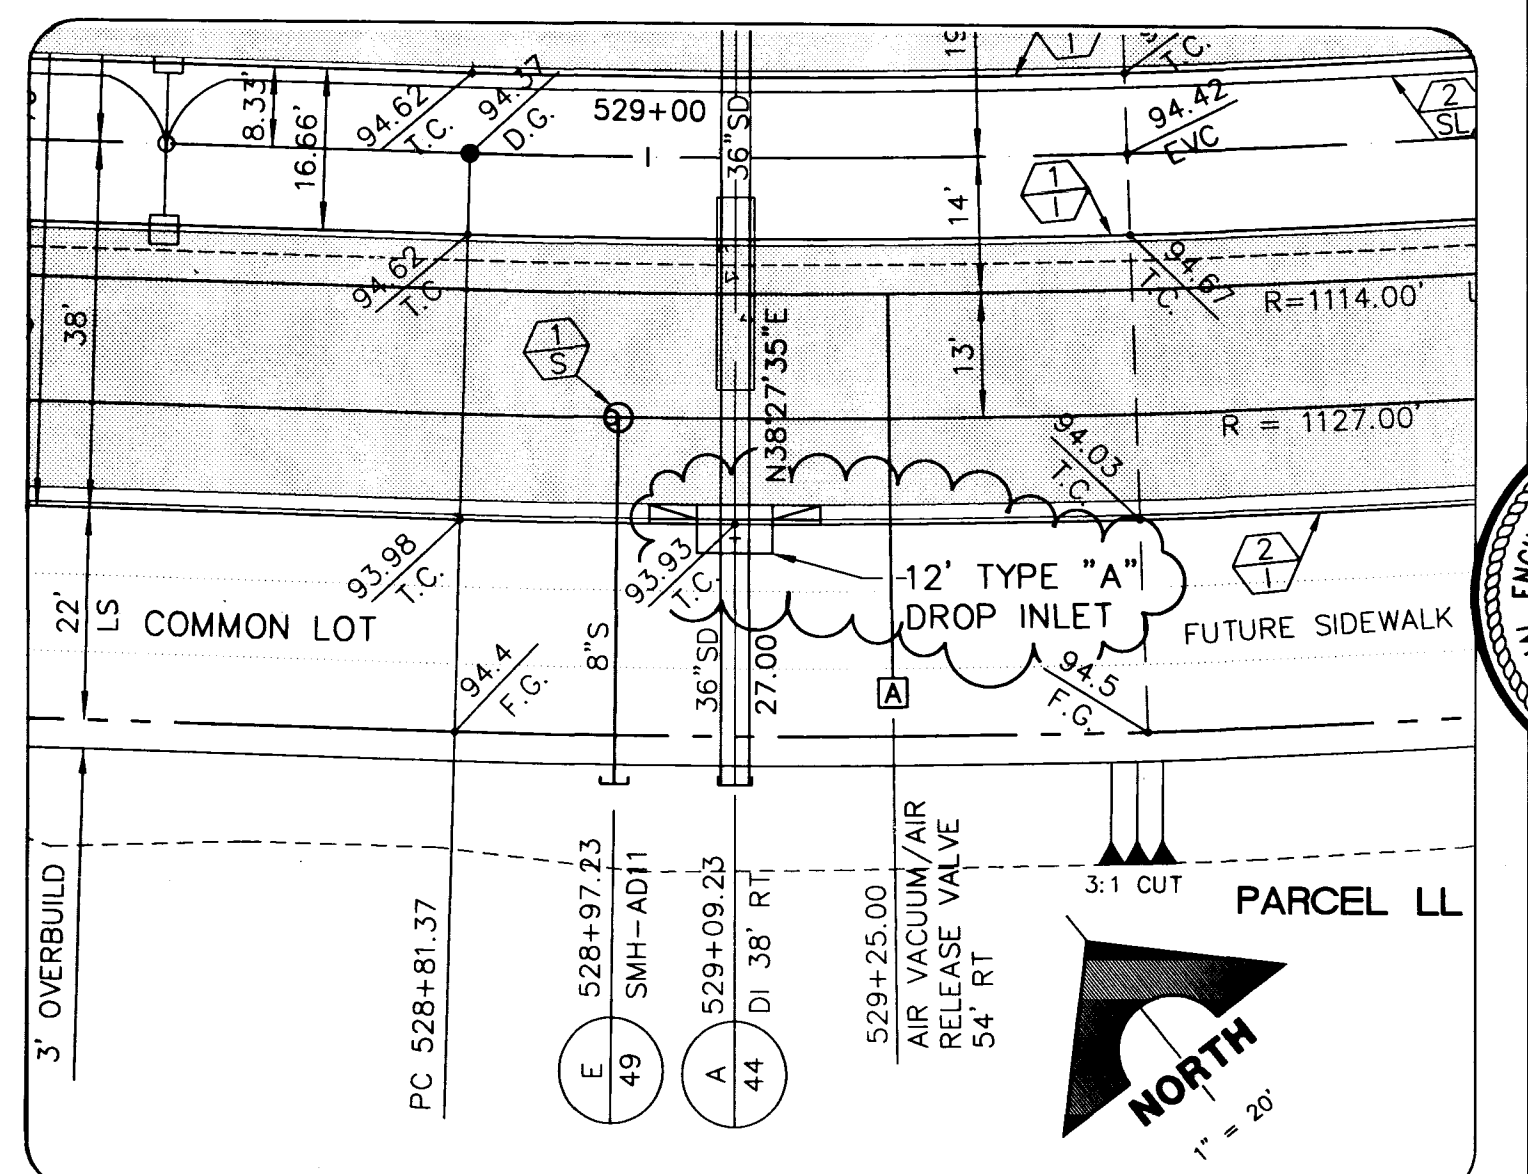

RAS 10-01-96 2AADDGN.DWG


DATE: 10-01-96
JOB NO. 62011.212
DCN NO. UNIT 2A - 1
AGENCY NO.

GCW APPROVAL _____ DATE _____

SUMMERLIN APPROVAL _____ DATE _____ AGENCY APPROVAL _____ DATE _____

PLEASE REVIEW AND FORWARD A COPY OF SIGNED NOTICE TO GCW

REVISION DESCRIPTION: REVISE SOUTHERLY DROP INLET ON ALTA DRIVE STA. 529+09.23
FROM 6' MODIFIED TYPE "C" TO 12' TYPE "A".

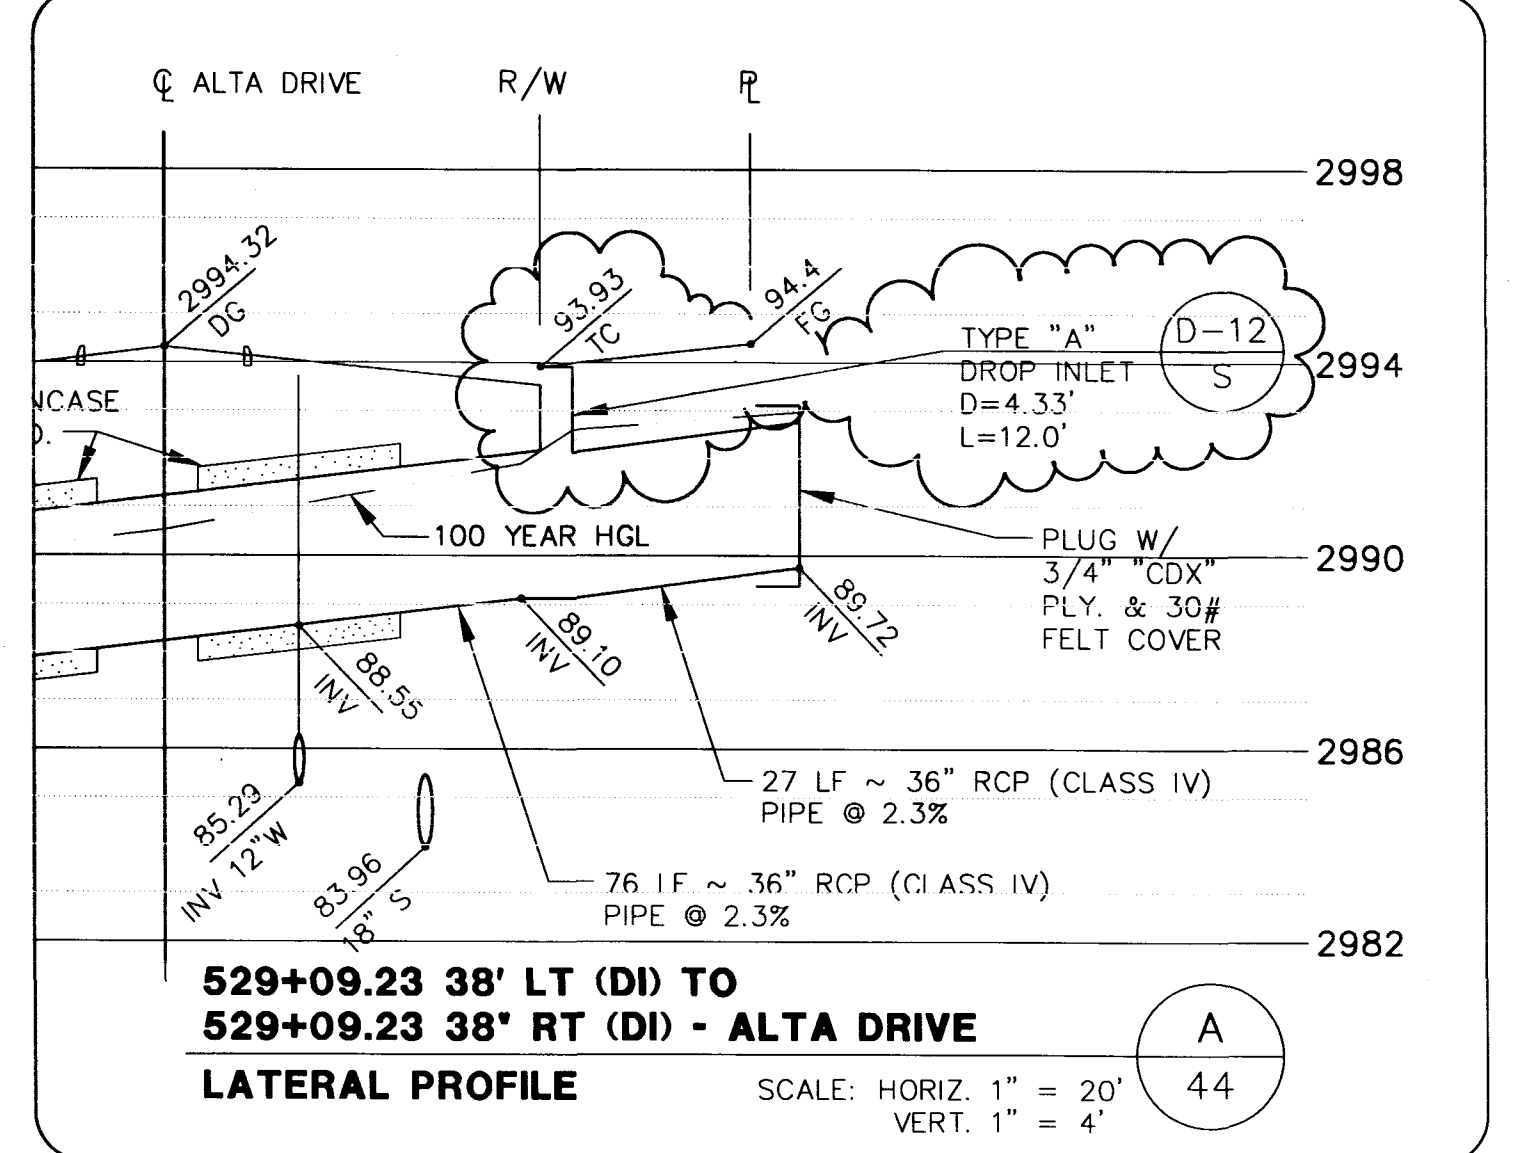


RAS 10-01-96 2AADD CN.DWG





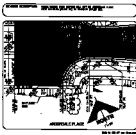






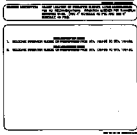






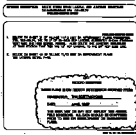






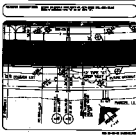












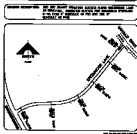






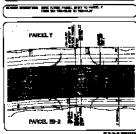






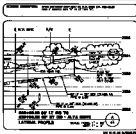


