G.C. WALLACE, INC.
Engineering/Architecture
MAIN: 1555 SOUTH RAINBOW BLVD. LAS VEGAS, NV 89102 (702) 363-1200
SUMMERLIN: 1645 VILLAGE CENTER CIR. LAS VEGAS, NV 89134 SUITE #181 (702) 363-0991

DRAWING CHANGE NOTICE:

DATE: 02-10-97
PROJECT NAME: VILLAGE 11/12 UNIT 2A IMPROVEMENTS
ALTA DRIVE
JOB NO. 62011.212
DCN NO. UNIT 2A - 10
AGENCY NO.

GCW APPROVAL DATE
SUMMERLIN APPROVAL DATE
AGENCY APPROVAL DATE

PLEASE REVIEW AND FORWARD A COPY OF SIGNED NOTICE TO GCW

REVISION DESCRIPTION: ADJUST TC ELEVATIONS ON ALTA DRIVE ON WEST SIDE OF HUGHES INTERSECTION SHEET 12.

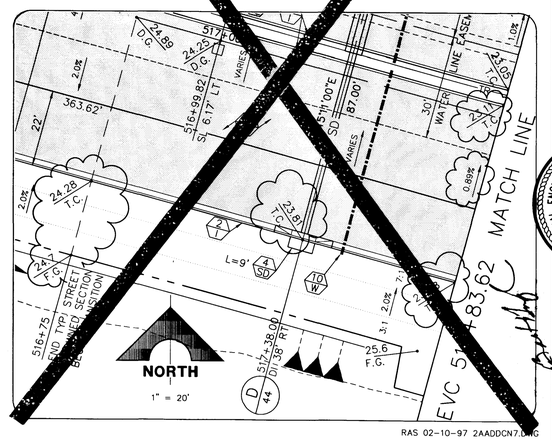

RECORD DRAWINGS

THESE PLANS SHOW RECORD INFORMATION RECEIVED FROM:

CONTRACTOR: **TAB CONTRACTORS**

DATE: **APRIL 1997**

THIS DATA MAY OR MAY NOT REFLECT THE ACTUAL FIELD LOCATIONS. ALL DATA SHOULD BE CONFIRMED PRIOR TO USE ON DEVELOPMENT OR ENGINEERING PLANS.

G.C. WALLACE, INC.
Engineering/Architecture
MAIN: 1555 SOUTH RAINBOW BLVD. LAS VEGAS, NV 89102 (702) 363-1200
SUMMERLIN: 1645 VILLAGE CENTER CIR. LAS VEGAS, NV 89134 SUITE #181 (702) 363-0991

DRAWING CHANGE NOTICE:

DATE: 04-07-97
PROJECT NAME: VILLAGE 11/12 UNIT 2A IMPROVEMENTS
ARBORDALE PLACE
JOB NO. 62011.212
DCN NO. UNIT 2A - 11
AGENCY NO.

GCW APPROVAL DATE
SUMMERLIN APPROVAL DATE
AGENCY APPROVAL DATE

PLEASE REVIEW AND FORWARD A COPY OF SIGNED NOTICE TO GCW

REVISION DESCRIPTION: ADD STEEL REINFORCEMENT BARS TO CIRCULAR CONCRETE RIBBON AT WEST END OF ARBORDALE PLACE.

1. CIRCULAR CONCRETE RIBBON AT WEST END OF ARBORDALE PLACE TO BE 9" THICK.
2. INCLUDE THREE NO. 5 STEEL REINFORCEMENT BARS LONGITUDINALLY AROUND CONCRETE RIBBON.
3. INCLUDE NO. 4 STEEL REINFORCEMENT BARS EVERY 18" RADIALLY AROUND CONCRETE RIBBON.

RAS 04-07-97 ARB-DCN2.DWG

G.C. WALLACE, INC.
Engineering/Architecture
MAIN: 1555 SOUTH RAINBOW BLVD. LAS VEGAS, NV 89102 (702) 363-1200
SUMMERLIN: 1645 VILLAGE CENTER CIR. LAS VEGAS, NV 89134 SUITE #181 (702) 363-0991

DRAWING CHANGE NOTICE:

DATE: 01-13-97
PROJECT NAME: VILLAGE 11/12 UNIT 2A IMPROVEMENTS
STREET LIGHT REVISIONS
JOB NO. 62011.212
DCN NO. UNIT 2A - 9
AGENCY NO.

GCW APPROVAL DATE
SUMMERLIN APPROVAL DATE
AGENCY APPROVAL DATE

PLEASE REVIEW AND FORWARD A COPY OF SIGNED NOTICE TO GCW

REVISION DESCRIPTION: RELOCATE AND ADD STREET LIGHTS AS SHOWN.

ALTA DRIVE

OLD STATIONS	** NEW STATIONS
506+80	506+90
508+70	508+68
----	510+73.01
519+09.16	519+10.12
535+08	534+99
537+04	536+36
----	537+73
539+00	539+10

PAVILION CENTER DRIVE
~~HUSTLE DRIVE~~

OLD STATIONS	** NEW STATIONS
159+70	159+58
161+55	161+32
163+40	163+06
----	164+79
167+08	166+34
168+80	167+90
170+50	169+45
----	171+00
172+20	172+52
173+90	174+03

SAGEBERRY DRIVE

OLD STATIONS	** NEW STATIONS
----	108+41
----	107+40.3
----	106+23.67
105+65	105+31
103+65	103+43

LAURELGLEN DRIVE

OLD STATIONS	NEW STATIONS
115+10	114+88
116+90	116+47

** NOTE THE ADDITION OF STREET LIGHTS AS A RESULT OF RESPACING AND PRIOR OMISSION.

RAS 01-13-97 2ASLDCN6.DWG

NO.	DESCRIPTION	DATE	APPROVAL
1	05/05/98 RECORD DRAWING INFORMATION		

RECOMMENDED
CHRISTOPHER W. ANDERSON
5071 R.P.E. NO. DATE

ENGINEER - STATE OF NEVADA
LICENSED PROFESSIONAL
CHRISTOPHER ANDERSON
CIVIL

G.C. WALLACE, INC.
Engineering/Architecture
1555 SOUTH RAINBOW BLVD. LAS VEGAS, NEVADA 89102

SUMMERLIN
VILLAGE 11/12 THE ARBORS - UNIT 2A
D.C.N. REVISION SHEET 2

SHEET
65B
SHT 65B OF 65

JOB NO. 62011.212

C:\dwg\112dcn.dwg Thu Apr 23 08:10:10 1998

9603

1074-4463-2A

G.C. WALLACE, INC.
Engineering/Architecture

DRAWING CHANGE NOTICE:

 

G.C. WALLACE, INC.
Engineering/Architecture

DRAWING CHANGE NOTICE:

G.C. WALLACE, INC.
Engineering/Architecture

DRAWING CHANGE NOTICE:

G.C. WALLACE, INC.
Engineering/Architecture

VILLAGE TI/TS THE ARBORS - UNIT 2A
D.O.R. REVISION SHEET 6

SHEET
65B