
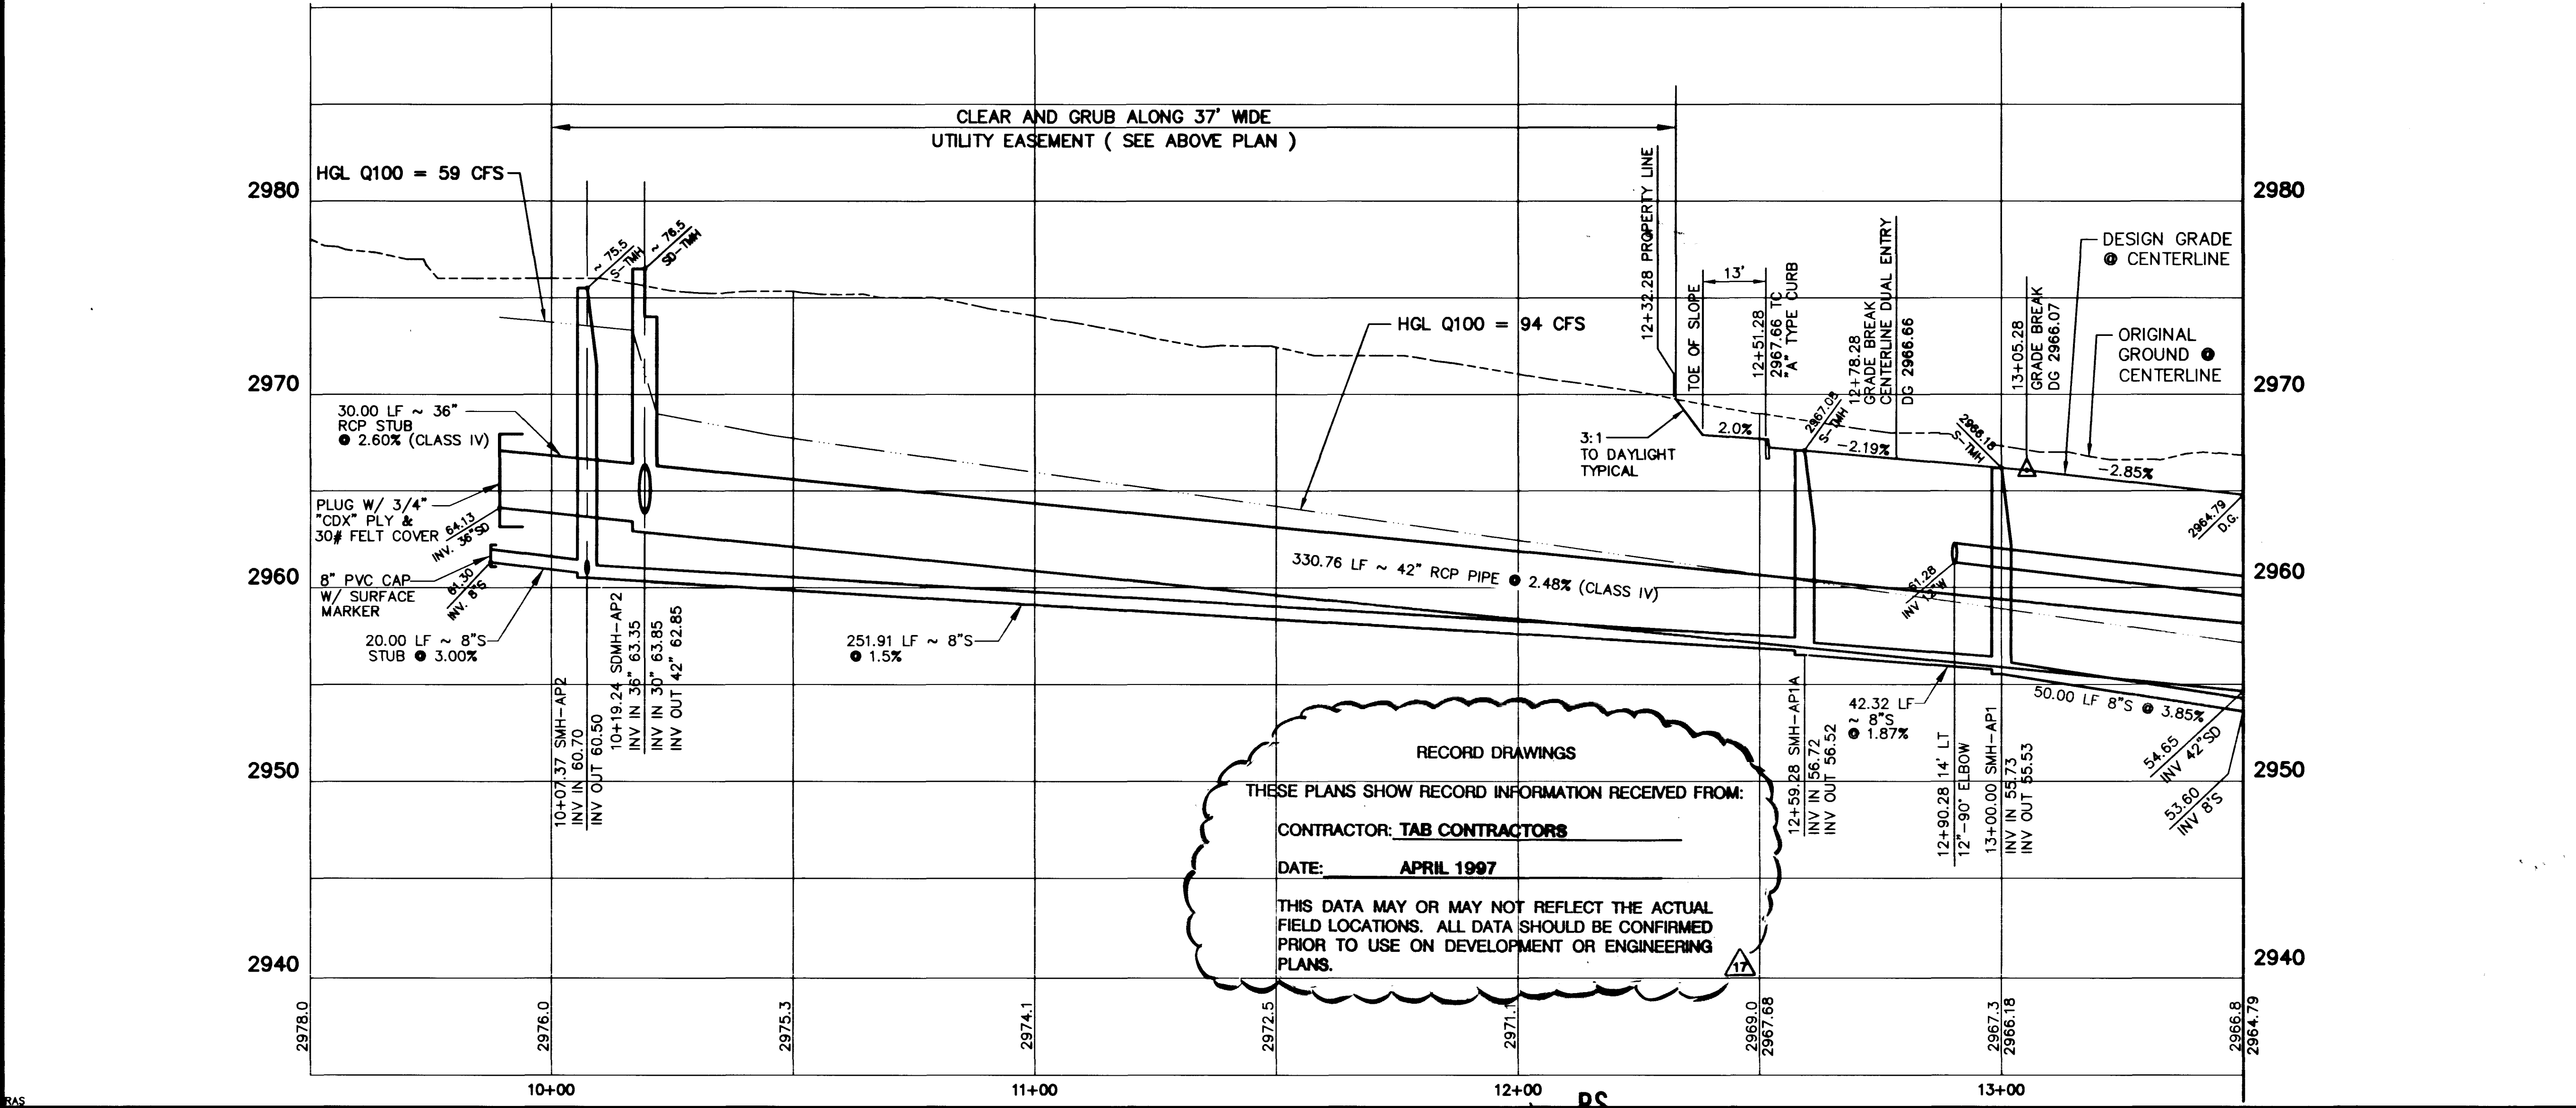


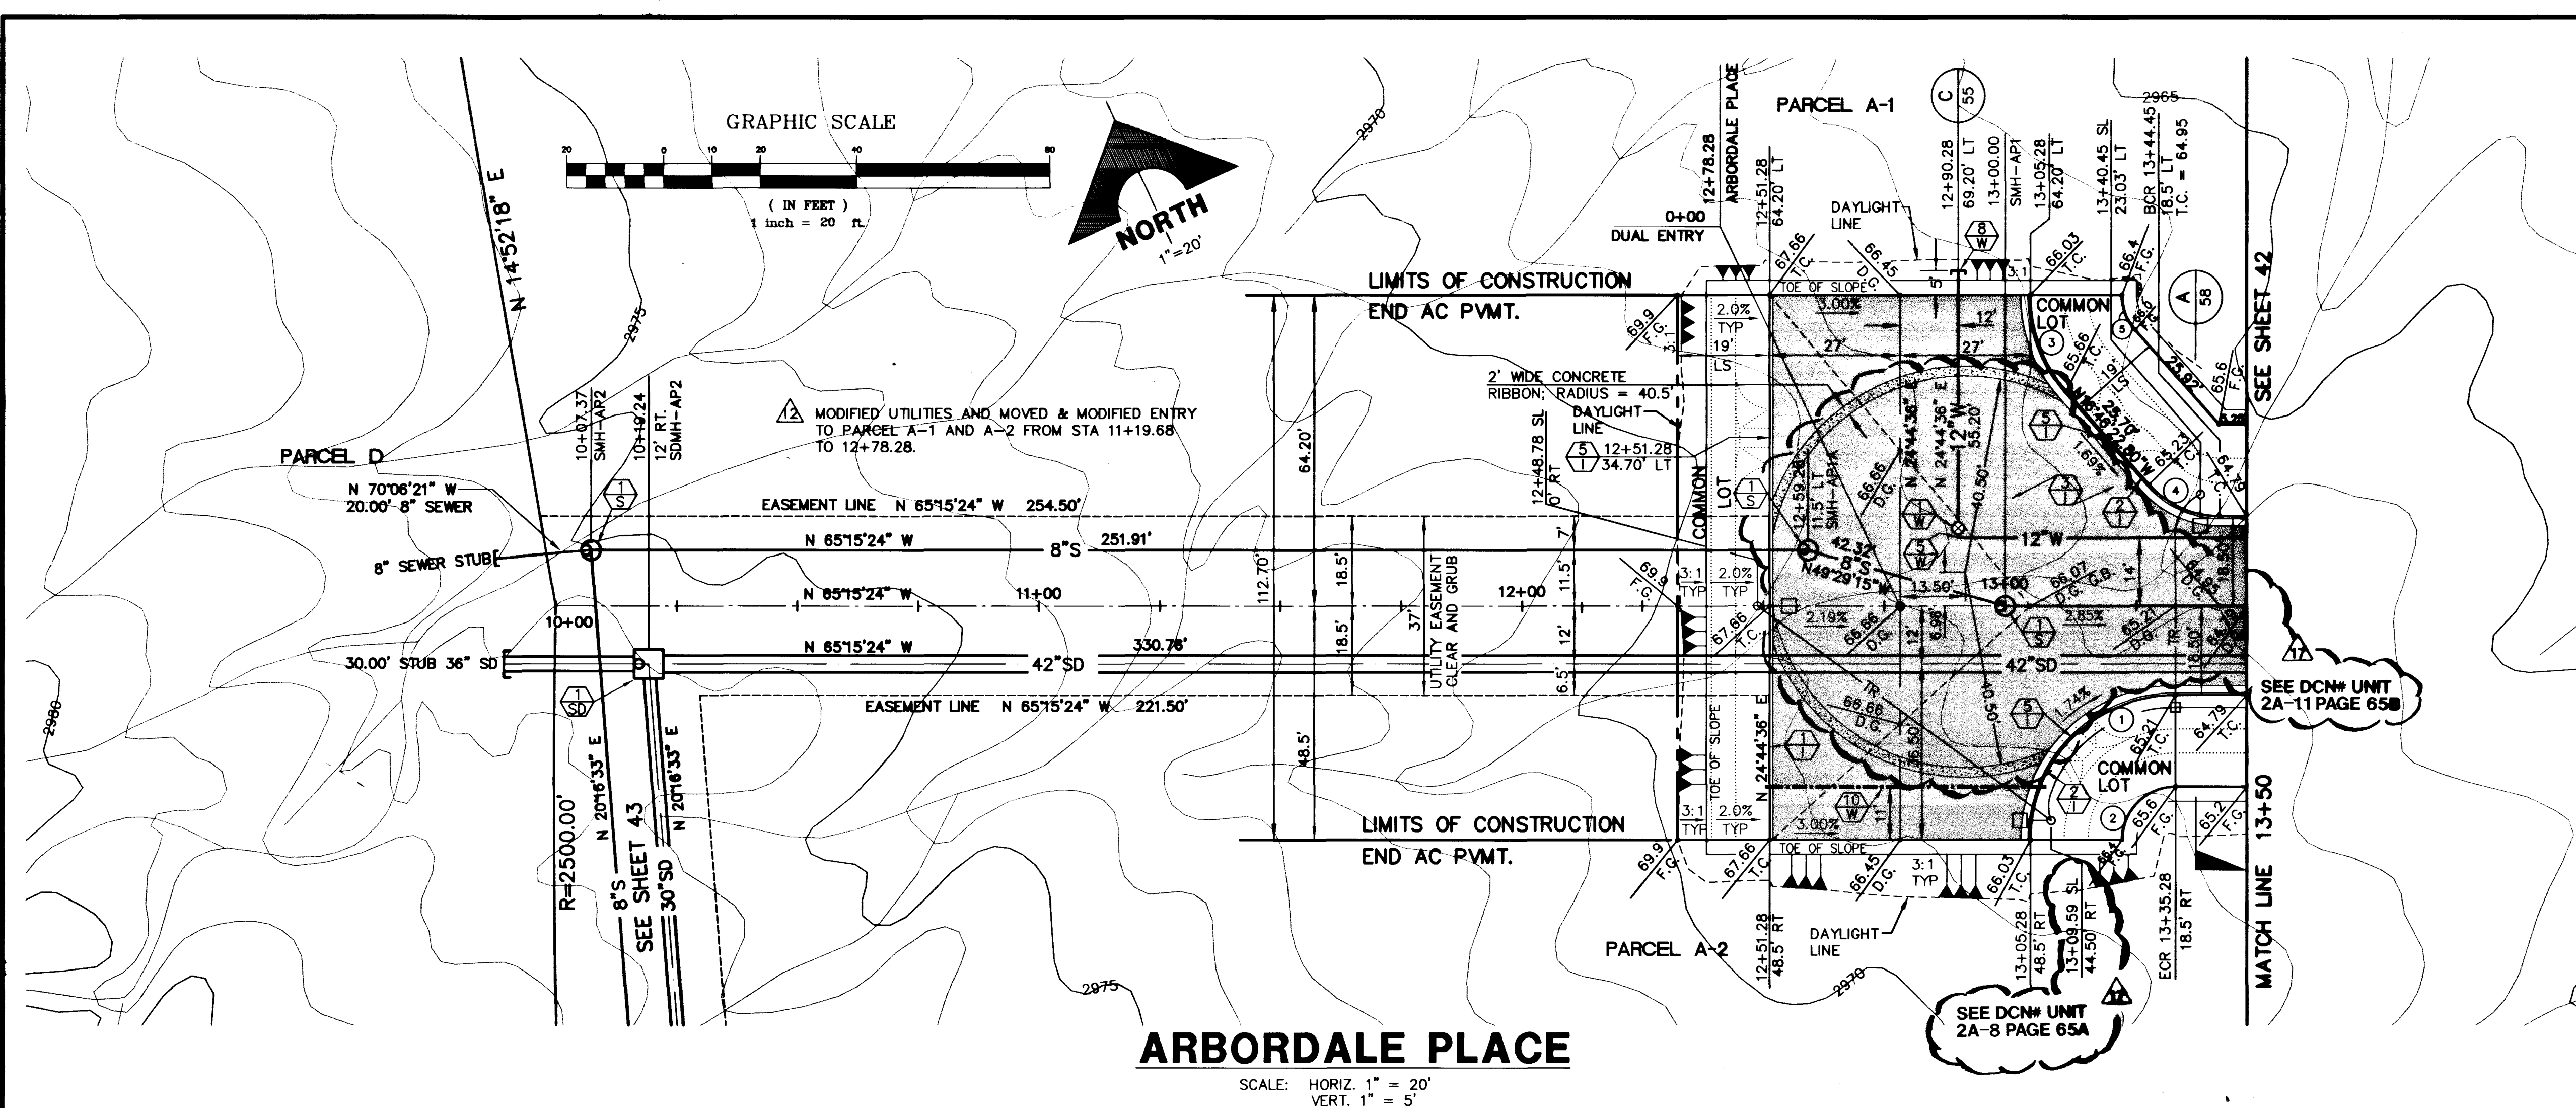

CURVE DATA				
① INDICATES CURVE NUMBER (THIS SHEET ONLY)				
CURVE	DELTA	RADIUS	LENGTH	TANGENT
1	90°00'00"	30.00'	47.12'	30.00'
2	90°00'00"	11.00'	17.28'	11.00'
3	41°30'59"	30.00'	21.74'	11.37'
4	48°30'00"	19.50'	16.50'	8.78'
5	41°30'59"	11.00'	7.97'	4.17'

CONSTRUCTION NOTES				
IMPROVEMENTS				
①	INSTALL "A" TYPE CURB	(S-50)		
②	INSTALL "L" TYPE CURB & GUTTER	(S-47)		
③	INSTALL AC PAVEMENT PER SECTION SHEETS 56, 57, & 58			
④	INSTALL CROSSWALK	(S-78)		
⑤	INSTALL DEPRESSED CURB	(S-75)		


WATER				
INSTALL WATER PIPES PER SUMMERLIN STD. U-20				
①	INSTALL 12" DIA. GATE VALVE & BOX	(U-34)		
②	INSTALL 8" DIA. GATE VALVE & BOX	(U-34)		
③	INSTALL 12"x12"x12" TEE			
④	INSTALL 12"x12"x12"x12" CROSS			
⑤	INSTALL 12"x12" ELBOW			
⑥	INSTALL 12"x12"x8" TEE			
⑦	INSTALL 12"x12"x8"x8" CROSS			
⑧	INSTALL 2" TEMP. BLOW-OFF & CAP	(U-32)		
⑨	INSTALL FIRE HYDRANT ASSEMBLY COMPLETE PER	(U-33)		
⑩	IRRIGATION SLEEVE	(U-18)		
⑪	EXISTING GATE VALVE MUST BE IN CLOSED POSITION PRIOR TO REMOVAL OF CAP			

STORM DRAIN				
INSTALL STORM DRAIN PIPES PER SUMMERLIN STD. U-20				
①	INSTALL STORM DRAIN MANHOLE	(D1-D10)		
②	INSTALL 4" TYPE "A" DROP INLET	(D-12)		
③	INSTALL TYPE "B" DROP INLET	(D-13)		
④	INSTALL TYPE "C" MODIFIED DROP INLET (SEE PLANS FOR LENGTH)	(D-14)		
⑤	INSTALL 6" TYPE "A" DROP INLET	(D-12)		

SEWER				
INSTALL SEWER PIPES PER SUMMERLIN STD. U-20				
①	INSTALL SEWER MANHOLE	(SD1-B)		

STREET LIGHTING				
①	INSTALL STREET LIGHT, SEE ELECTRICAL PLANS	(E-2)		
②	STREET LIGHT OR COMMON TRENCH, SEE ELECTRICAL PLANS			

TRAFFIC				
①	INSTALL 2-3" CONDUIT	(E-32)		
②	INSTALL NO. 5 PULLBOX	(S)		

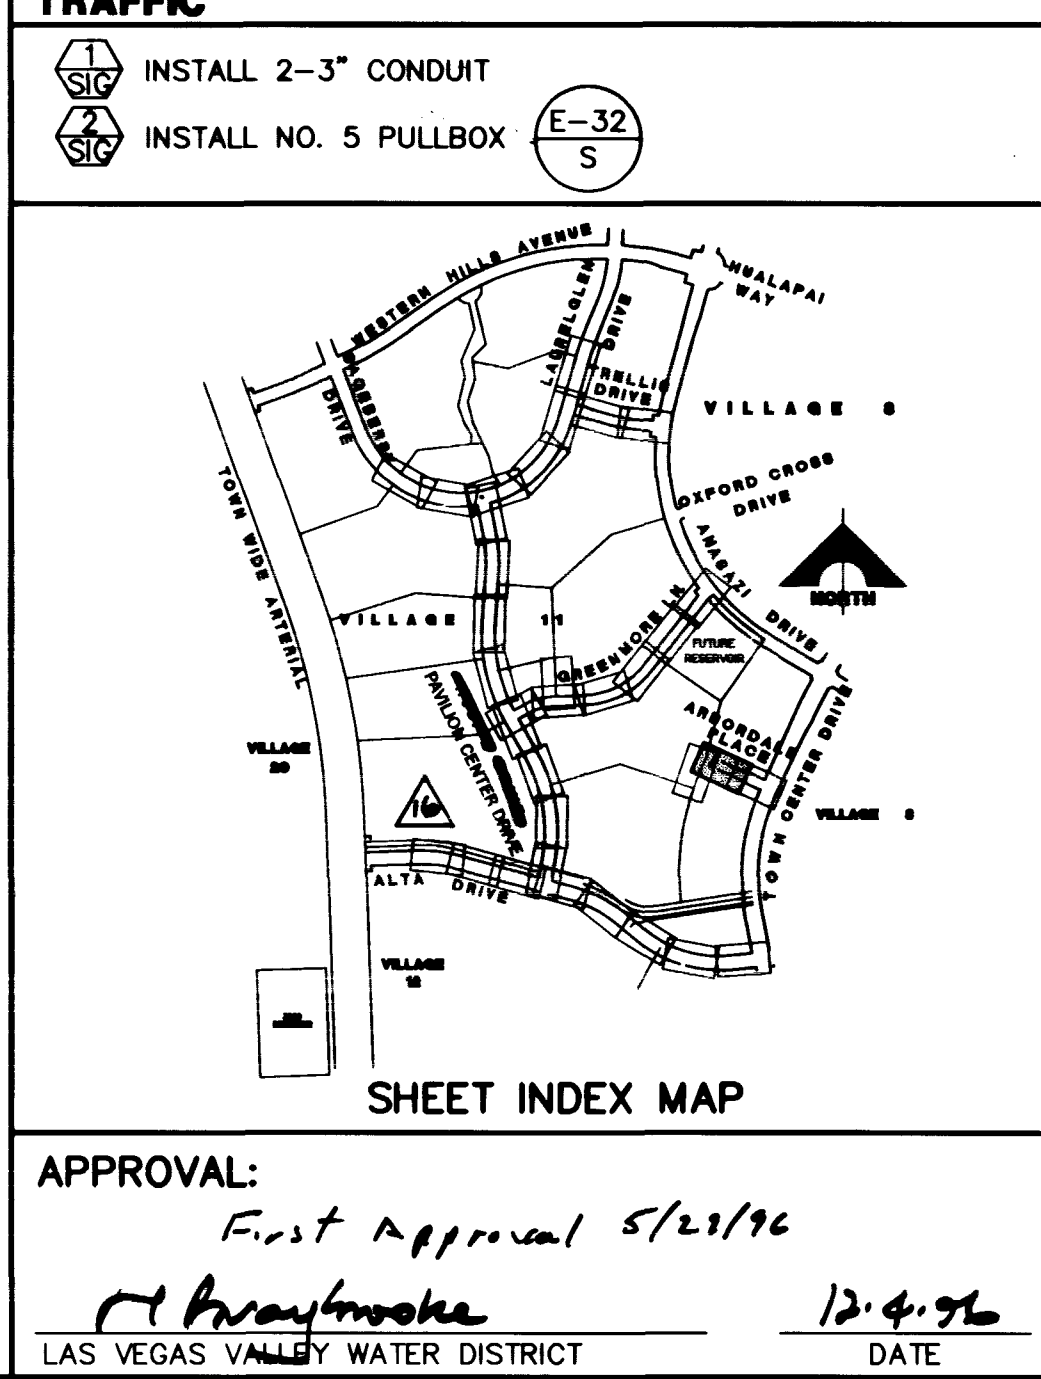

APPROVAL: First Approval 5/21/96
DATE: 12-4-96
LAS VEGAS VALLEY WATER DISTRICT


