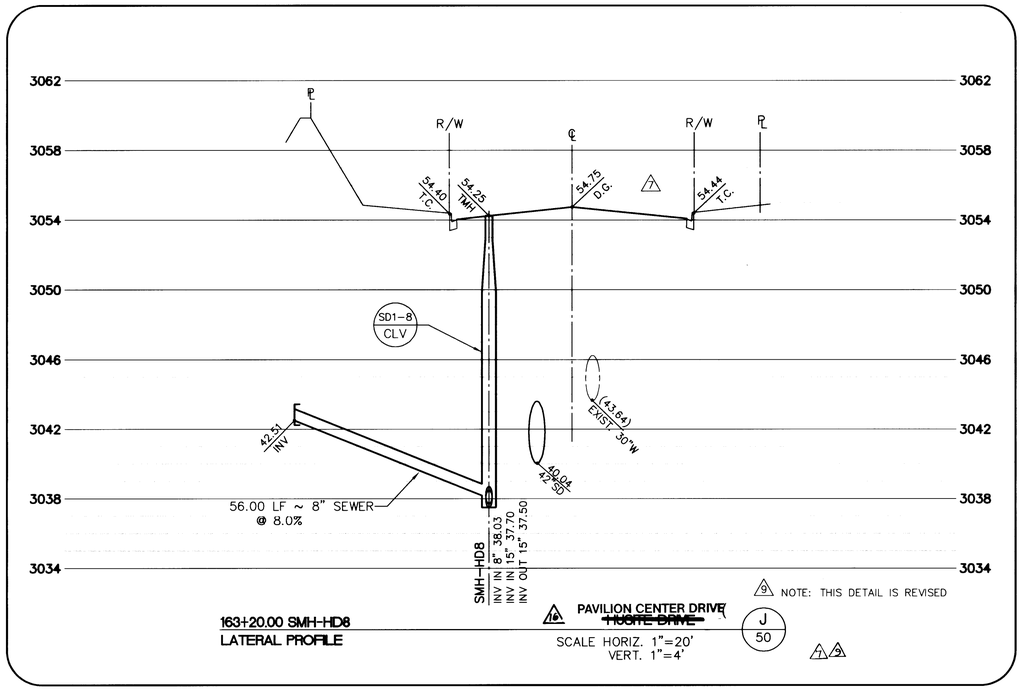

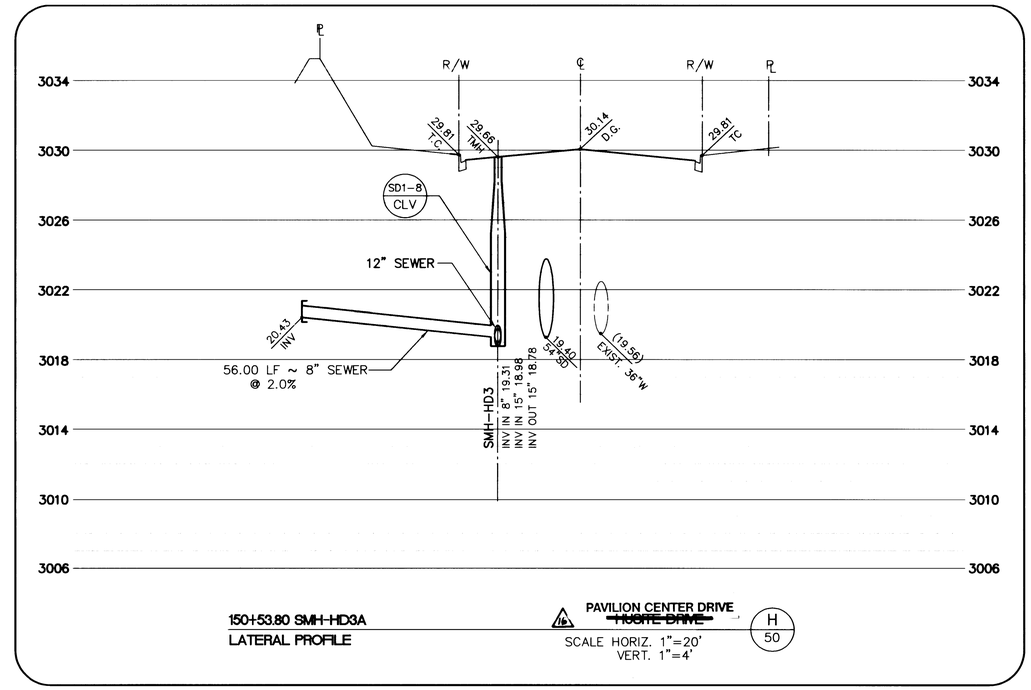

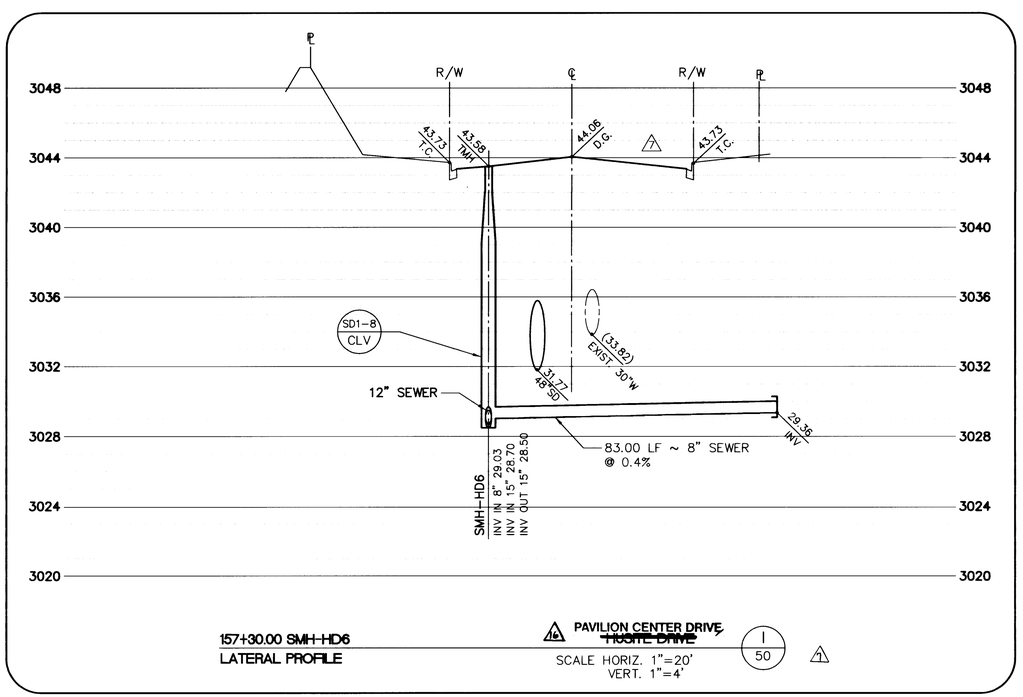

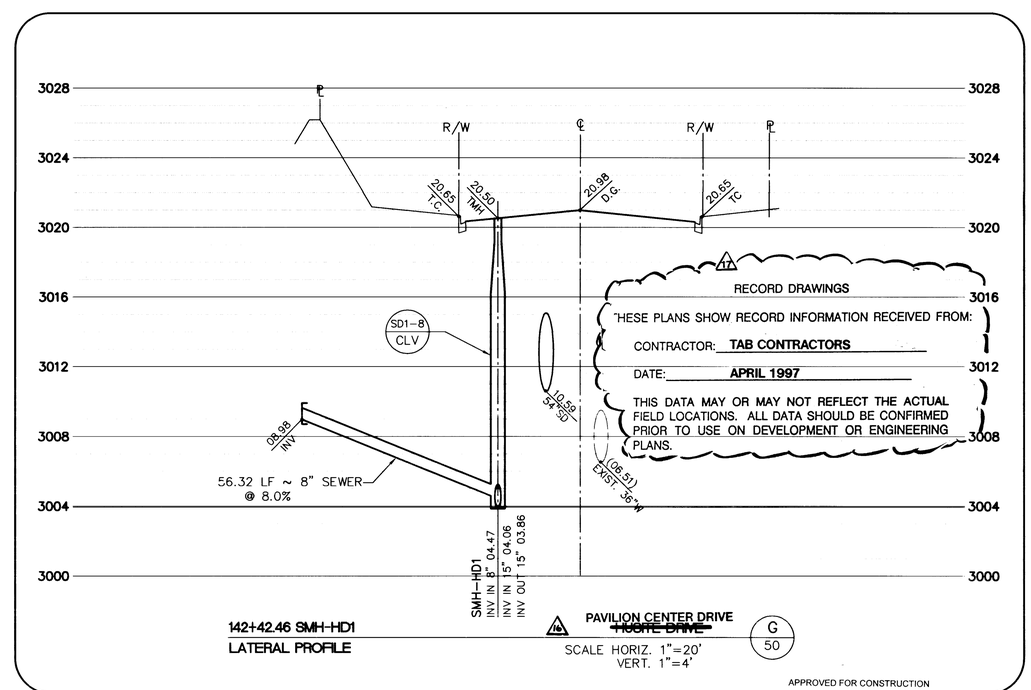

APPROVED FOR CONSTRUCTION

1st APPR 5-31-96

LVWWD 8-28-96 DATE

REV.	DATE	DESCRIPTION	DATE	APPROVAL
8/22/96	REVISED DESIGN GRADE AND ELEV. FROM STA 156+29.83 TO 177+18.16 AND DELETED 8" SEWER STUB	3-5-97		
8/23/96	REVISED WATER STUB TO PAR. ES-2 FROM STA 163+12.81 TO 165+29.50	1/28/96		
1/29/96	REV. ST. NAME	1/24/96		
05/05/95	RECORD DRAWING INFORMATION			

FINAL SUBMITTAL

RECOMMENDED
CHRISTOPHER W. ANDERSON
DATE
5071
R.P.E. NO.

STATE OF NEVADA
REGISTERED PROFESSIONAL ENGINEER
CHRISTOPHER W. ANDERSON
No. 5071

G.C. WALLACE, INC.
Engineering/Architecture
1555 SOUTH RAINBOW BLVD./LAS VEGAS, NEVADA 89102

SUMMERLIN
VILLAGE 11/12 THE ARBORS - UNIT 2A
PAVILION CENTER DRIVE
SEWER LATERALS

SHEET
50
SHT 50 OF 65

JOB NO. 62011.212

August 26, 1996 12:42:51 p.m. Drawing: C:\DWG\VIL11-12\2A\DETAILS\112A-L50.DWG

ADR

8586

SID 707 PROJECT NO. 10A,10B,10C,11A,11B,11C,12A,12B,12C,13A,13B,13C,17A,17B,17C,21, & 53

307Y-4463-2A

 

 

 

 

C.C. WALLACE, INC.


SEWER LATERALS

SHEET
50


307Y-4463-2A