

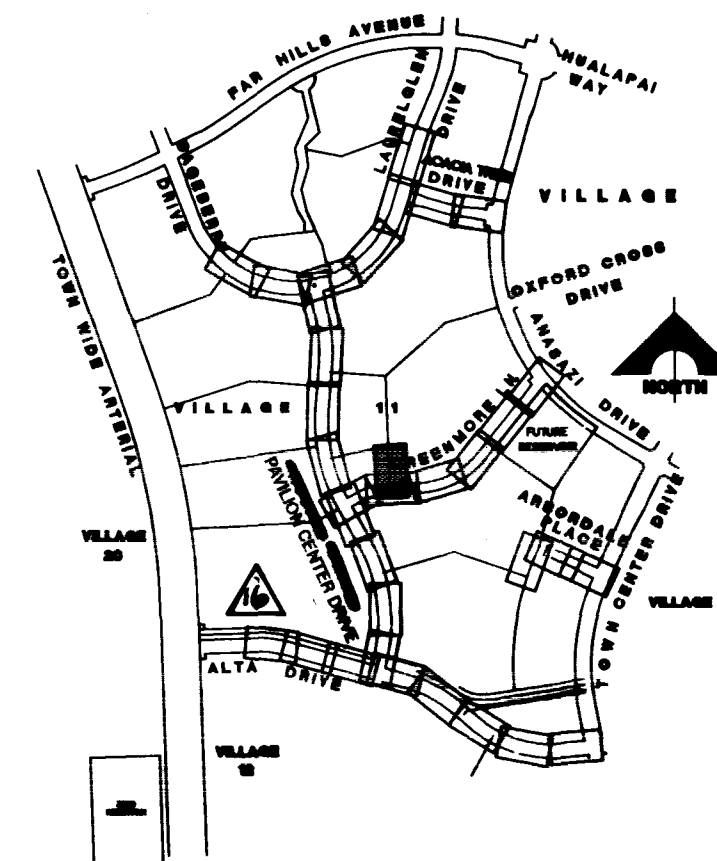


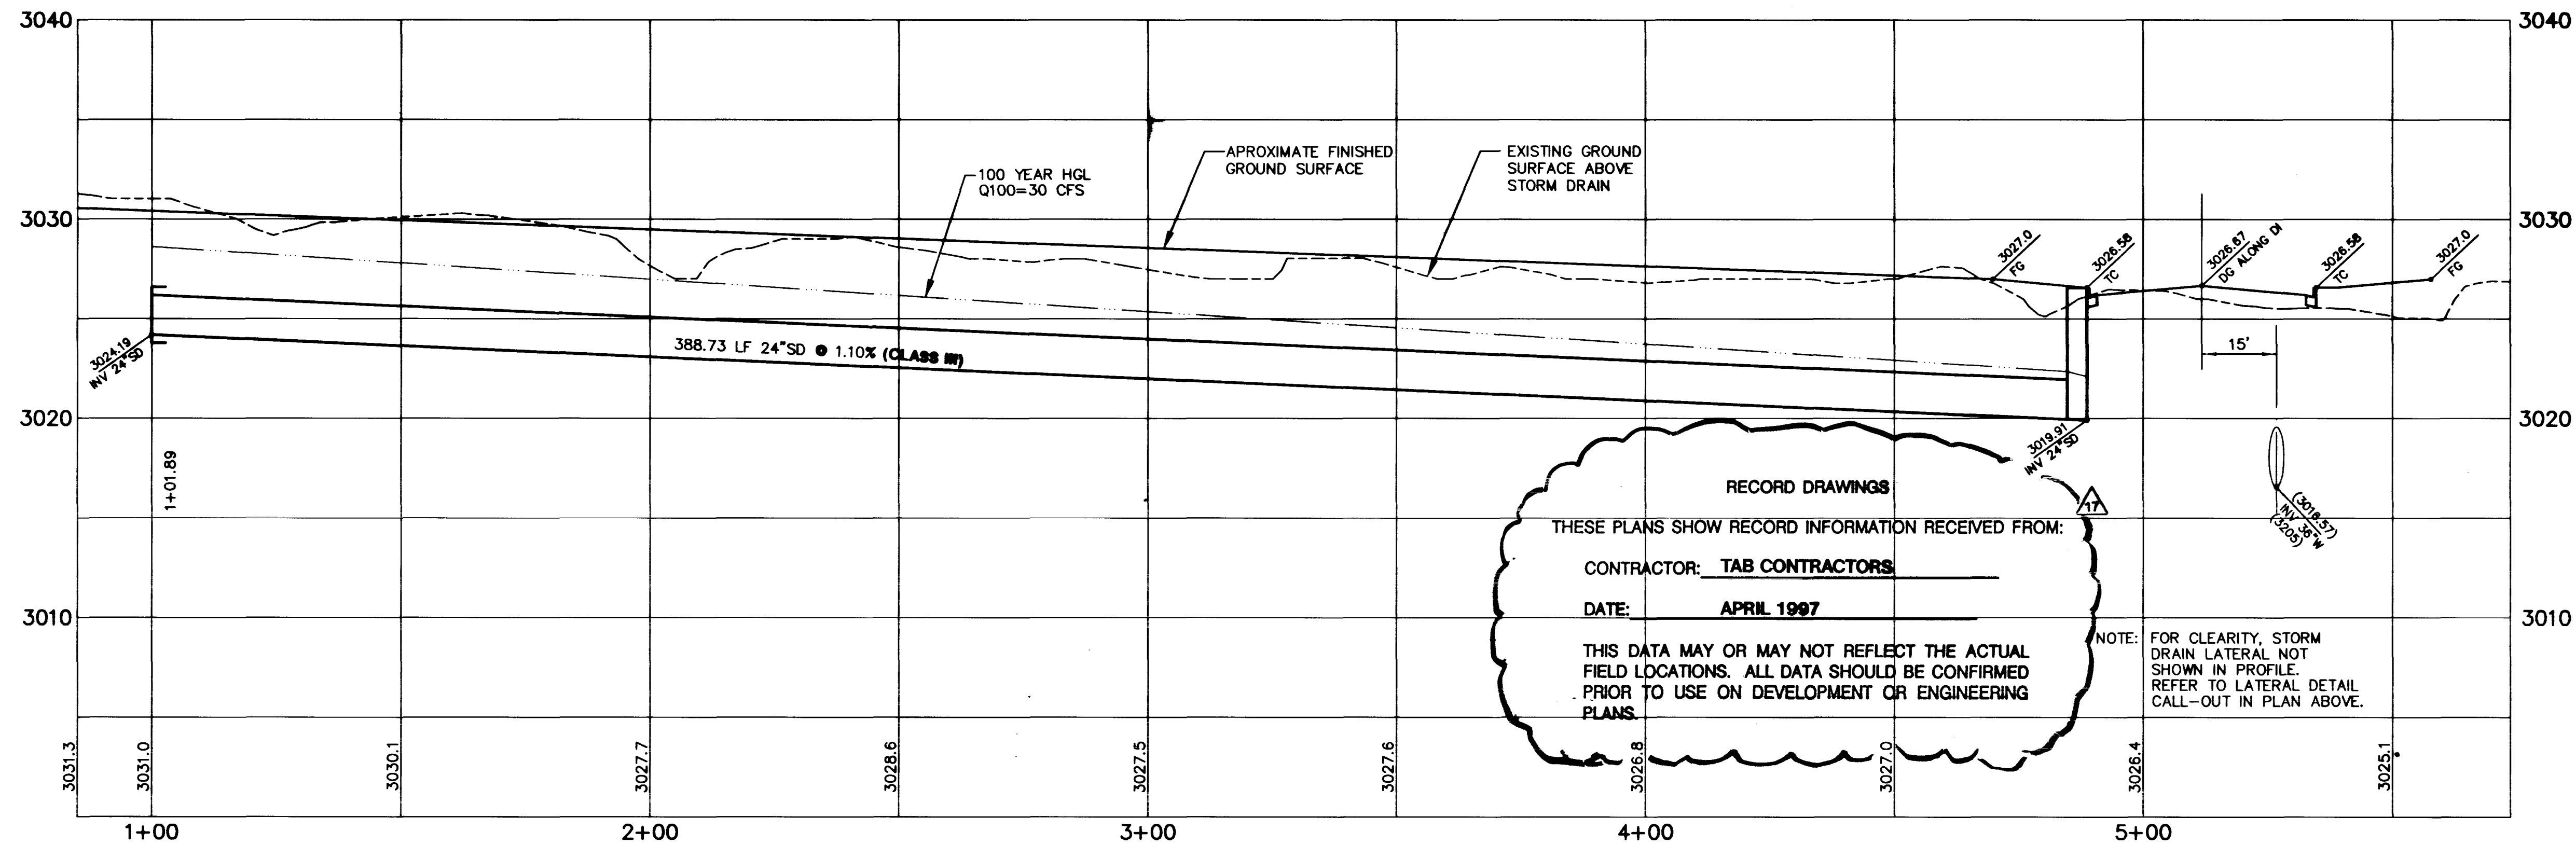

FINAL SUBMITTAL DATE: 3-5-97 REV. ST. NAME: [blank] DESCRIPTION: [blank]	
RECOMMENDED CHRISTOPHER W. ANDERSON 5071 R.P.E. NO. 5071	G.C. WALLACE, INC. Engineering/Architecture 1555 SOUTH RANCHO BLVD./LAS VEGAS, NEVADA 89102
SUMMERLIN VILLAGE 11/12 THE ARBORS - UNIT 2A INTER-PARCEL UTILITY PLAN & PROFILE	
SHEET 40 SHT 40 OF 65	

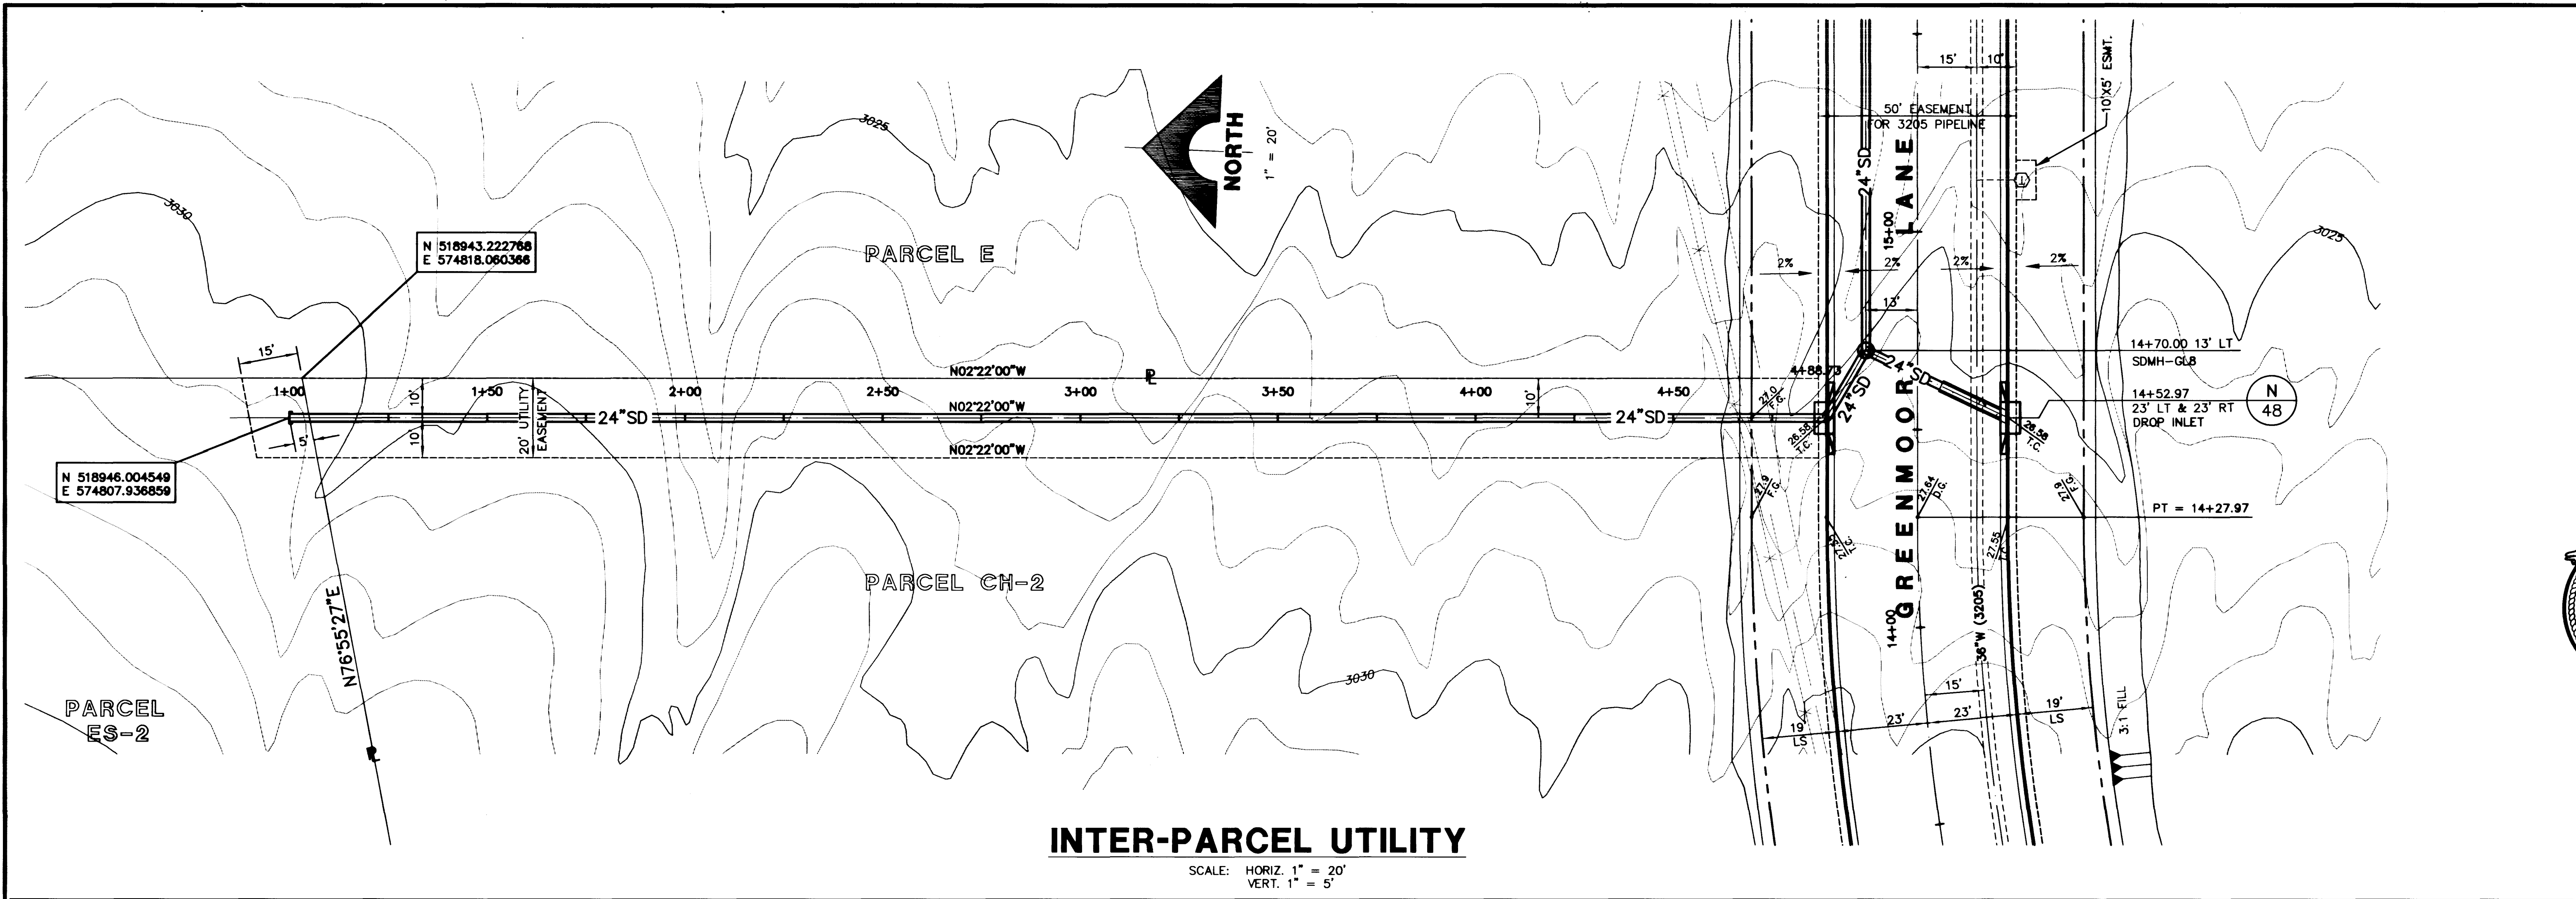