
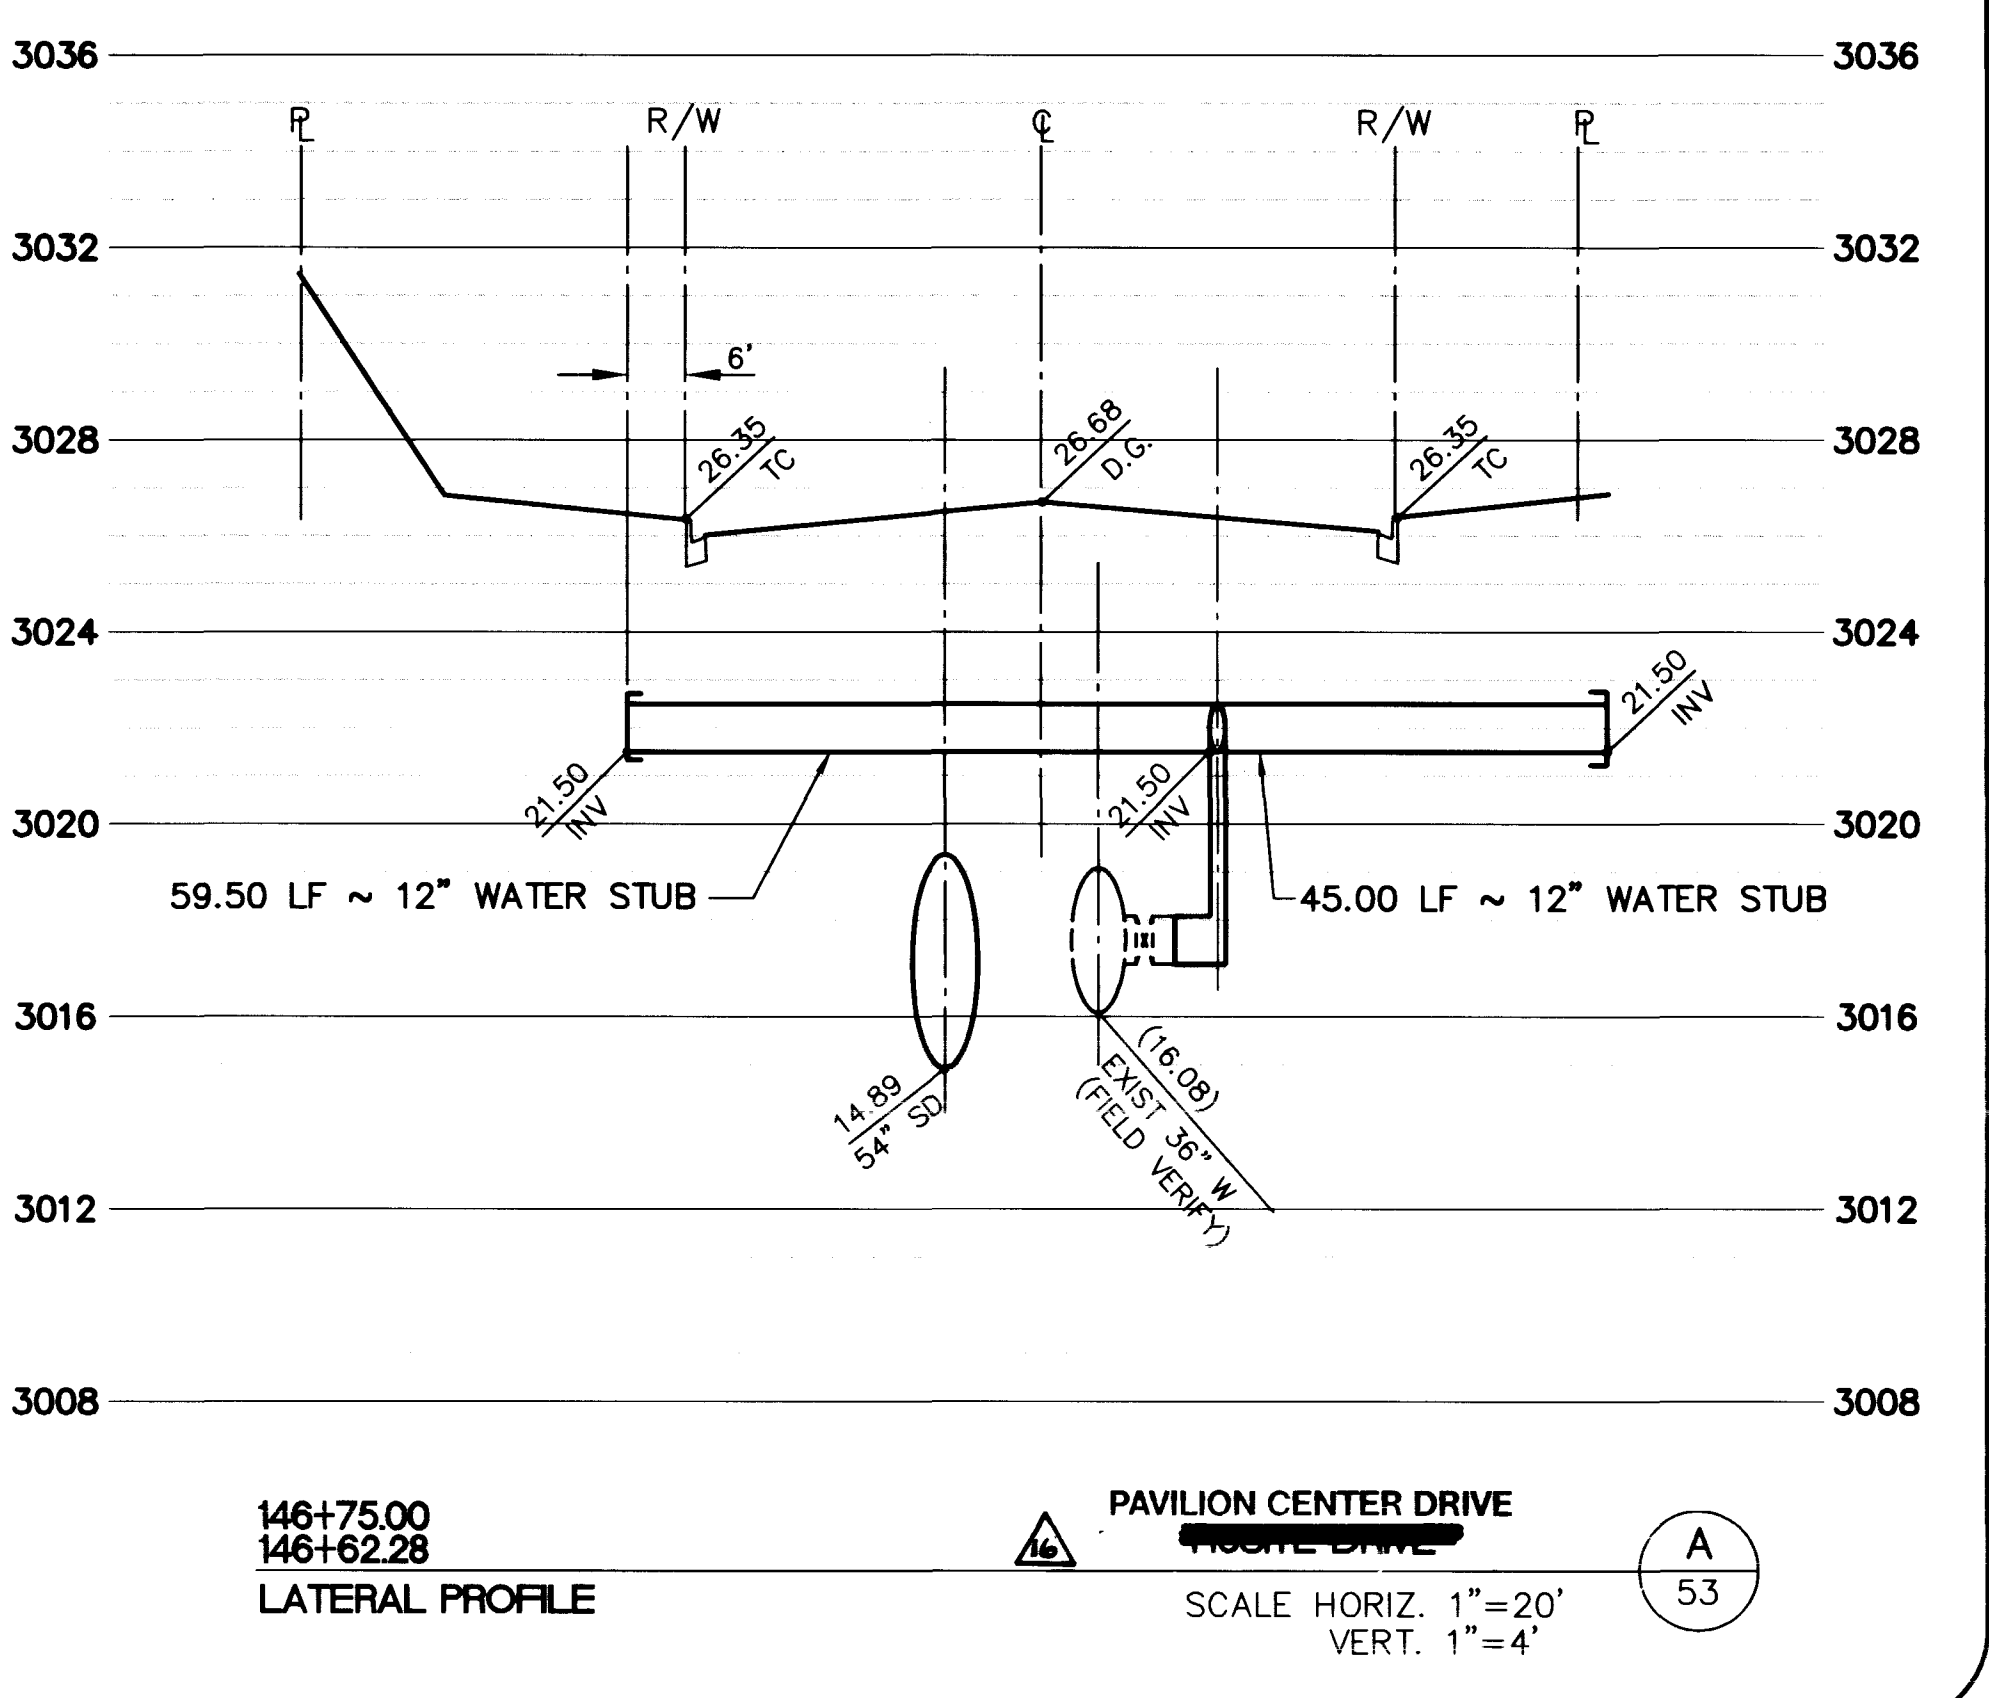
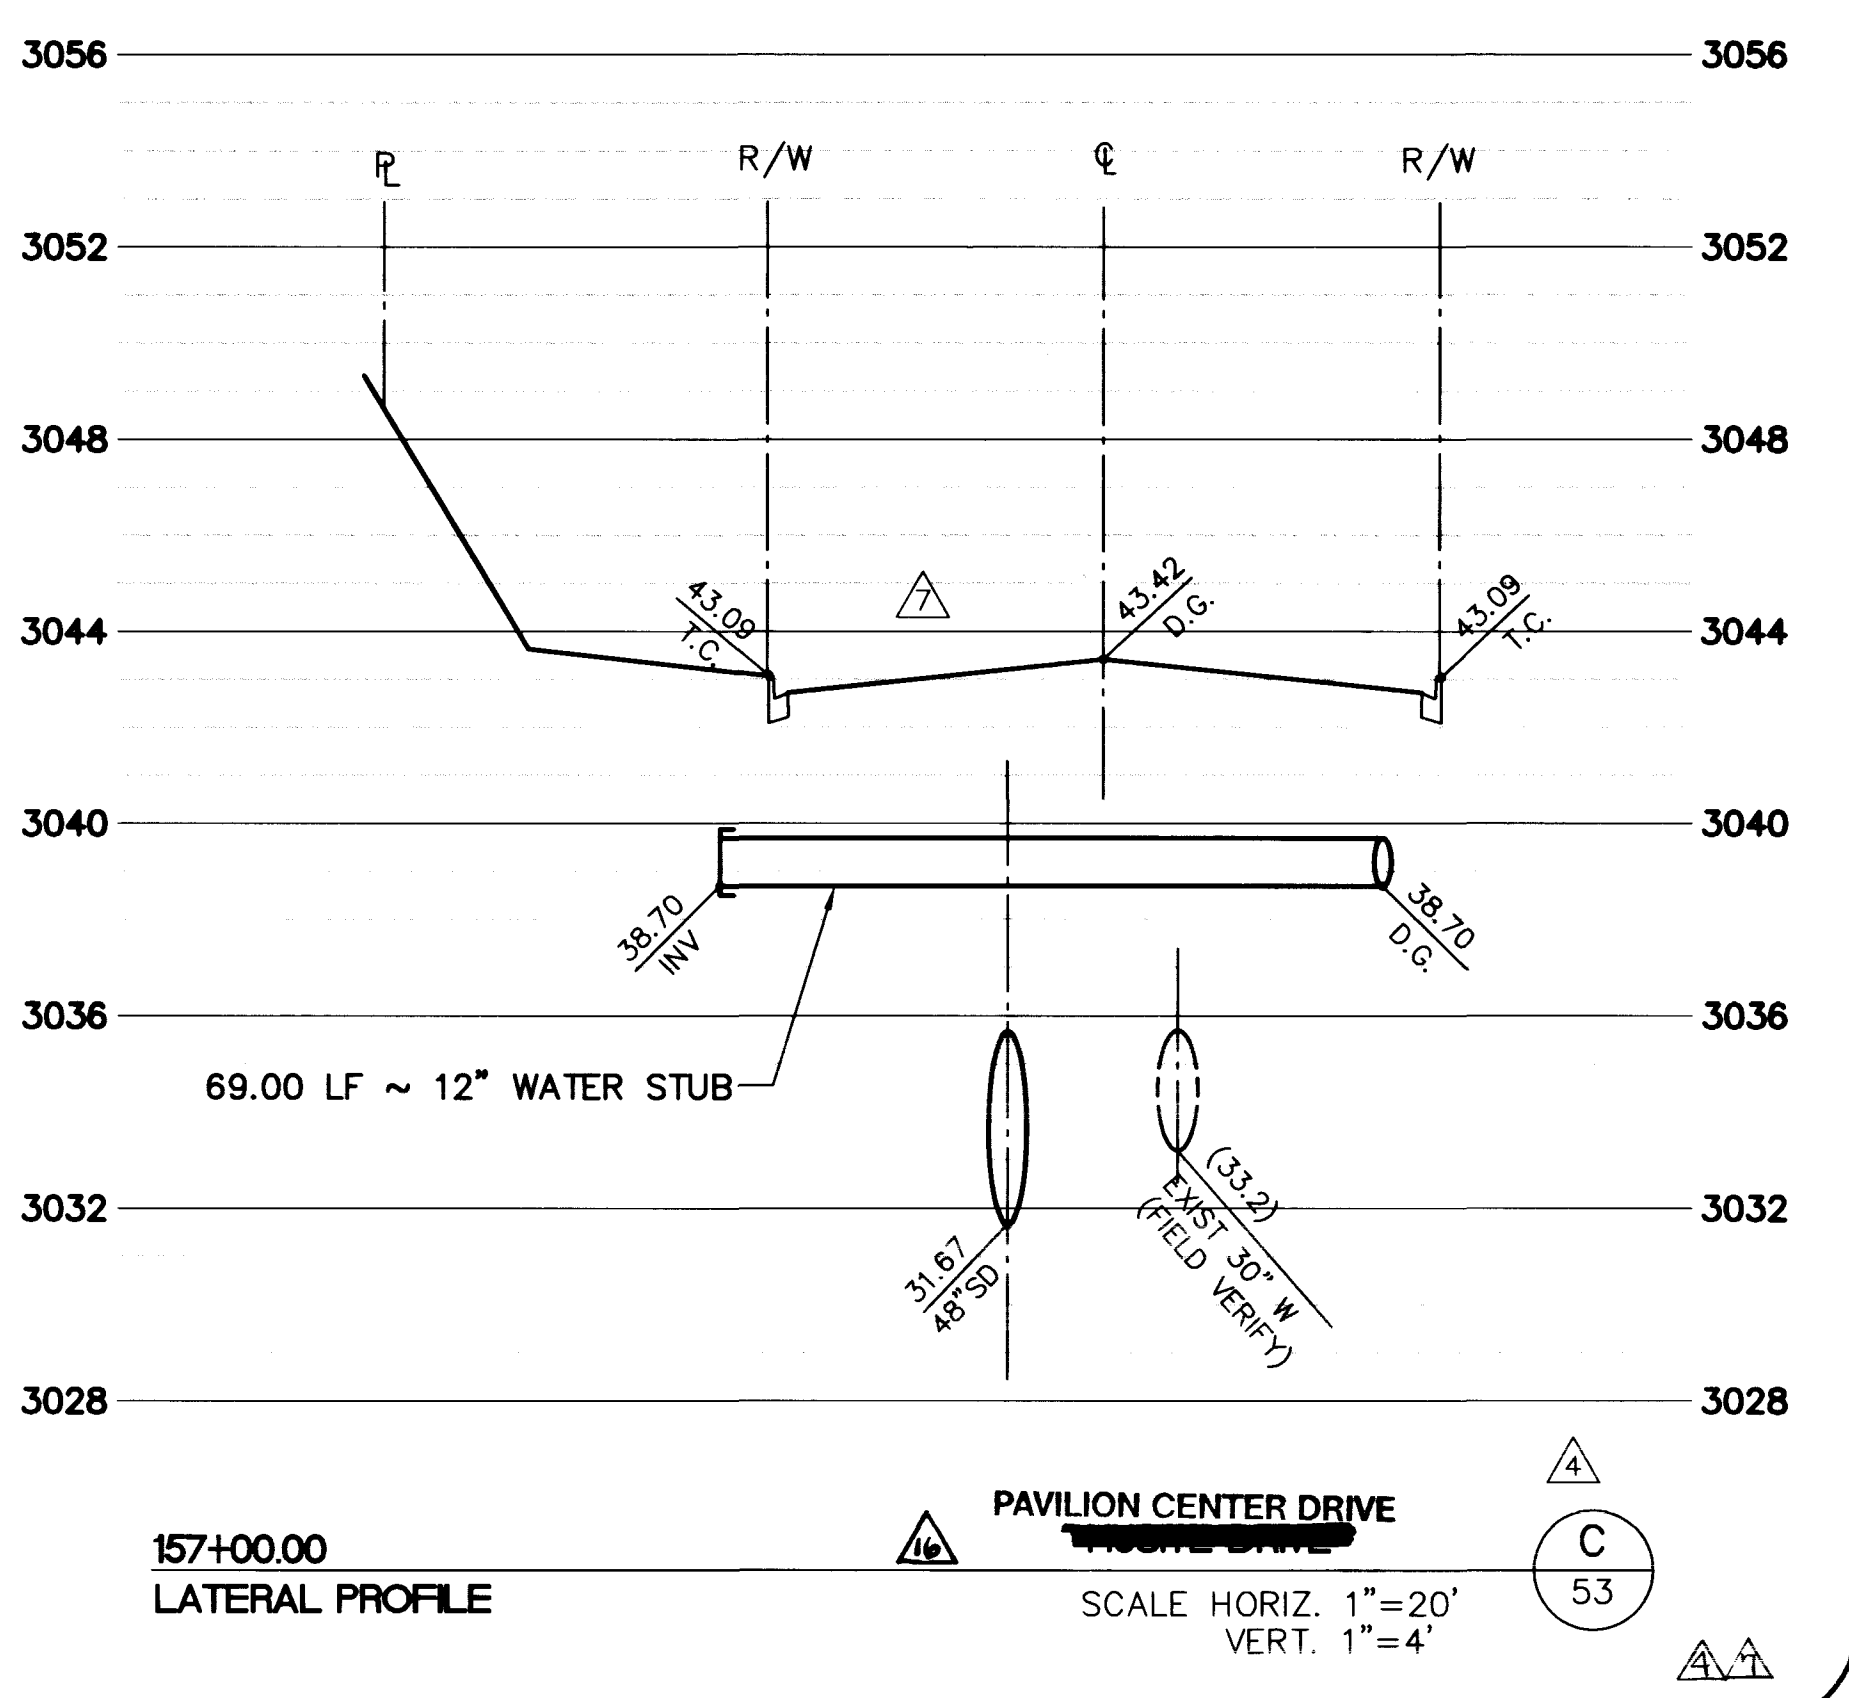
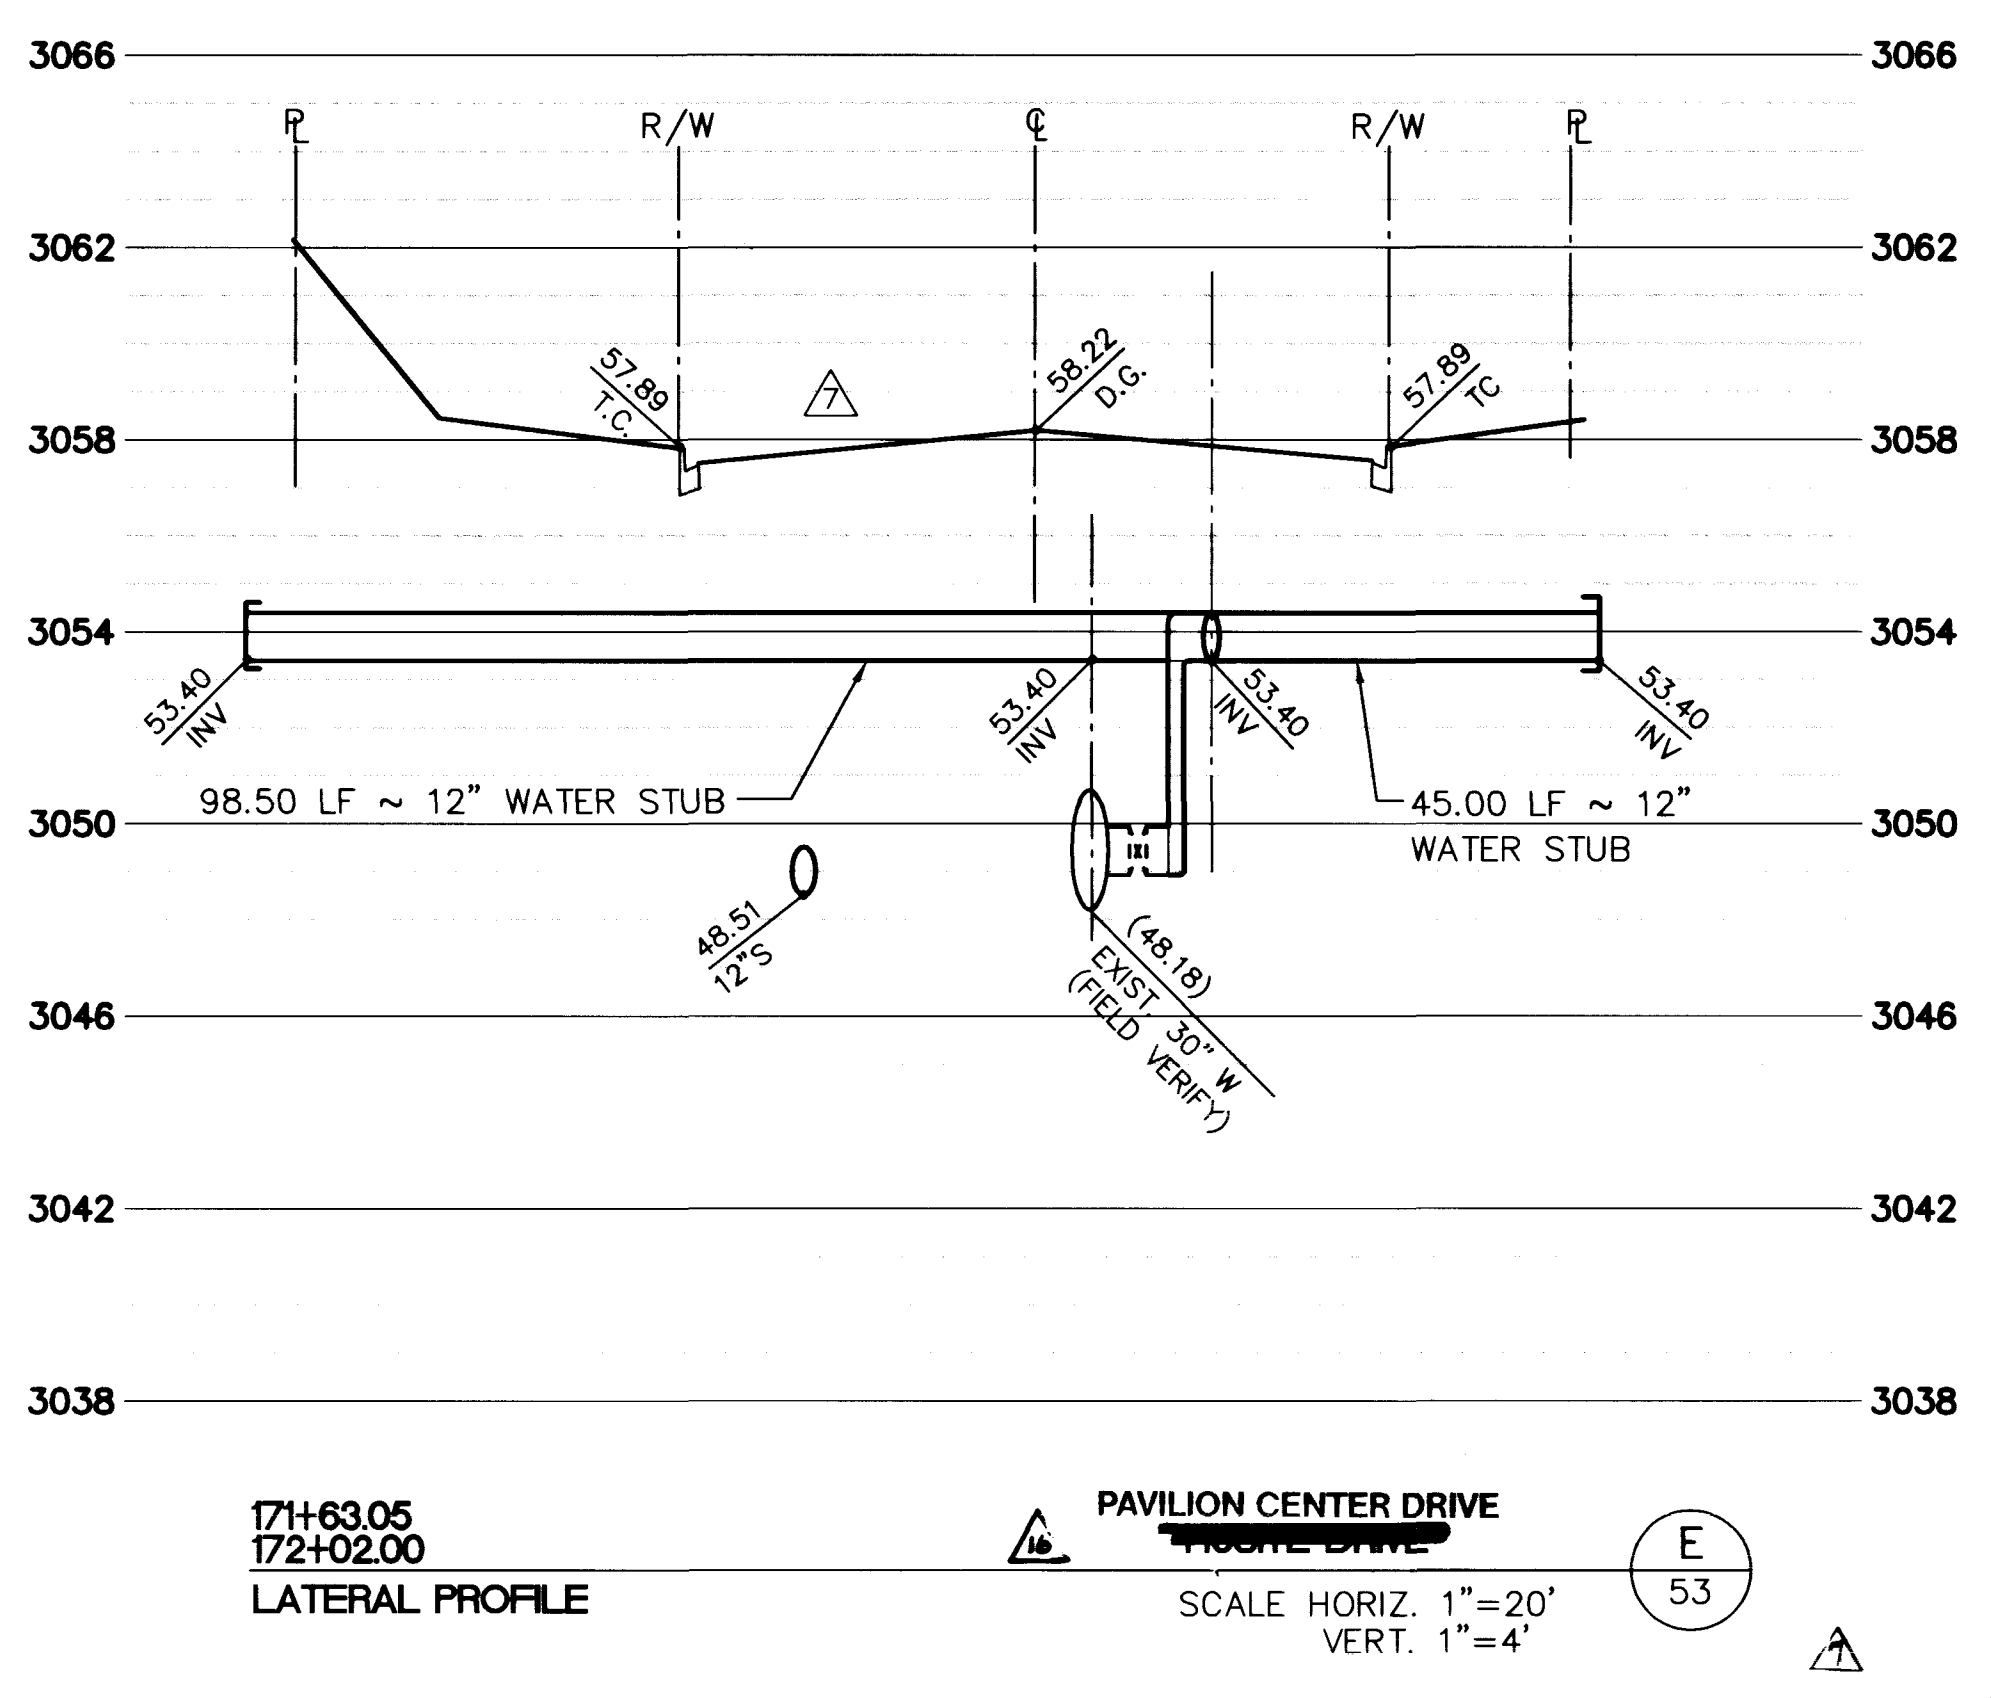
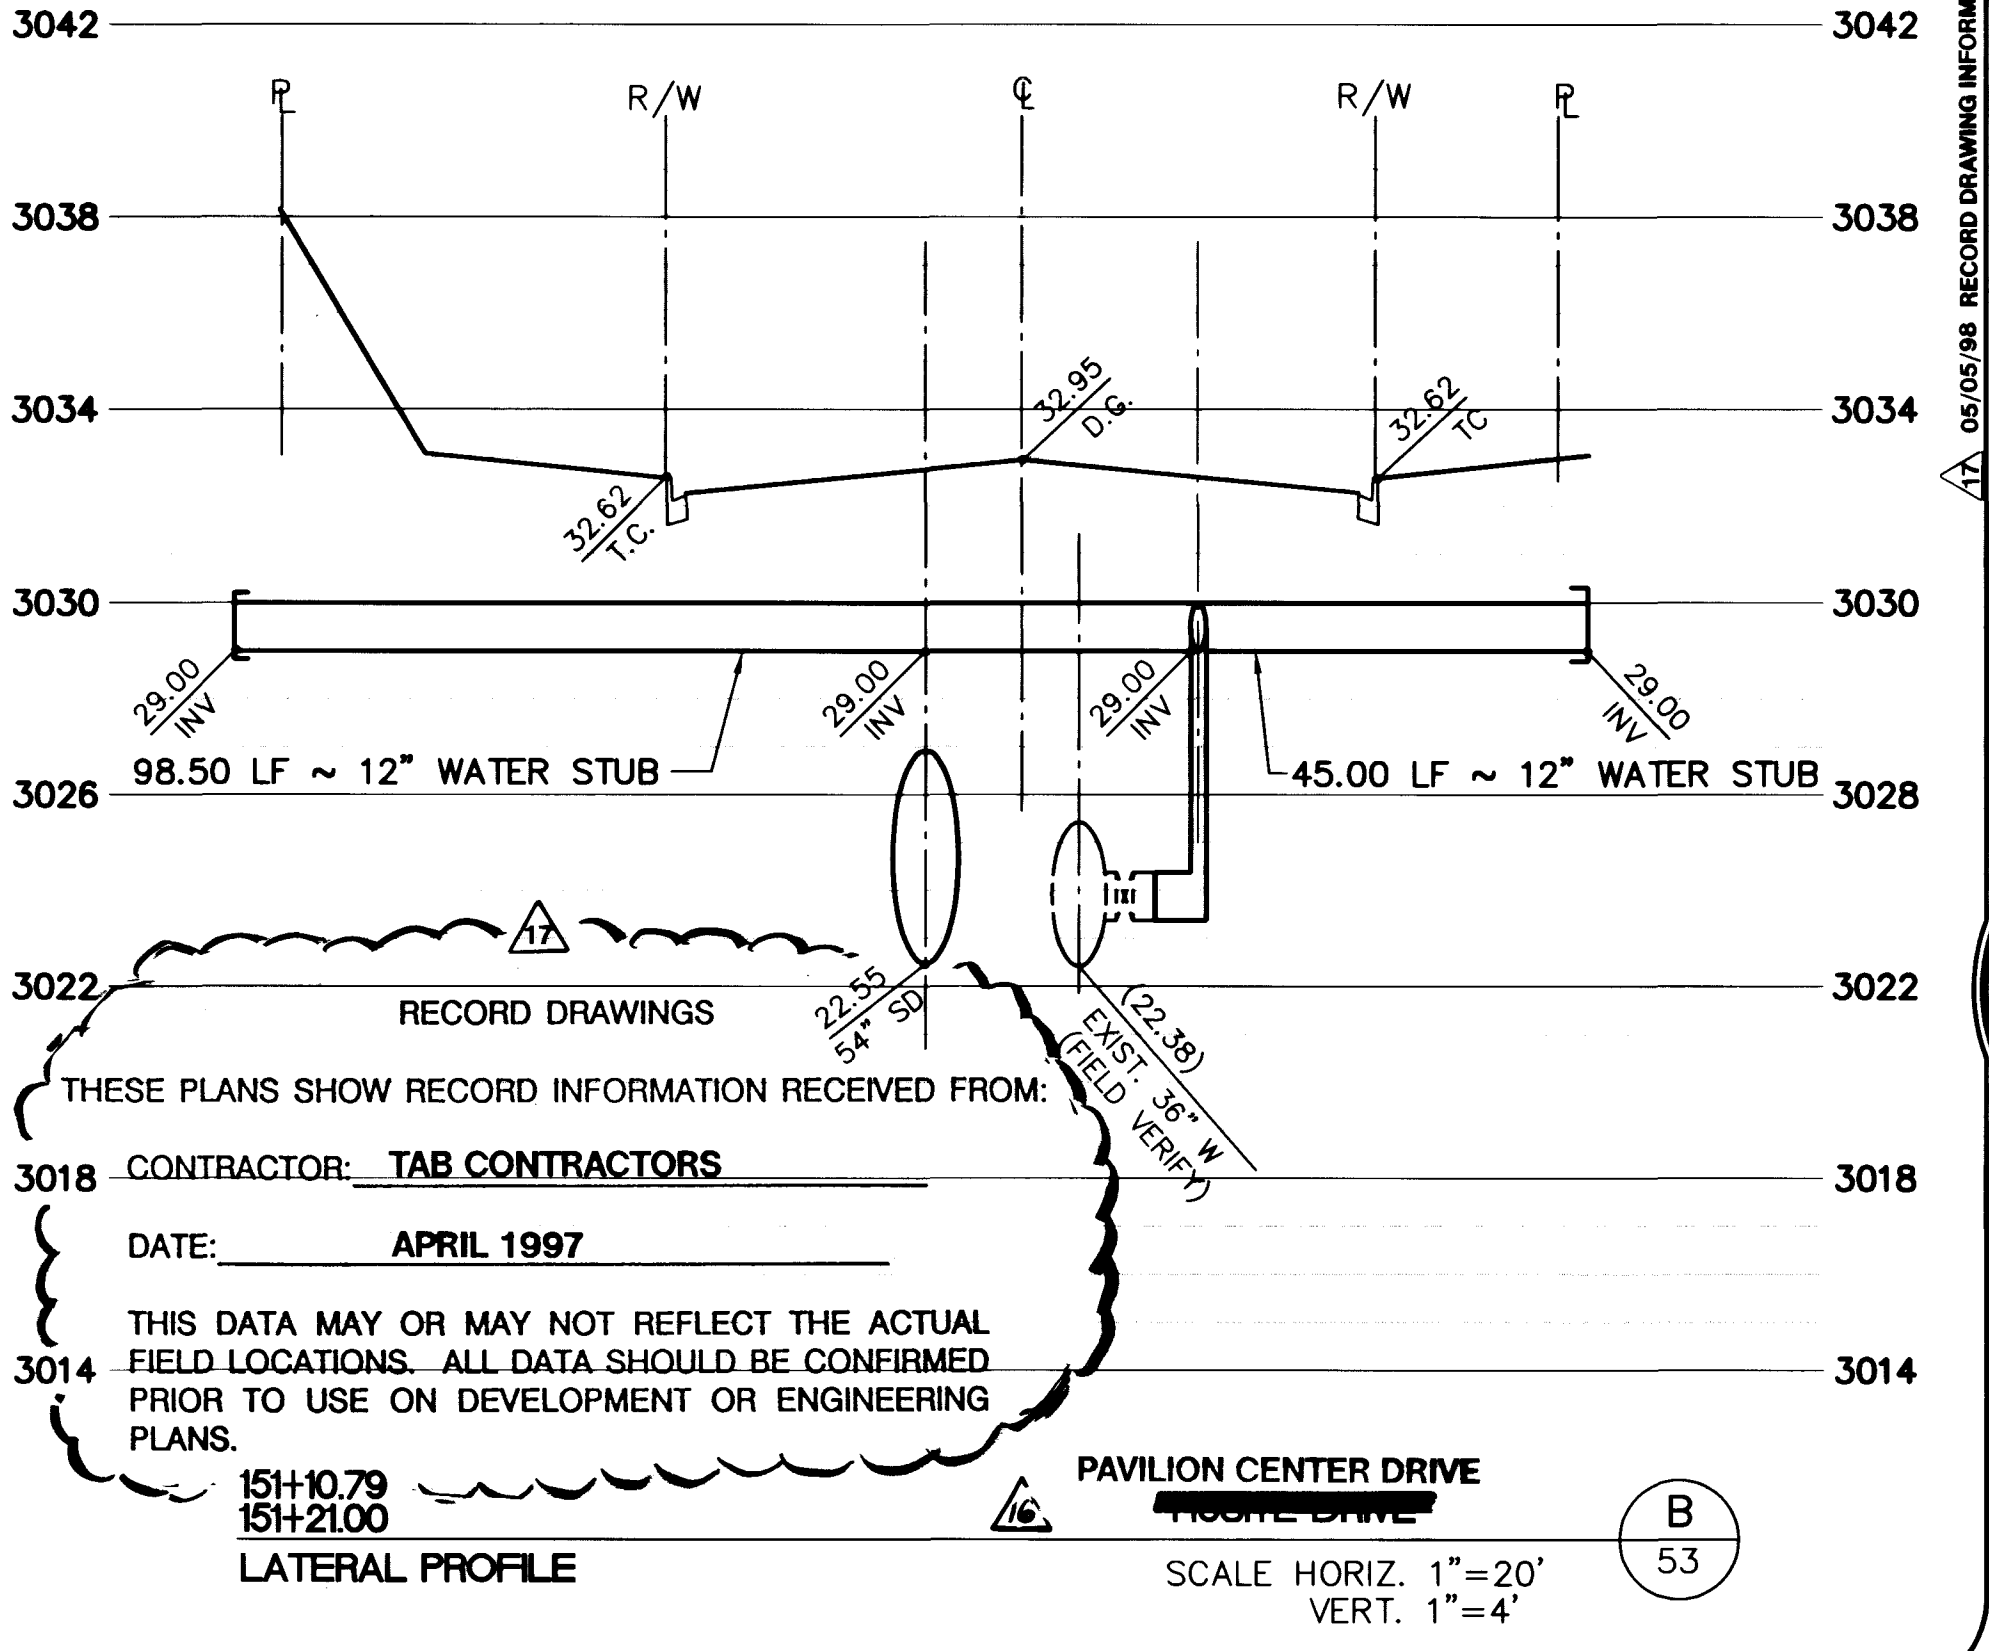
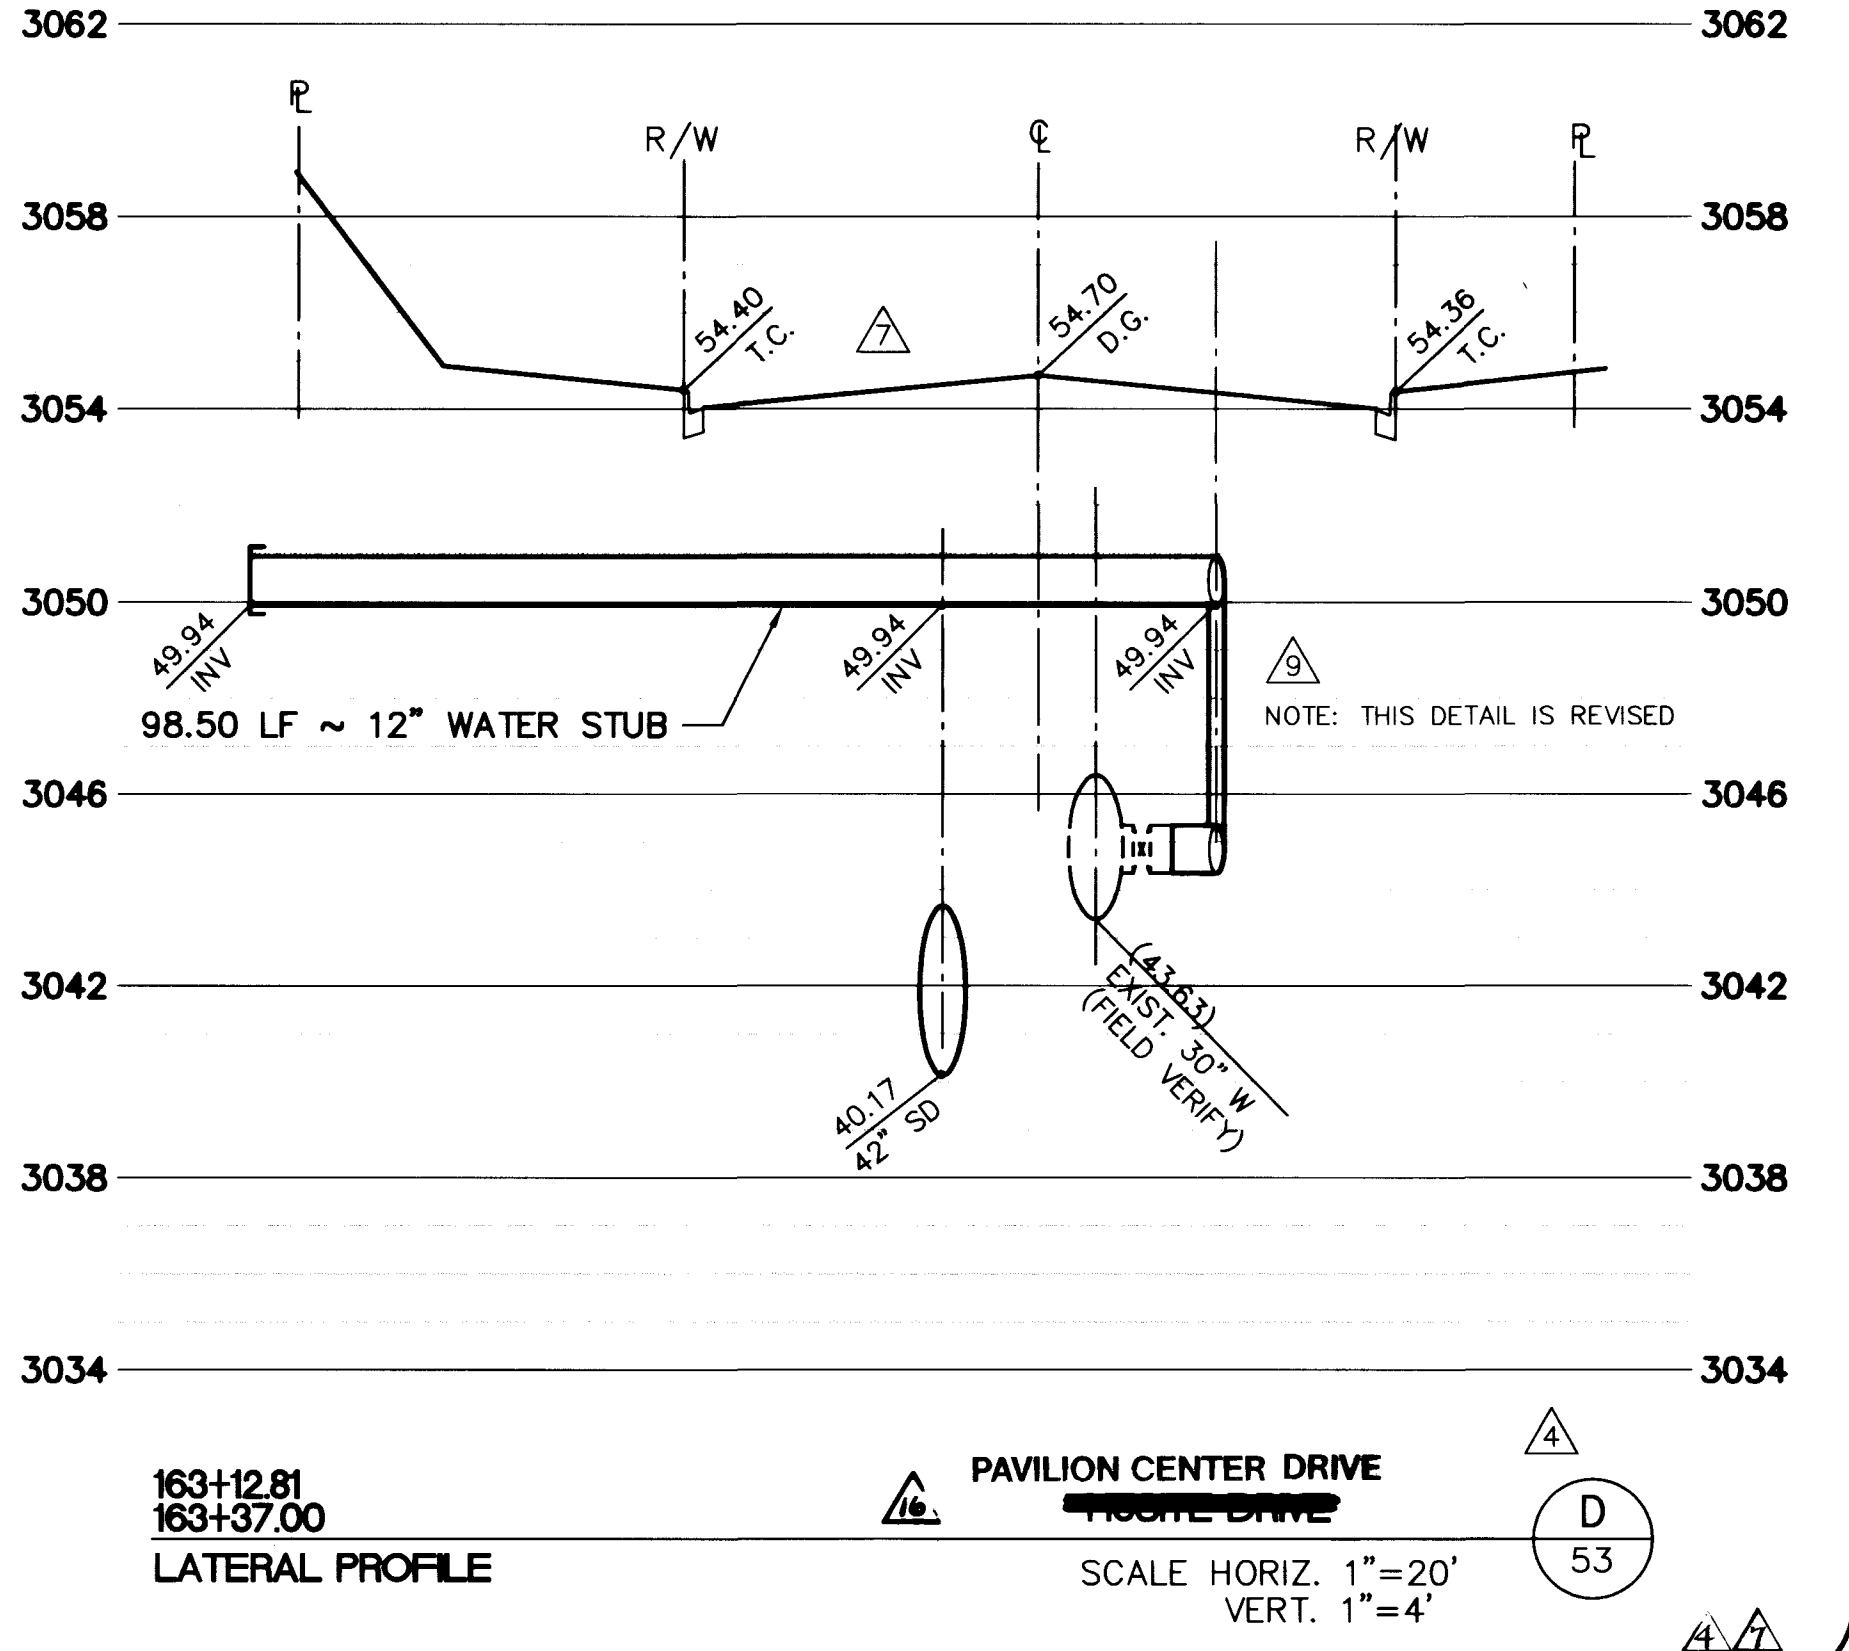


August 23, 1996 10:31:10 a.m. Drawing: C:\DWG\VL17-12\DETAILS\112A-L53.DWG

JOB NO. 62011.212

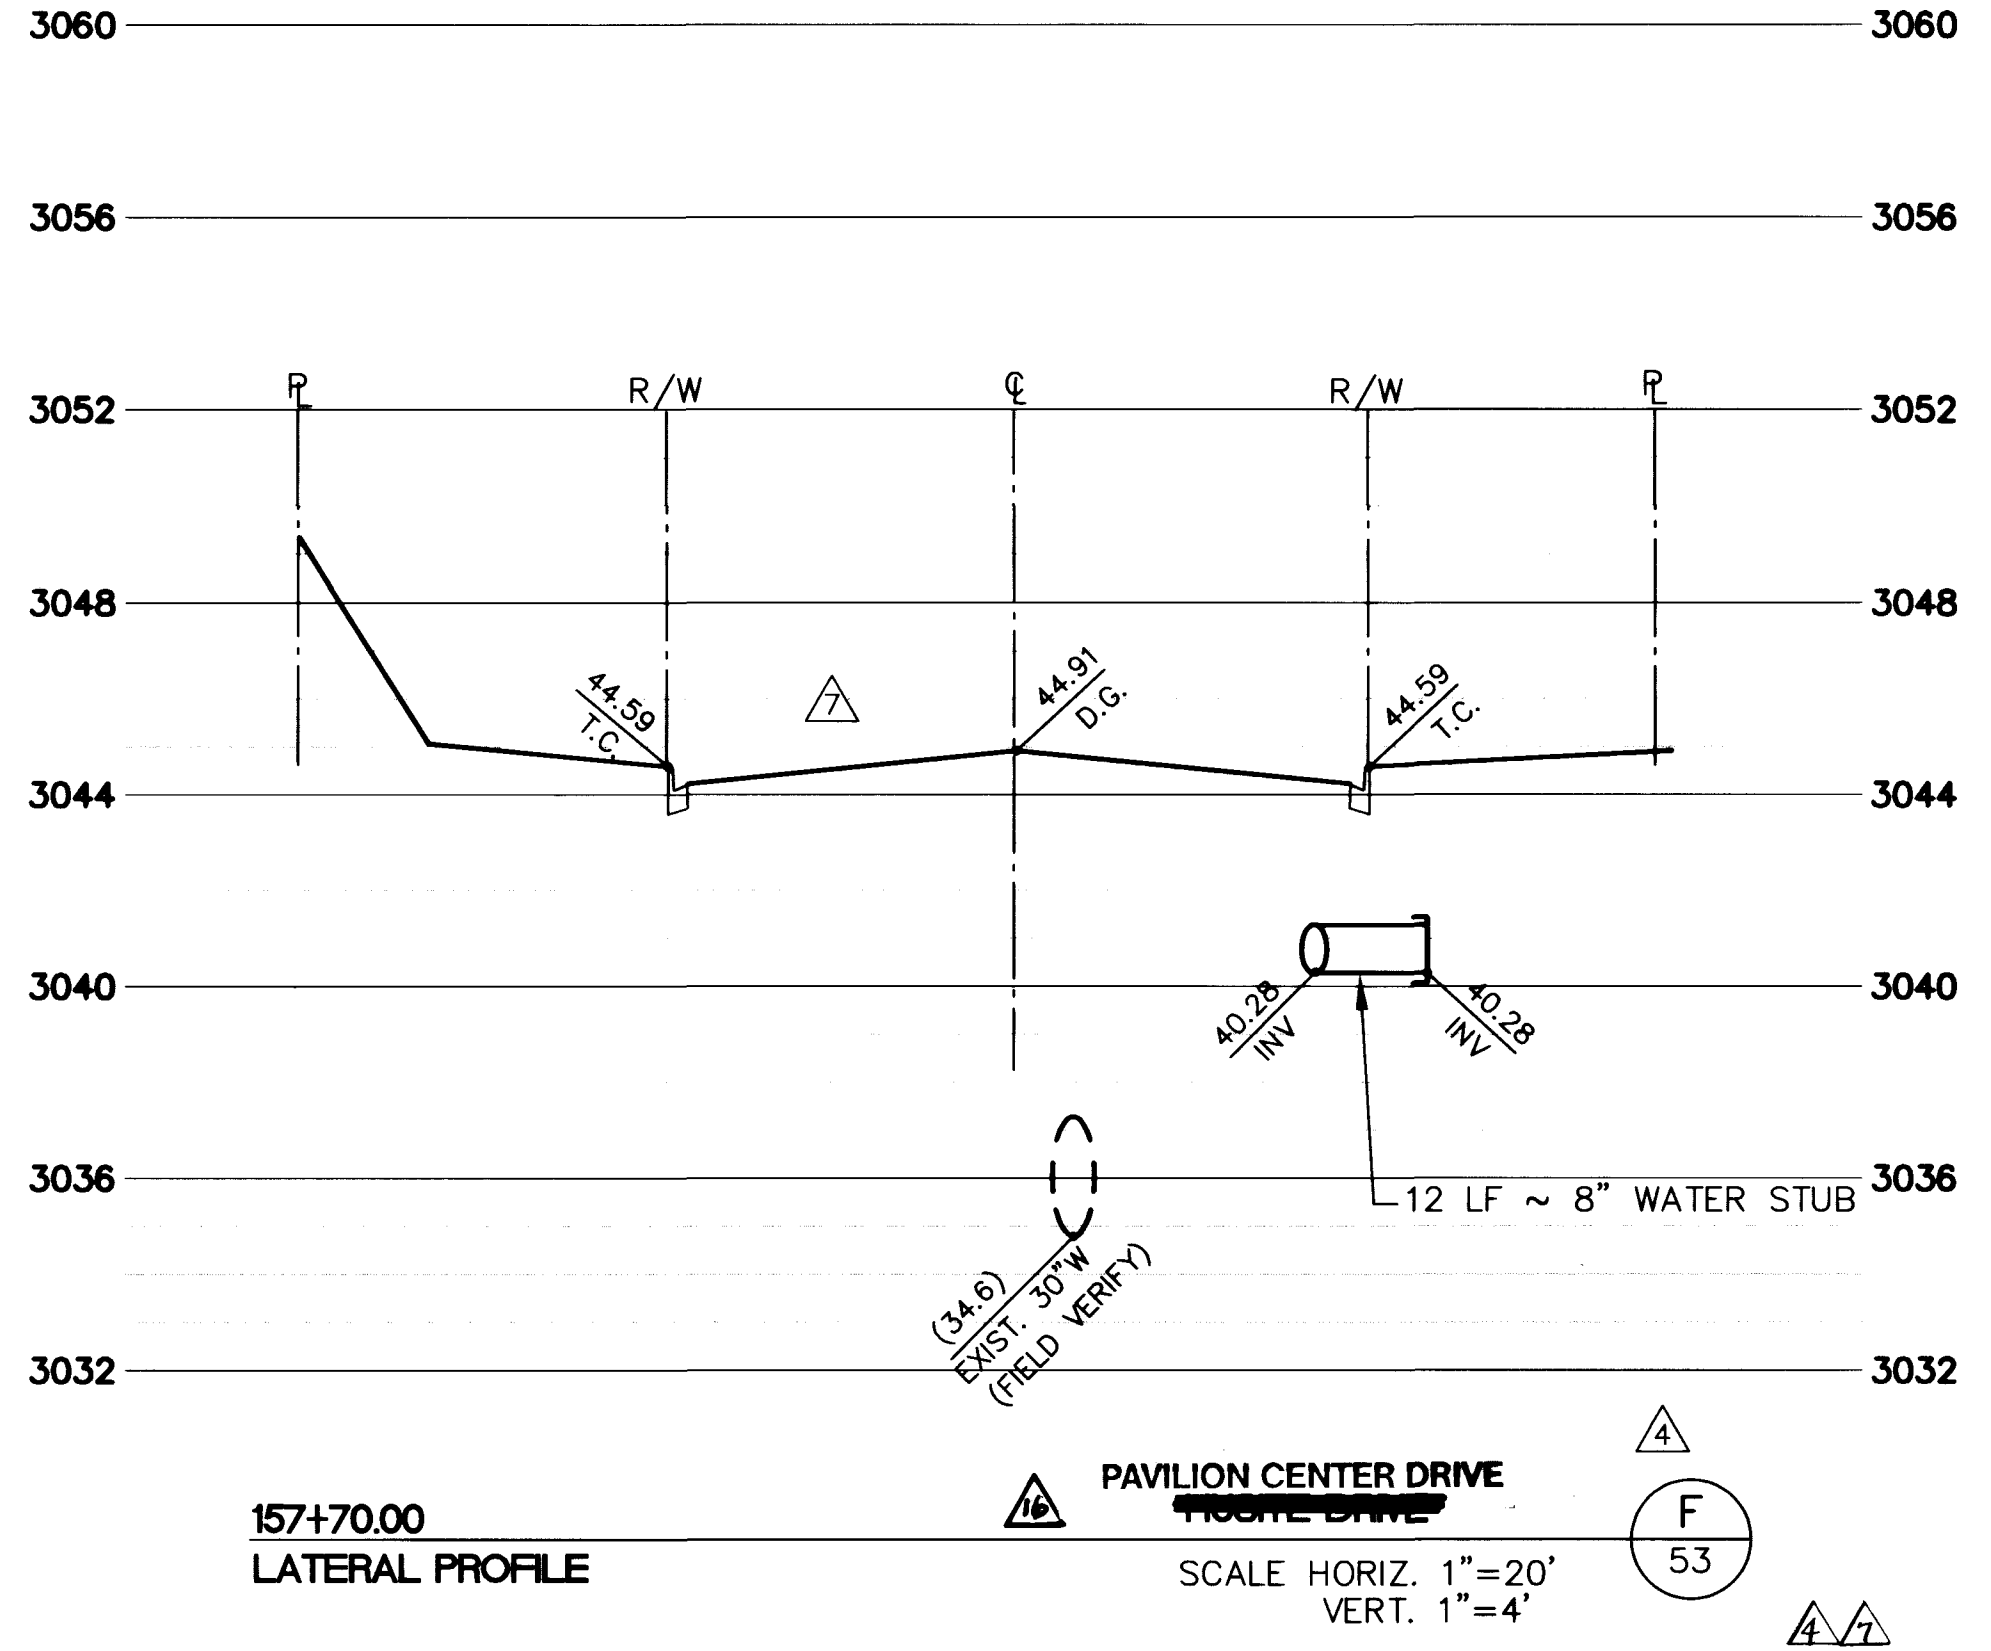

APPROVED FOR CONSTRUCTION
 1st 11/2 5-31-96
 12/2 8-28-96
 LWWD DATE

FINAL SUBMITTAL

REVISIONS:

NO.	DATE	DESCRIPTION
1	8/7/96	REVISED WATER STUB TO PARCELS 2 AND CH-2 AND F.H.
2	8/7/96	REVISED WATER STUB TO PARCELS 2 AND CH-2 AND F.H.
RECOMMENDED BY: CHRISTOPHER W. ANDERSON
 ENGINEER: CHRISTOPHER W. ANDERSON
 LICENSE NO.: 5071
 STATE OF NEVADA

G.C. WALLACE, INC.
 Engineering/Architecture
 1555 SOUTH RAINBOW BLVD., LAS VEGAS, NEVADA 89102

VILLAGE 11/12 THE ARBORS - UNIT 2A
 PAVILION CENTER DRIVE
 WATER LATERALS

SHEET **53**
 SHT 53 OF 65

