

VLLAGE 10

FUTURE SUMMERLIN PKWY.




PARCEL L
(CYPRESS POINTE BY PULTE HOMES)

PARCEL K
(OAK HILLS BY COLEMAN HOMES)

PARCEL J
(ARBOR GROVE BY DURABLE HOMES)

VILLAGE 8

BENCHMARK
CITY OF LAS VEGAS BENCHMARK
0LV001954 RIVET & PLATE IN TOP OF CURB NW SIDE
OF TOWN CENTER DRIVE & SOUTH CIRCLE ISLAND.
2725.923 NGVD 1929 DATUM
2728.37 NAVD 1988 DATUM (831.6074 M)
* 2726.19 SUMMERLIN DATUM

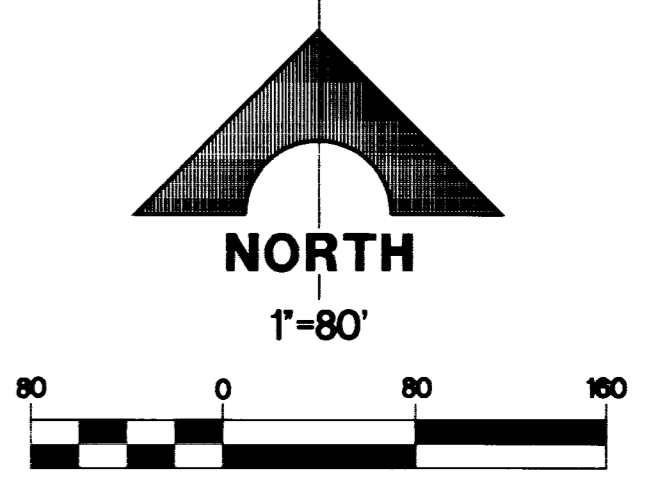

EXISTING IMPROVEMENT
PER "THE ARBORS AT
SUMMERLIN" VILLAGE 11/12
UNIT 2B CLV # 107Y-4463-2B

EXISTING IMPROVEMENT
PER "ANASAZI DRIVE
DRAINAGE CHANNEL"
CLV # 731-58A

RECOMMENDED CHRISTOPHER W. ANDERSON	REV. NO. 5071	DATE 8/07/07	REV. MANHOLE LOCATION	DATE 8/07/07	APP. DATE	DATE 8/07/07	DESCRIPTION	DATE 8/07/07	APP. DATE	DATE 8/07/07	DESCRIPTION
G.C. WALLACE, INC. Engineering/Architecture SUMMERLIN DIVISION (702) 353-0899											
SUMMERLIN VILLAGE 11/12 OFF-SITE DRAINAGE MASTER STORM DRAIN PLAN STA 10+24.00 TO 38+22.54											
SHEET 3 SHT 3 OF 7											
JOB NO. 62011.218											

C:\DMS\11112\UNIT-2B\15D\DRALLSD Tue Jun 17 07:59:06 1997 BY LUPE

219


S.I.D. 707 PROJECT NO. 62

327-V246

FINAL SUBMITTAL

VILLAGE 10

FUTURE SCHMIDT PARK

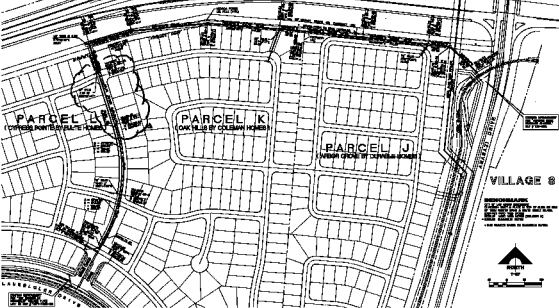

VILLAGE 8

INDICATED
STREETS ARE
NOT TO BE
CONSIDERED
AS PART OF
THE PROJECT
UNLESS
SPECIFICALLY
NOTED
OTHERWISE



















