



RECORD OF SURVEY


MONUMENT TIE MAP
A PORTION OF SUMMERLIN VILLAGE 23B UNIT NO. 2
A COMMON INTEREST COMMUNITY

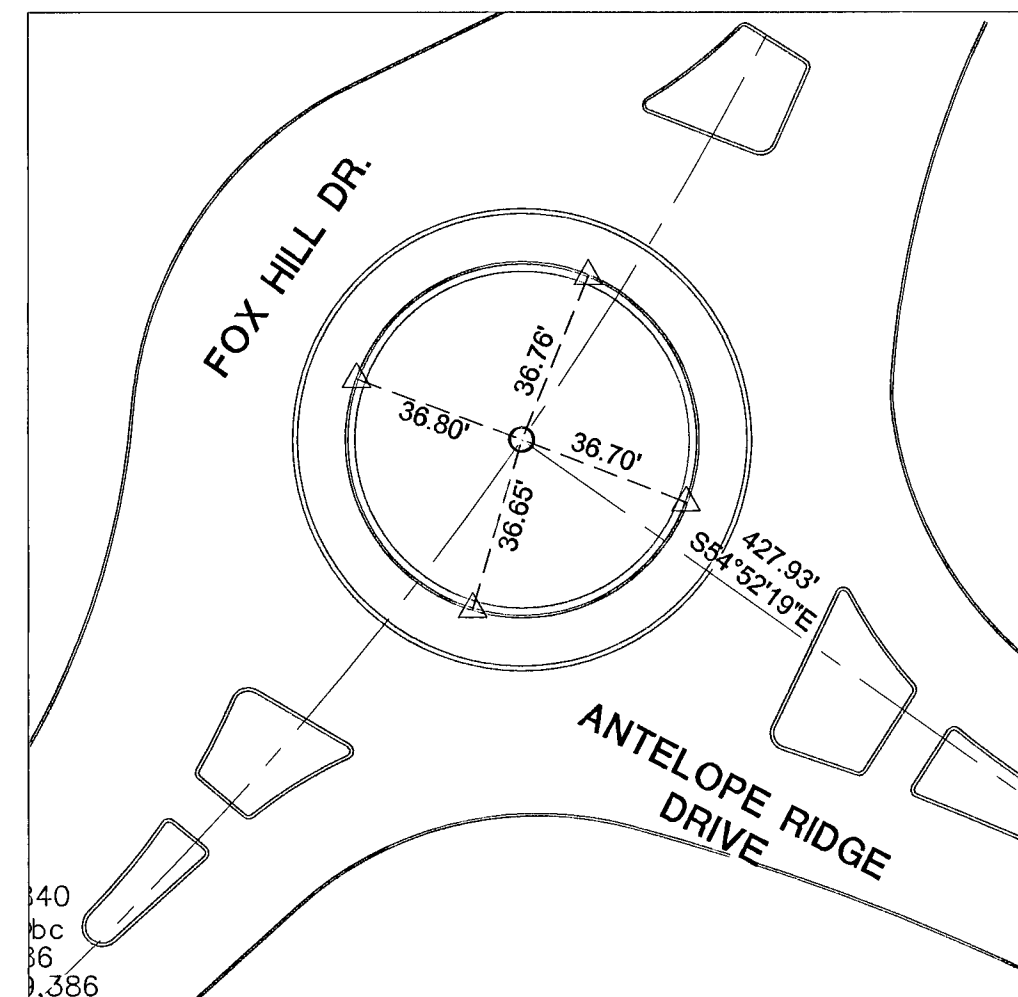


DETAIL "A"

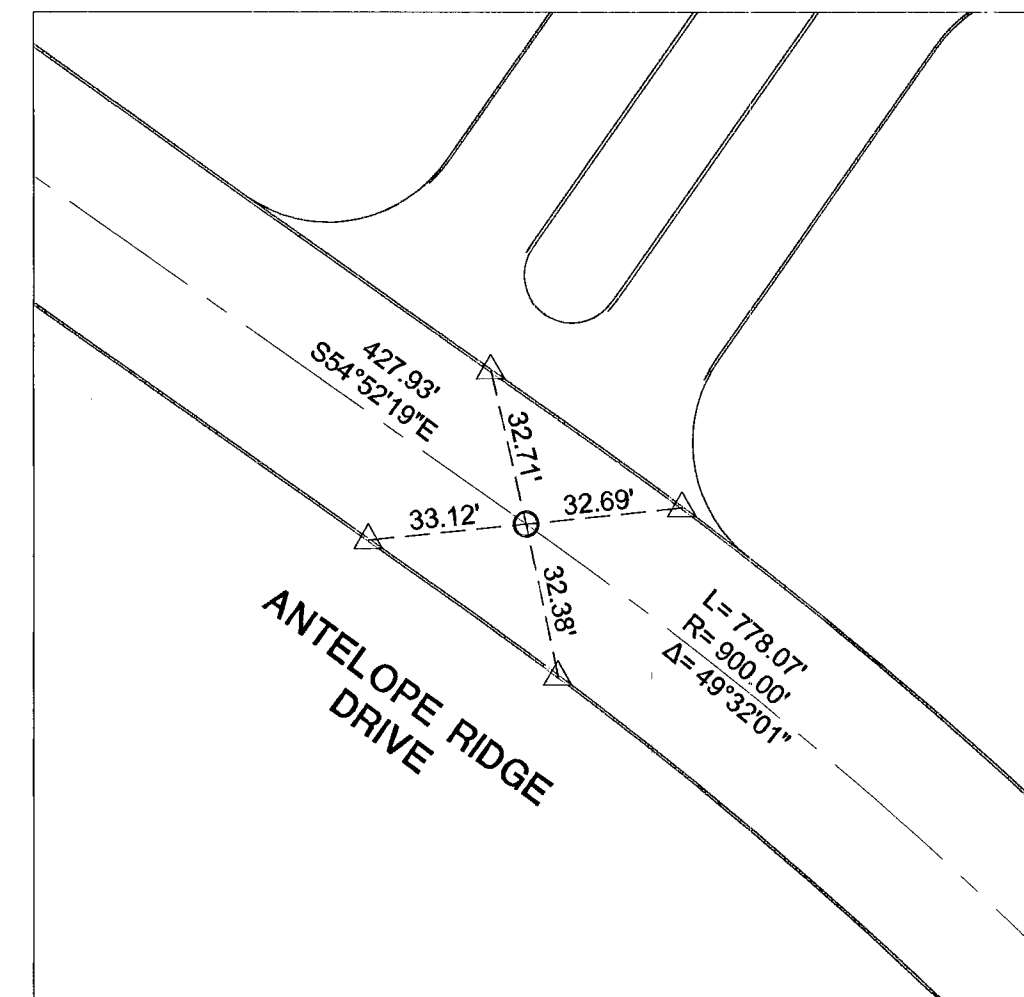


DETAIL "B"

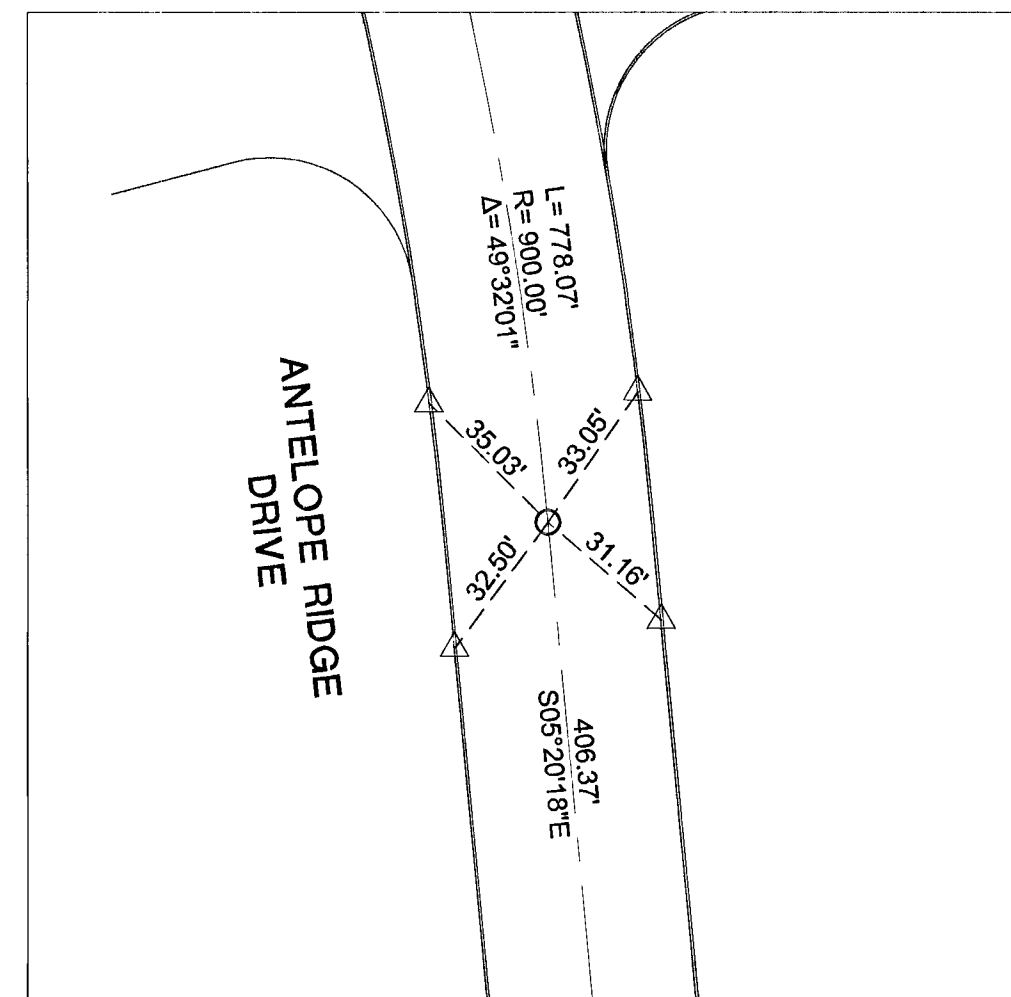


DETAIL "C"

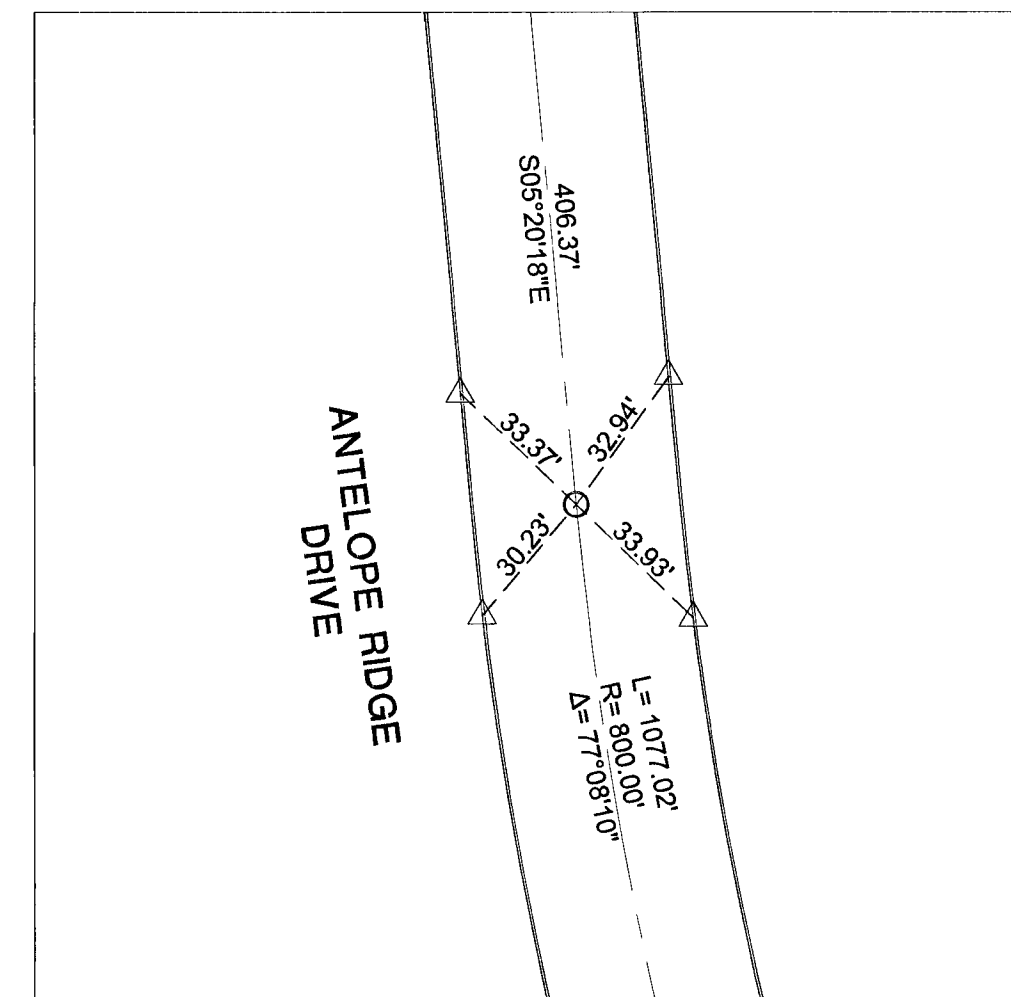

DETAIL "D"

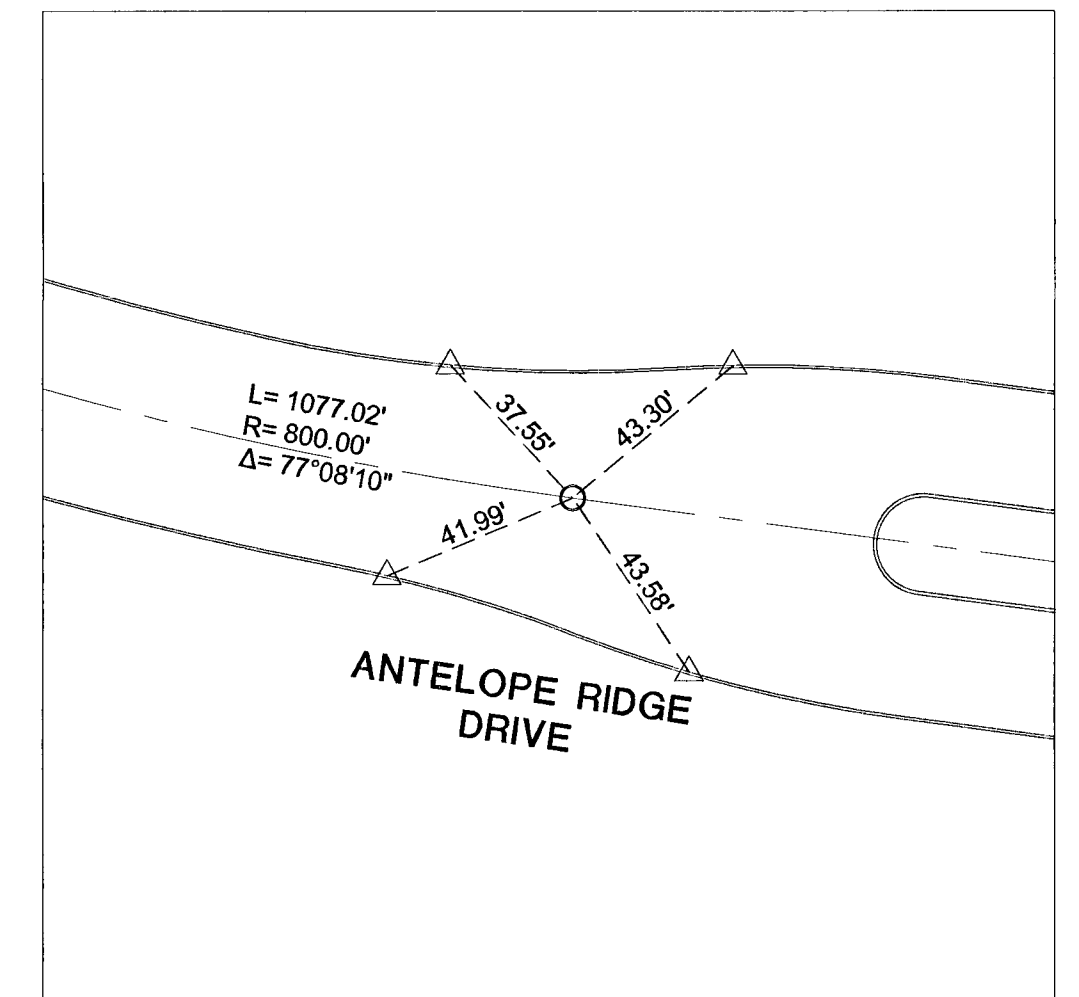

DETAIL "E"

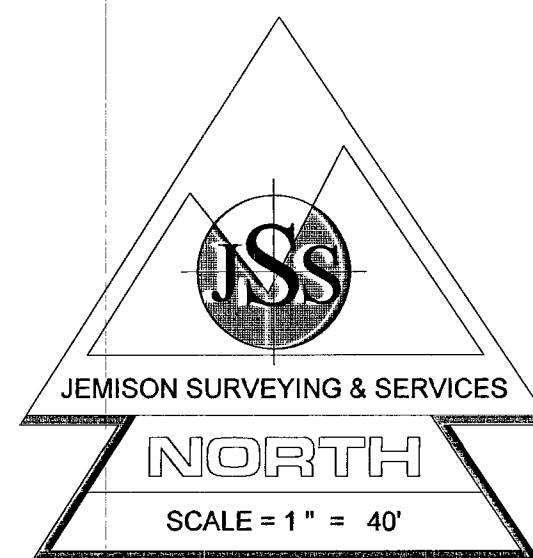

GRAPHIC SCALE

(IN FEET)
1 inch = 40 ft.

LEGEND

(NOTE: SOME SYMBOLS HAVE BEEN EXAGGERATED IN SCALE FOR CLARITY)


- SET TYPE III MONUMENT PLS 10598
- △ SET TYPE IV REFERENCE MONUMENT PLS 10598
- STREET CENTERLINE
- RIGHT-OF-WAY / LOT LINE

RECORD OF SURVEY

MONUMENT TIE MAP
PORTION OF SUMMERLIN VILLAGE 23B UNIT NO. 2
A COMMON INTEREST COMMUNITY

SITUATE IN THE SECTION 27 AND 34,
TOWNSHIP 20 SOUTH, RANGE 59 EAST, M.D.M.,
CLARK COUNTY, NEVADA.

DATE: 10-30-2014 JOB NUMBER: DRAWN BY: RPS

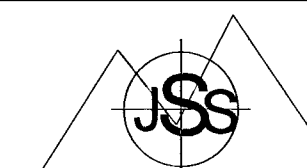

JEMISON SURVEYING & SERVICES
2690 CRIMSON CANYON DRIVE
LAS VEGAS, NEVADA, 89128
702-360-4838 FAX 702-360-4839

056-053