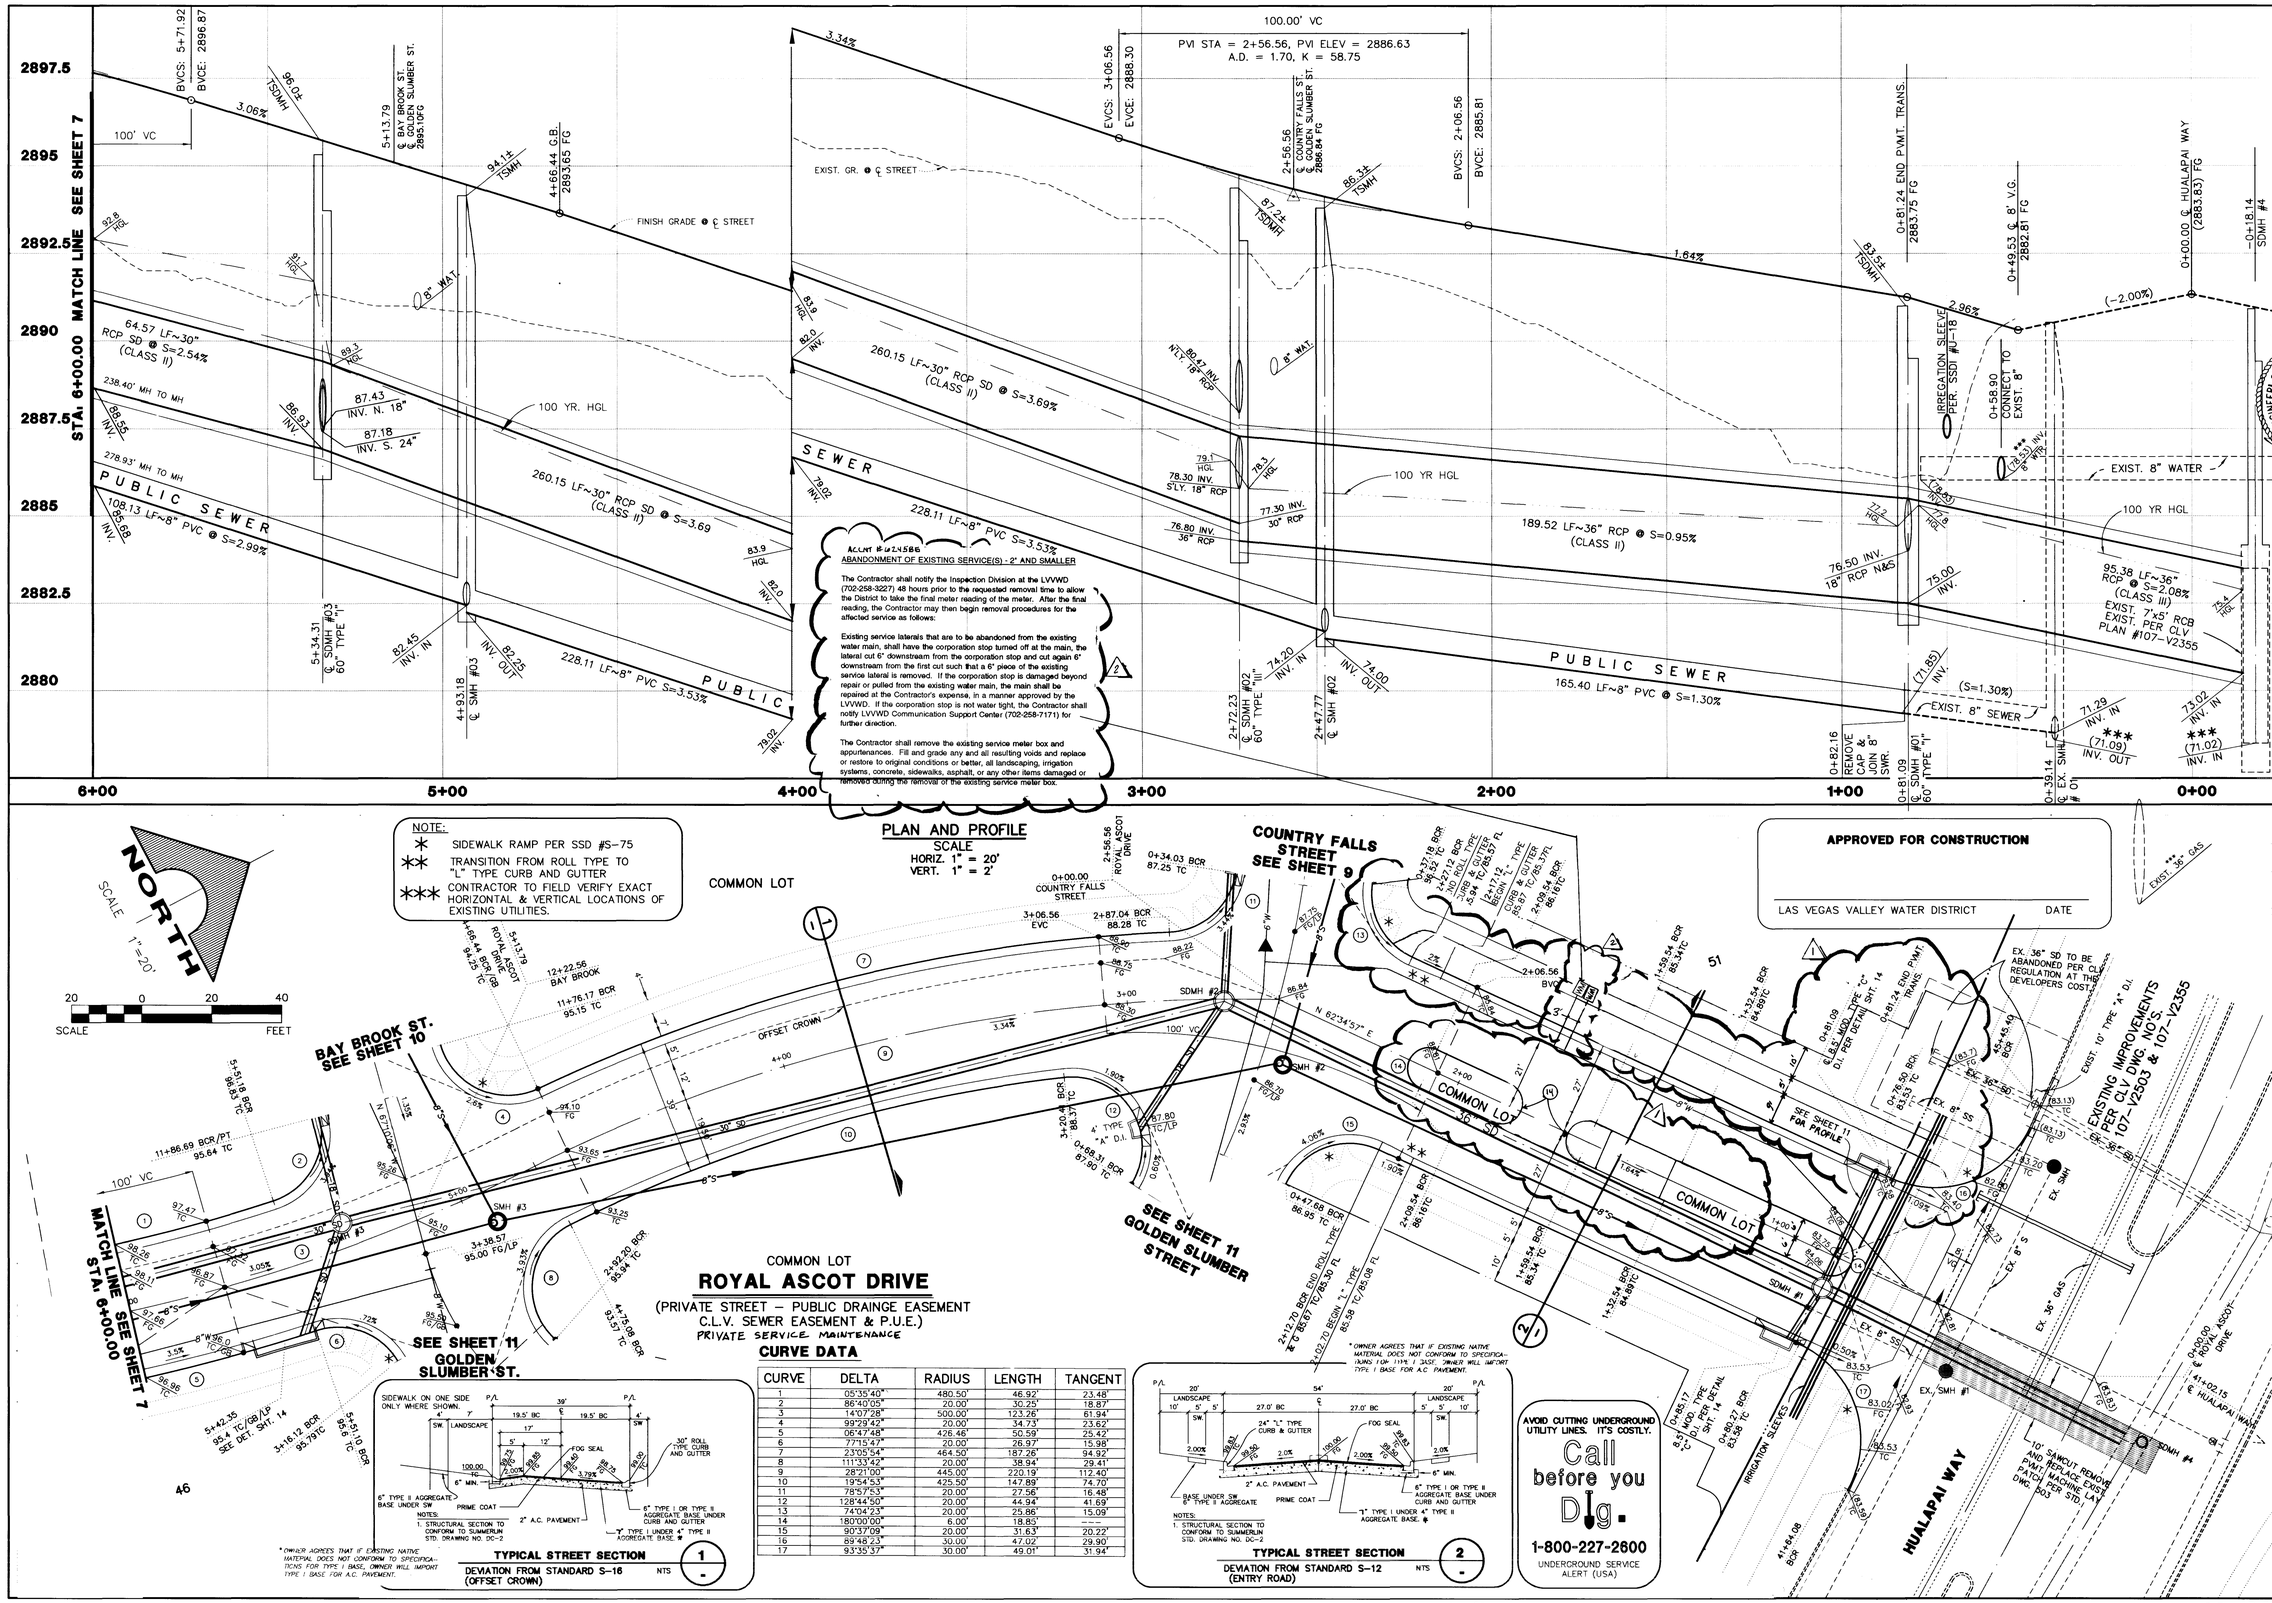

CURVE	DELTA	RADIUS	LENGTH	TANGENT
1	05°35'40"	480.50'	46.92'	23.48'
2	86°40'05"	20.00'	30.25'	18.87'
3	14°07'28"	500.00'	123.26'	61.94'
4	99°29'42"	20.00'	34.73'	23.62'
5	06°47'48"	426.46'	50.59'	25.42'
6	7°15'47"	20.00'	26.97'	15.98'
7	23°05'54"	464.50'	187.26'	94.92'
8	111°33'42"	20.00'	38.94'	29.41'
9	28°21'00"	445.00'	220.19'	112.40'
10	19°54'53"	425.50'	147.89'	74.70'
11	78°57'53"	20.00'	27.56'	16.48'
12	128°44'50"	20.00'	44.94'	41.69'
13	74°04'23"	20.00'	25.86'	15.09'
14	180°00'00"	6.00'	18.85'	---
15	90°37'09"	20.00'	31.63'	20.22'
17	93°35'37"	30.00'	49.01'	31.94'

REV	DATE	DESCRIPTION
1	10/5/97	REV. ENTRY WALK & ROAD. S.W. ADA
2	10/8/97	LOT 81, LL 4' TO INSET'N.
3	11/13/97	INSTALL WATER LAT. MOVE WATER

RECOMMENDED FOR ISSUANCE
SAMIH F. ALWATEK
P.E. NO. 10502
STATE OF NEVADA
PROFESSIONAL ENGINEER
No. 10502
DATE 11-13-97

G.C. WALLACE, INC.
Engineering/Architecture
1555 SOUTH RAINBOW BLVD./LAS VEGAS, NEVADA 89102
(702) 363-1200

CHRISTOPHER HOMES
SUMMERLIN VILLAGE 3, PARCEL 'O' - PHASE I
ROYAL ASCOT DR.
STA. 0+00.00 TO 6+50.00

SHEET 6 OF 15 SHEETS

Drawing: C:\DRAWINGS\745070\IMPDWGS\070PP106.DWG
Xrefs: 070SITE.DWG
February 26, 1997 3:30:16 p.m.

107Y-4510-1

 
PUBLIC SEWER
NORTH
ROYAL ASCOT DRIVE
Call before you Dig.
D.C. WALLACE, INC.
ROYAL ASCOT DR.

107Y-4510-1