
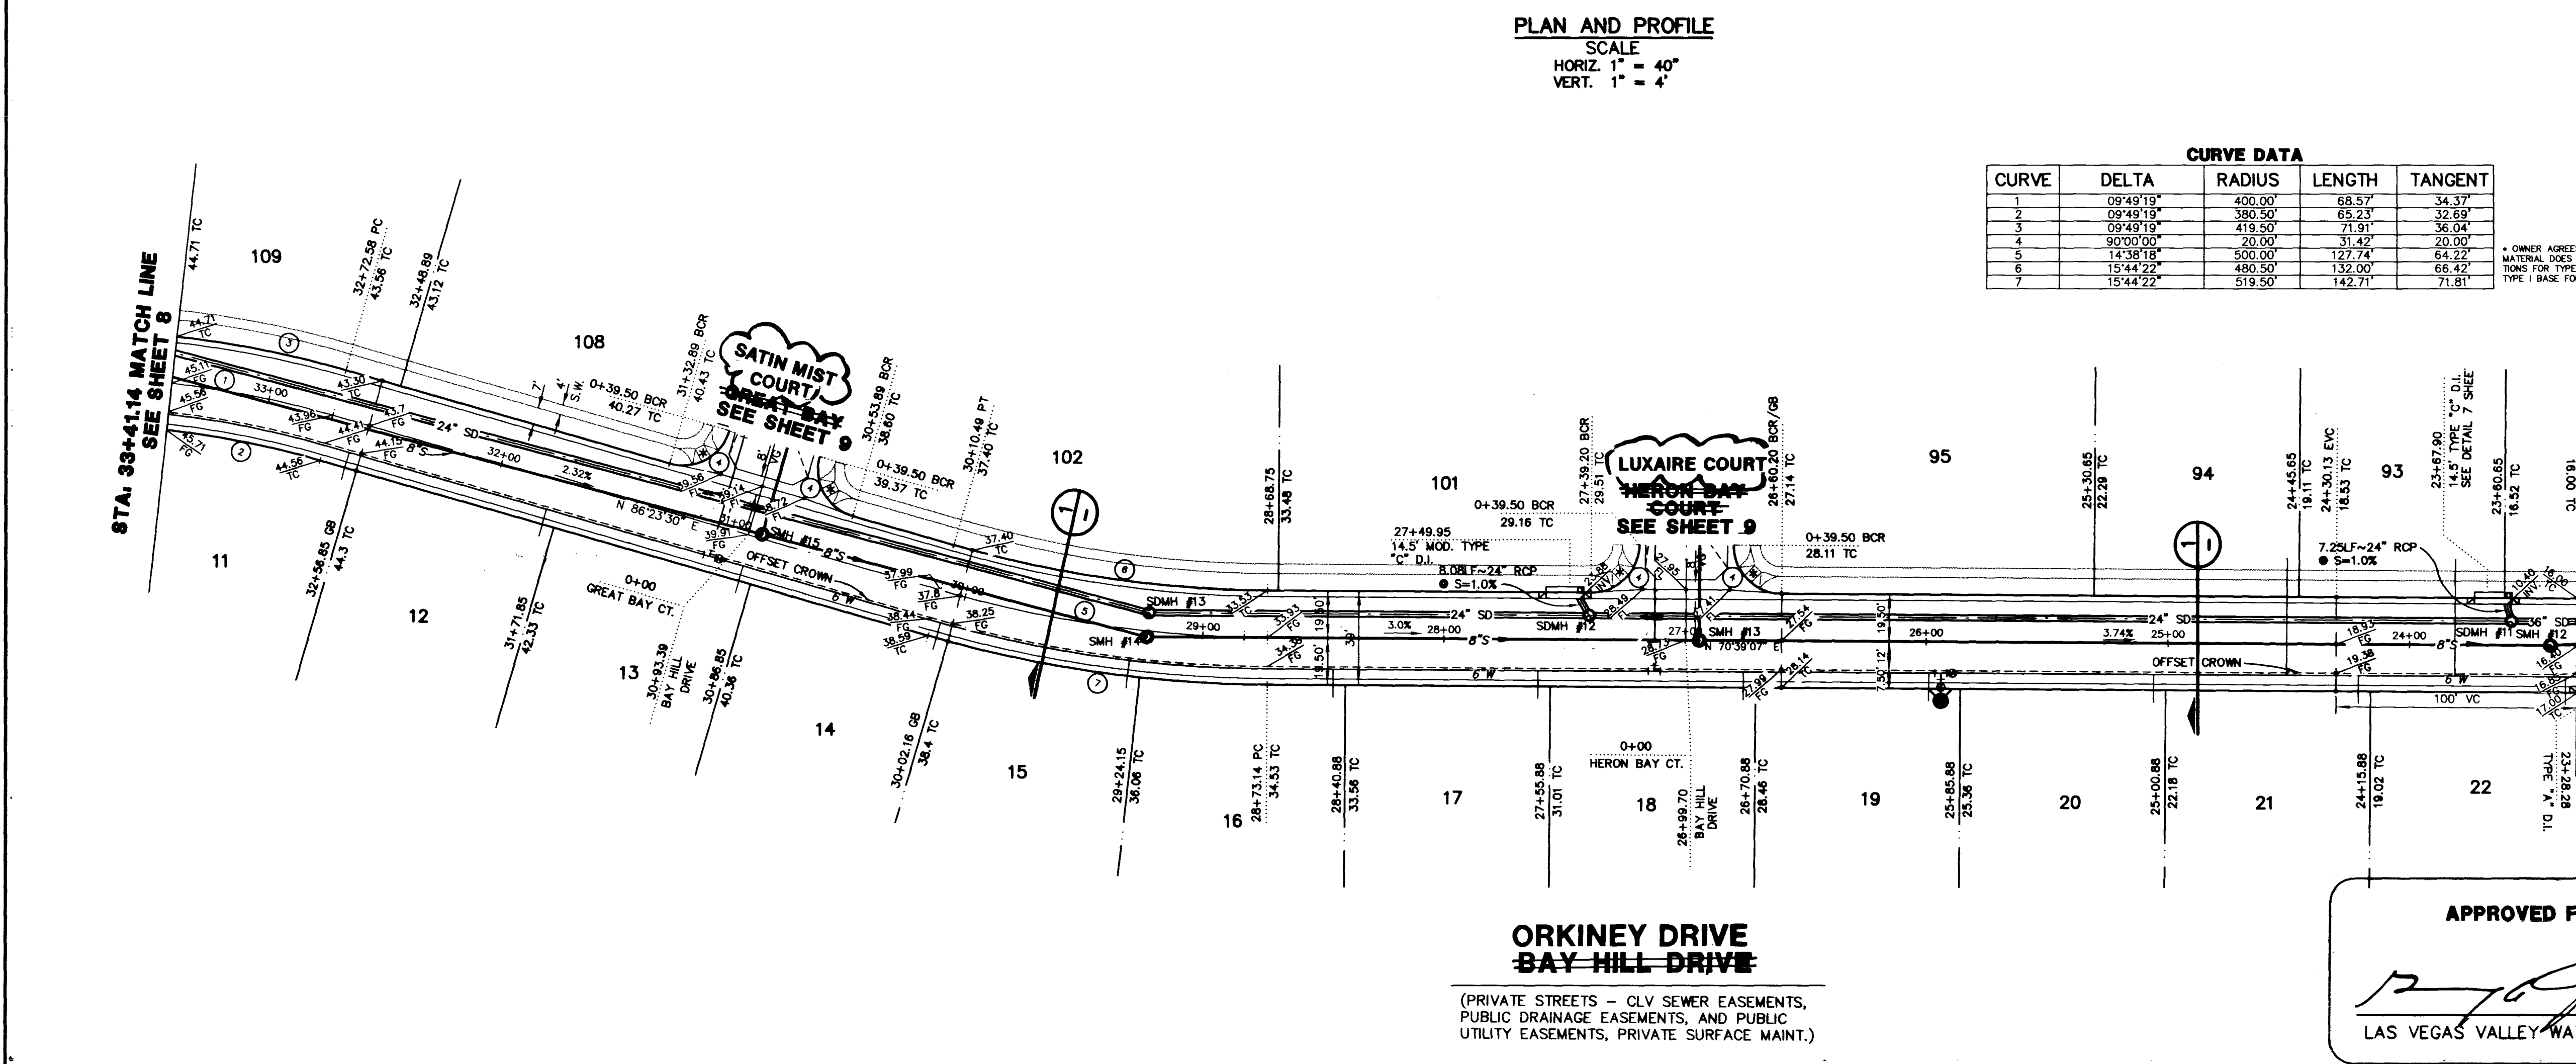


**PLAN AND PROFILE**  
SCALE  
HORIZ. 1" = 40'  
VERT. 1" = 4'

**CURVE DATA**

CURVE	DELTA	RADIUS	LENGTH	TANGENT
1	09°49'19"	400.00'	68.57'	34.37'
2	09°49'19"	380.50'	65.23'	32.69'
3	09°49'19"	419.50'	71.91'	36.04'
5	14°38'18"	500.00'	127.74'	64.22'
6	15°44'22"	480.50'	132.00'	66.42'
7	15°44'22"	519.50'	142.71'	71.81'

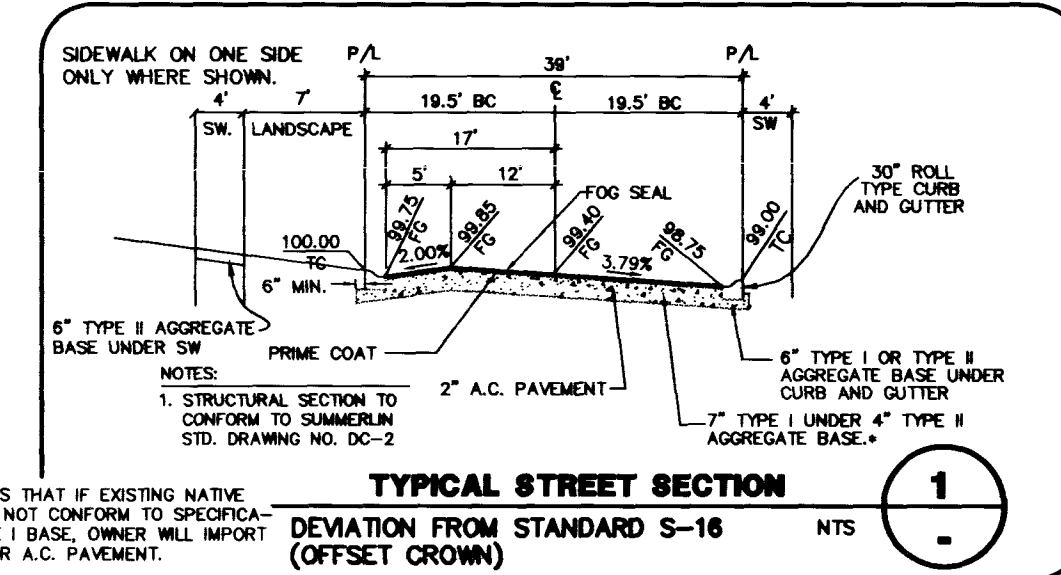

**APPROVED FOR CONSTRUCTION**

*[Signature]* 6/23/97  
LAS VEGAS VALLEY WATER DISTRICT DATE

**Call before you Dig.**  
1-800-227-2600  
UNDERGROUND SERVICE ALERT (USA)

**RECOMMENDED**

ENGINEER - STATE OF NEVADA  
SAM H. F. WALLACE  
No. 10928

REVISIONS

NO.	DATE	DESCRIPTION
1	05/02/97	REVISED

G. C. WALLACE, INC.  
Engineering/Architecture  
1555 SOUTH RAINBOW BLVD., LAS VEGAS, NEVADA 89102  
(702) 363-1200

CHRISTOPHER HOMES  
SUMMERLIN VILLAGE 3, PARCEL 'O' - PHASE II  
ORKINEY DRIVE  
STA. 16+50.00 TO 24+82.85

SHEET  
**7**  
OF 13 SHEETS

1074-4510-2  

