

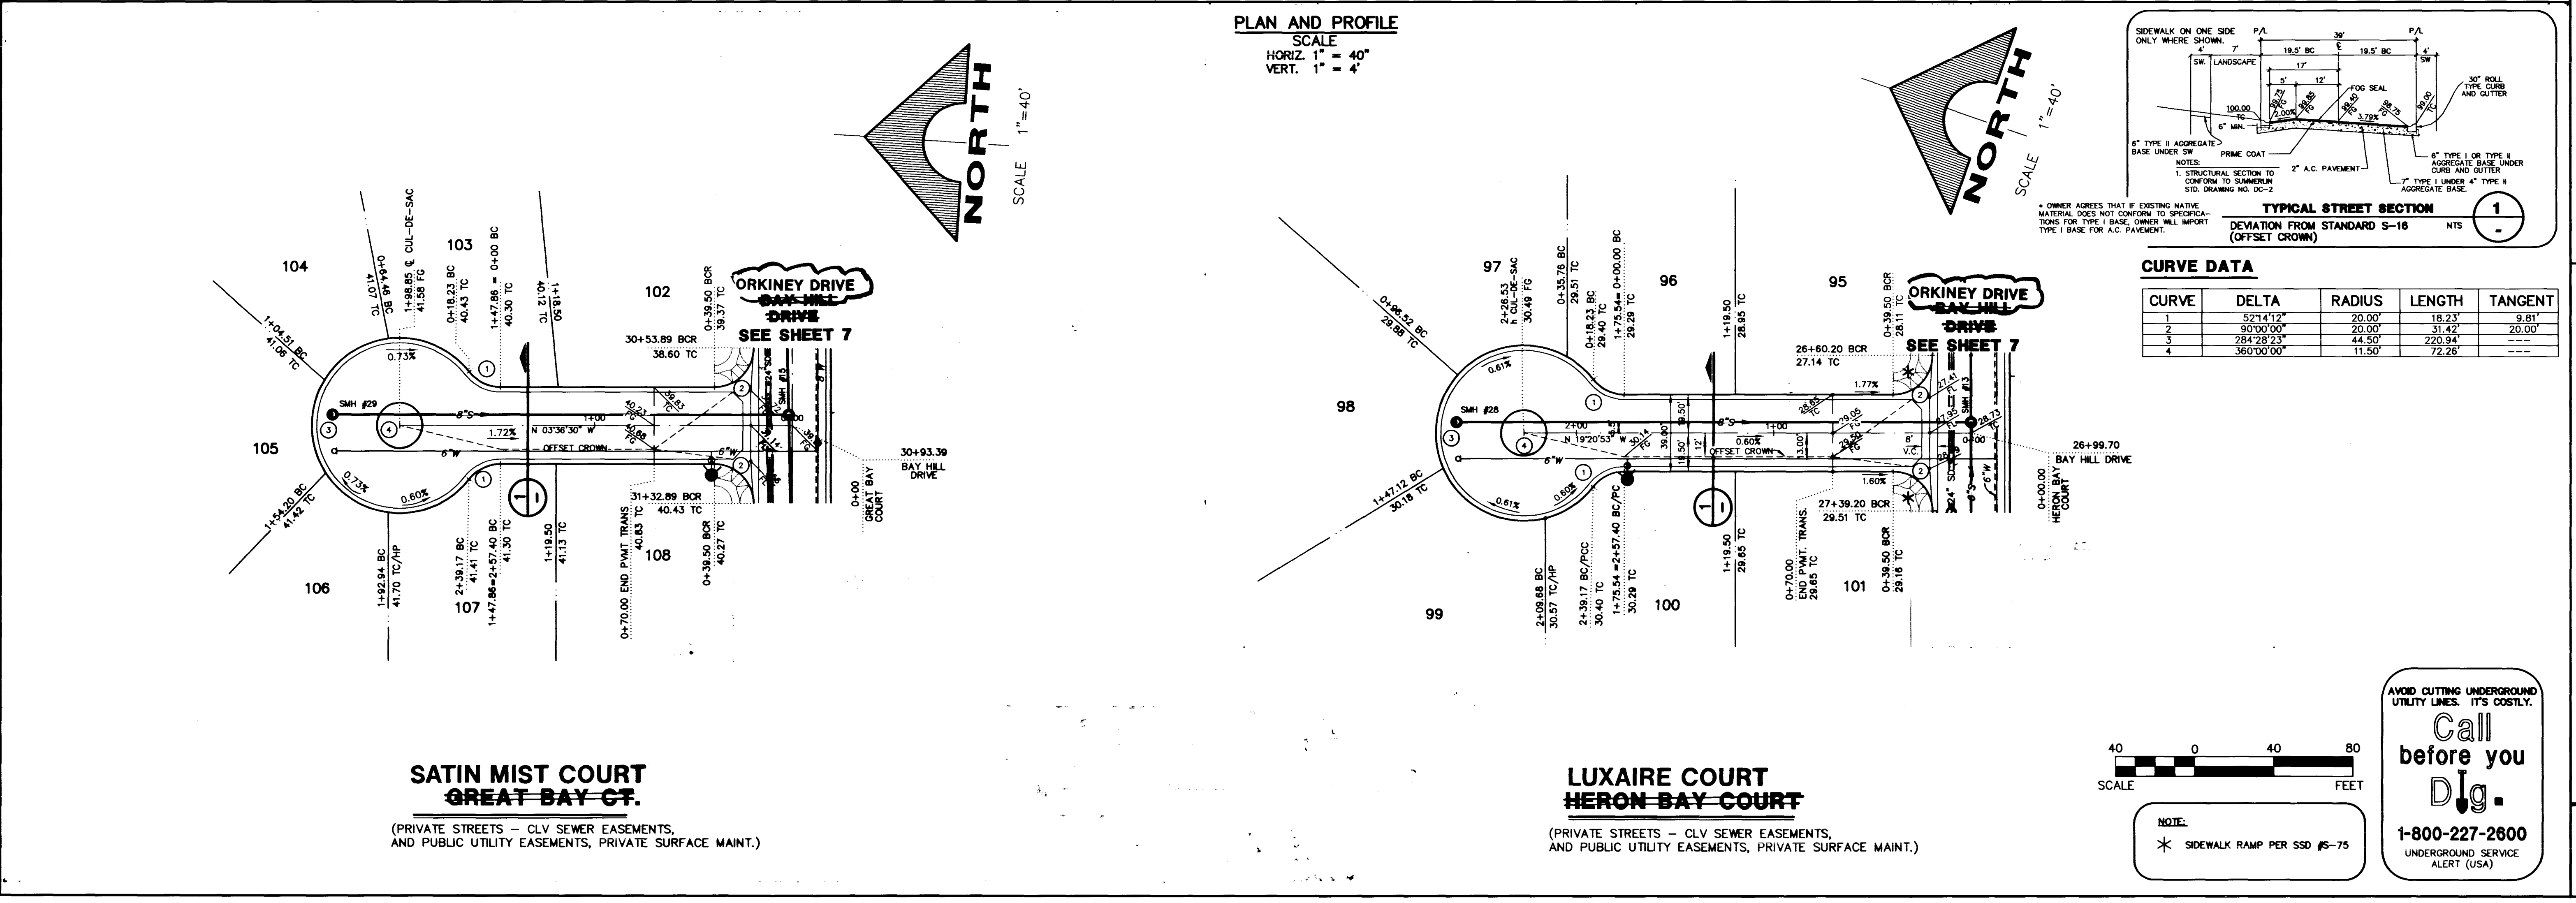


REV	DATE	DESCRIPTION
1	17/6/98	REV. ST. NAMES PER FINAL L&AP

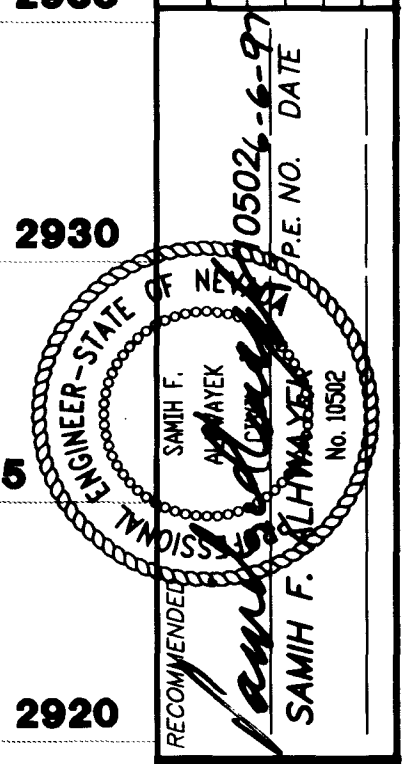


PLAN AND PROFILE
SCALE
HORIZ. 1" = 40'
VERT. 1" = 4'

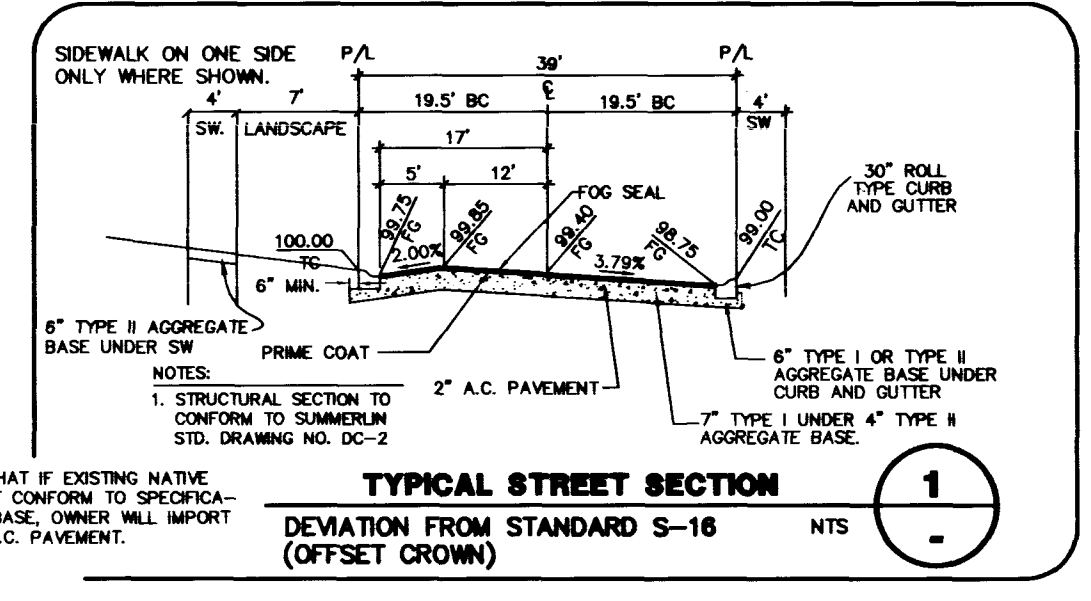

CURVE DATA

CURVE	DELTA	RADIUS	LENGTH	TANGENT
1	52°14'12"	20.00'	18.23'	9.81'
2	90°00'00"	20.00'	31.42'	20.00'
3	284°28'23"	44.50'	220.94'	---
4	360°00'00"	11.50'	72.28'	---

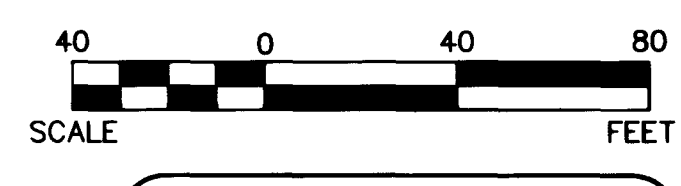

NOTE:
* SIDEWALK RAMP PER SSD §5-75

AVOID CUTTING UNDERGROUND UTILITY LINES. IT'S COSTLY.

Call before you Dig.

1-800-227-2600
UNDERGROUND SERVICE ALERT (USA)

CHRISTOPHER HOMES
SUMMERLIN VILLAGE 3, PARCEL 'O' - PHASE II
SATIN MIST COURT & LUXAIRE COURT
STA. 0+00.00 TO 1+98.86 & STA. 0+00.00 TO 2+28.83
Drawing: C:\745070\MPDWCS\070DF208.DWG
May 21, 1997 2:13:54 p.m.

G.C. WALLACE, INC.
Engineering/Architecture
1855 SOUTH RAINBOW BLVD./LAS VEGAS, NEVADA 89102
(702) 363-1200
Xref: 070SITE.DWG

SHEET
9
OF 13 SHEETS
1074-4510-2












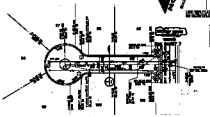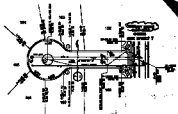





