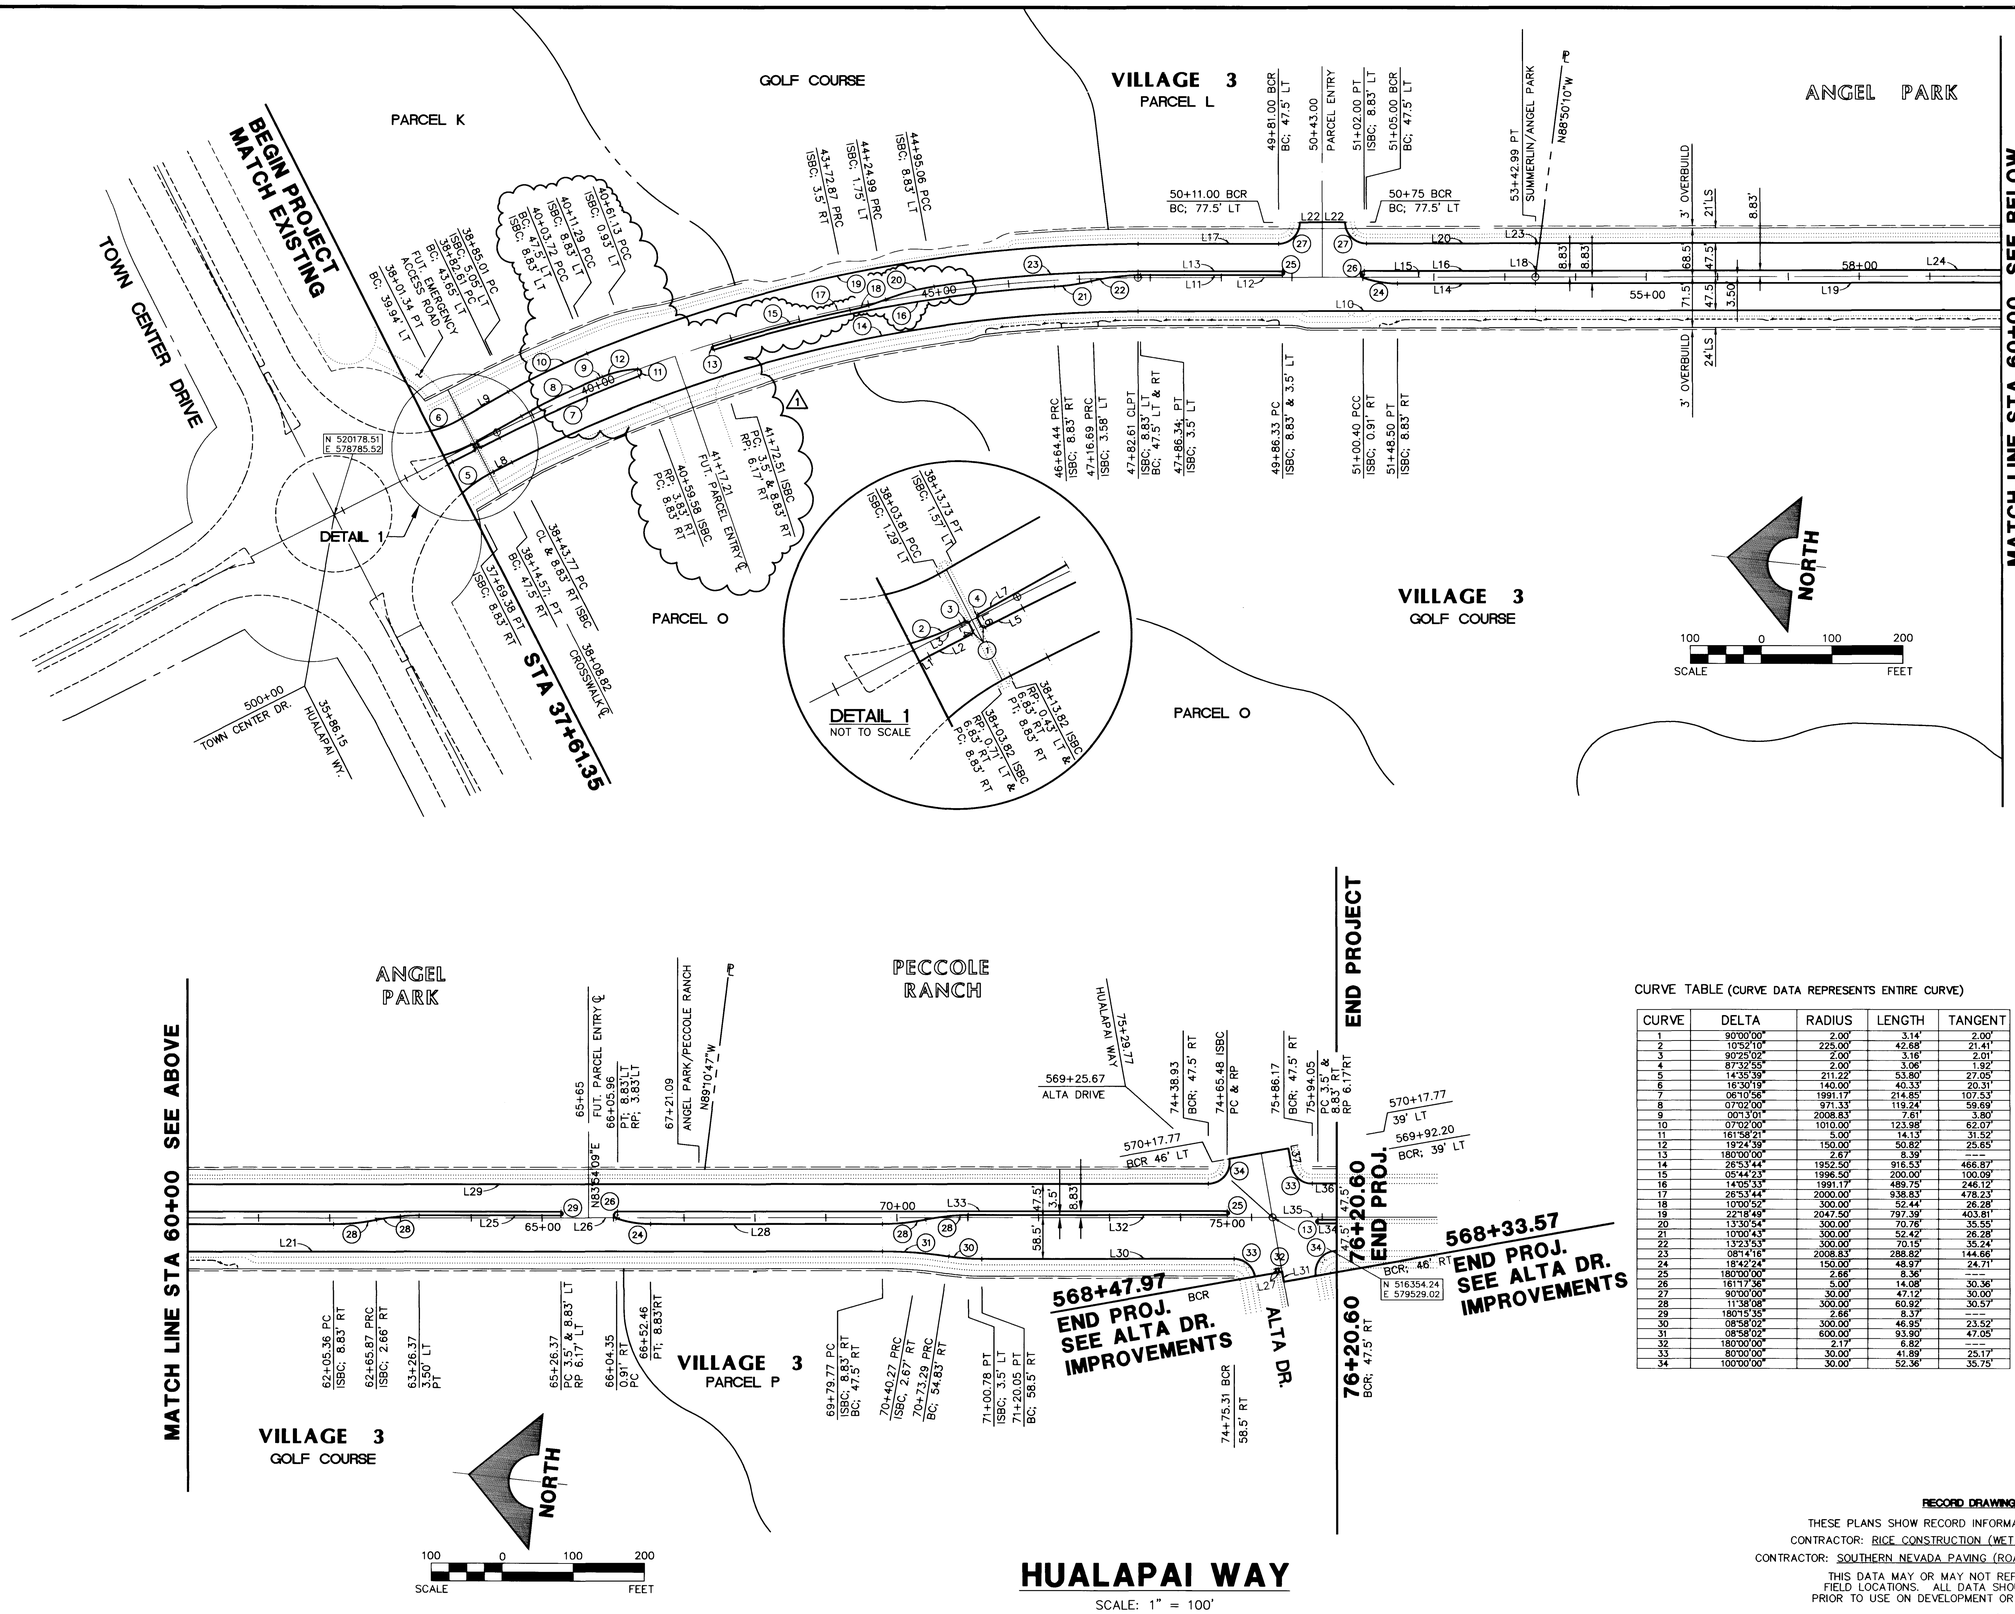

HUALAPAI WAY

SCALE: 1" = 100'

CURVE TABLE (CURVE DATA REPRESENTS ENTIRE CURVE)

CURVE	DELTA	RADIUS	LENGTH	TANGENT
1	90°00'00"	2.00'	3.14'	2.00'
2	10°52'10"	225.00'	42.68'	21.41'
3	90°25'02"	2.00'	3.16'	2.01'
4	87°32'55"	2.00'	3.06'	1.92'
5	14°35'39"	211.22'	53.80'	27.05'
6	16°30'19"	140.00'	40.33'	20.31'
7	06°10'56"	1991.17'	214.85'	107.53'
8	07°02'00"	971.33'	119.24'	59.69'
9	00°13'01"	2008.83'	7.61'	3.80'
10	07°02'00"	1010.00'	123.98'	62.07'
11	161°58'21"	5.00'	14.13'	31.52'
12	19°24'39"	150.00'	50.82'	25.65'
13	180°00'00"	2.67'	8.39'	----
14	26°53'44"	1952.50'	916.53'	466.87'
15	05°44'23"	1996.50'	200.00'	100.09'
16	14°05'33"	1991.17'	489.75'	246.12'
17	26°53'44"	2000.00'	938.83'	478.23'
18	10°00'52"	300.00'	52.44'	26.28'
19	22°18'49"	2047.50'	797.39'	403.81'
20	13°30'54"	300.00'	70.76'	35.55'
21	10°00'43"	300.00'	52.42'	26.28'
22	13°23'53"	300.00'	70.15'	35.24'
23	08°41'16"	2008.83'	288.82'	144.66'
24	18°42'24"	150.00'	48.97'	24.71'
25	180°00'00"	2.66'	8.36'	----
26	161°17'36"	5.00'	14.08'	30.36'
27	90°00'00"	30.00'	47.12'	30.00'
28	11°38'08"	300.00'	60.92'	30.57'
29	180°15'35"	2.66'	8.37'	----
30	08°58'02"	300.00'	46.95'	23.52'
31	08°58'02"	600.00'	93.90'	47.05'
32	180°00'00"	2.17'	6.82'	----
33	80°00'00"	30.00'	41.89'	25.17'
34	100°00'00"	30.00'	52.36'	35.75'

LINE TABLE (LINE DATA REPRESENTS ENTIRE LINE)

LINE	BEARING	DISTANCE
L1	N37°52'21"W	8.06'
L2	N33°00'00"W	34.45'
L3	N33°00'00"W	82.42'
L4	N57°00'00"E	6.12'
L5	N33°00'00"W	29.96'
L6	N57°00'00"E	6.40'
L7	N35°27'05"W	71.44'
L8	N33°00'00"W	29.20'
L9	N35°27'05"W	82.20'
L10	N06°06'16"W	560.38'
L11	N06°06'16"W	200.00'
L12	N06°06'16"W	260.39'
L13	N06°06'16"W	203.73'
L14	N06°06'16"W	194.49'
L15	N06°06'16"W	299.99'
L16	N06°06'16"W	240.99'
L17	N06°06'16"W	198.39'
L18	N06°06'16"W	1.13'
L19	N06°05'51"W	862.37'
L20	N06°06'15"W	237.99'
L21	N06°05'51"W	1636.77'
L22	N06°06'16"W	32.00'
L23	N06°06'15"W	6.05'
L24	N06°05'51"W	1182.26'
L25	N06°05'51"W	200.00'
L26	N06°05'51"W	2186.78'
L27	N73°54'09"E	5.75'
L28	N06°05'51"W	327.30'
L29	N06°05'51"W	2089.89'
L30	N06°09'51"W	355.26'
L31	N73°54'09"E	14.40'
L32	N06°05'51"W	364.71'
L33	N06°05'51"W	859.53'
L34	N06°05'51"W	28.56'
L35	N06°05'51"W	90.84'
L36	N06°05'51"W	34.44'
L37	N73°54'09"E	25.57'

RECORD DRAWINGS

THESE PLANS SHOW RECORD INFORMATION RECEIVED FROM:

CONTRACTOR: RICE CONSTRUCTION (WET UTILITY IMP.) 12-30-96

CONTRACTOR: SOUTHERN NEVADA PAVING (ROADWAY IMPROVEMENTS)3/19/97

THIS DATA MAY OR MAY NOT REFLECT THE ACTUAL FIELD LOCATIONS. ALL DATA SHOULD BE CONFIRMED PRIOR TO USE ON DEVELOPMENT OR ENGINEERING PLANS.

REV.	DATE	DESCRIPTION	APPROVAL
1	6/03/96	REVISE MEDIAN ISLAND	7/24/96

RECOMMENDED: BERT A. HUGHES

BERT A. HUGHES, R.E. CIVIL, DATE

REGISTERED PROFESSIONAL ENGINEER STATE OF NEVADA

G.C. WALLACE, INC.
Engineering/Architecture
1555 SOUTH RAINBOW BLVD./LAS VEGAS, NEVADA 89102

SUMMERLIN
VILLAGE 3 HUALAPAI WAY IMPROVEMENTS
HORIZONTAL CONTROL PLAN

SHEET 3
SHT 3 OF 21

JOB NO. 62003.206 June 03, 1996 11:28:26 a.m. QT Drawing: C:\DWG\VL3\HW-90-12\90-FINAL\HW3-CTL.DWG

582

S.I.D. 404 PROJECT NO. 8 AND S.I.D. 707 PROJECT NO. 4B, 4C, 4D 107-V2503

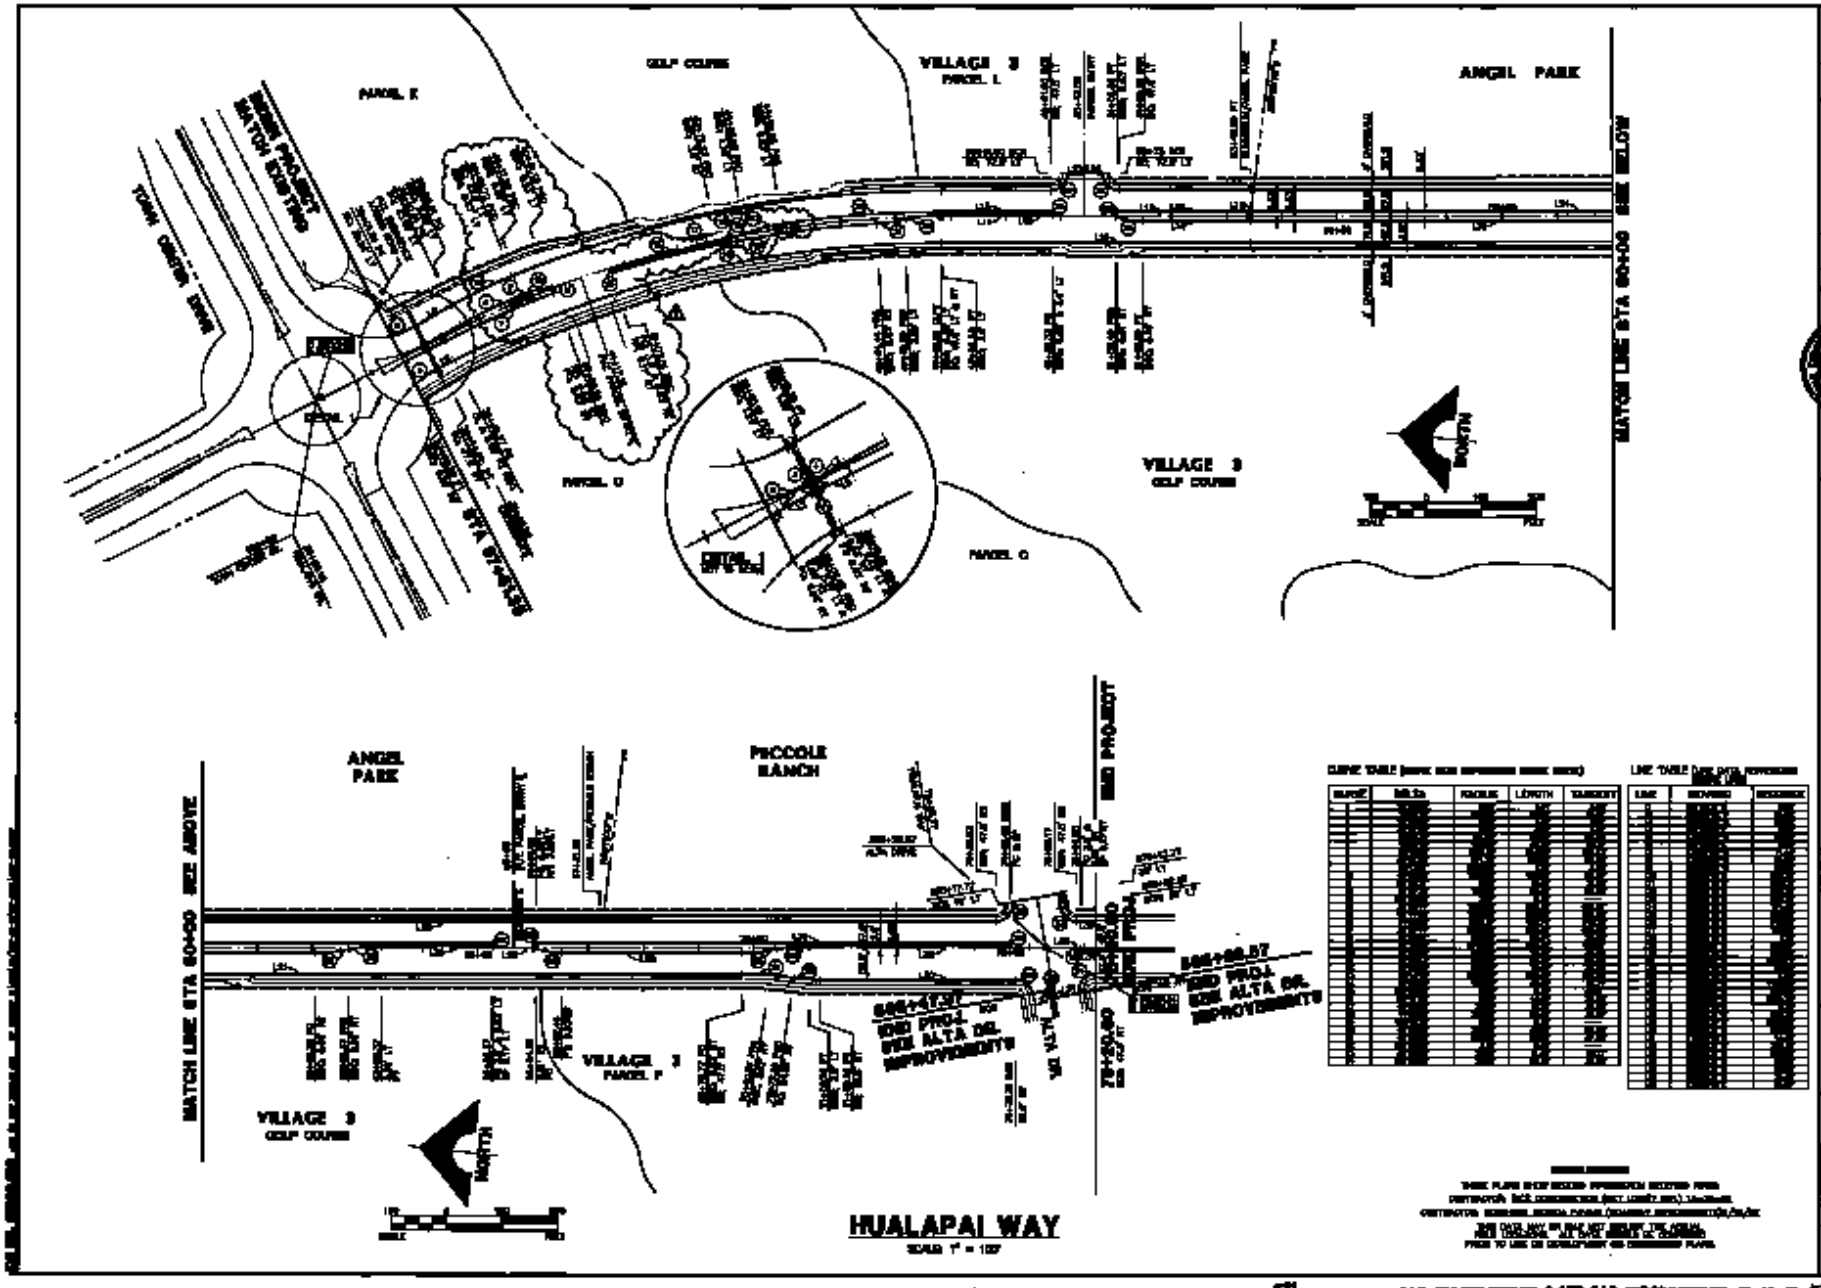
GOLF COURSE
VILLAGE 3
PARCEL L
ANGEL PARK
PARCEL E
PARCEL O
VILLAGE 3
GOLF COURSE
MATCH LINE STA 60+00 SEE BELOW
NORTH
ANGEL PARK
PICCOLE RANCH
MATCH LINE STA 60+00 SEE ABOVE
VILLAGE 3
PARCEL P
VILLAGE 3
GOLF COURSE
NORTH
HUALAPAI WAY
SCALE 1" = 100'
CURVE TABLE
LINE TABLE
D.C. WALLACE, INC.
VILLAGE 3 HUALAPAI WAY IMPROVEMENTS
HORIZONTAL CONTROL PLAN
SHEET
3