


Book No. _____

Instrument No. _____

LEGEND

- SET 5/8" REBAR AND ALUM. CAP
STAMPED P.L.S. 7755 W/ ALUMINUM
CAP TIES IN TOP OF CURB
(UNLESS OTHERWISE NOTED)
- SET MONUMENTATION PER N.R.S. 278.371
- 84 LOT NUMBER
TOTAL RESIDENTIAL LOTS = 125
COMMON LOTS IN SUBDIVISION = 4
- 3 BLOCK NUMBER
- SUBDIVISION BOUNDARY LINE
- STREET CENTERLINE

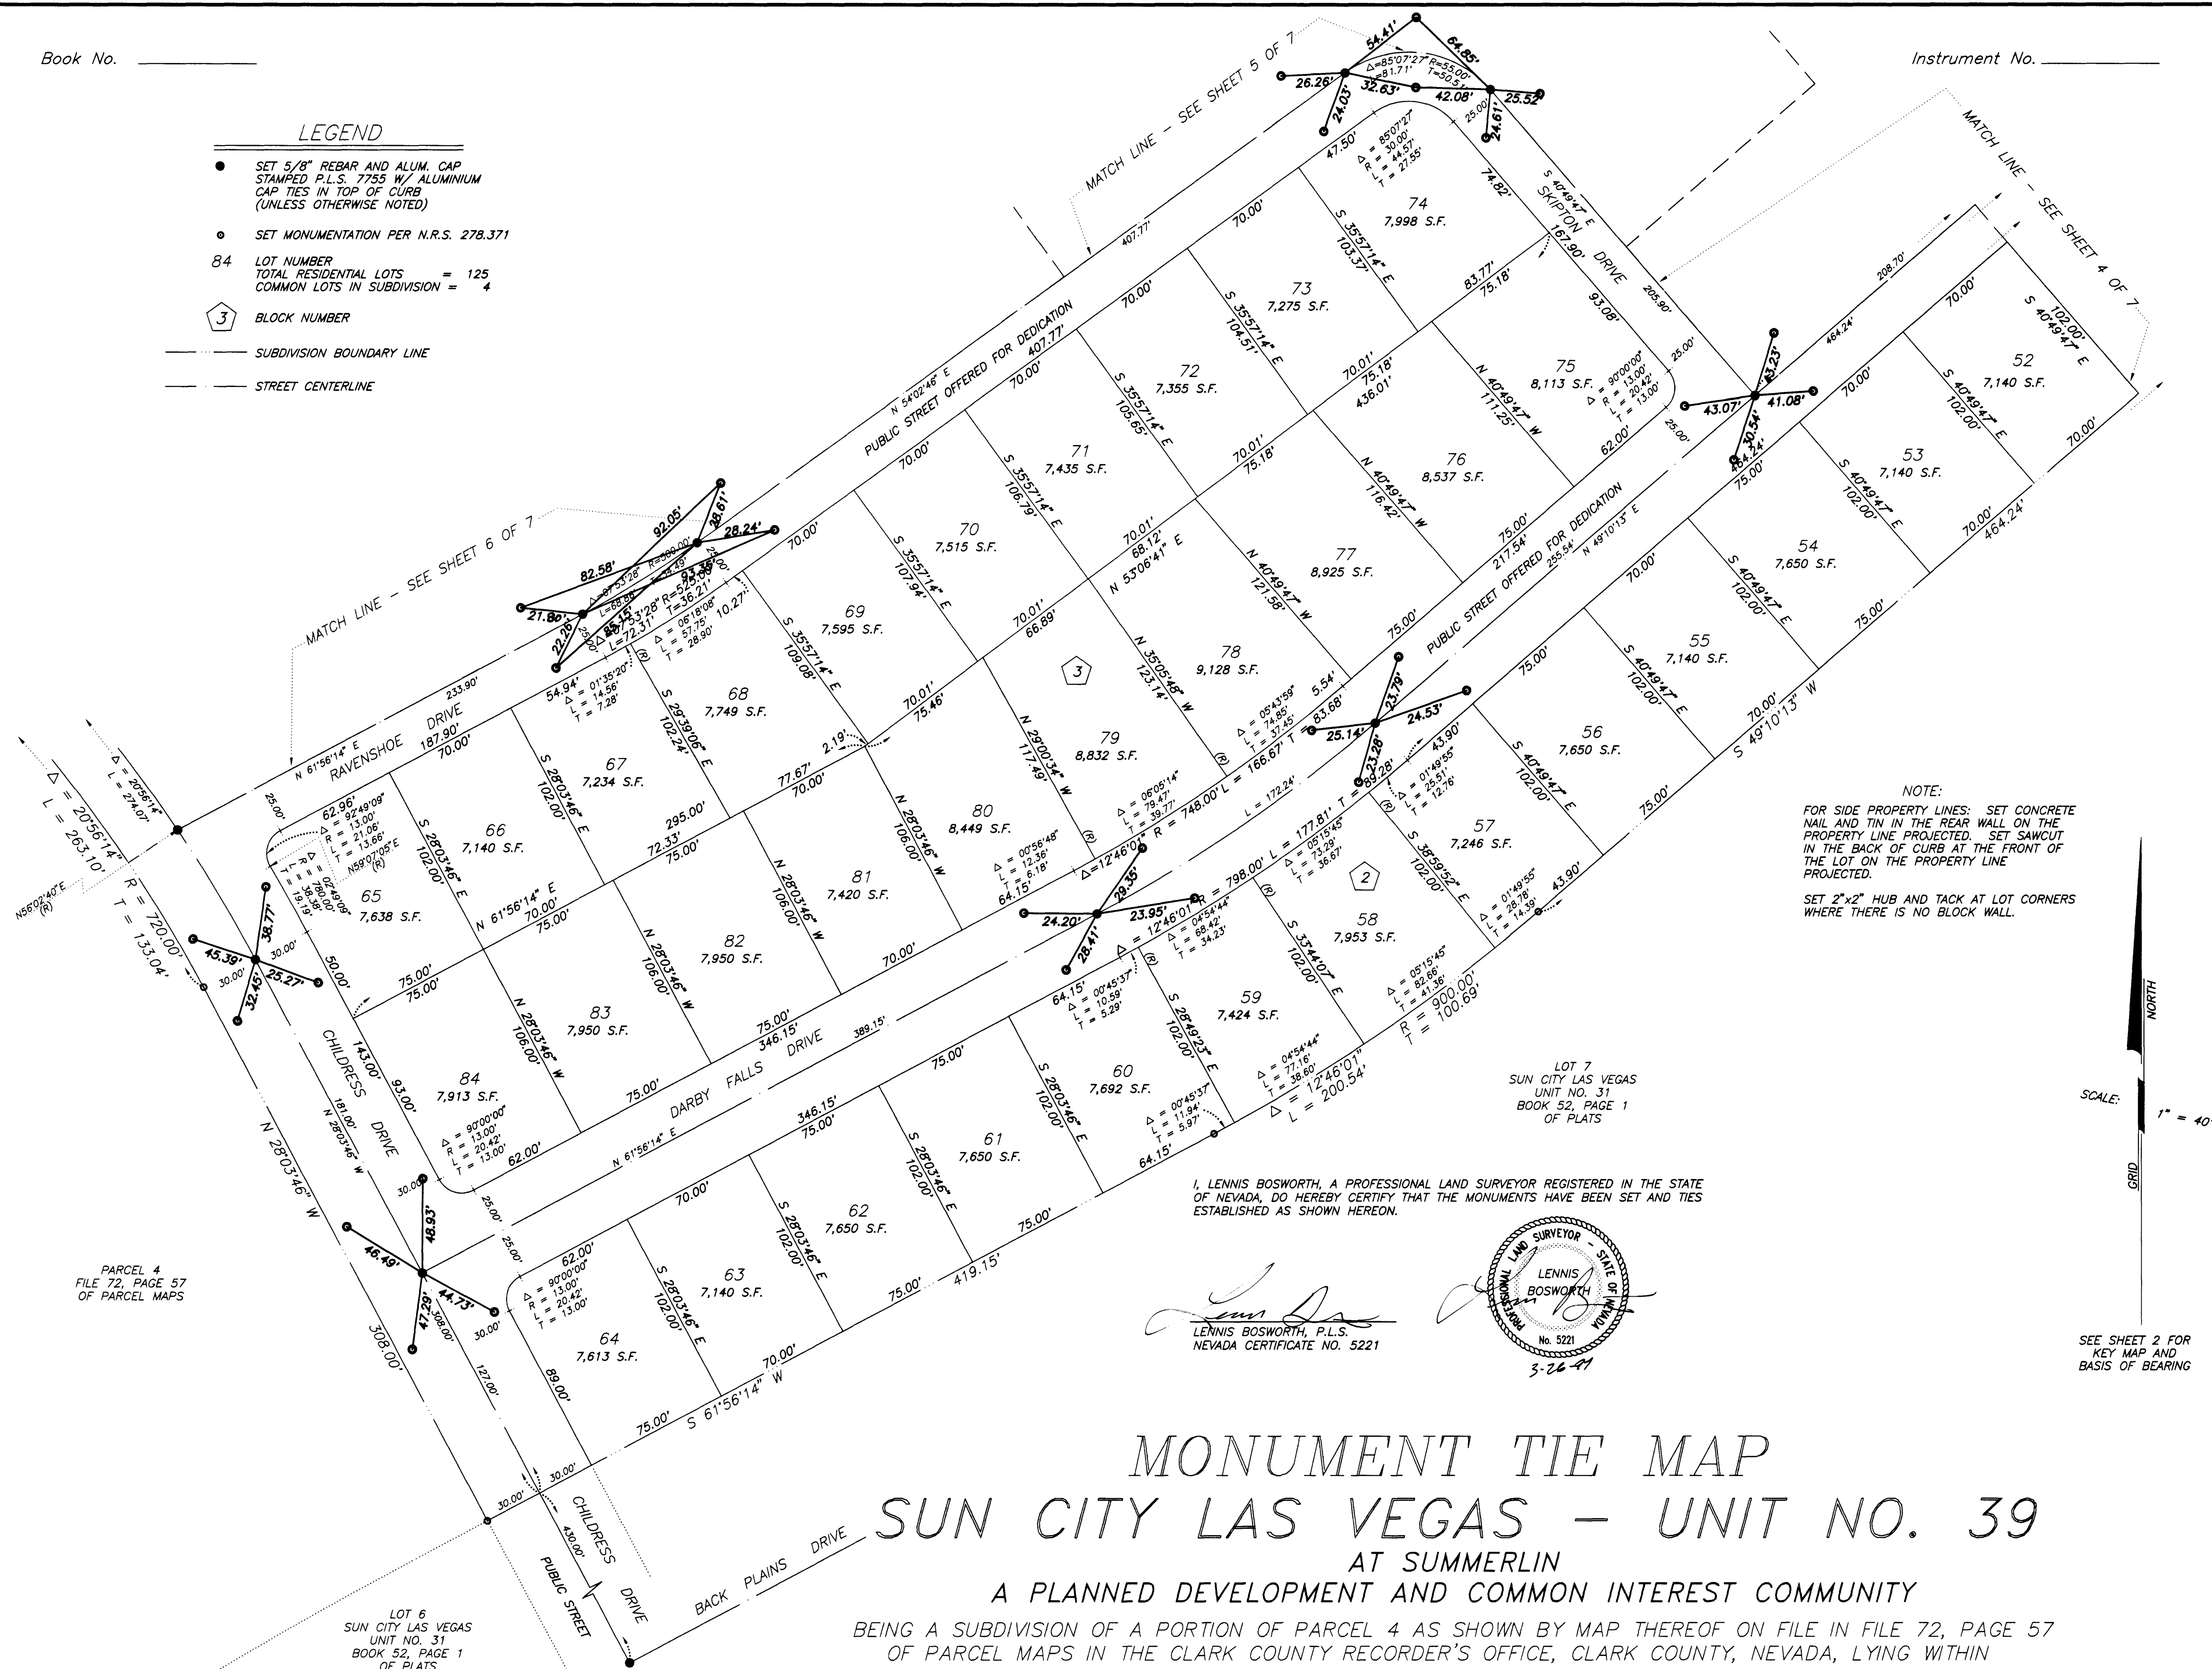

MONUMENT TIE MAP SUN CITY LAS VEGAS - UNIT NO. 39

AT SUMMERLIN

A PLANNED DEVELOPMENT AND COMMON INTEREST COMMUNITY

BEING A SUBDIVISION OF A PORTION OF PARCEL 4 AS SHOWN BY MAP THEREOF ON FILE IN FILE 72, PAGE 57
OF PARCEL MAPS IN THE CLARK COUNTY RECORDER'S OFFICE, CLARK COUNTY, NEVADA, LYING WITHIN
SECTION 13, TOWNSHIP 20 SOUTH, RANGE 59 EAST, M.D.M., CITY OF LAS VEGAS, CLARK COUNTY, NEVADA

SHEET 7 OF 7


Book _____ Page _____

058-4141-39

Sheet No. _____

Instrument No. _____

LEGEND
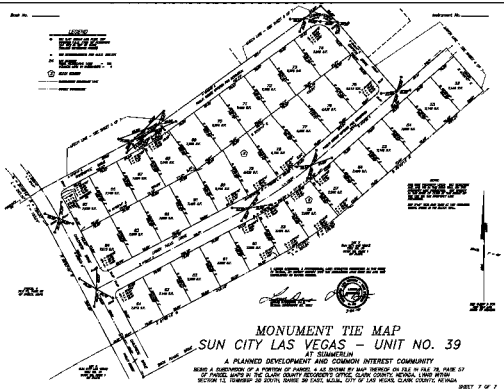

MONUMENT TIE MAP
SUN CITY LAS VEGAS - UNIT NO. 39
 AT SIMMERLIN
 A PLANNED DEVELOPMENT AND COMMON INTEREST COMMUNITY


SHEET 7 OF 7