

MONUMENT TIE MAP



FINAL MAP OF SUN CITY LAS VEGAS — UNIT NO. 43

AT SUMMERLIN
A PLANNED DEVELOPMENT AND COMMON INTEREST COMMUNITY

BEING A SUBDIVISION OF A PORTION OF SECTION 13,
TOWNSHIP 20 SOUTH, RANGE 59 EAST, M.D.M., CITY OF LAS VEGAS, CLARK COUNTY, NEVADA

I, LENNIS BOSWORTH, A PROFESSIONAL LAND SURVEYOR REGISTERED IN THE STATE OF NEVADA, DO HEREBY CERTIFY THAT THE MONUMENTS HAVE BEEN SET AND TIES ESTABLISHED AS SHOWN HEREON.

LENNIS BOSWORTH, P.L.S.
NEVADA CERTIFICATE NO. 5221

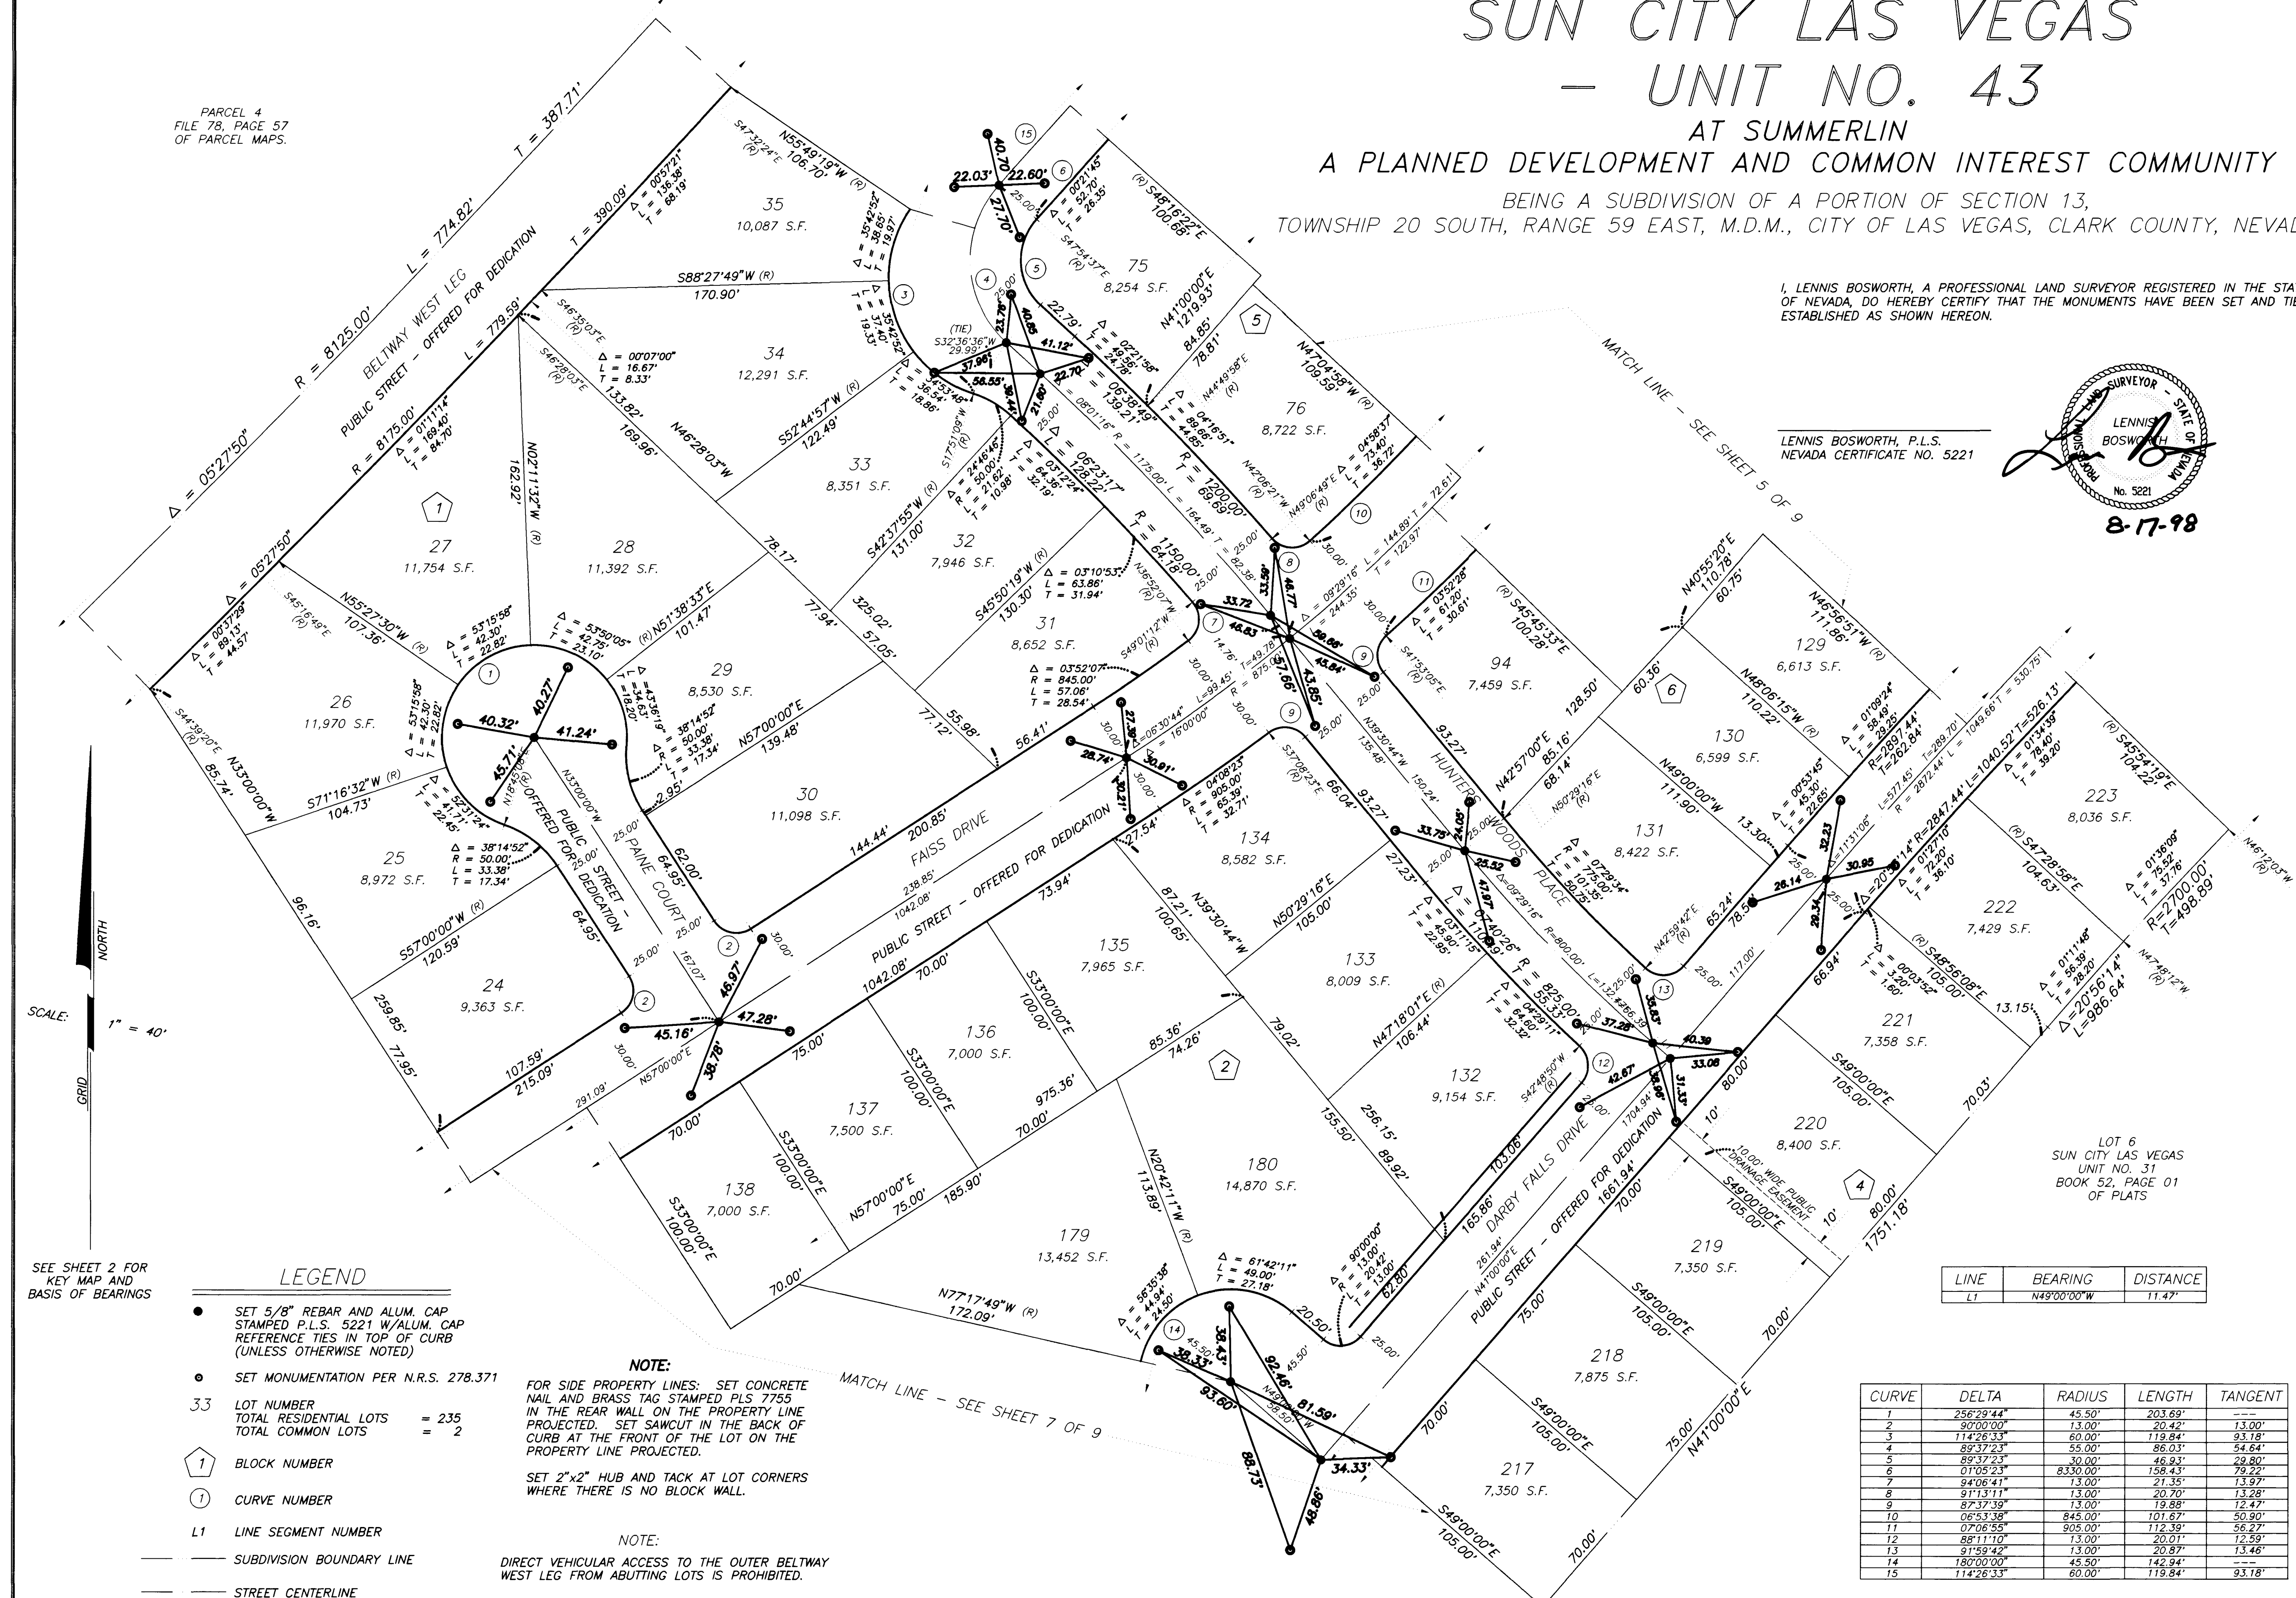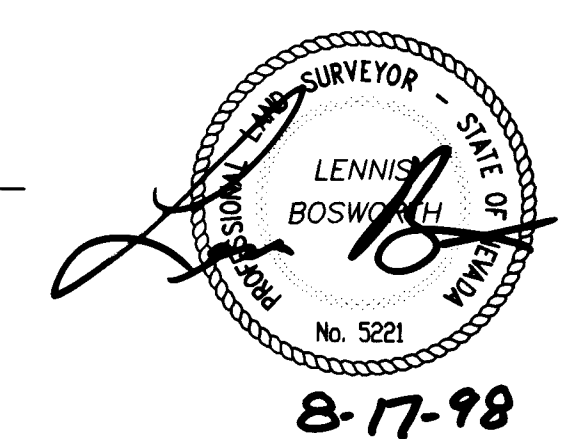

SEE SHEET 2 FOR
KEY MAP AND
BASIS OF BEARINGS

- LEGEND**
- SET 5/8" REBAR AND ALUM. CAP STAMPED P.L.S. 5221 W/ALUM. CAP REFERENCE TIES IN TOP OF CURB (UNLESS OTHERWISE NOTED)
 - SET MONUMENTATION PER N.R.S. 278.371
 - 33 LOT NUMBER
TOTAL RESIDENTIAL LOTS = 235
TOTAL COMMON LOTS = 2
 - 1 BLOCK NUMBER
 - 1 CURVE NUMBER
 - L1 LINE SEGMENT NUMBER
 - SUBDIVISION BOUNDARY LINE
 - STREET CENTERLINE

NOTE:
FOR SIDE PROPERTY LINES: SET CONCRETE NAIL AND BRASS TAG STAMPED PLS 7755 IN THE REAR WALL ON THE PROPERTY LINE PROJECTED. SET SAWCUT IN THE BACK OF CURB AT THE FRONT OF THE LOT ON THE PROPERTY LINE PROJECTED.
SET 2"x2" HUB AND TACK AT LOT CORNERS WHERE THERE IS NO BLOCK WALL.

NOTE:
DIRECT VEHICULAR ACCESS TO THE OUTER BELTWAY WEST LEG FROM ADJUTING LOTS IS PROHIBITED.

LINE	BEARING	DISTANCE
L1	N49°00'00"W	11.47'

CURVE	DELTA	RADIUS	LENGTH	TANGENT
1	256°29'44"	45.50'	203.69'	---
2	90°00'00"	13.00'	20.42'	13.00'
3	114°26'53"	60.00'	119.84'	93.18'
4	89°37'23"	55.00'	86.03'	54.64'
5	89°37'23"	30.00'	46.93'	29.80'
6	01°05'23"	8330.00'	158.43'	79.22'
7	91°06'41"	13.00'	21.35'	13.97'
8	91°13'11"	13.00'	20.70'	13.28'
9	87°37'39"	13.00'	19.88'	12.47'
10	06°53'38"	845.00'	101.67'	50.90'
11	07°06'55"	905.00'	112.38'	56.27'
12	88°11'10"	13.00'	20.01'	12.59'
13	91°59'42"	13.00'	20.87'	13.46'
14	180°00'00"	45.50'	142.94'	---
15	114°26'53"	60.00'	119.84'	93.18'

BEING A SUBDIVISION OF A PORTION OF SECTION 13,




