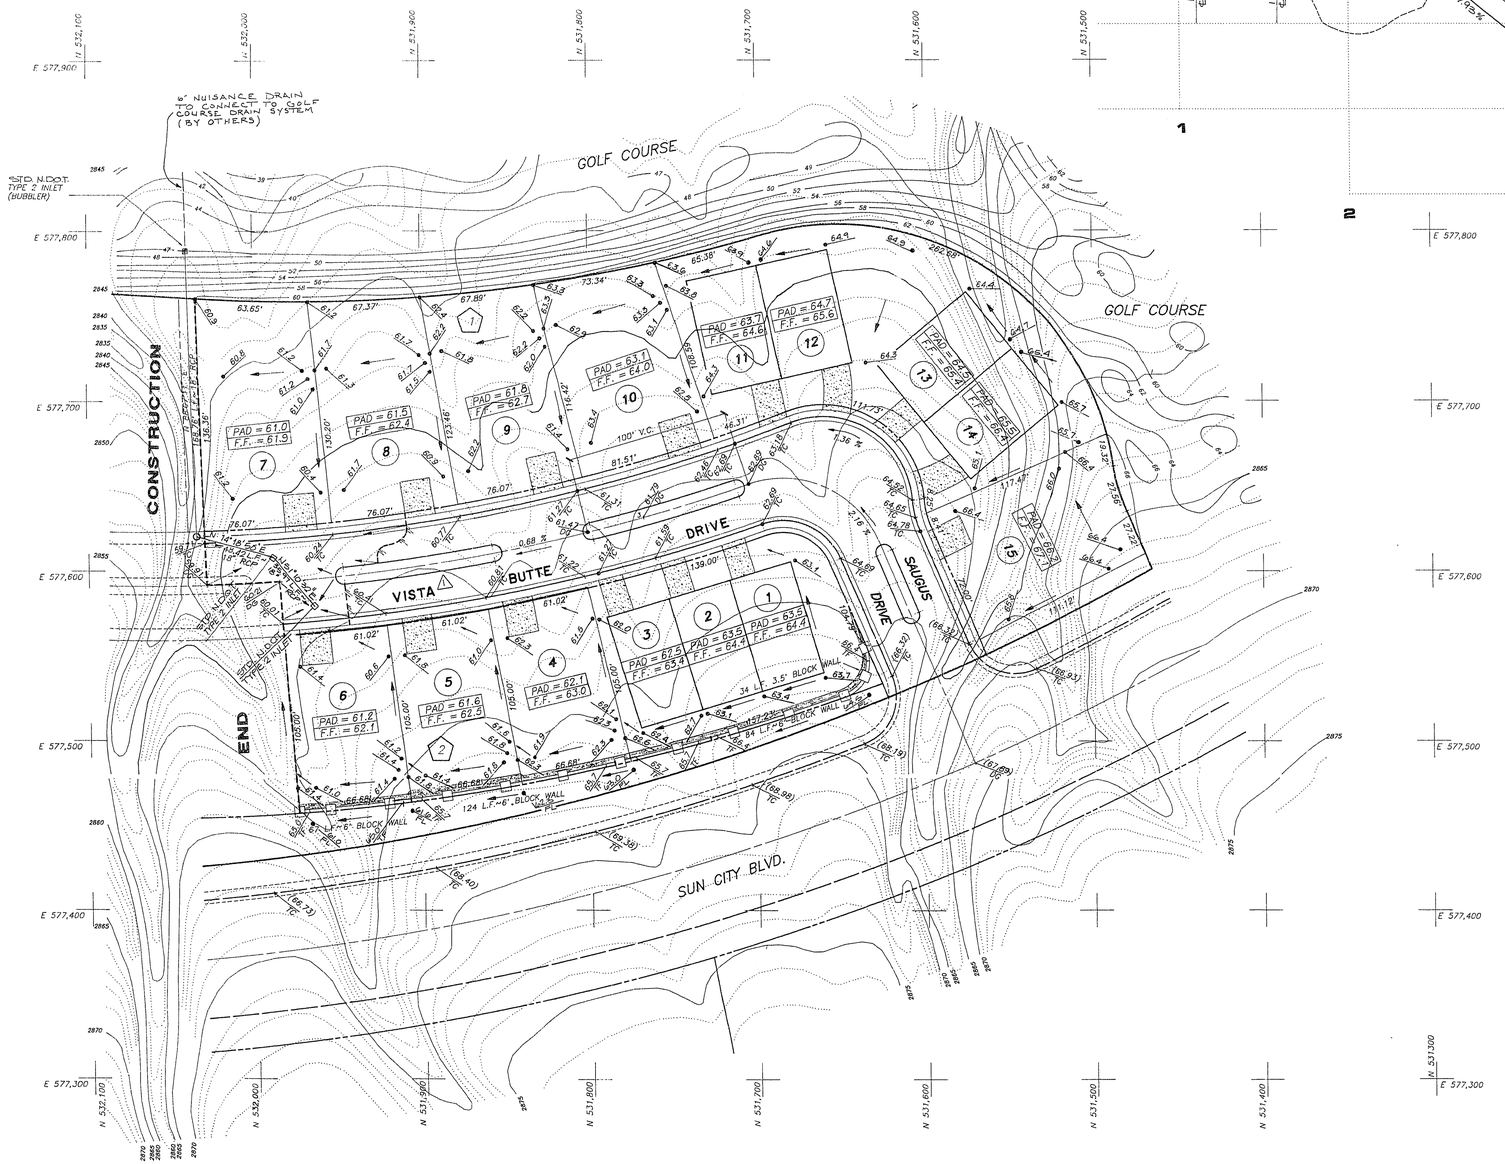

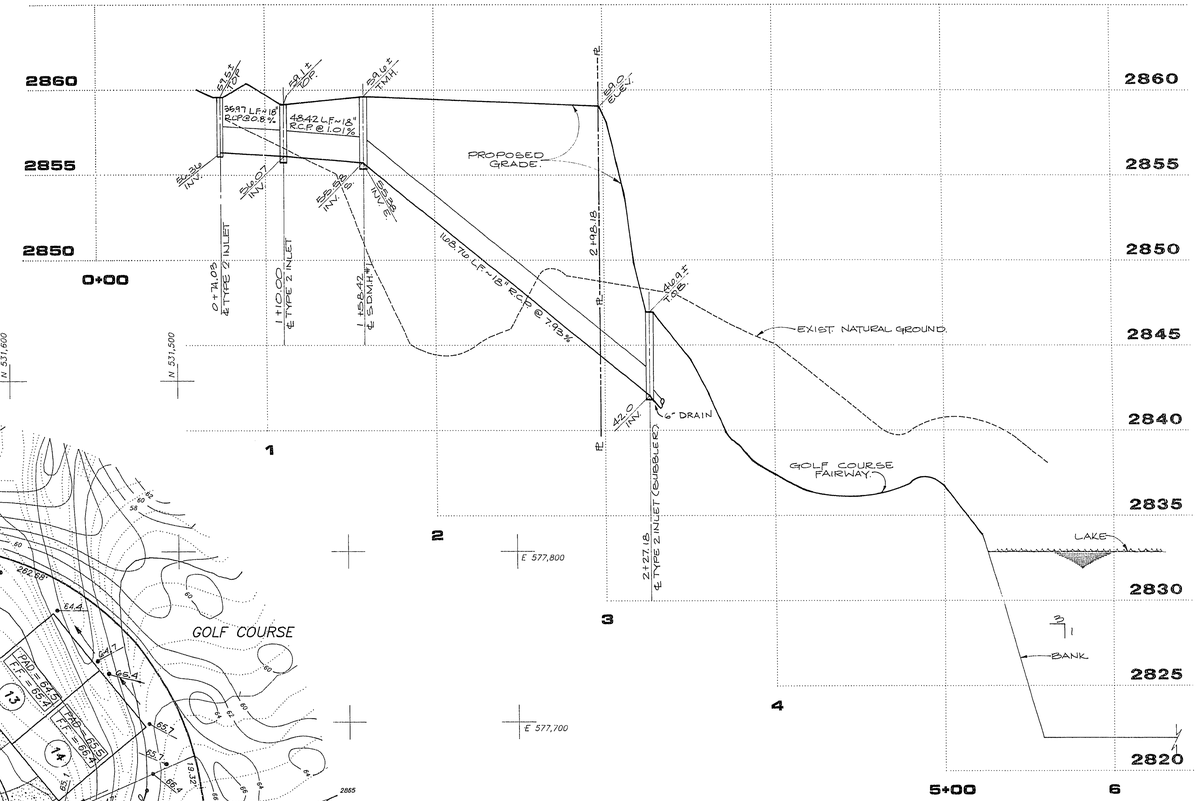

I CERTIFY THAT THIS GRADING PLAN IS IN CONFORMANCE WITH THE APPROVED DRAINAGE STUDY ON FILE AT THE CITY OF LAS VEGAS FOR THIS PROJECT.

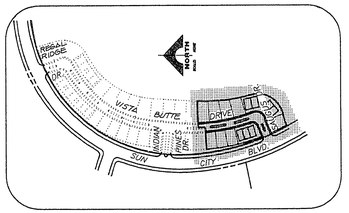

REV.	DATE	DESCRIPTION	C.L.V.	DATE
1	6/28/92	CLARKE ST. NAMES		5/28/92

RECOMMENDED
MICHAEL D. ROSS
P.E. NO. 6218
DATE

G.C. WALLACE, INC.
Engineering/Architecture 1555 SOUTH RAINBOW BLVD/LAS VEGAS, NEVADA 89102

DEL WEBB COMMUNITIES, INC.
SUN CITY LAS VEGAS UNIT NO. 33A
GRADING PLAN I

SHEET 7 OF 9 SHEETS

JOB NO. 701.132 PLOTTED: 12/19/91 3:07 pm

10-3-95 107Y-4141-33A