



JOB NO. 701-182 PLOTTED: 03/29/24 8:51 am DRAWING: C:\DRAWINGS\DWG\24\701-182-18 BY: DLM

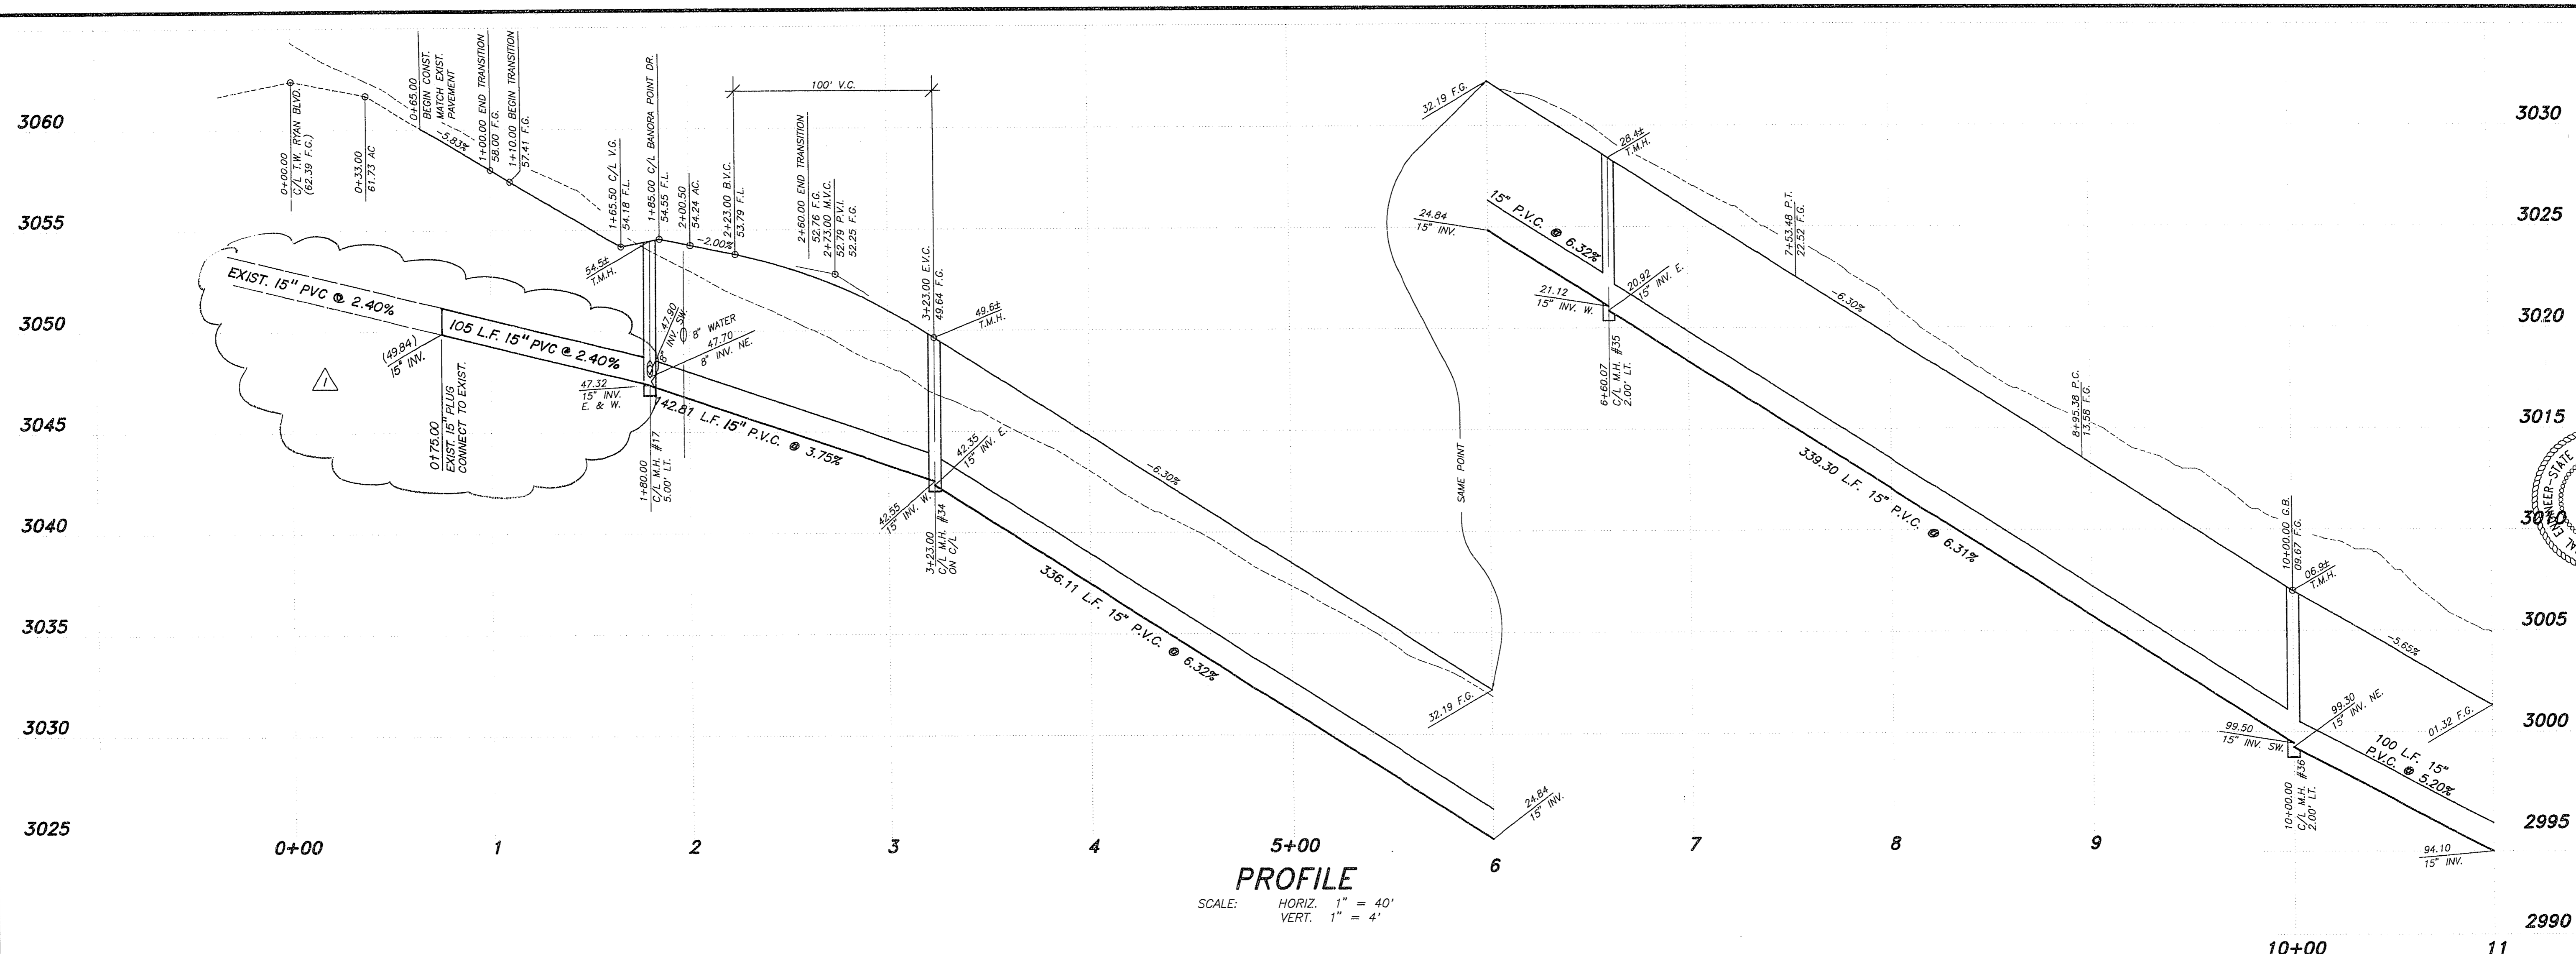

PROFILE
SCALE: HORIZ. 1" = 40'
VERT. 1" = 4'


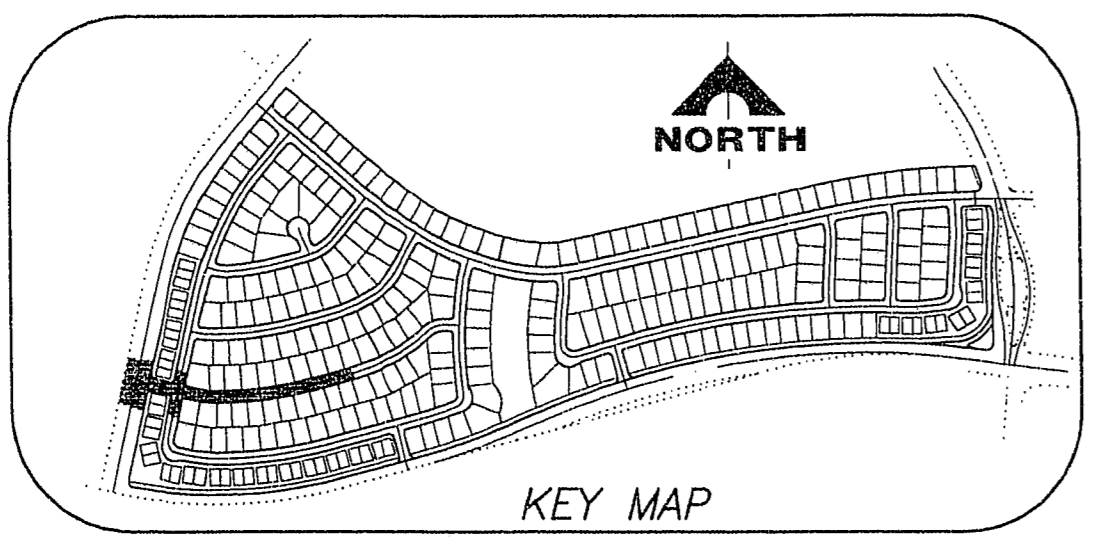


① CURVE TABLE

CURVE	DELTA	RADIUS	LENGTH	TANGENT
1	90°00'00"	30.00'	47.12'	30.00'
2	90°00'00"	20.00'	31.42'	20.00'
3	02°11'39"	358.00'	13.71'	6.86'
4	12°55'27"	340.00'	76.69'	38.51'
5	06°49'08"	322.00'	39.32'	19.18'
6	09°52'25"	358.00'	61.69'	39.92'
7	12°55'27"	322.00'	72.63'	36.47'
8	12°55'27"	358.00'	80.75'	40.55'
9	06°06'19"	322.00'	34.31'	17.17'
10	02°51'23"	358.00'	5.35'	2.68'
11	01°02'10"	1537.00'	27.79'	13.90'
12	02°01'03"	1573.00'	55.39'	27.70'
13	02°48'54"	1537.00'	74.42'	37.24'
14	02°30'34"	1573.00'	68.89'	34.45'
15	02°13'22"	1573.00'	61.02'	30.52'

② CURVE TABLE

CURVE	DELTA	RADIUS	LENGTH	TANGENT
16	14°55'26"	1555.00'	405.03'	203.67'
17	14°55'26"	1537.00'	400.34'	201.31'
18	14°55'26"	1573.00'	409.72'	206.03'
19	02°47'00"	1537.00'	74.67'	37.34'
20	02°55'57"	1573.00'	75.69'	37.80'
21	01°05'52"	918.00'	17.61'	8.81'
22	05°04'43"	882.00'	78.18'	39.12'
23	04°14'02"	918.00'	68.12'	34.07'
24	13°01'35"	918.00'	208.71'	104.81'
25	13°01'35"	882.00'	200.53'	100.70'
26	03°46'00"	918.00'	60.35'	30.19'
27	13°01'35"	900.00'	204.62'	102.75'
28	02°52'09"	882.00'	44.17'	22.09'
29	02°08'33"	918.00'	2.28'	1.14'

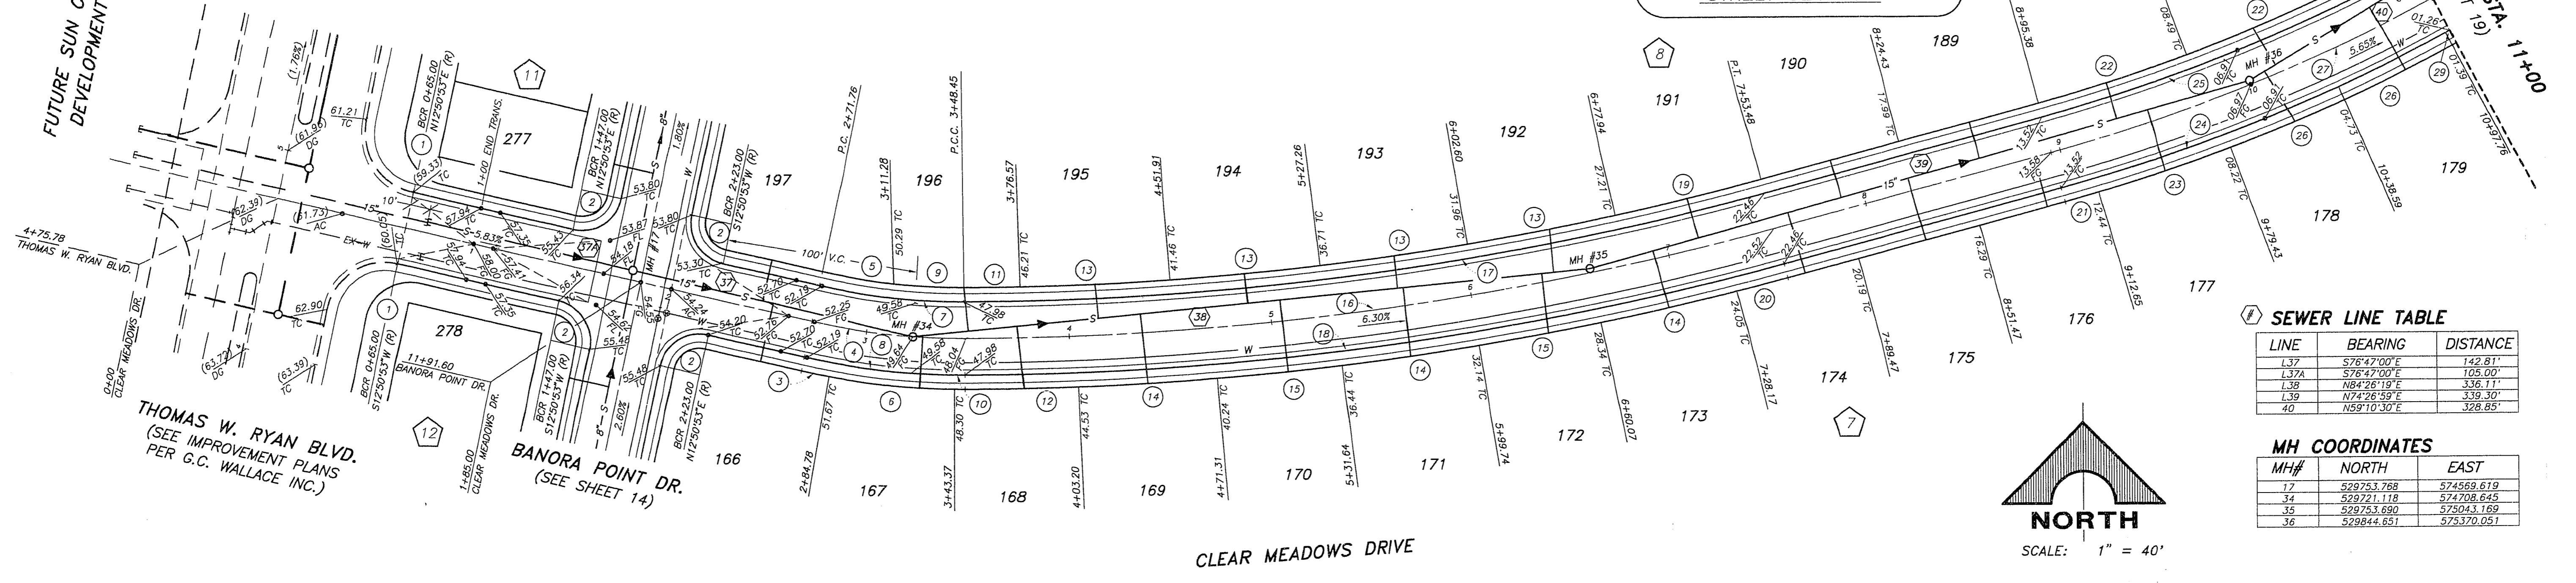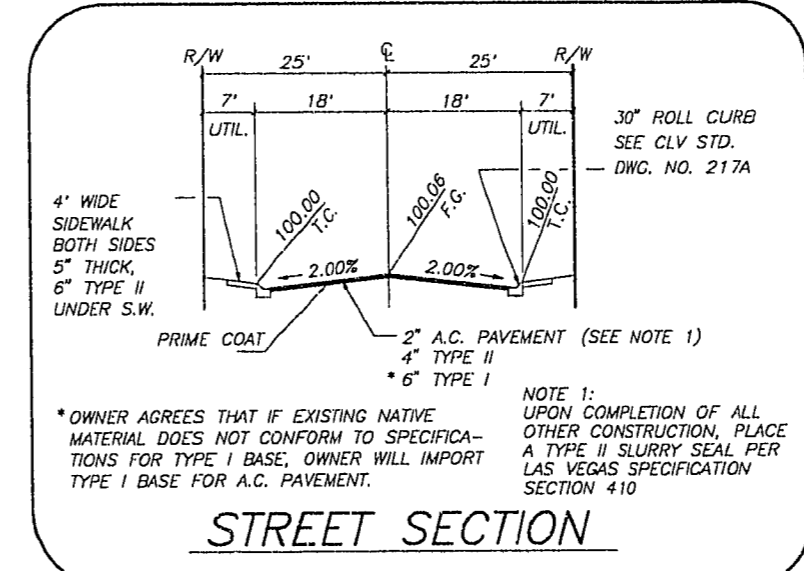


③ SEWER LINE TABLE

LINE	BEARING	DISTANCE
L37	S76°47'00"E	142.81'
L37A	S76°47'00"E	105.00'
L38	N84°26'19"E	336.11'
L39	N74°26'59"E	339.30'
40	N59°10'30"E	328.85'

MH COORDINATES

MH#	NORTH	EAST
17	529753.768	574569.619
34	529721.118	574708.645
35	529753.690	575043.169
36	529844.651	575370.051

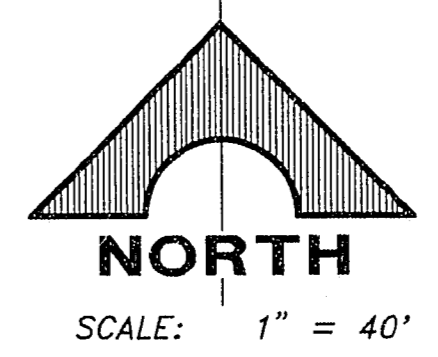

REVISIONS

NO.	DATE	DESCRIPTION	C.L.V.	DATE
1	4/28/24	CHANGED SLOPE ON SEWER	DL	4-28-24

REGISTERED PROFESSIONAL ENGINEER - STATE OF NEVADA
 G.C. WALLACE, INC.
 No. 10118
 1555 SOUTH RAINBOW BLVD., LAS VEGAS, NEVADA 89102

DEL WEBB COMMUNITIES, INC.
 SUN CITY LAS VEGAS UNIT NO. 42
 PLAN & PROFILE
 CLEAR MEADOW DRIVE

SHEET
 18
 OF 45 SHEETS

10-10-106 107Y-4/41-442