

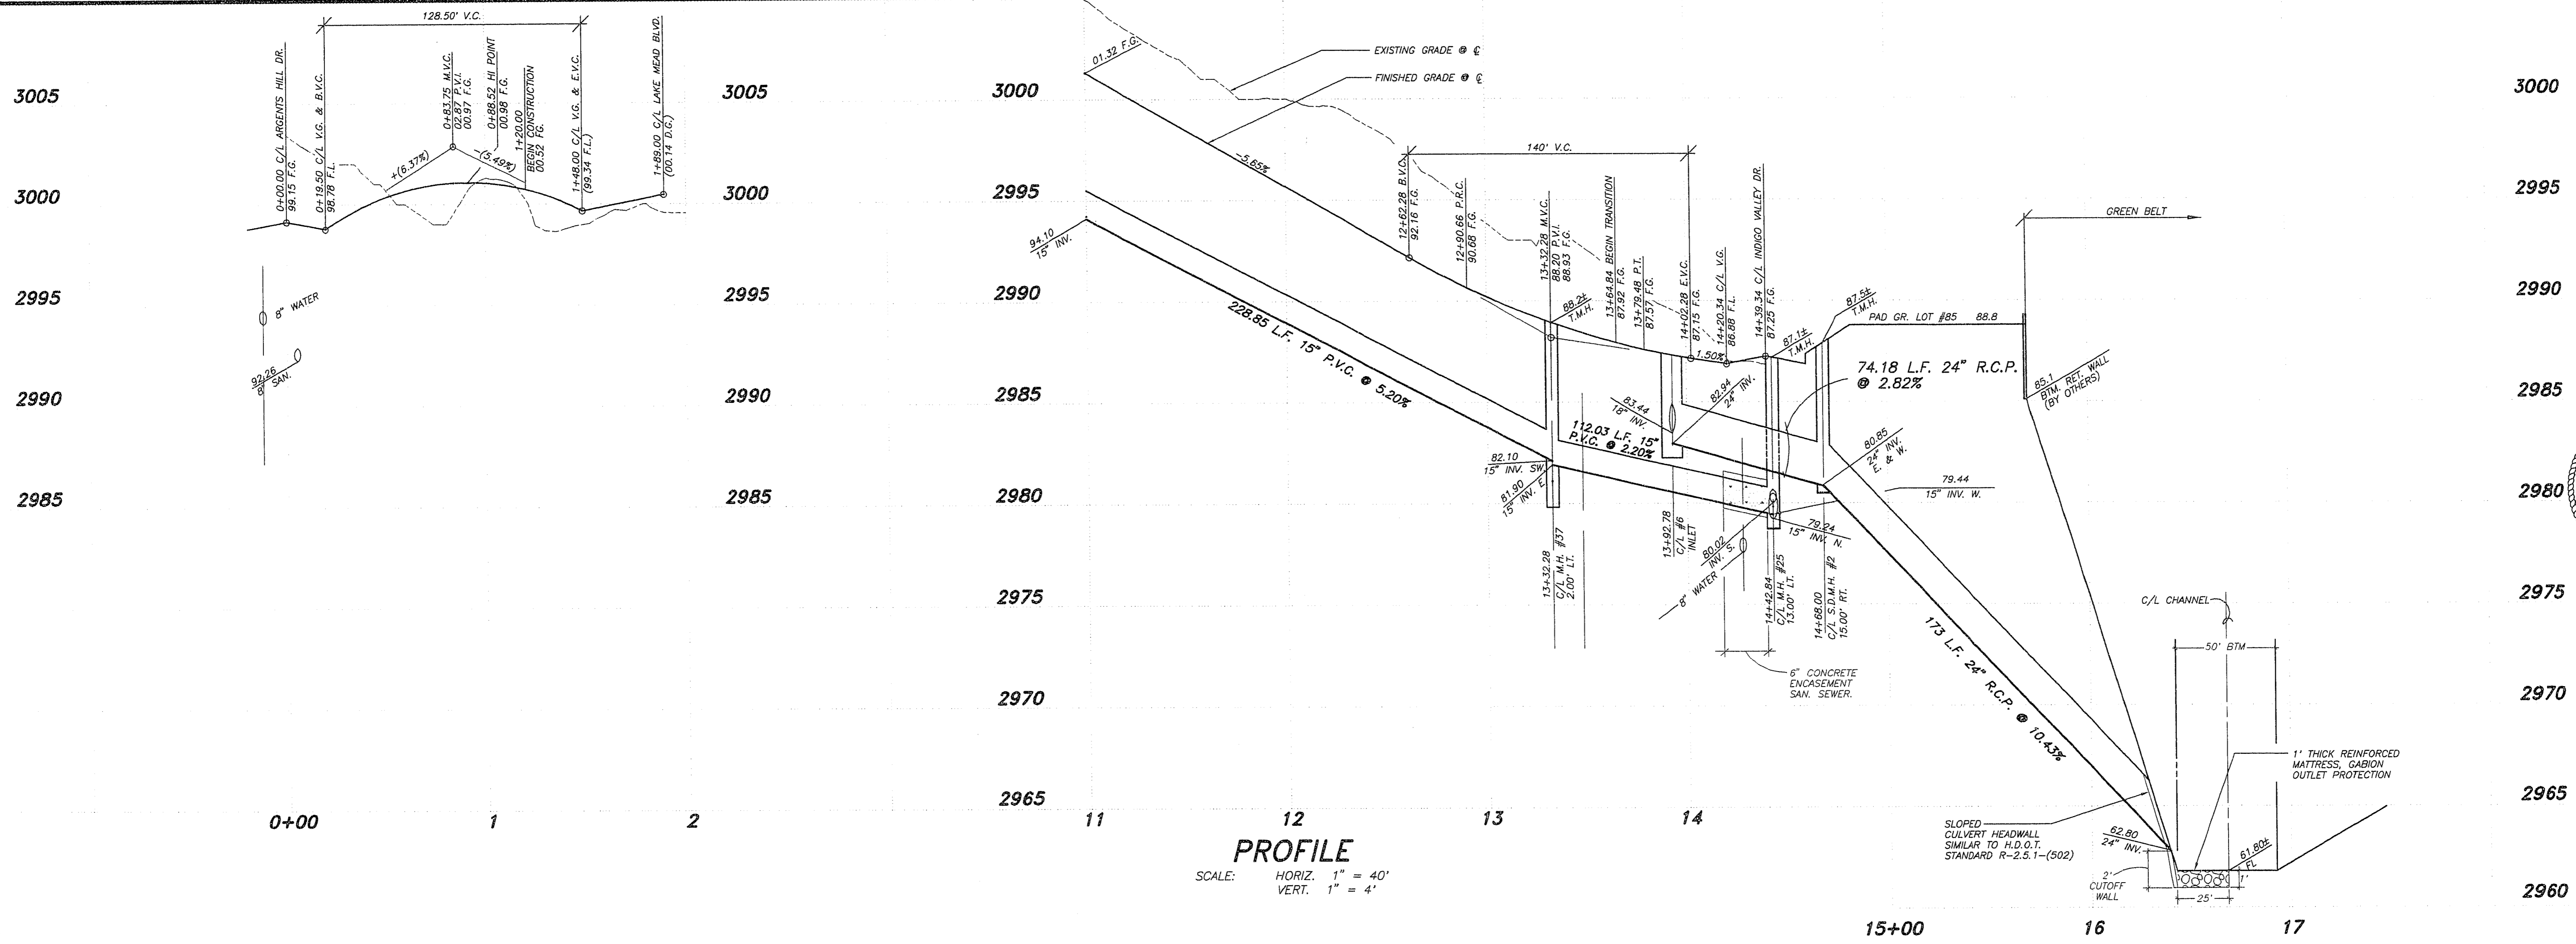
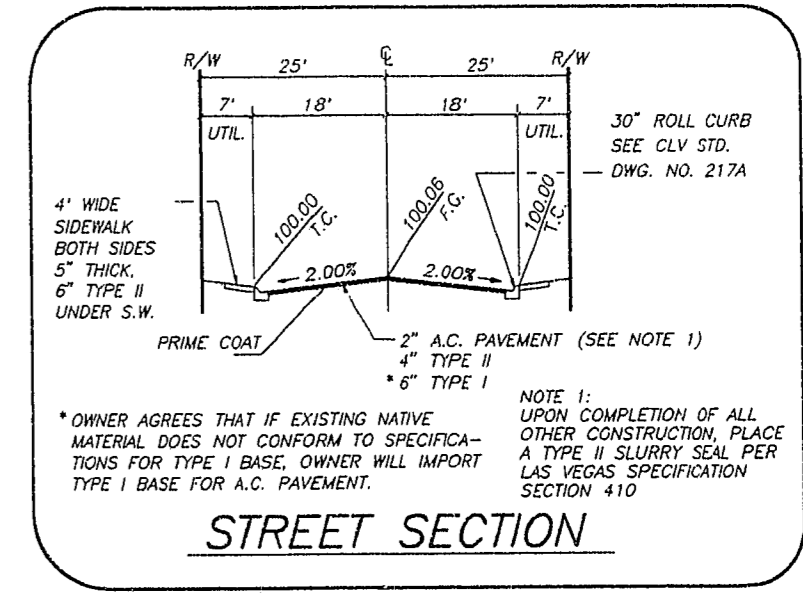
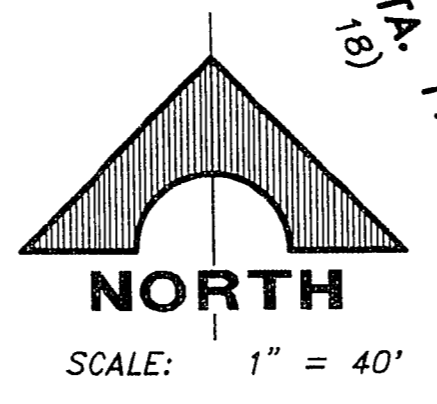


JOB NO. 701.182 PLOTTED: 03/21/94 5:11 pm DRAWING: C:\ADMIN\STW\DWG\121002-18 87: DLW

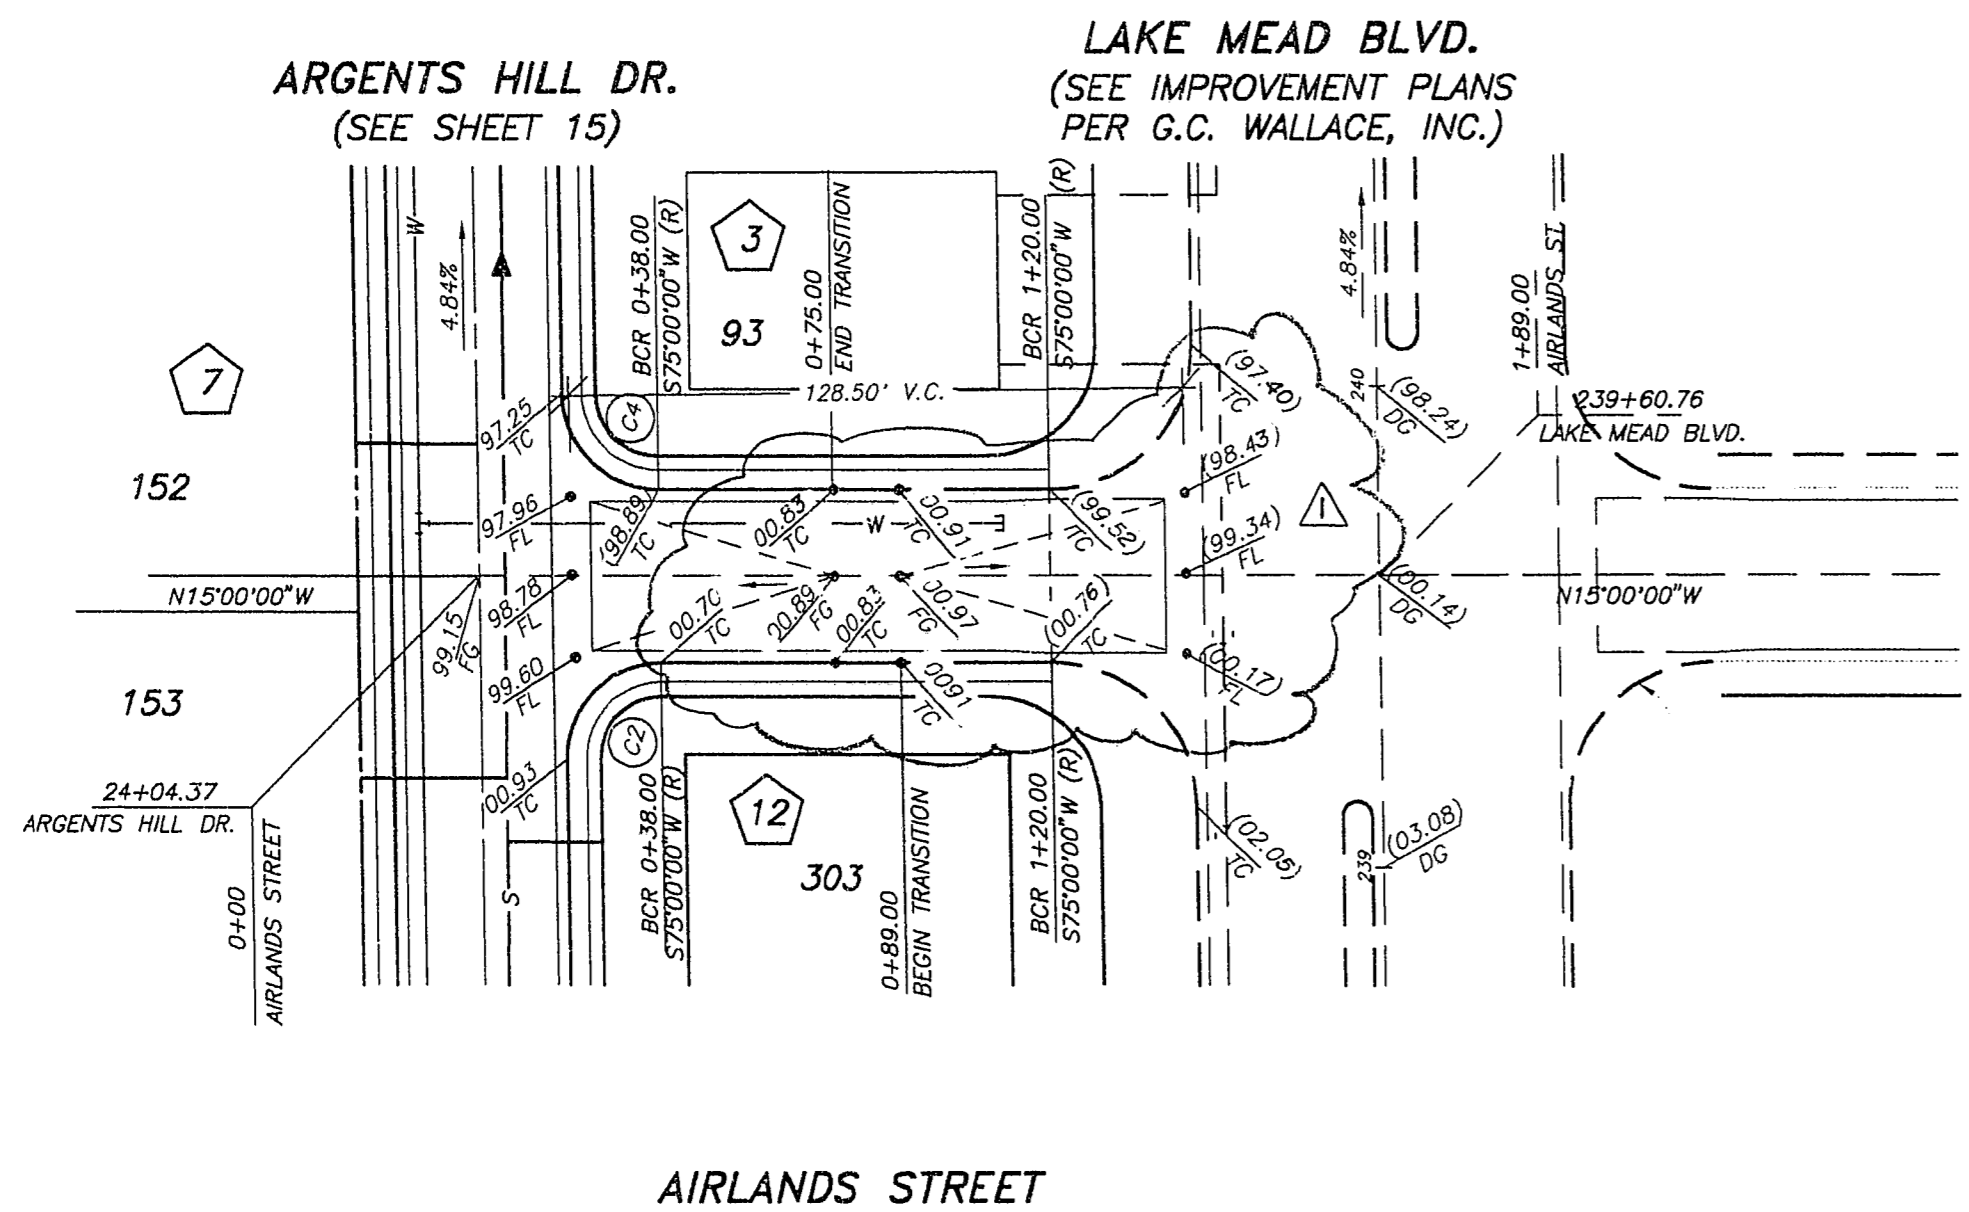

⑦ CURVE TABLE

CURVE	DELTA	RADIUS	LENGTH	TANGENT
C2	90°00'00"	20.00'	31.42'	20.00'
C4	90°00'00"	20.00'	31.42'	20.00'

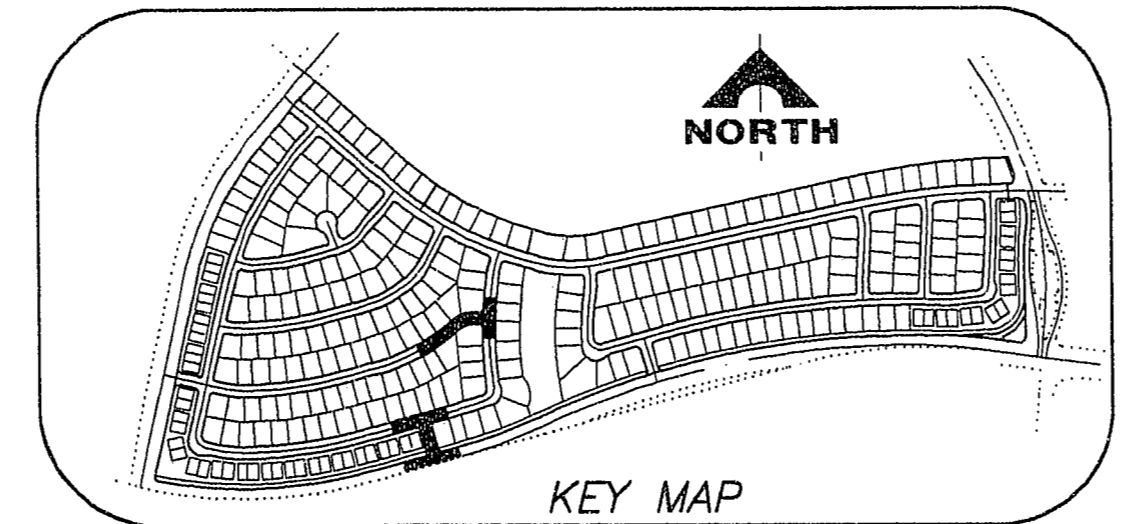

⑧ S.D. LINE TABLE

LINE	BEARING	DISTANCE
L1	N02°14'53"E	32.50'
L2	N89°48'15"W	74.18'
L3	N88°04'10"W	173.00'

S.D.M.H. COORDINATES

MH#	NORTH	EAST
2	575788.000	530002.451

⑨ SEWER LINE TABLE

LINE	BEARING	DISTANCE
L40	N89°10'30"E	328.85'
L41	N81°48'46"E	112.03'

MH COORDINATES

MH#	NORTH	EAST
25	530030.140	575765.053
37	530014.187	57564.168

⑩ CURVE TABLE

CURVE	DELTA	RADIUS	LENGTH	TANGENT
1	02°12'34"	882.00'	34.01'	17.01'
2	03°37'27"	918.00'	58.07'	29.04'
3	04°23'53"	895.00'	69.24'	34.64'
4	12°08'15"	882.00'	186.84'	93.77'
5	12°08'15"	900.00'	190.66'	95.69'
6	12°08'15"	918.00'	194.47'	97.50'
7	05°08'30"	882.00'	79.15'	39.60'
8	07°30'31"	918.00'	120.30'	60.24'
9	00°17'19"	882.00'	14.44'	2.22'
10	12°35'59"	138.00'	47.21'	23.54'
11	01°00'18"	918.00'	18.10'	8.05'
12	42°24'43"	138.00'	102.15'	53.54'
13	42°24'43"	120.00'	88.83'	45.56'
14	42°24'43"	102.00'	75.50'	39.56'
15	22°48'46"	138.00'	54.95'	27.84'
16	88°40'58"	20.00'	30.96'	19.55'

APPROVED FOR CONSTRUCTION
LVVWD [Signature] 3-25-94 DATE

RECORDED: 4/11/94
FILE NO. 10118
DATE 10/11/94
G.C. WALLACE, INC.
Engineering/Architecture
1555 SOUTH RAINBOW BLVD./LAS VEGAS, NEVADA 89102
DEL WEBB COMMUNITIES, INC.
SUN CITY LAS VEGAS UNIT NO. 42
PLAN & PROFILE
CLEAR MEADOWS DRIVE & AIRLANDS STREET
SHEET 19 OF 43 SHEETS

10-12-197 1074-4/41-42