


FINAL MAP OF
SUN CITY LAS VEGAS
— UNIT NO. 44

AT SUMMERLIN
A PLANNED DEVELOPMENT AND COMMON INTEREST COMMUNITY
BEING A SUBDIVISION OF A PORTION OF SECTIONS 13 AND 14,
TOWNSHIP 20 SOUTH, RANGE 59 EAST, M.D.M., CITY OF LAS VEGAS, CLARK COUNTY, NEVADA


MONUMENT TIE MAP

LOT 6
SUN CITY LAS VEGAS
UNIT NO. 31
BOOK 52, PAGE 01
OF PLATS

I, LENNIS BOSWORTH, A PROFESSIONAL LAND SURVEYOR REGISTERED IN THE STATE
OF NEVADA, DO HEREBY CERTIFY THAT THE MONUMENTS HAVE BEEN SET AND TIES
ESTABLISHED AS SHOWN HEREON.

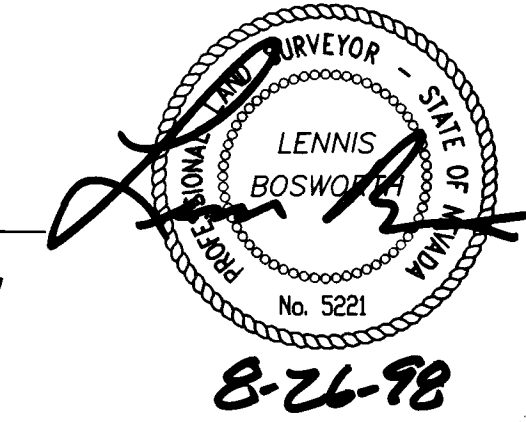

LENNIS BOSWORTH, P.L.S.
NEVADA CERTIFICATE NO. 5221

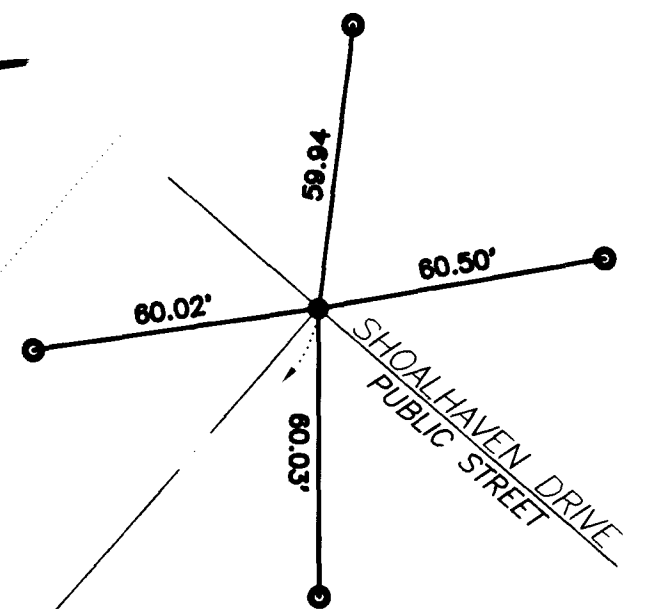


NOTE:
FOR SIDE PROPERTY LINES: SET CONCRETE
NAIL AND BRASS TAG STAMPED PLS 7755
IN THE REAR WALL ON THE PROPERTY LINE
PROJECTED. SET SAWCUT IN THE BACK OF
CURB AT THE FRONT OF THE LOT ON THE
PROPERTY LINE PROJECTED.

SET 2"x2" HUB AND TACK AT LOT CORNERS
WHERE THERE IS NO BLOCK WALL.

LEGEND

- SET 5/8" REBAR AND ALUM. CAP
STAMPED P.L.S. NUM W/ ALUMINUM
REFERENCE TIES IN TOP OF CURB
(UNLESS OTHERWISE NOTED)
- REFERENCE POINT
- LOT# LOT NUMBER
TOTAL RES-COMM = LOTS
TOTAL COMMON LOTS = CLOTS
- BLK# BLOCK NUMBER
- CRV# CURVE NUMBER
- SUBDIVISION BOUNDARY LINE
- STREET CENTERLINE

NOTE:
DIRECT VEHICULAR ACCESS TO THOMAS W. RYAN
BOULEVARD FROM ADJUTING LOTS IS PROHIBITED.

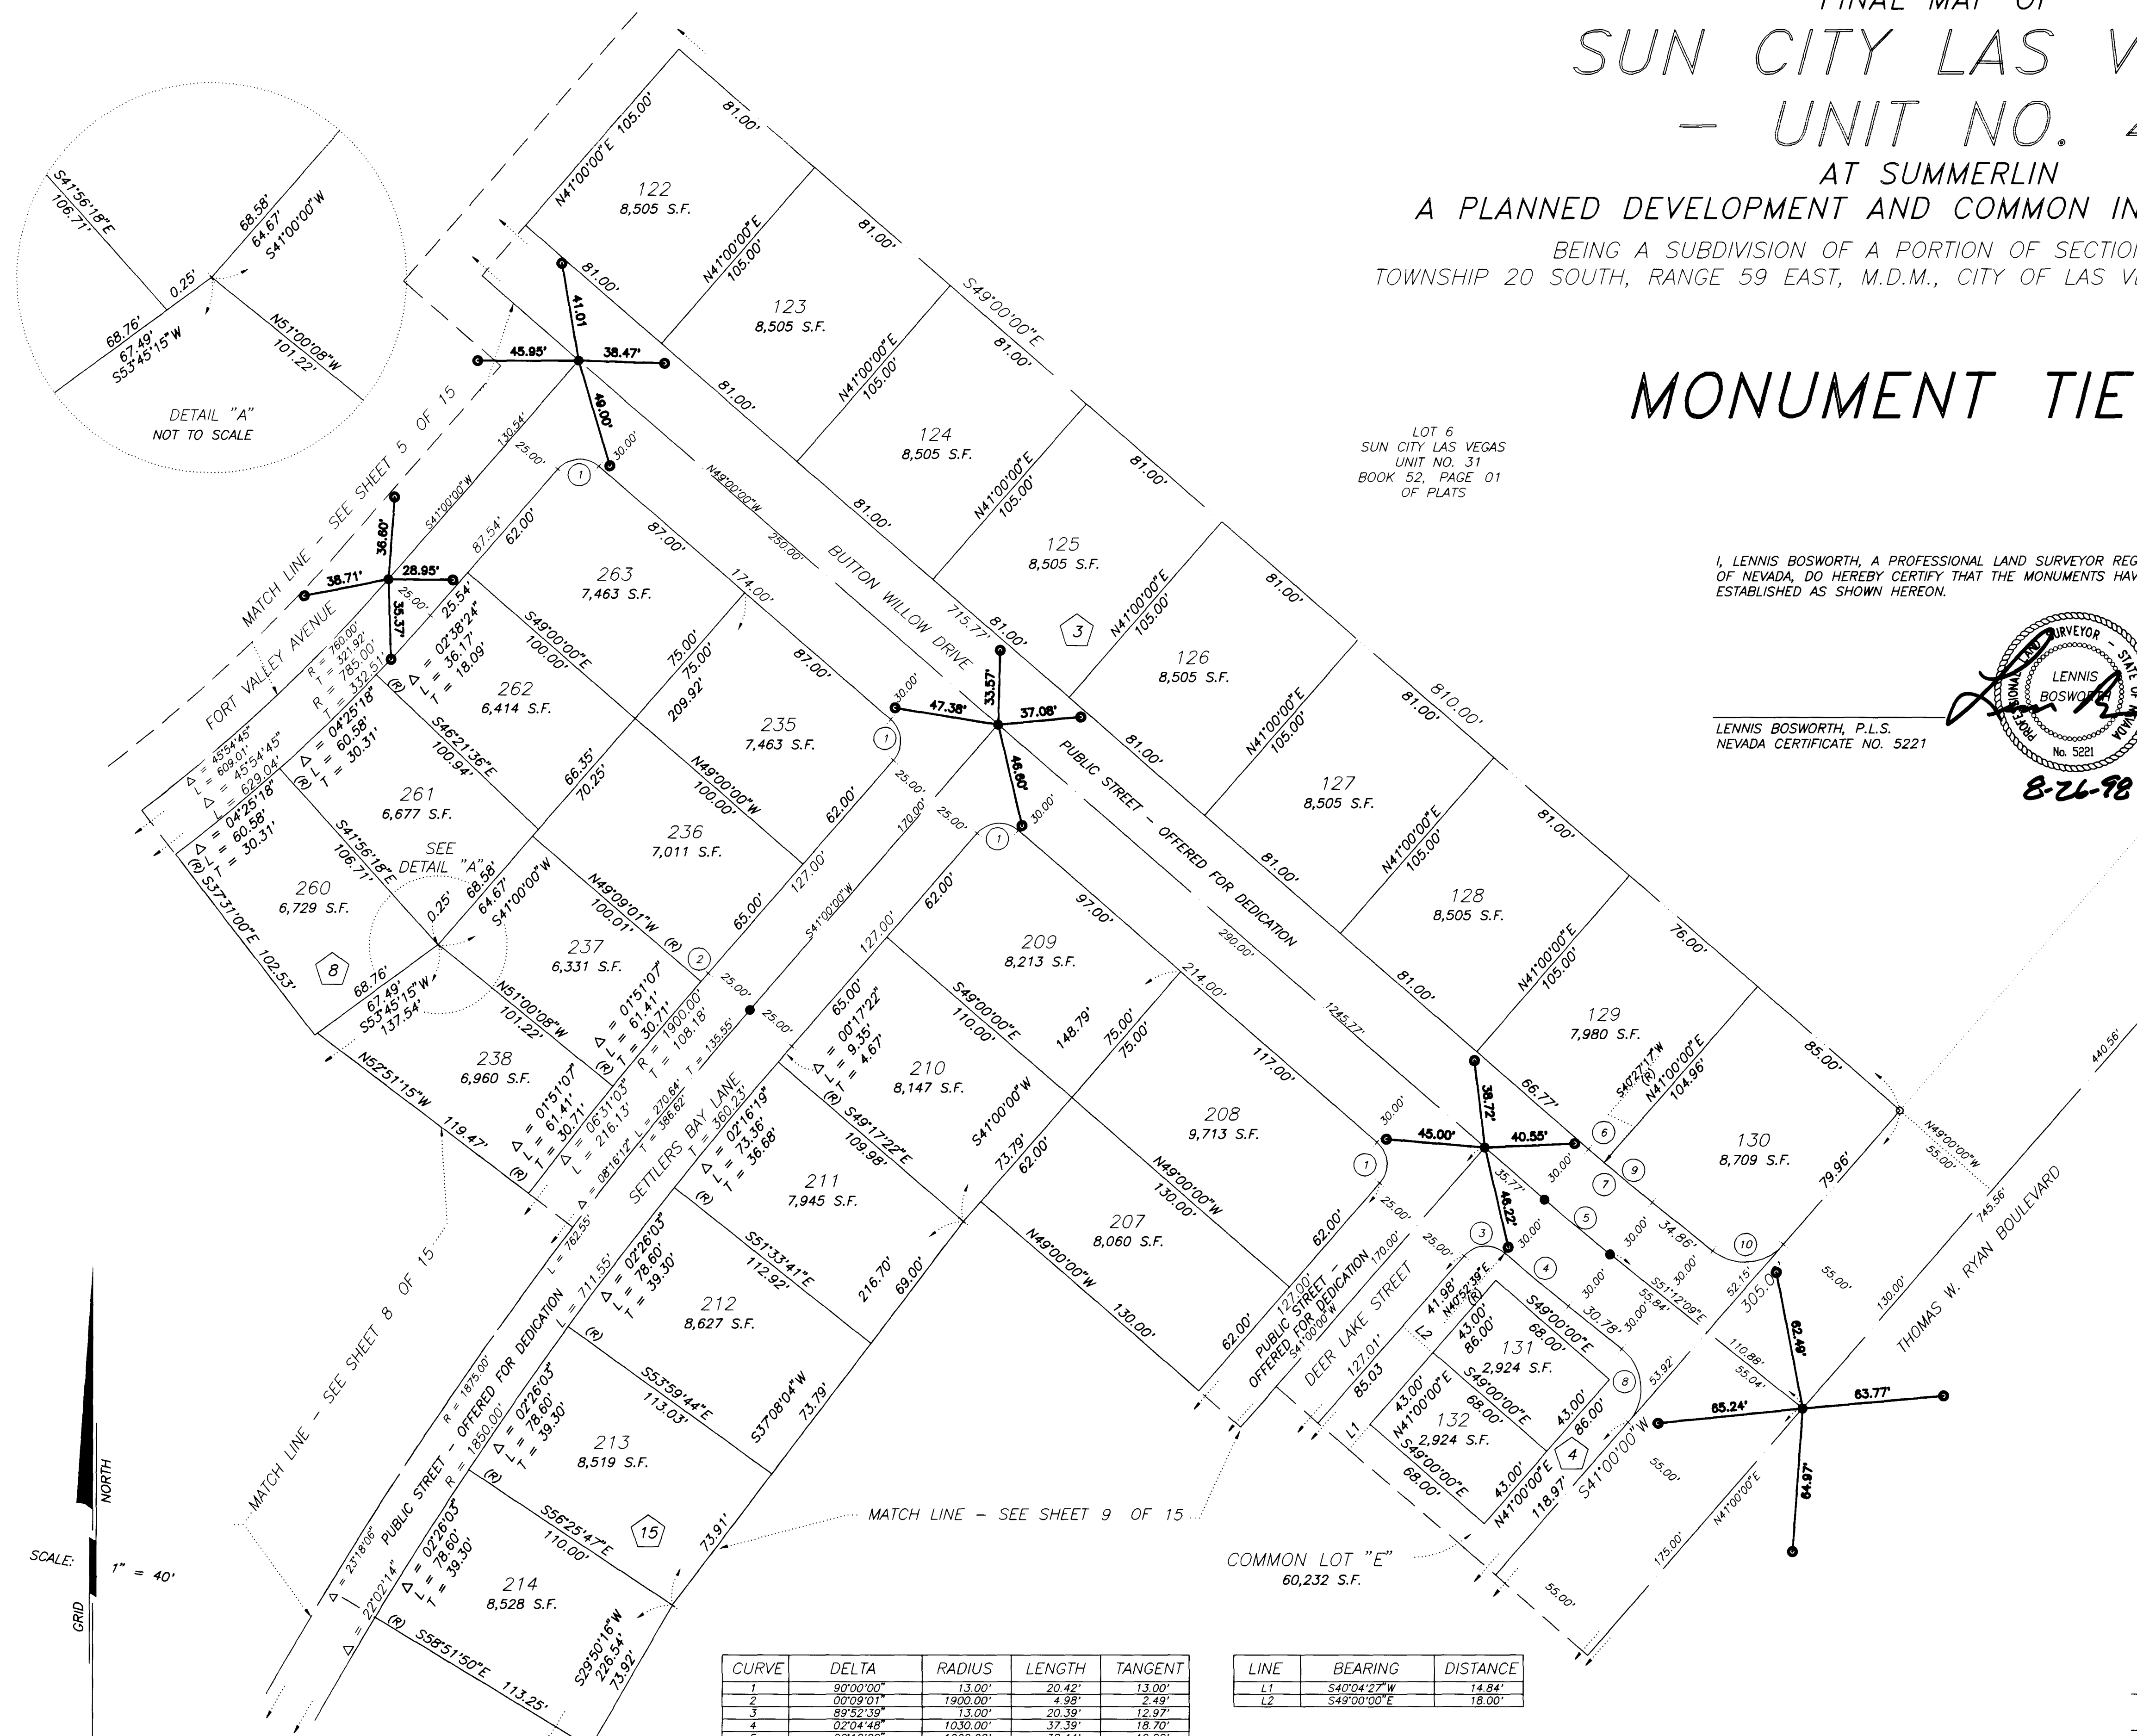

SEE SHEET 2 FOR
KEY MAP AND
BASIS OF BEARINGS

CURVE	DELTA	RADIUS	LENGTH	TANGENT
1	90°00'00"	13.00'	20.42'	13.00'
2	00°09'01"	1900.00'	4.98'	2.49'
3	89°52'19"	13.00'	20.39'	12.97'
4	02°04'48"	1030.00'	37.39'	18.70'
5	02°12'09"	1000.00'	38.44'	19.22'
6	00°32'43"	970.00'	9.23'	4.62'
7	02°12'09"	970.00'	37.29'	18.65'
8	02°12'09"	23.00'	37.01'	23.90'
9	01°39'26"	970.00'	28.06'	14.03'
10	87°47'51"	23.00'	35.24'	22.13'

LINE	BEARING	DISTANCE
L1	S40°04'27"W	14.84'
L2	S49°00'00"E	18.00'

