

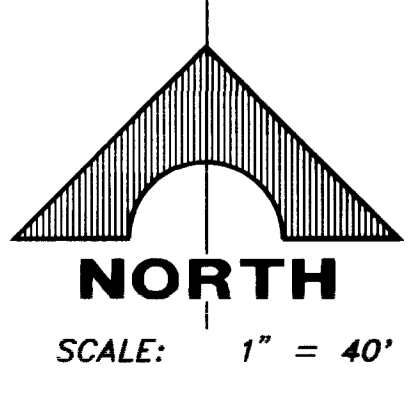


JOB NO. 701-238 PLOTTED: 11/02/94 10:29 am DRAWING: C:\DRAWINGS\DW\UNIT45\DAE-6 B.P. D.Lee

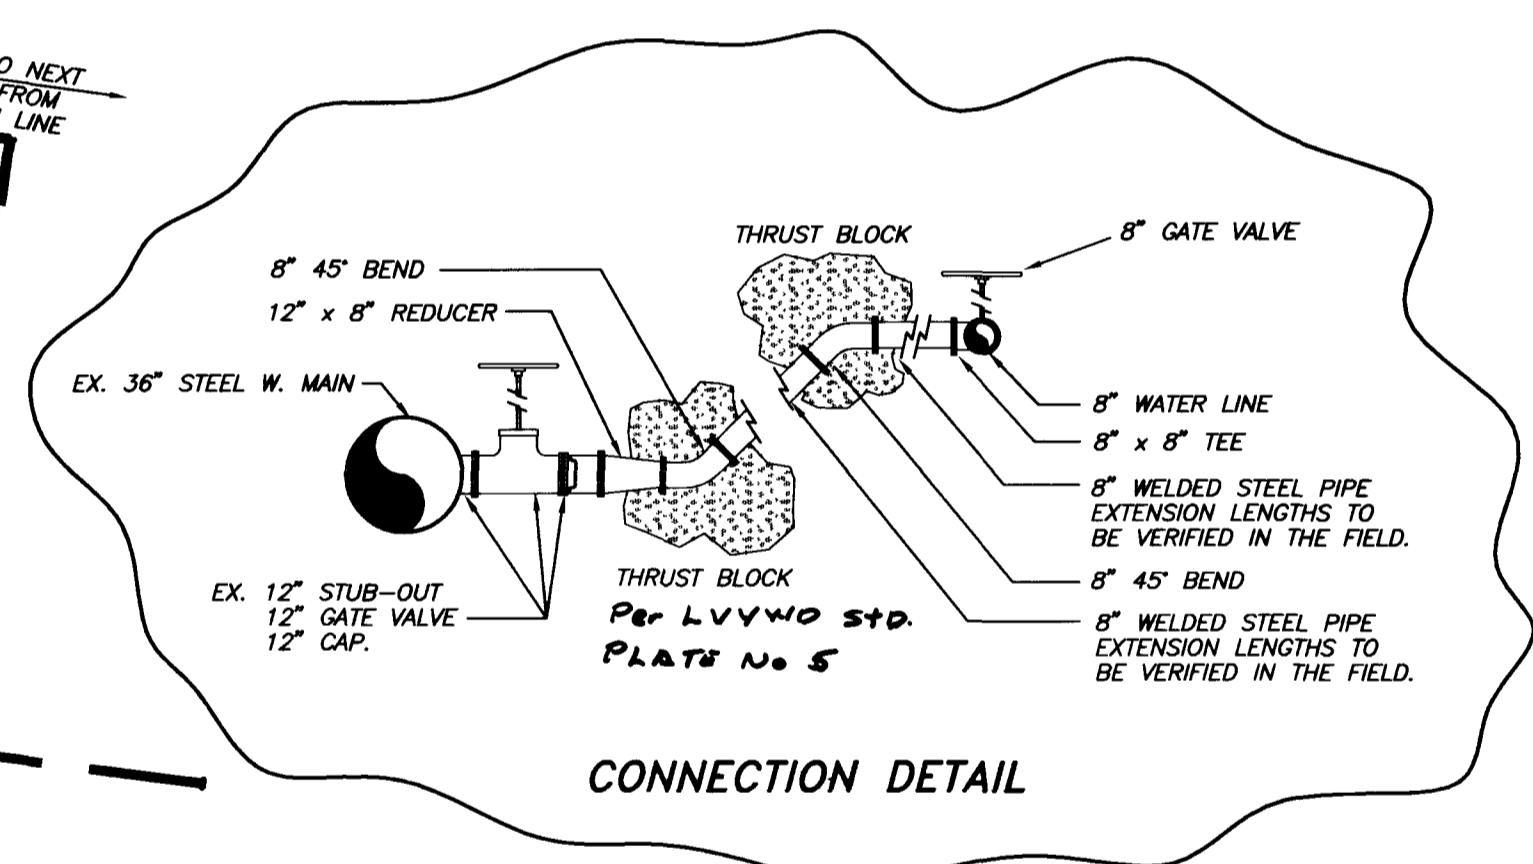


**FIRE HYDRANT RELOCATION AND LATERAL ABANDONMENT**  
(Existing Lateral to be Abandoned)

Where shown on the drawing(s), the Contractor shall abandon the existing fire hydrant(s) by removing both the upper and lower barrels of the fire hydrant so that no portion of the remaining fire hydrant assembly is closer than 2 feet to the existing grade. The existing hydrant shall be installed at the new location as indicated on the drawing, in accordance with Standard Plate No. 7. The existing valve shall be abandoned in a closed position and a minimum of the top 12 inches of the valve box removed. The remaining portion of the valve box shall be filled with concrete having a compressive strength of at least 2,000 psi. The remaining portion of the hole may be filled with concrete or asphalt cement. The lateral shall be cut and capped where indicated. Where a joint or coupling in the existing pipe is uncovered at the cut and cap location, the installation of a plug may be permitted, with Agency approval. A concrete thrust block shall be installed at all cut and cap locations in accordance with the provisions of Standard Plate No. 8.

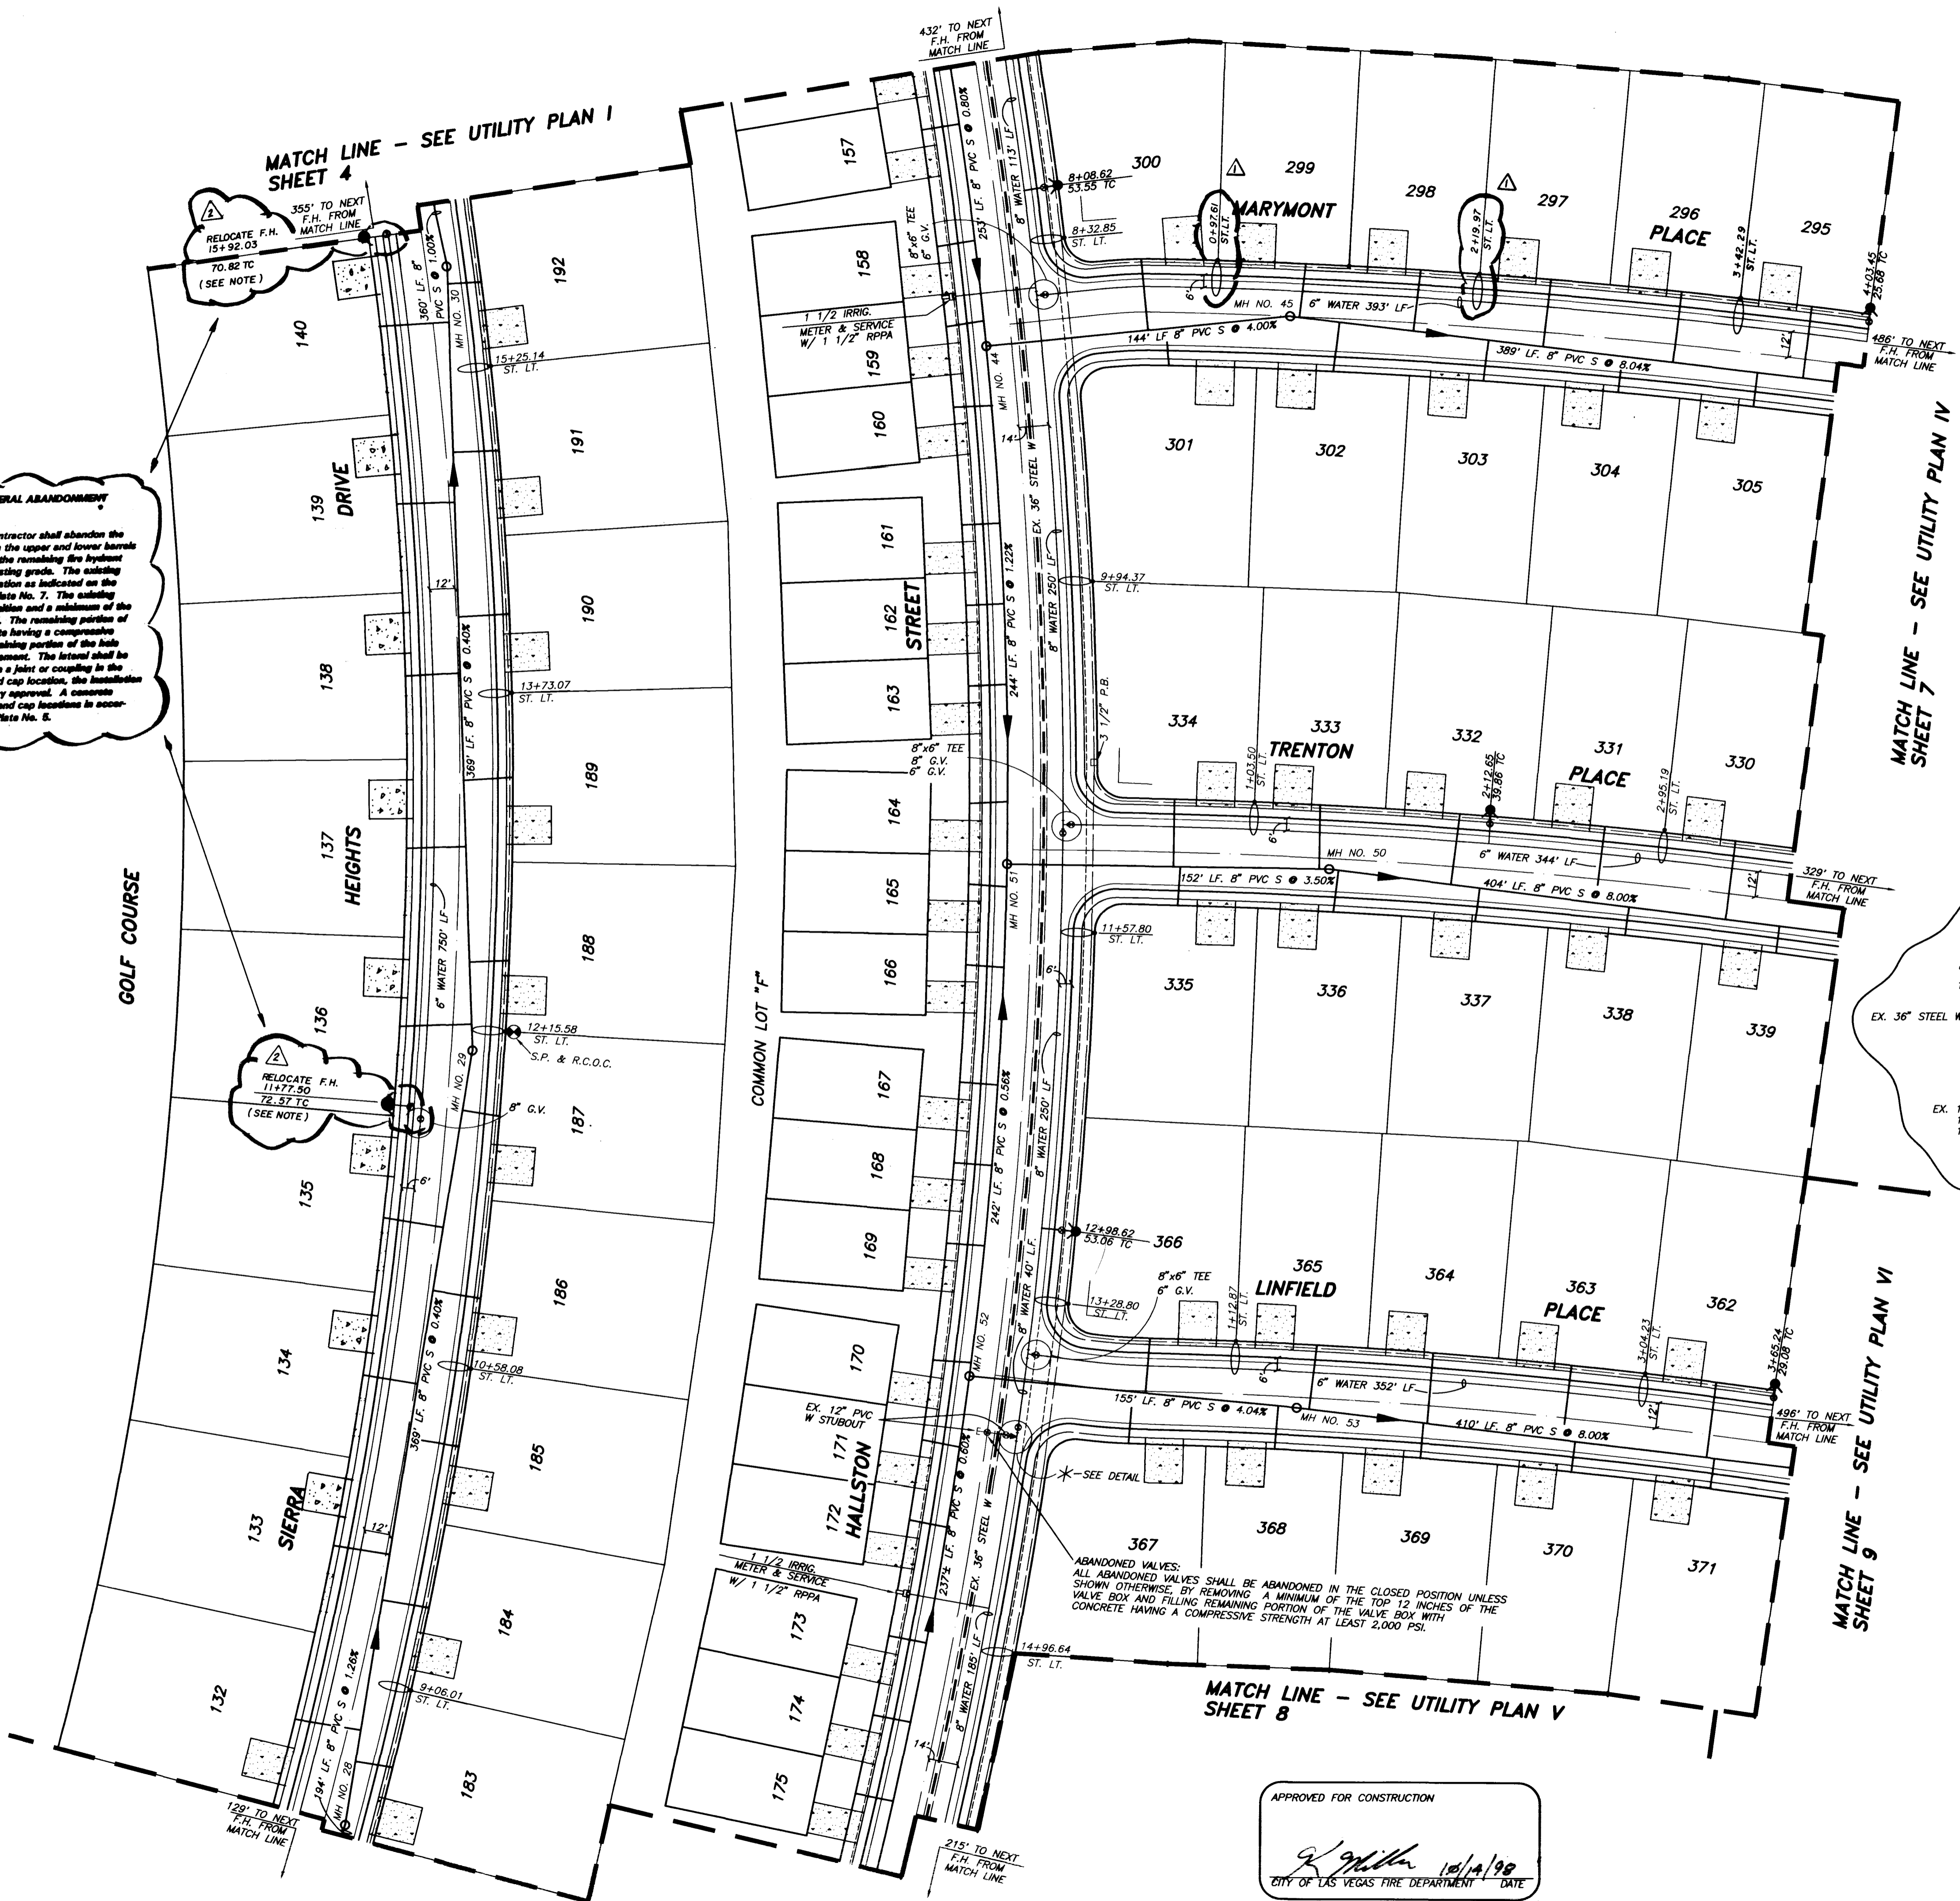

APPROVED FOR CONSTRUCTION  
*[Signature]*  
LAS VEGAS VALLEY WATER DISTRICT DATE: 11/13/94

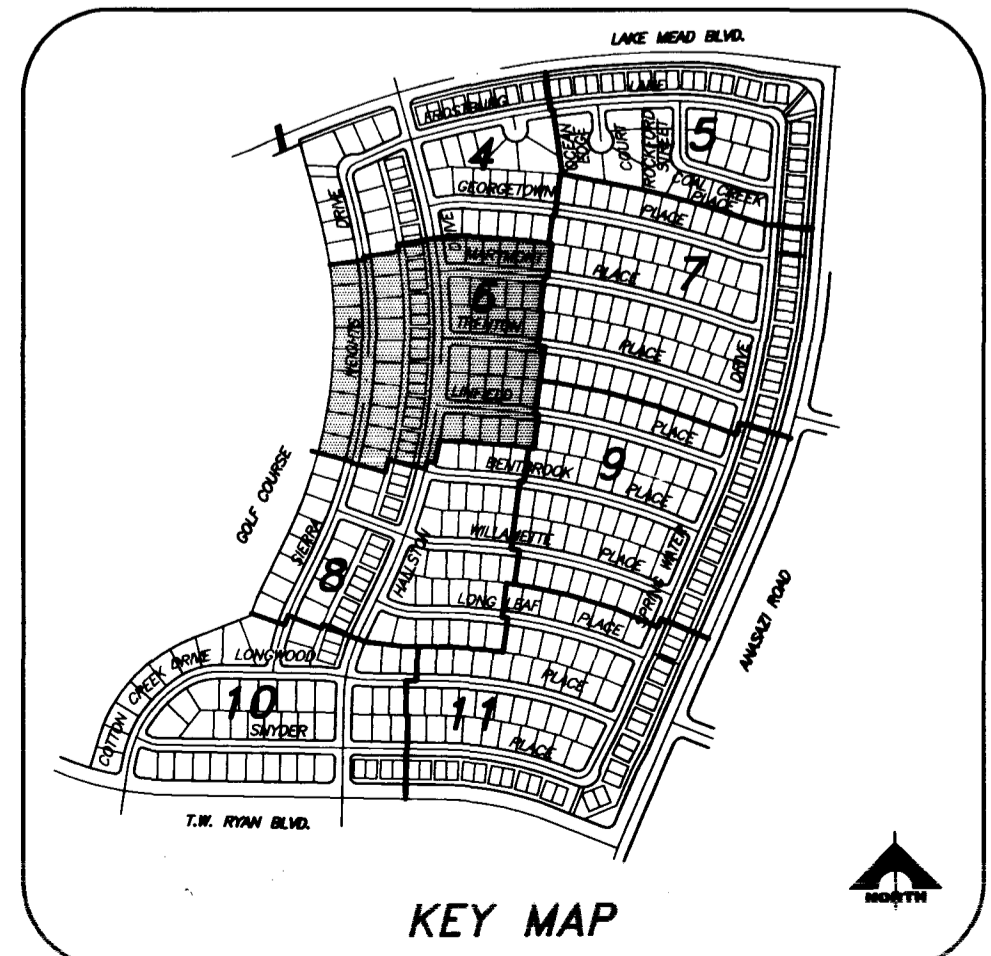

APPROVED FOR CONSTRUCTION  
*[Signature]* 10/14/98  
CITY OF LAS VEGAS FIRE DEPARTMENT DATE

REV.	DATE	DESCRIPTION	C.L.V.	DATE
1	10/11/94	REV. ST. L. LOCATIONS	10/11/94	10/11/94
2	10/11/94	REV. ST. L. LOCATIONS	10/11/94	10/11/94
REGISTERED PROFESSIONAL ENGINEER  
STATE OF NEVADA  
BOBBY W. WALLACE  
No. 10118  
10118  
11-2-94  
1555 SOUTH RAINBOW BLVD./LAS VEGAS, NEVADA 89102

DEL WEBB COMMUNITIES, INC.  
SUN CITY LAS VEGAS UNIT NO. 46  
UTILITY PLAN III  
SHEET 6  
OF 48 SHEETS

10-11-98 307Y-4141-46



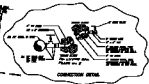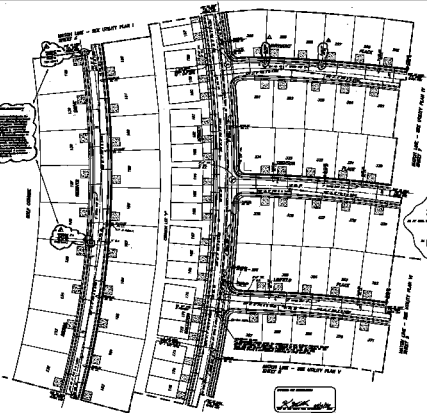









