


MATCH LINE - SEE UTILITY PLAN IV
SHEET 7


MATCH LINE - SEE UTILITY PLAN VI
SHEET 9

MATCH LINE - SEE UTILITY PLAN I
SHEET 4


ABANDONED VALVES:
ALL ABANDONED VALVES SHALL BE ABANDONED IN THE CLOSED POSITION UNLESS SHOWN OTHERWISE, BY REMOVING A MINIMUM OF THE TOP 12 INCHES OF THE VALVE BOX AND FILLING REMAINING PORTION OF THE VALVE BOX WITH CONCRETE HAVING A COMPRESSIVE STRENGTH AT LEAST 2,000 PSI.

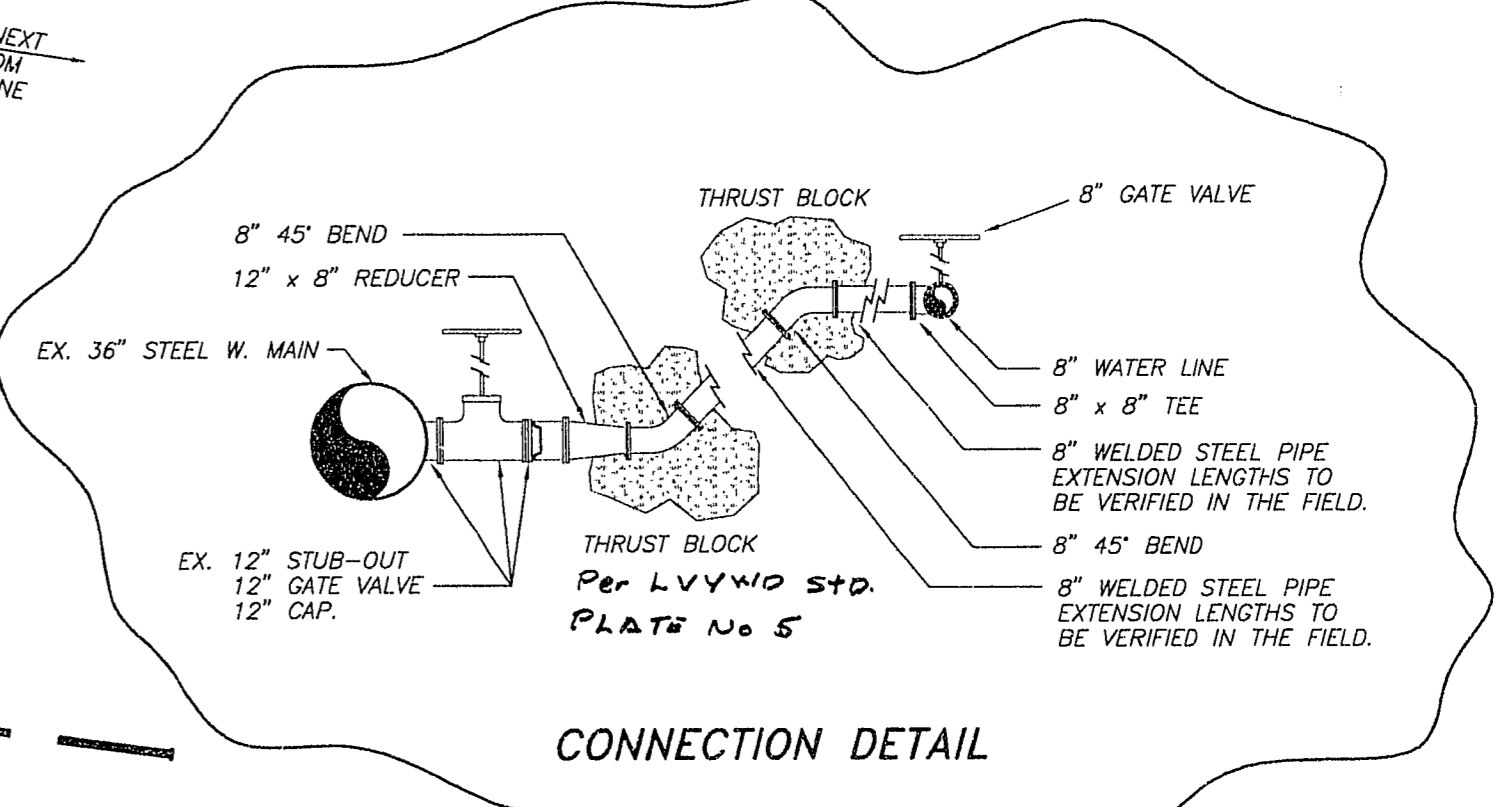

APPROVED FOR CONSTRUCTION
[Signature]
LAS VEGAS VALLEY WATER DISTRICT
DATE: 11/13/94

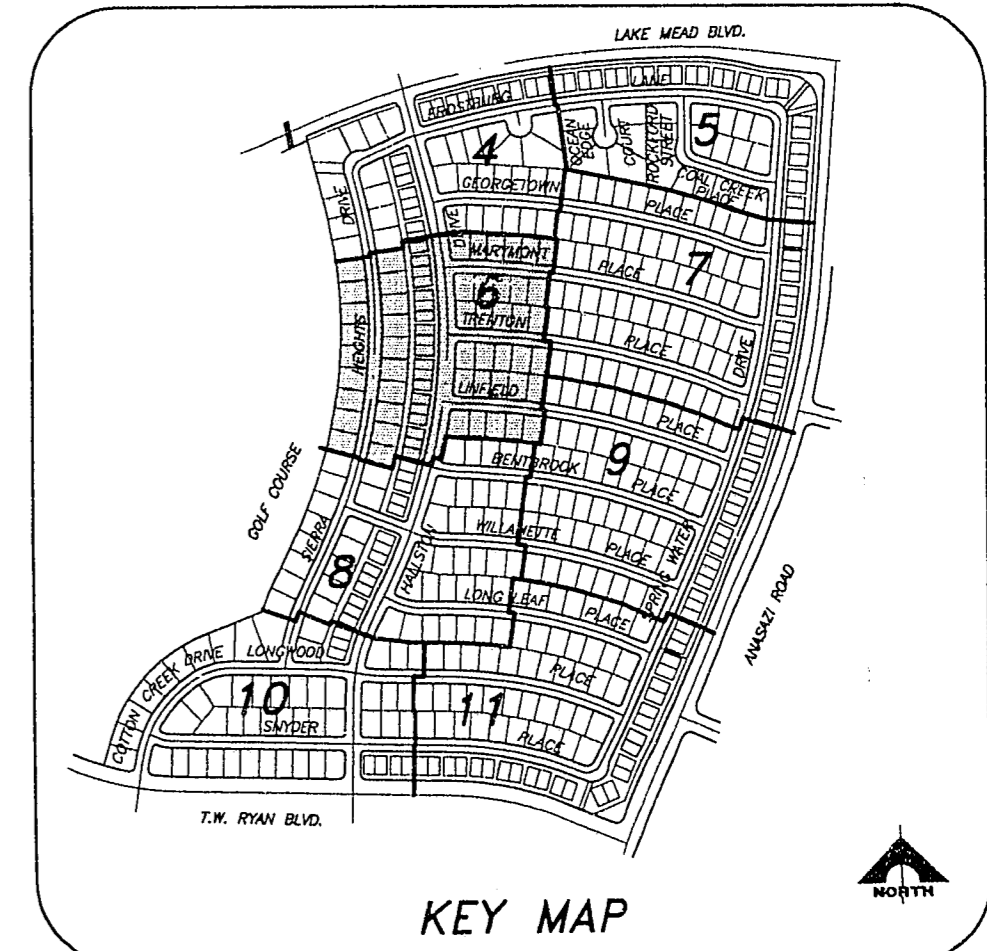

REV.	DATE	DESCRIPTION	C.L.V.	DATE
1	11/13/94	REV. STILL LOCATIONS		
2	11/13/94			

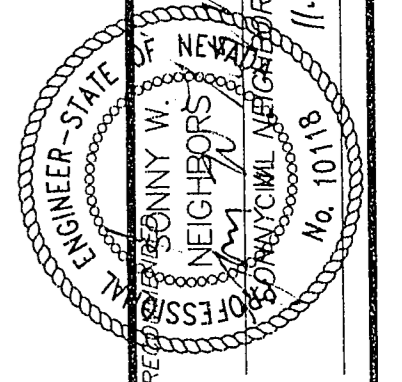

G.C. WALLACE, INC.
Engineering/Architecture
1555 SOUTH RAINBOW BLVD., LAS VEGAS, NEVADA 89102

DEL WEBB COMMUNITIES, INC.
SUN CITY LAS VEGAS UNIT NO. 46
UTILITY PLAN III