



NO.	DATE	DESCRIPTION	BY	CHK
1	10/11/18	ISSUED FOR CONSTRUCTION		

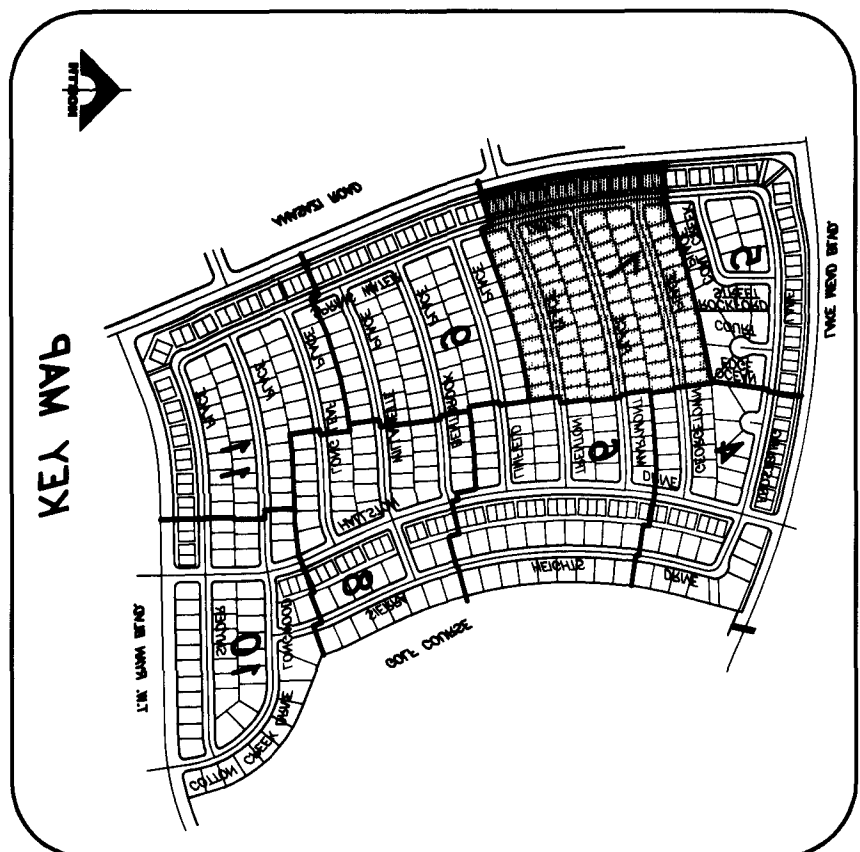


ISSUED FOR CONSTRUCTION
 DATE: 10/11/18
 BY: [Signature]
 CHK: [Signature]

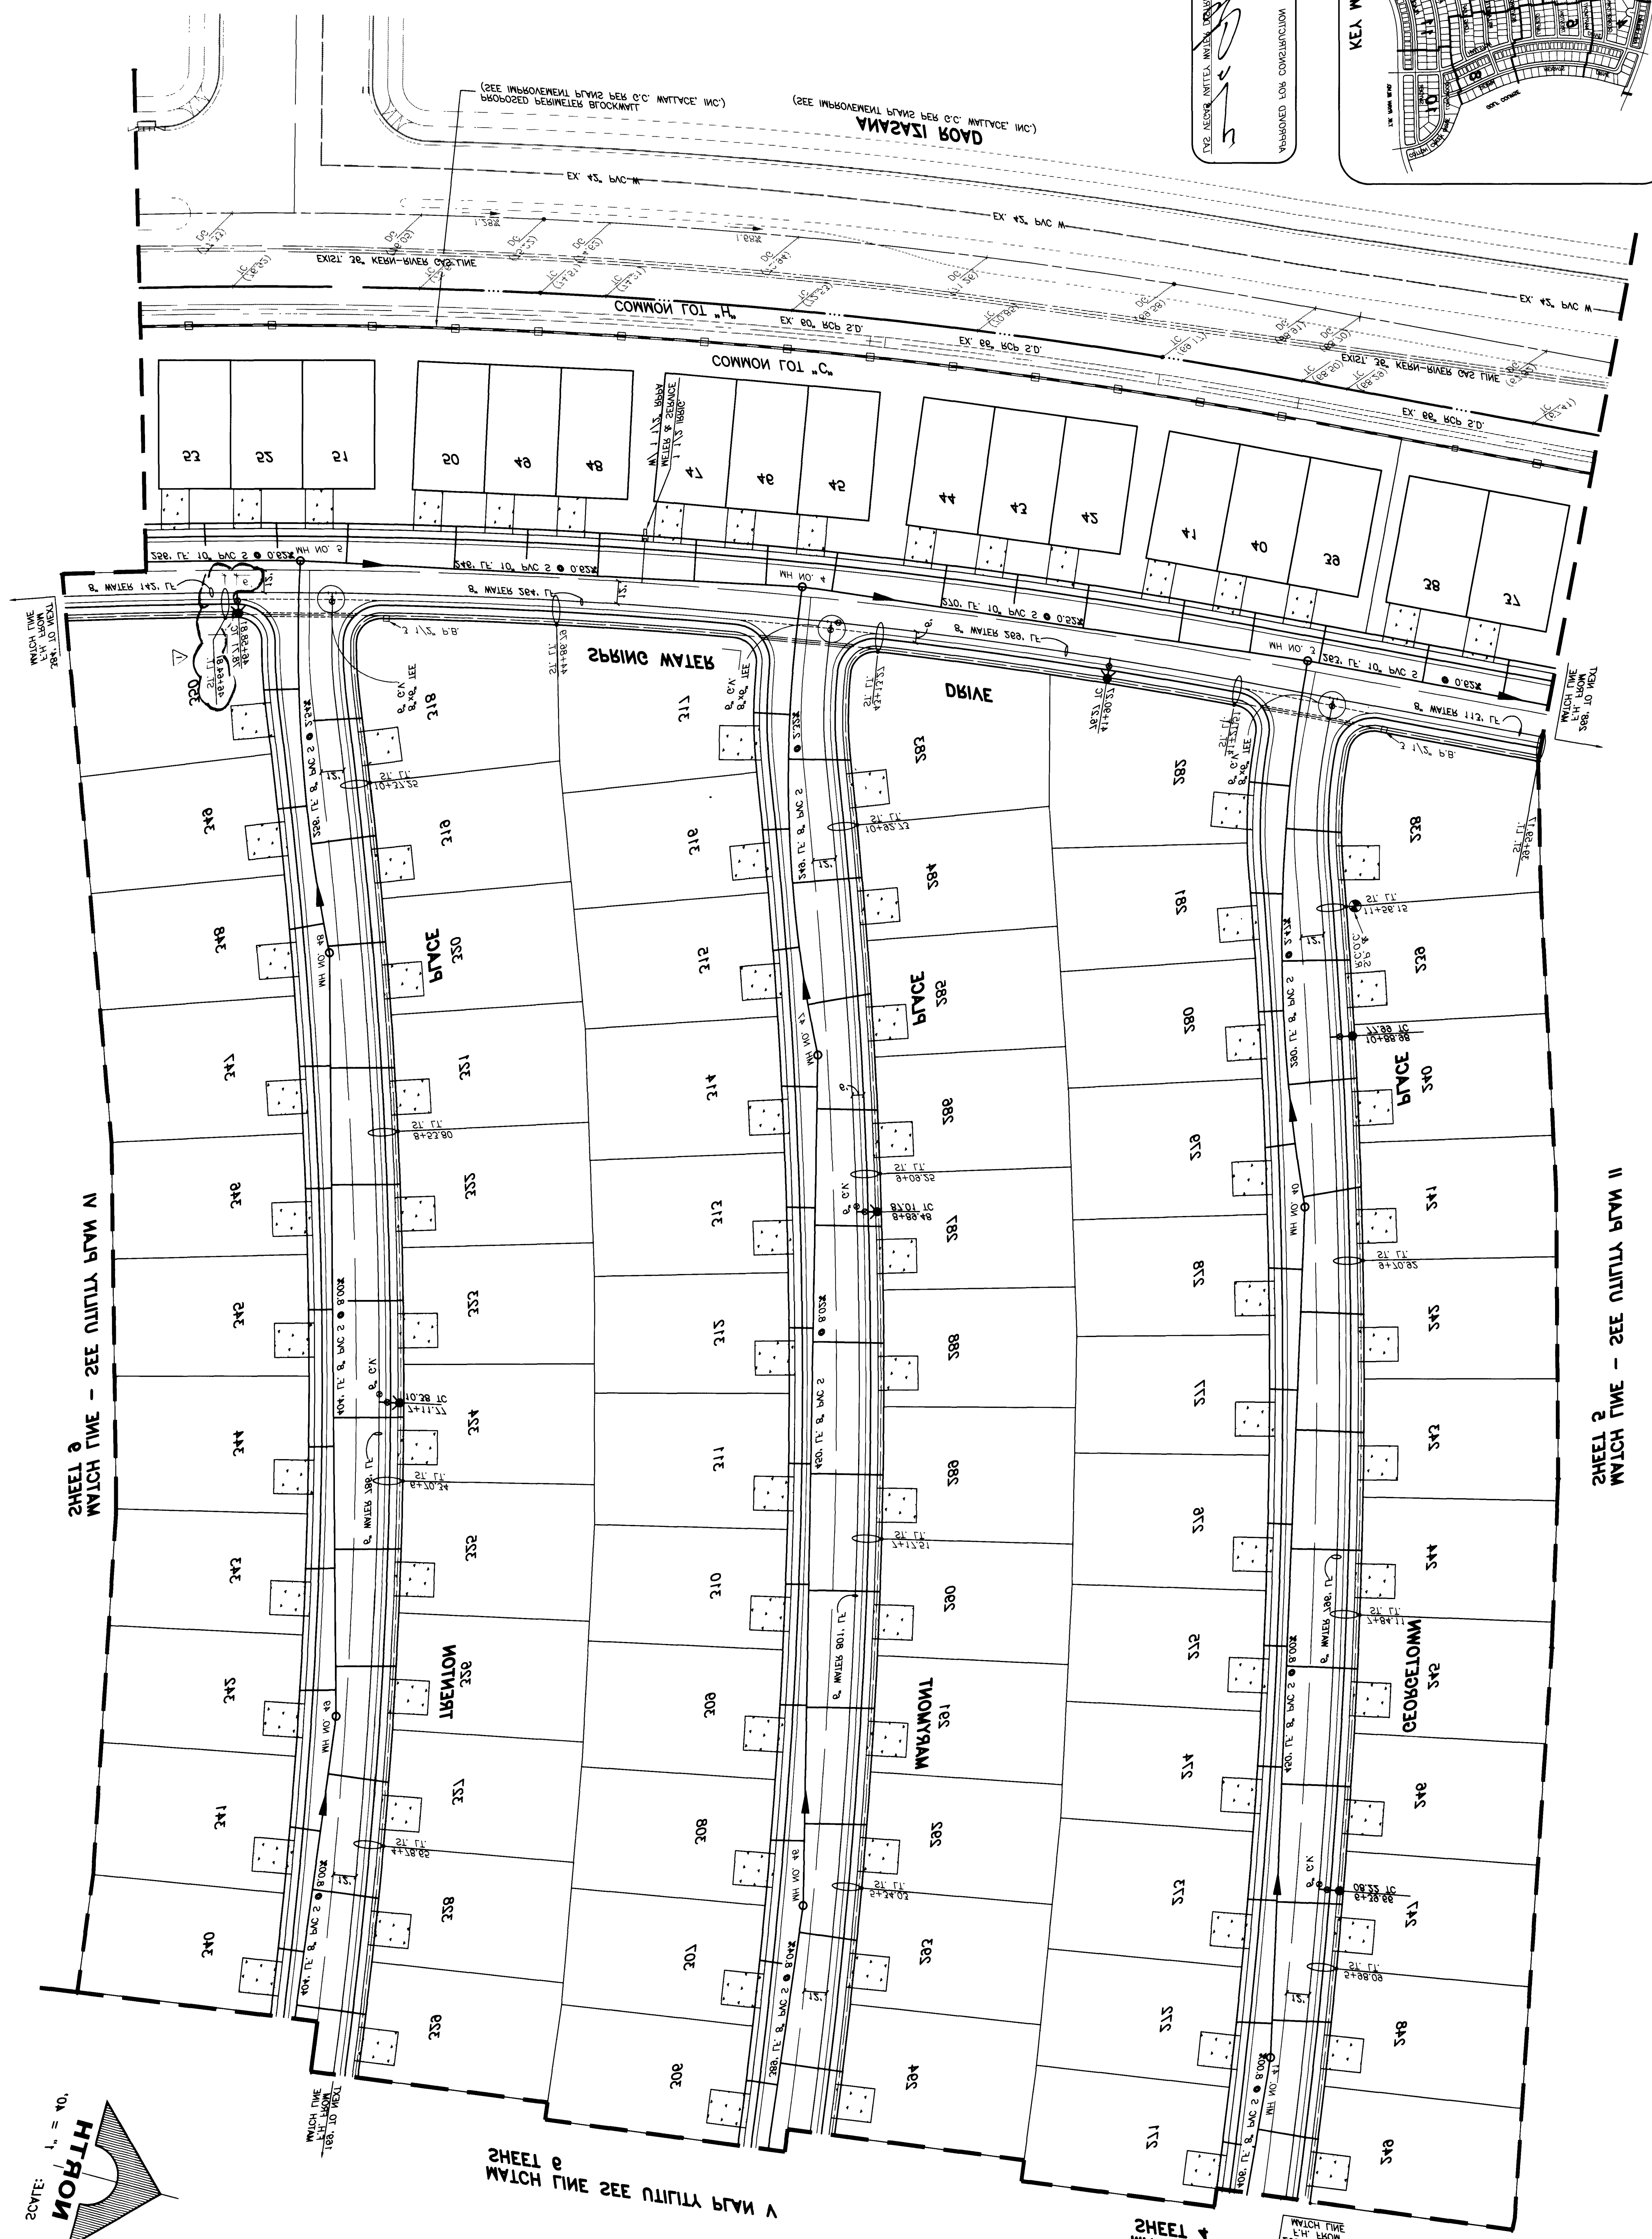

SHEET 3
 MATCH LINE - SEE UTILITY PLAN IV

SHEET 2
 MATCH LINE - SEE UTILITY PLAN II

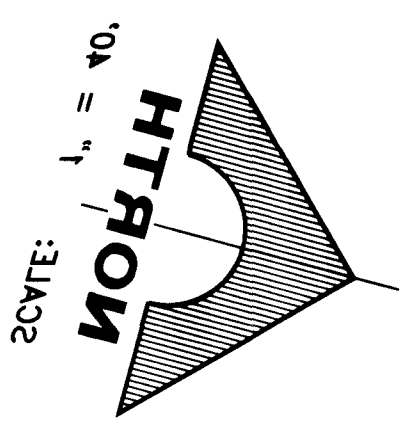

 MATCH LINE SEE UTILITY PLAN V


SHEET 4
 MATCH LINE SEE UTILITY PLAN V






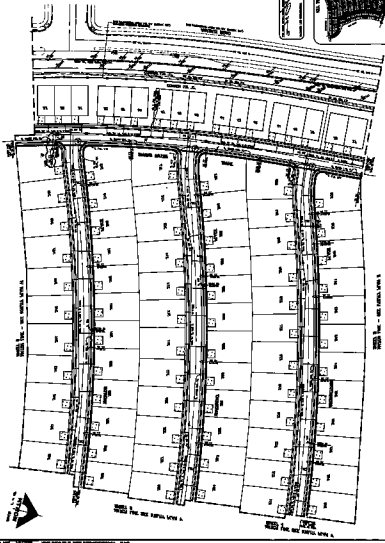

SEE PLAN FOR DETAILS OF LOT 1





