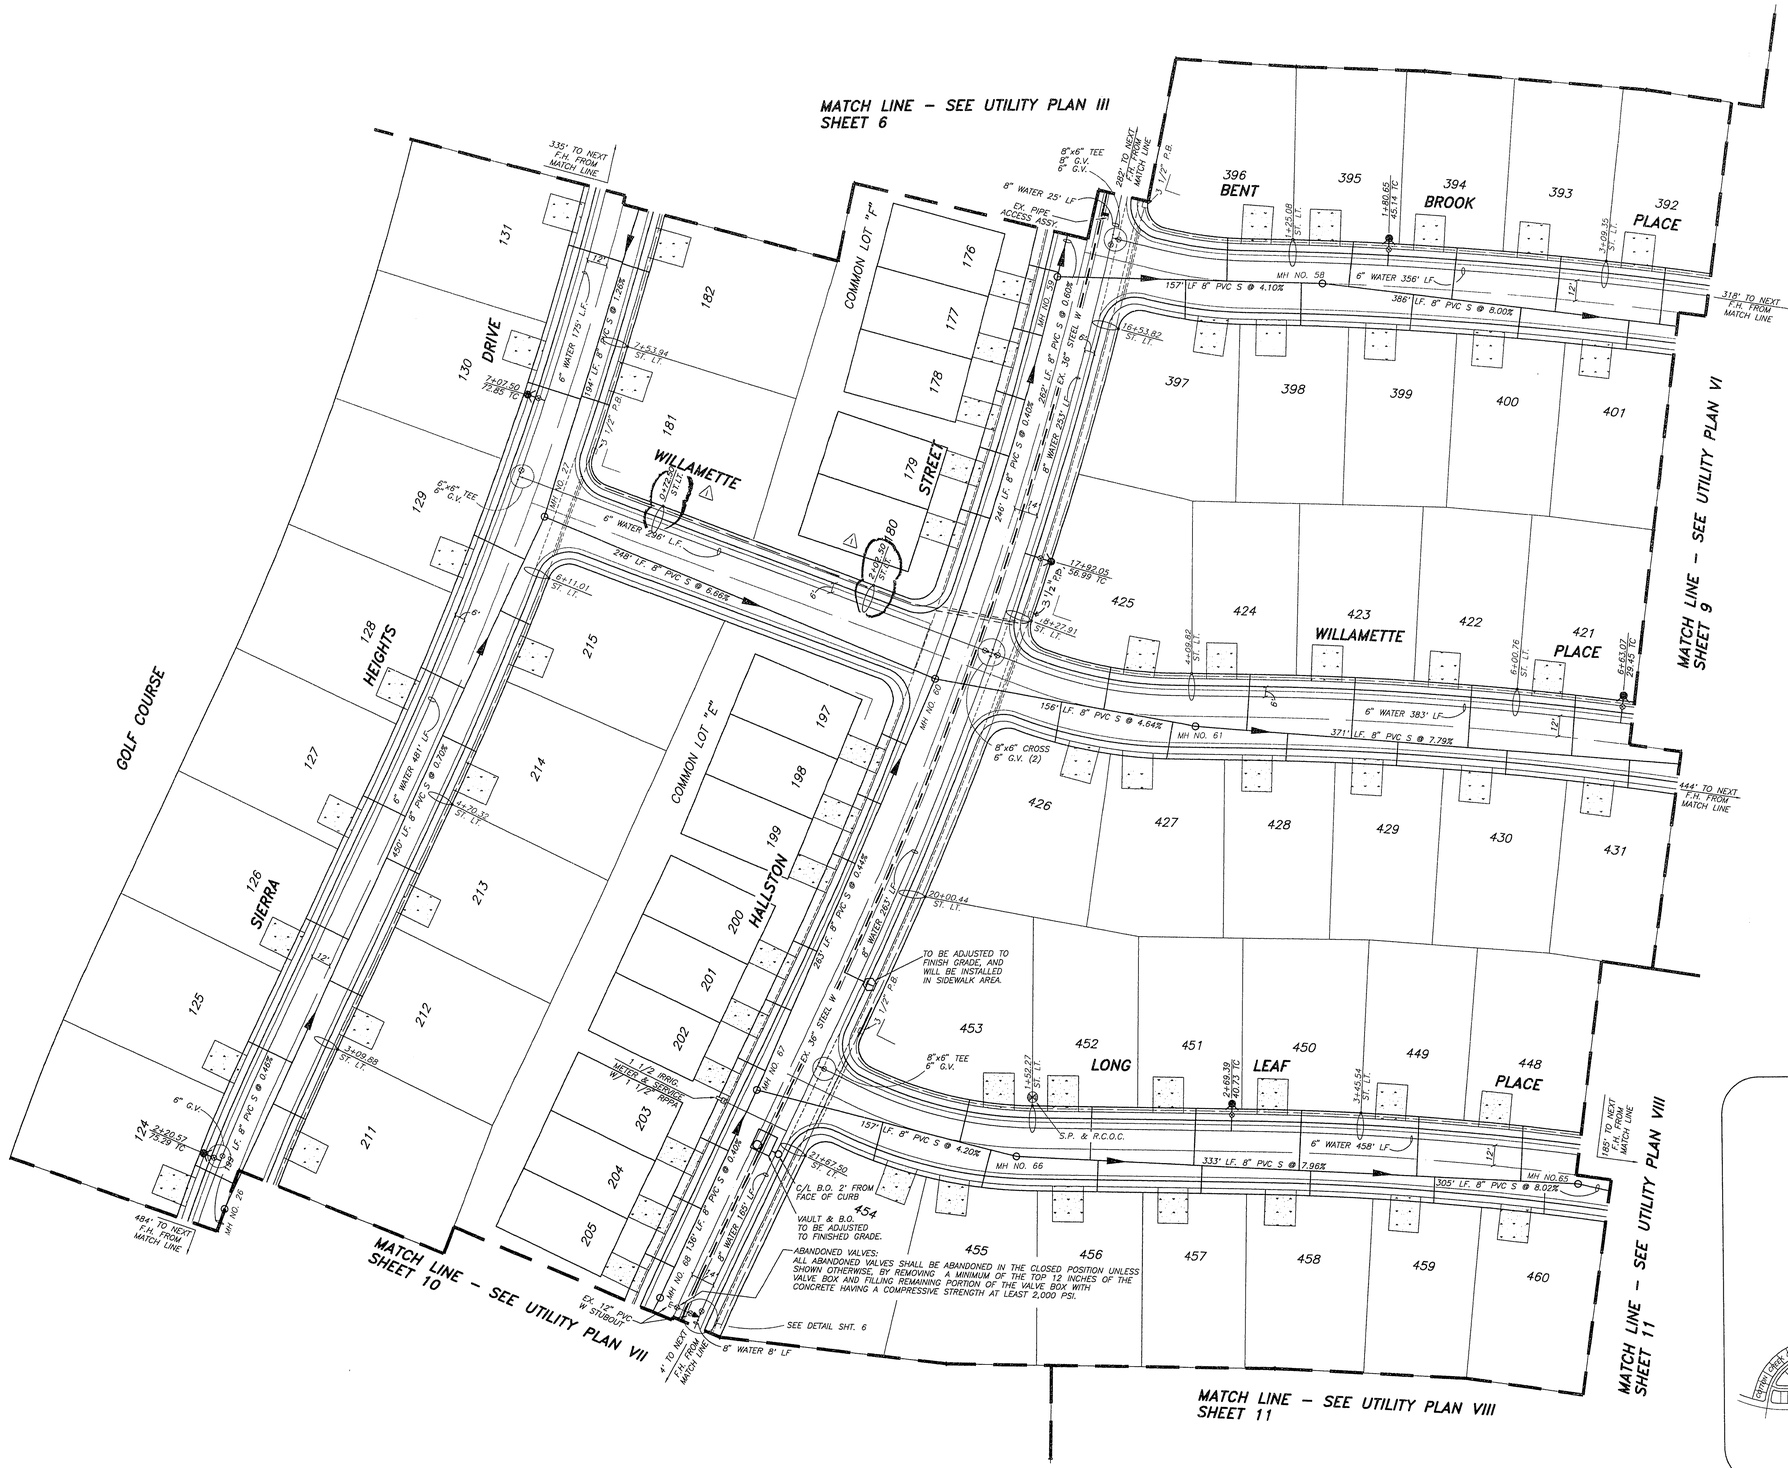

REV.	DATE	DESCRIPTION	C.O.V.	DATE
1	3/16/95	ADDED ST.L.T.		3/18/95

RECOMMENDED: SONNY W. NEIGHBORS, P.E. NO. 10118 — DATE 11-2-14
REGISTERED PROFESSIONAL ENGINEER — STATE OF NEVADA — No. 10118

G.C. WALLACE, INC.
Engineering/Architecture
1555 SOUTH RAINBOW BLVD./LAS VEGAS, NEVADA 89102

DEL WEBB COMMUNITIES, INC.
SUN CITY LAS VEGAS UNIT NO. 46
UTILITY PLAN V

SHEET 8 OF 48 SHEETS

JOB NO. 701.238

PLOTTED: 11/02/94 12:50 pm DRAWING: C:\DRAWINGS\DWG\UNIT46\046-8 BY: D.Lee

10-11-80 307Y-4141-46