


FINAL MAP OF
SUN CITY SUMMERLIN – UNIT NO. 47
AT LAS VEGAS
A PLANNED DEVELOPMENT AND COMMON INTEREST COMMUNITY

BEING A SUBDIVISION OF A PORTION OF PARCEL 4 AS SHOWN BY MAP THEREOF ON FILE IN FILE 80, PAGE 39 OF PARCEL MAPS IN THE CLARK COUNTY RECORDER'S OFFICE, CLARK COUNTY, NEVADA, LYING WITHIN SECTION 24, TOWNSHIP 20 SOUTH, RANGE 59 EAST, M.D.M., CITY OF LAS VEGAS, CLARK COUNTY, NEVADA

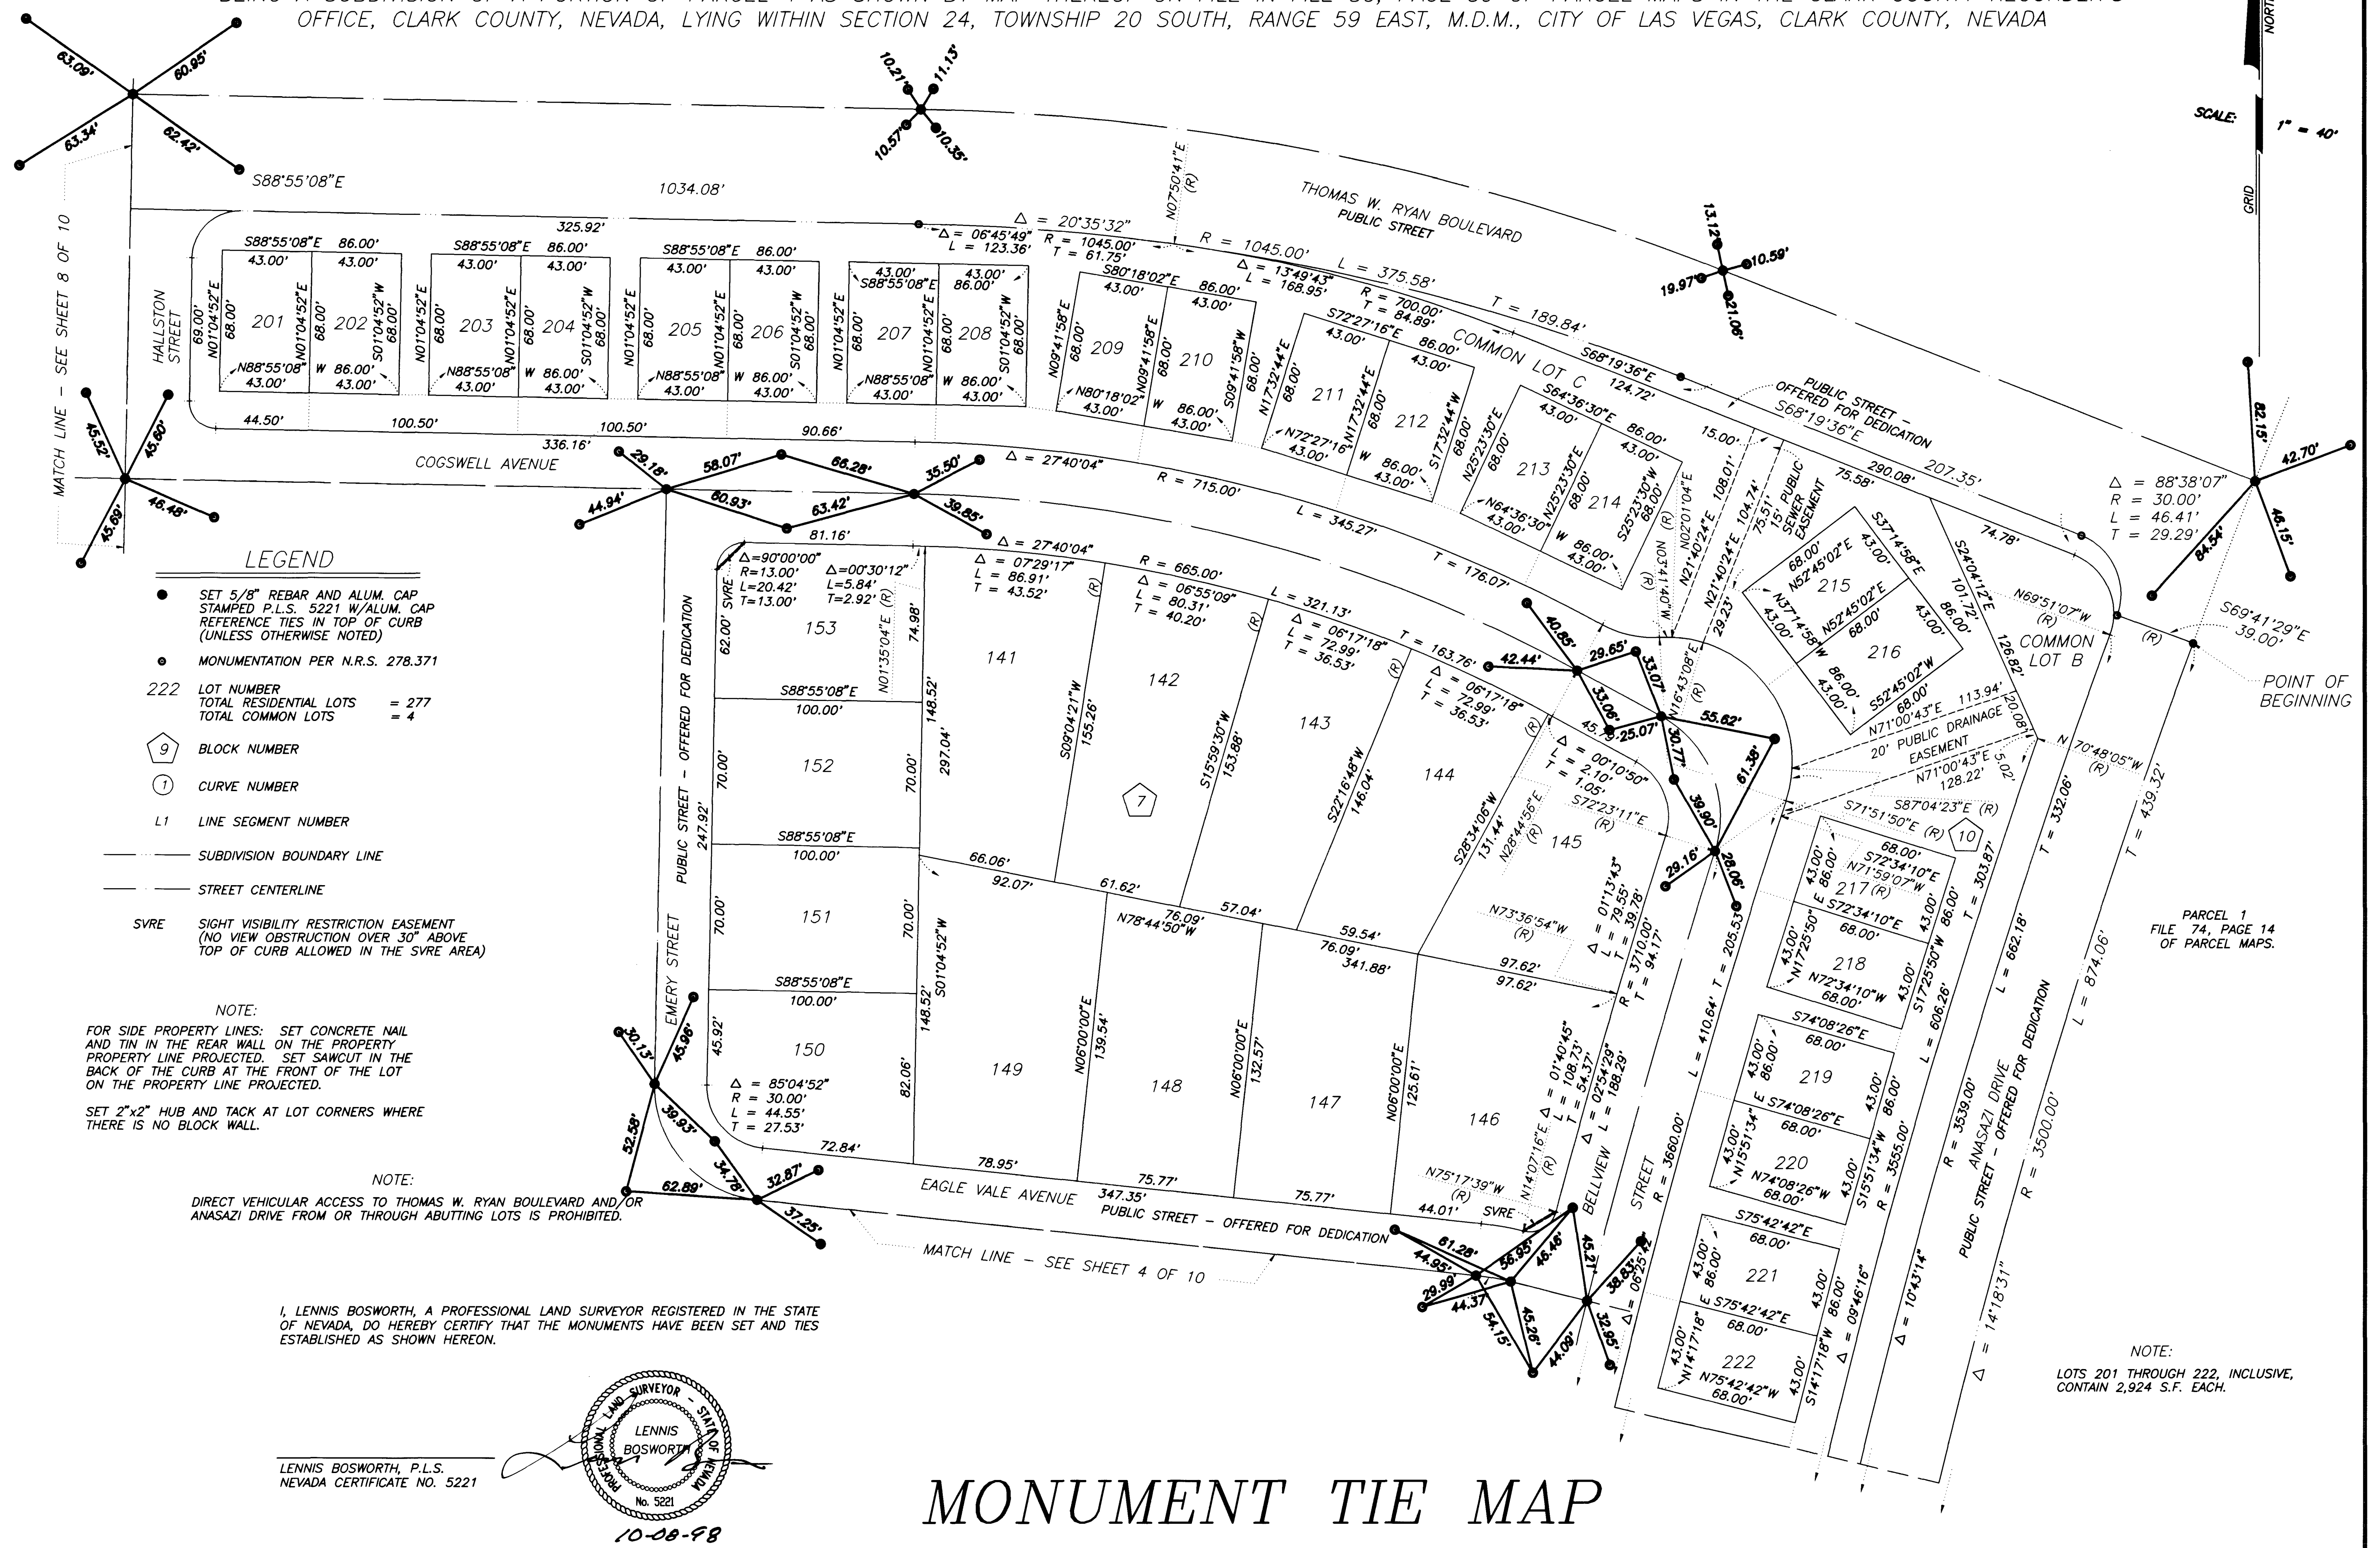

MONUMENT TIE MAP

A PLANNED DEVELOPMENT AND COMMON INTEREST COMMUNITY

BEING A SUBDIVISION OF A PORTION OF PARCEL 4 AS SHOWN BY MAP THEREOF ON FILE IN FILE NO. PAGE 39 OF PARCEL MAPS IN THE CLARK COUNTY RECORDERS OFFICE, CLARK COUNTY, NEVADA, LYING BETWEEN SECTION 24, TOWNSHIP 20 SOUTH, RANGE 50 EAST, M.O.M., CITY OF LAS VEGAS, CLARK COUNTY, NEVADA

