

FINAL MAP OF
SUN CITY SUMMERLIN – UNIT NO. 47
AT LAS VEGAS
A PLANNED DEVELOPMENT AND COMMON INTEREST COMMUNITY

NOTE:
FOR SIDE PROPERTY LINES: SET CONCRETE NAIL
AND TIN IN THE REAR WALL ON THE PROPERTY
LINE PROJECTED. SET SAWCUT IN THE
BACK OF THE CURB AT THE FRONT OF THE LOT
ON THE PROPERTY LINE PROJECTED.

SET 2"x2" HUB AND TACK AT LOT CORNERS WHERE
THERE IS NO BLOCK WALL.


SEE SHEET 2 FOR
KEY MAP AND
BASIS OF BEARINGS

BEING A SUBDIVISION OF A PORTION OF PARCEL 4 AS SHOWN BY MAP THEREOF ON FILE IN FILE 80, PAGE 39 OF PARCEL MAPS IN THE CLARK COUNTY RECORDER'S
OFFICE, CLARK COUNTY, NEVADA, LYING WITHIN SECTION 24, TOWNSHIP 20 SOUTH, RANGE 59 EAST, M.D.M., CITY OF LAS VEGAS, CLARK COUNTY, NEVADA

NOTE:
DIRECT VEHICULAR ACCESS TO SUMMERLIN PARKWAY
FROM OR THROUGH ABUTTING LOTS IS PROHIBITED.

NOTE:
LOTS 249 THROUGH 262, INCLUSIVE,
CONTAIN 2,924 S.F. EACH.

SCALE:
1" = 40'

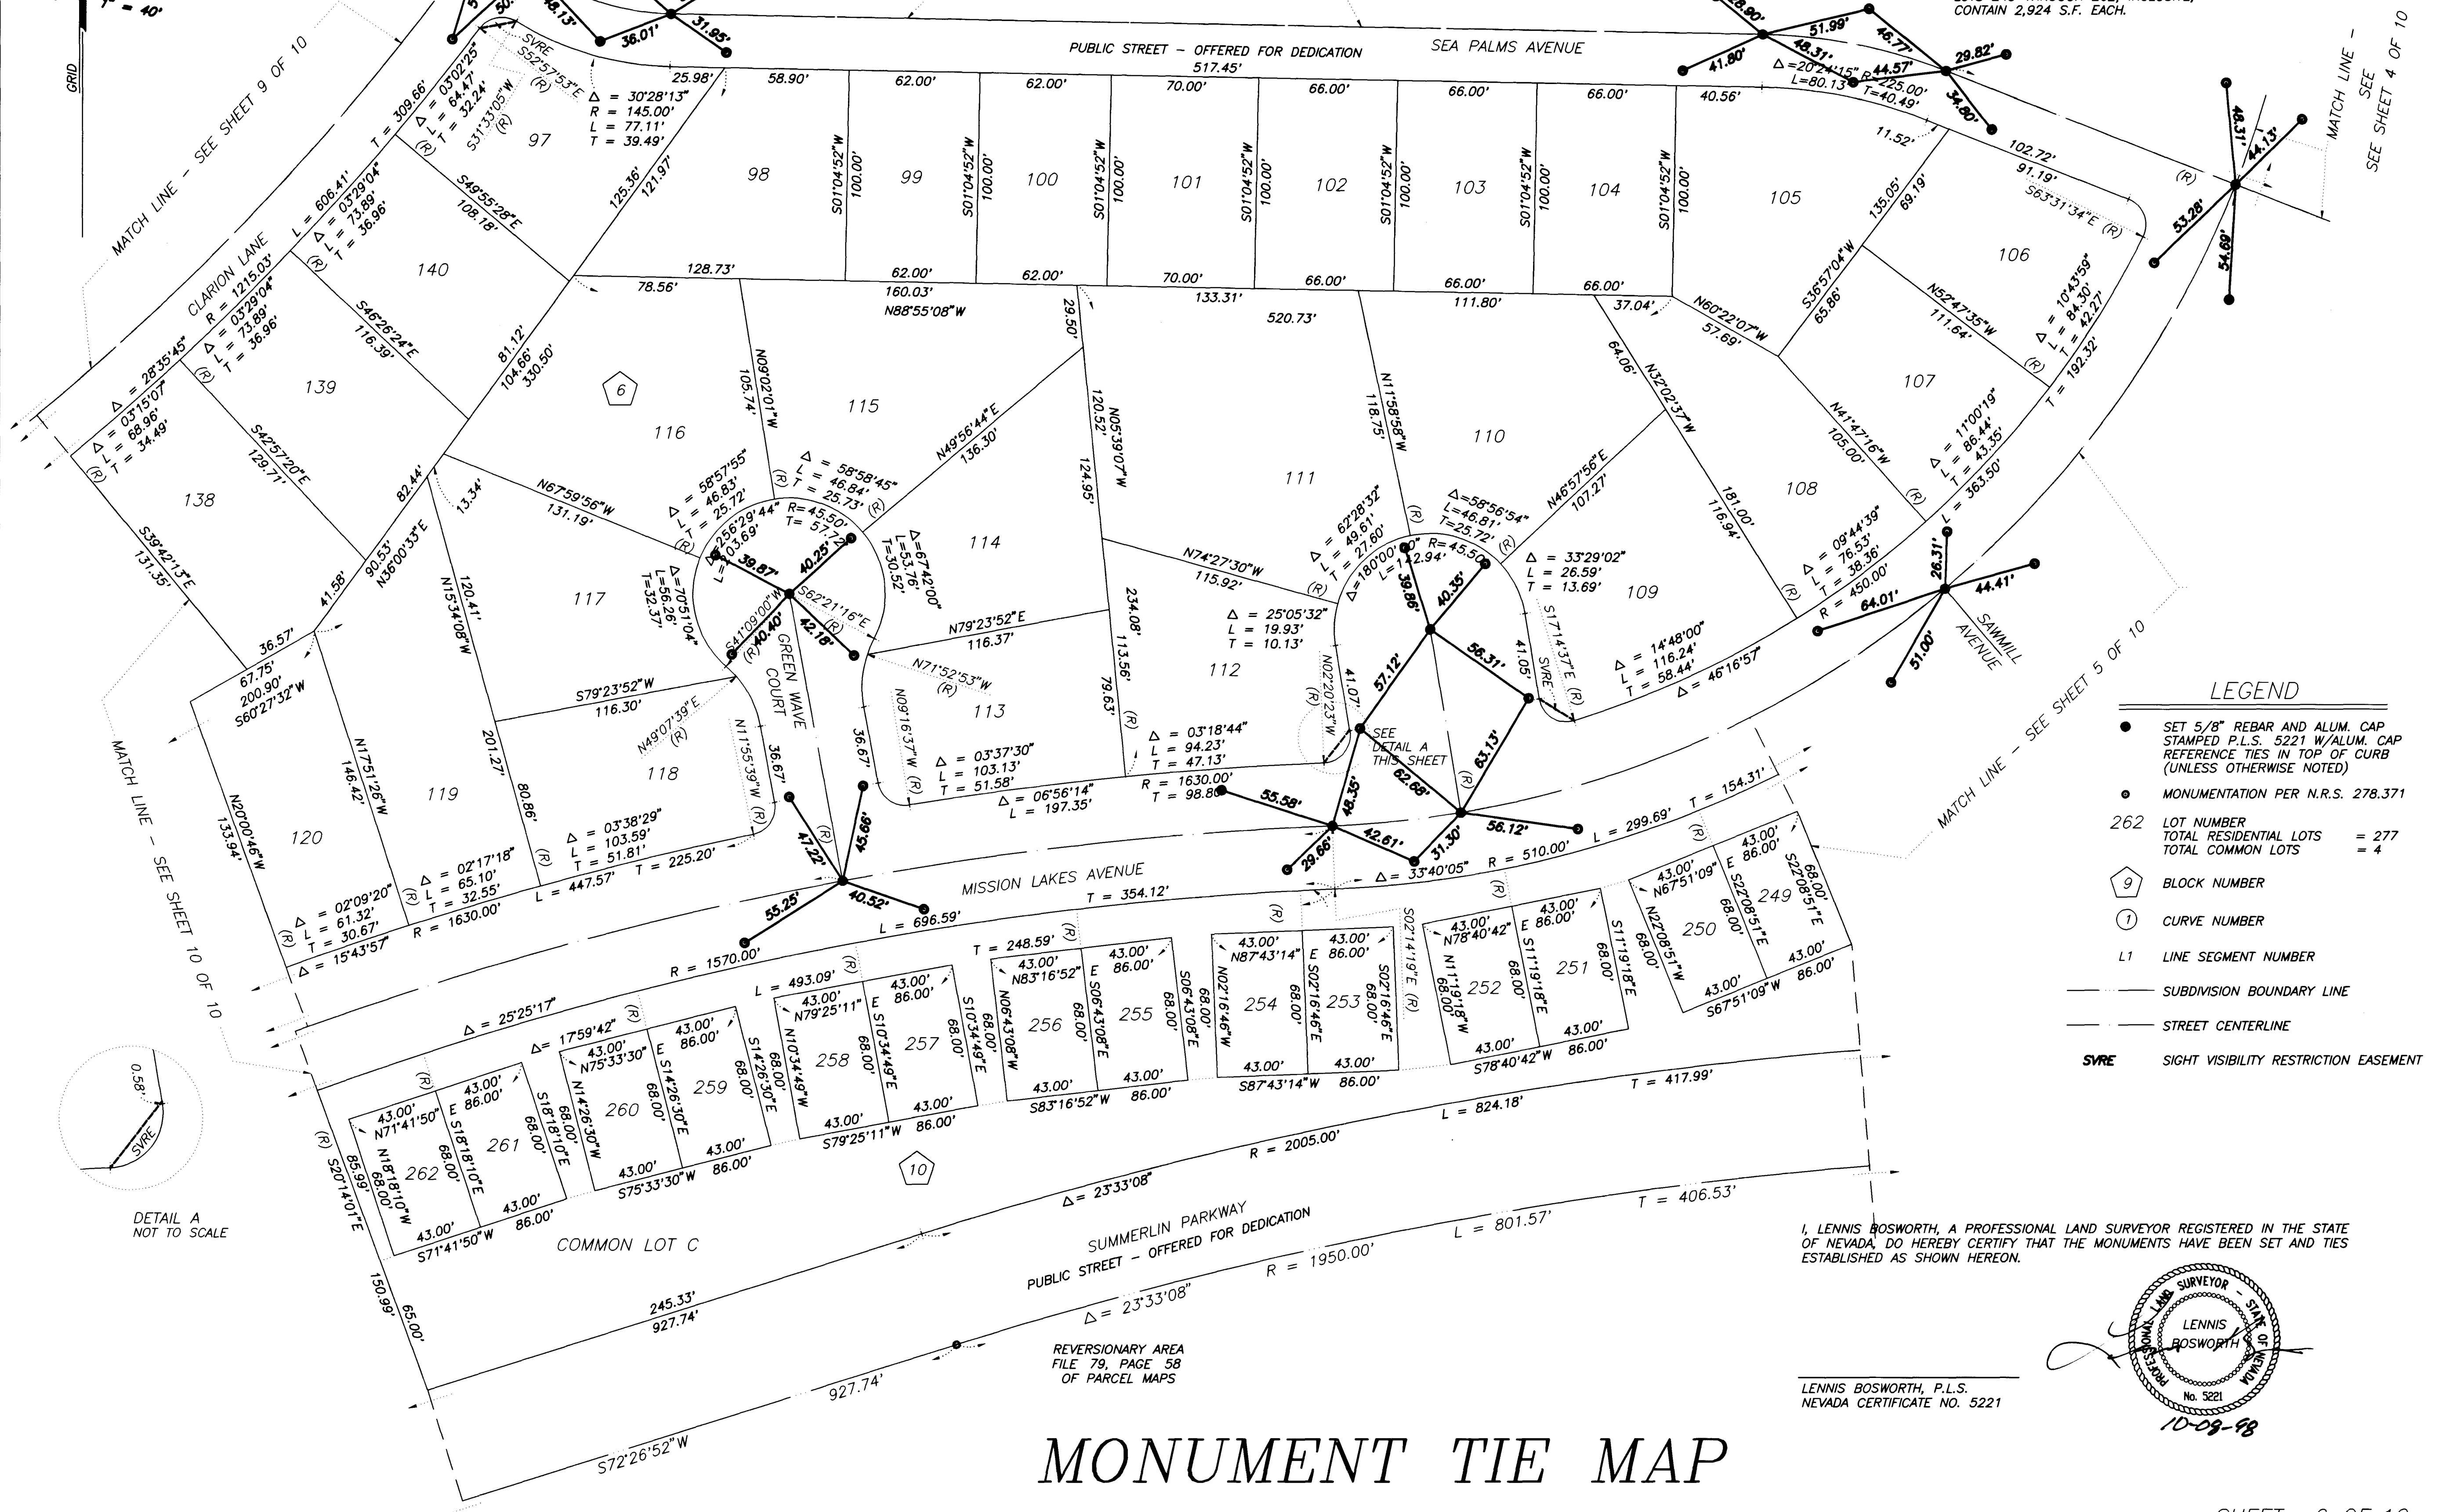

MONUMENT TIE MAP

SHEET 6 OF 10


Book 72 Page 76
058-4141-47

11011

FINAL MAP OF SUN CITY SUMMERLIN - UNIT NO. 47 AT LAS VEGAS

A PLANNED DEVELOPMENT AND COMMON INTEREST COMMUNITY


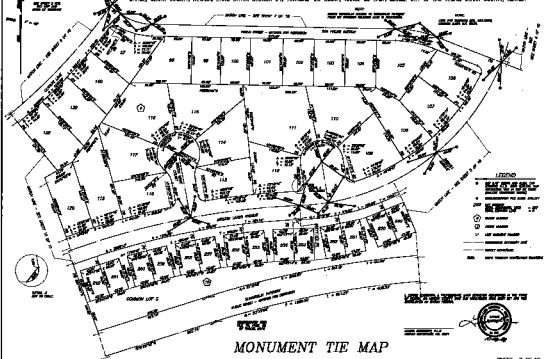

MONUMENT TIE MAP