


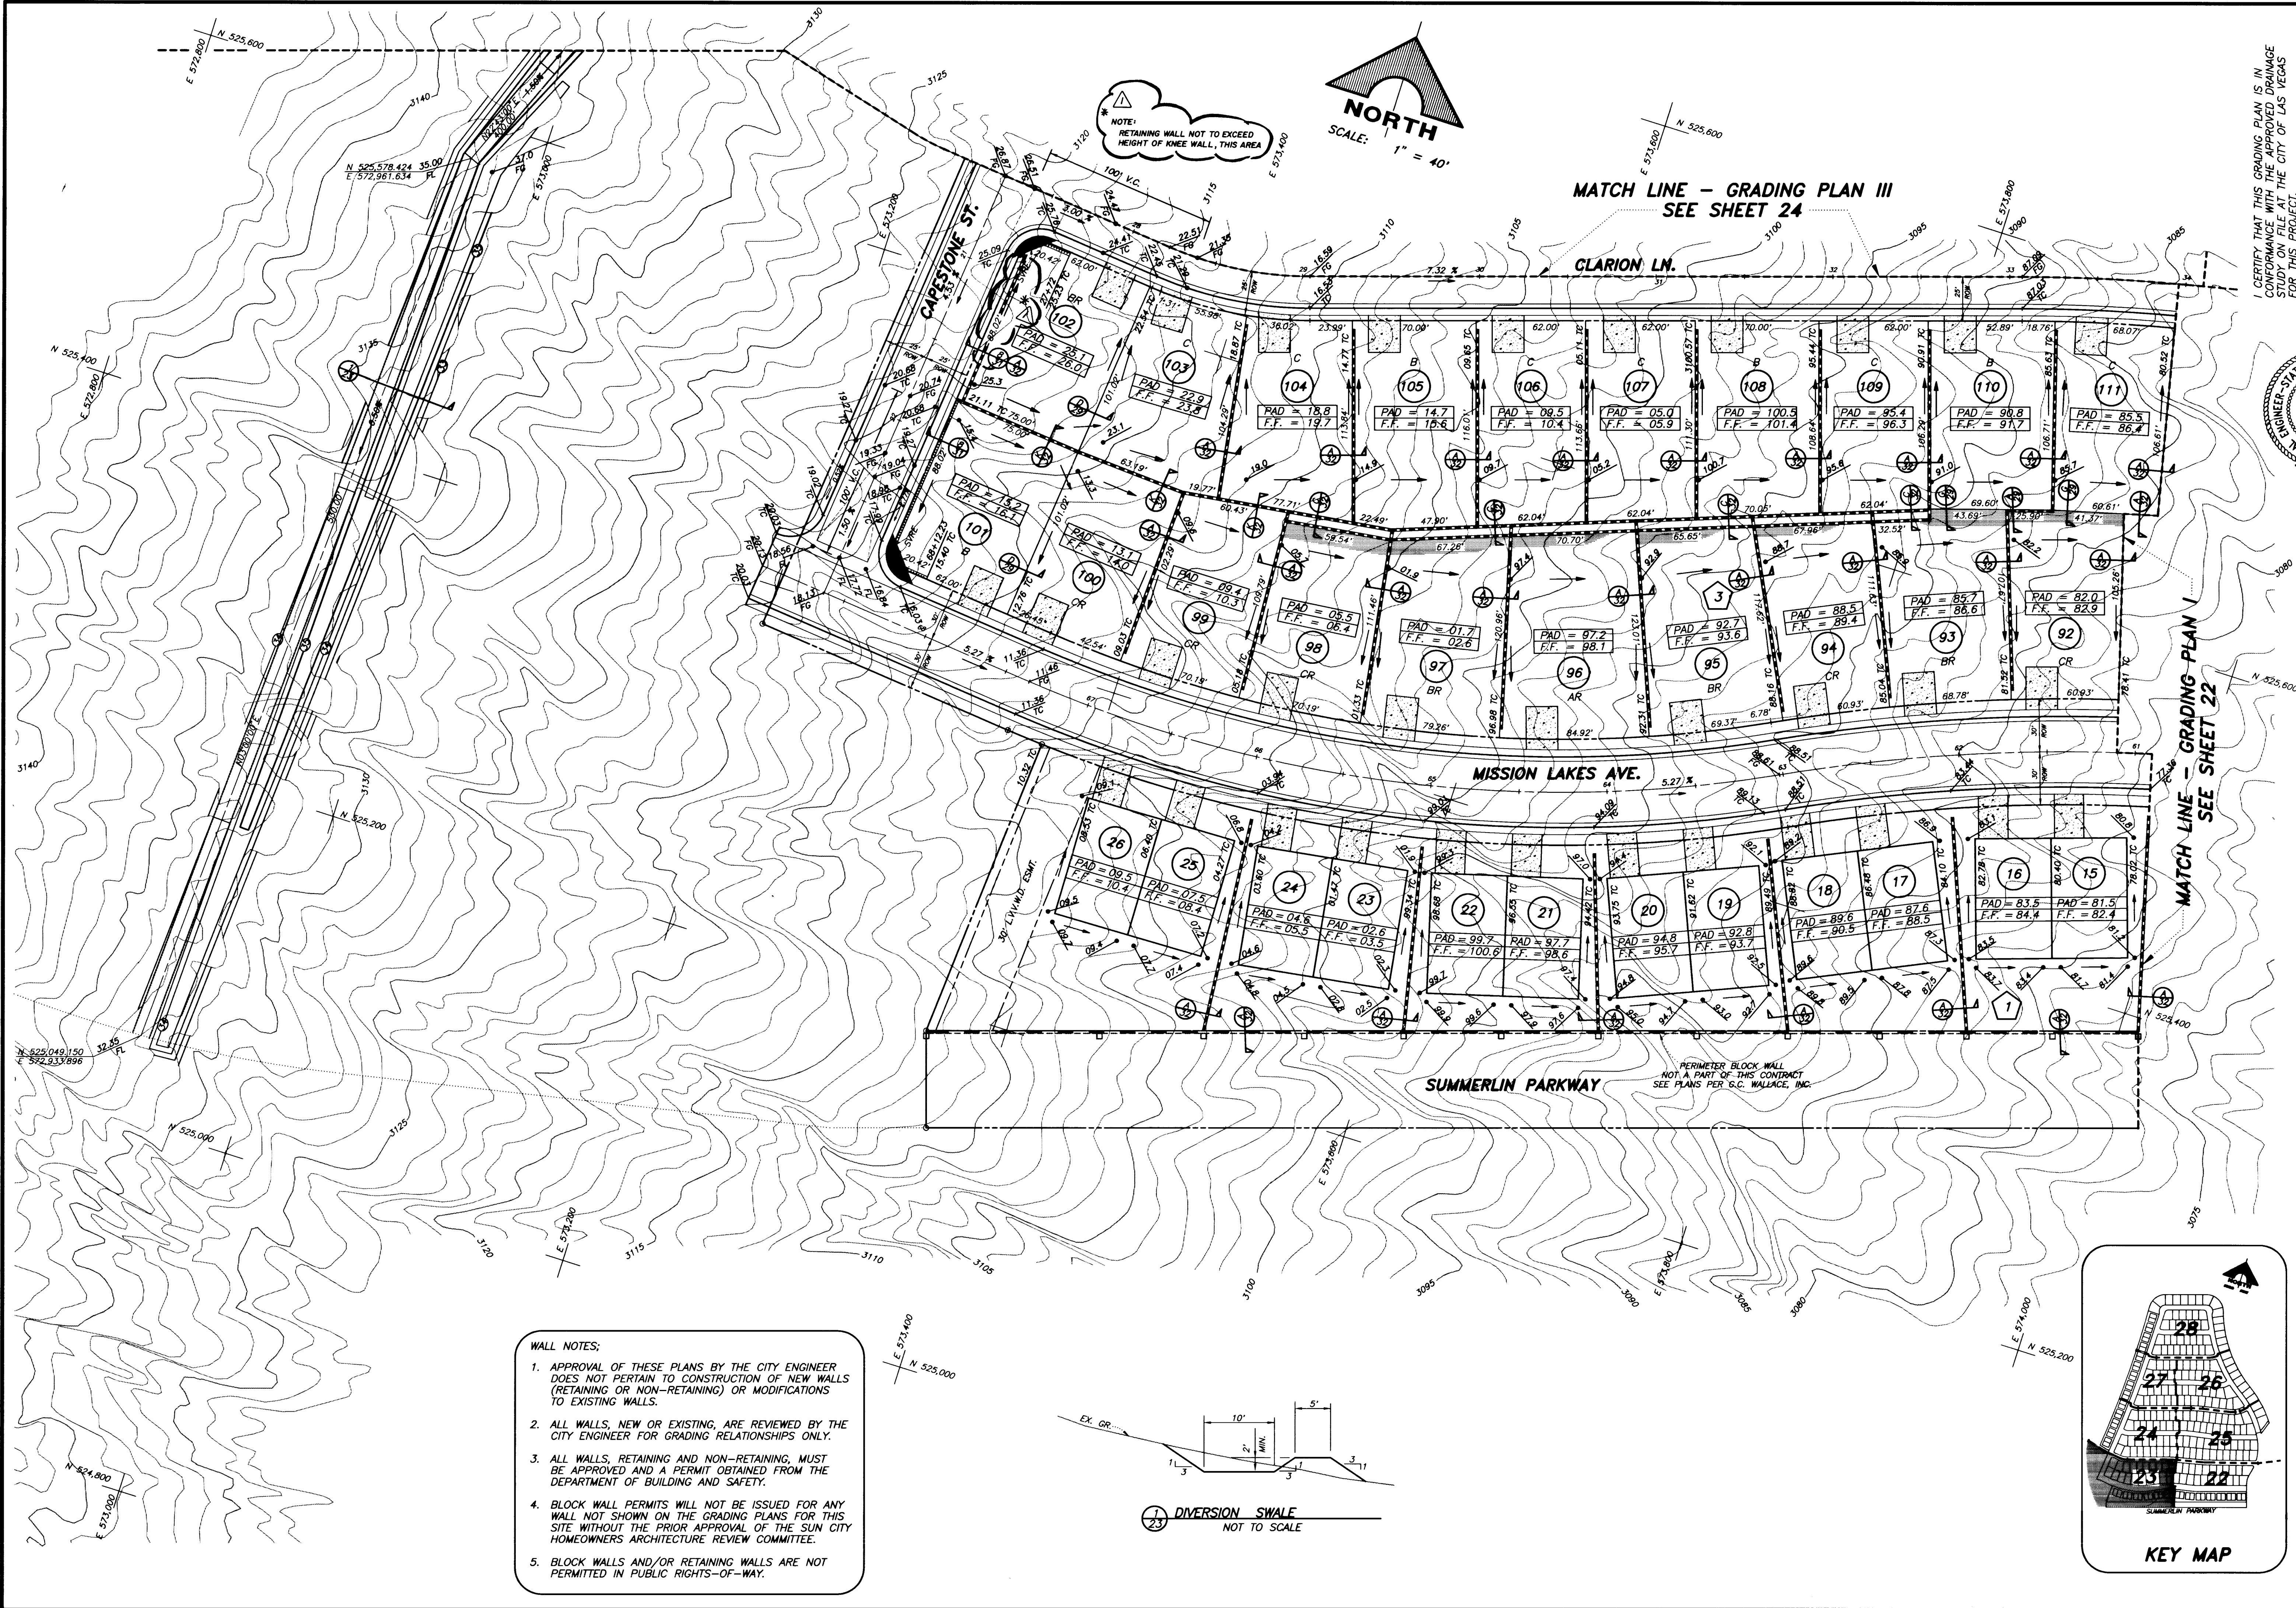


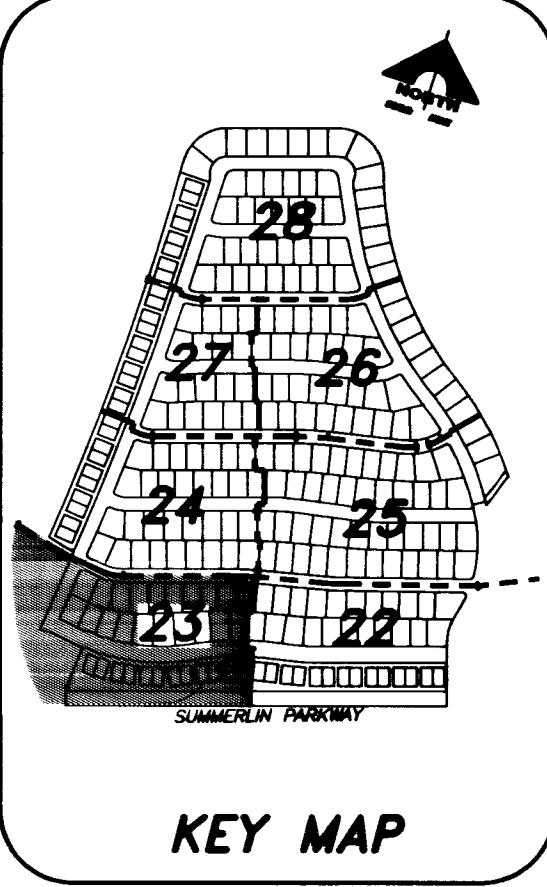

- WALL NOTES:**
1. APPROVAL OF THESE PLANS BY THE CITY ENGINEER DOES NOT PERTAIN TO CONSTRUCTION OF NEW WALLS (RETAINING OR NON-RETAINING) OR MODIFICATIONS TO EXISTING WALLS.
 2. ALL WALLS, NEW OR EXISTING, ARE REVIEWED BY THE CITY ENGINEER FOR GRADING RELATIONSHIPS ONLY.
 3. ALL WALLS, RETAINING AND NON-RETAINING, MUST BE APPROVED AND A PERMIT OBTAINED FROM THE DEPARTMENT OF BUILDING AND SAFETY.
 4. BLOCK WALL PERMITS WILL NOT BE ISSUED FOR ANY WALL NOT SHOWN ON THE GRADING PLANS FOR THIS SITE WITHOUT THE PRIOR APPROVAL OF THE SUN CITY HOMEOWNERS ARCHITECTURE REVIEW COMMITTEE.
 5. BLOCK WALLS AND/OR RETAINING WALLS ARE NOT PERMITTED IN PUBLIC RIGHTS-OF-WAY.

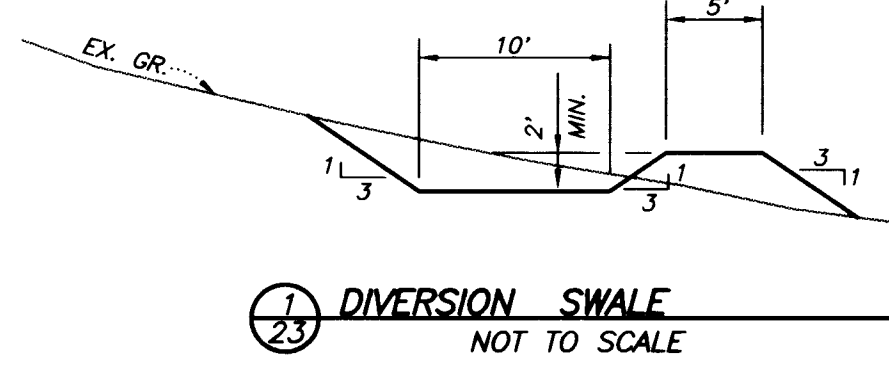

I CERTIFY THAT THIS GRADING PLAN IS IN CONFORMANCE WITH THE APPROVED DRAINAGE STUDY ON FILE AT THE CITY OF LAS VEGAS FOR THIS PROJECT.

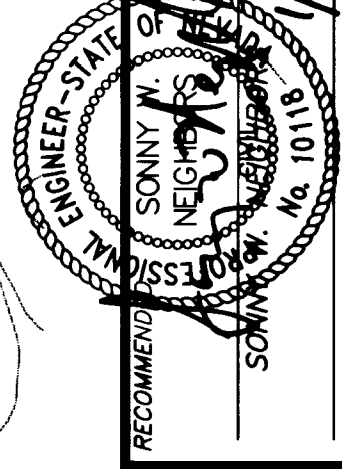

REV	DATE	DESCRIPTION	CL	DATE
1	01/05/98	FOR EXTENDED RT WALL - LOT 102		01/05/98

RECOMMENDED BY	DATE	REVIEWED BY	DATE
SONNY NECA	10/11/8	SONNY NECA	10/11/8

DEL WEBB COMMUNITIES, INC.	SUN CITY SUMMERLIN - UNIT NO. 49	G.C. WALLACE, INC.
GRADING PLAN II		Engineering/Architecture

SHEET	23
OF 32 SHEETS	

