


MONUMENT TIE MAP OF SYCAMORE RIDGE – UNIT 1

A PLANNED COMMUNITY AND COMMON INTEREST COMMUNITY
BEING A SUBDIVISION OF A PORTION OF LOT 3 IN BLOCK B OF "THE CROSSING AT SUMMERLIN
VILLAGE 8 – UNIT NO. 3" AS SHOWN BY MAP THEREOF ON FILE IN BOOK , PAGE OF PLATS
IN THE CLARK COUNTY RECORDER'S OFFICE, CLARK COUNTY, NEVADA, LYING WITHIN SECTION 25,
TOWNSHIP 20 SOUTH, RANGE 59 EAST, M.D.M., CITY OF LAS VEGAS, CLARK COUNTY, NEVADA


SURVEYOR'S CERTIFICATE

I, ROBERT S. MERCADO, A PROFESSIONAL LAND SURVEYOR REGISTERED IN THE
STATE OF NEVADA, DO HEREBY CERTIFY THAT THE TIE MONUMENTS HAVE BEEN
SET AND THE TIE DISTANCES ESTABLISHED AS SHOWN HEREON.
THIS SURVEY WAS COMPLETED ON APRIL 15, 1997

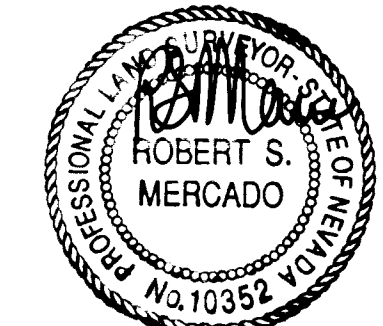

717197

ROBERT S. MERCADO
PROFESSIONAL LAND SURVEYOR
CERTIFICATE NO. 10352

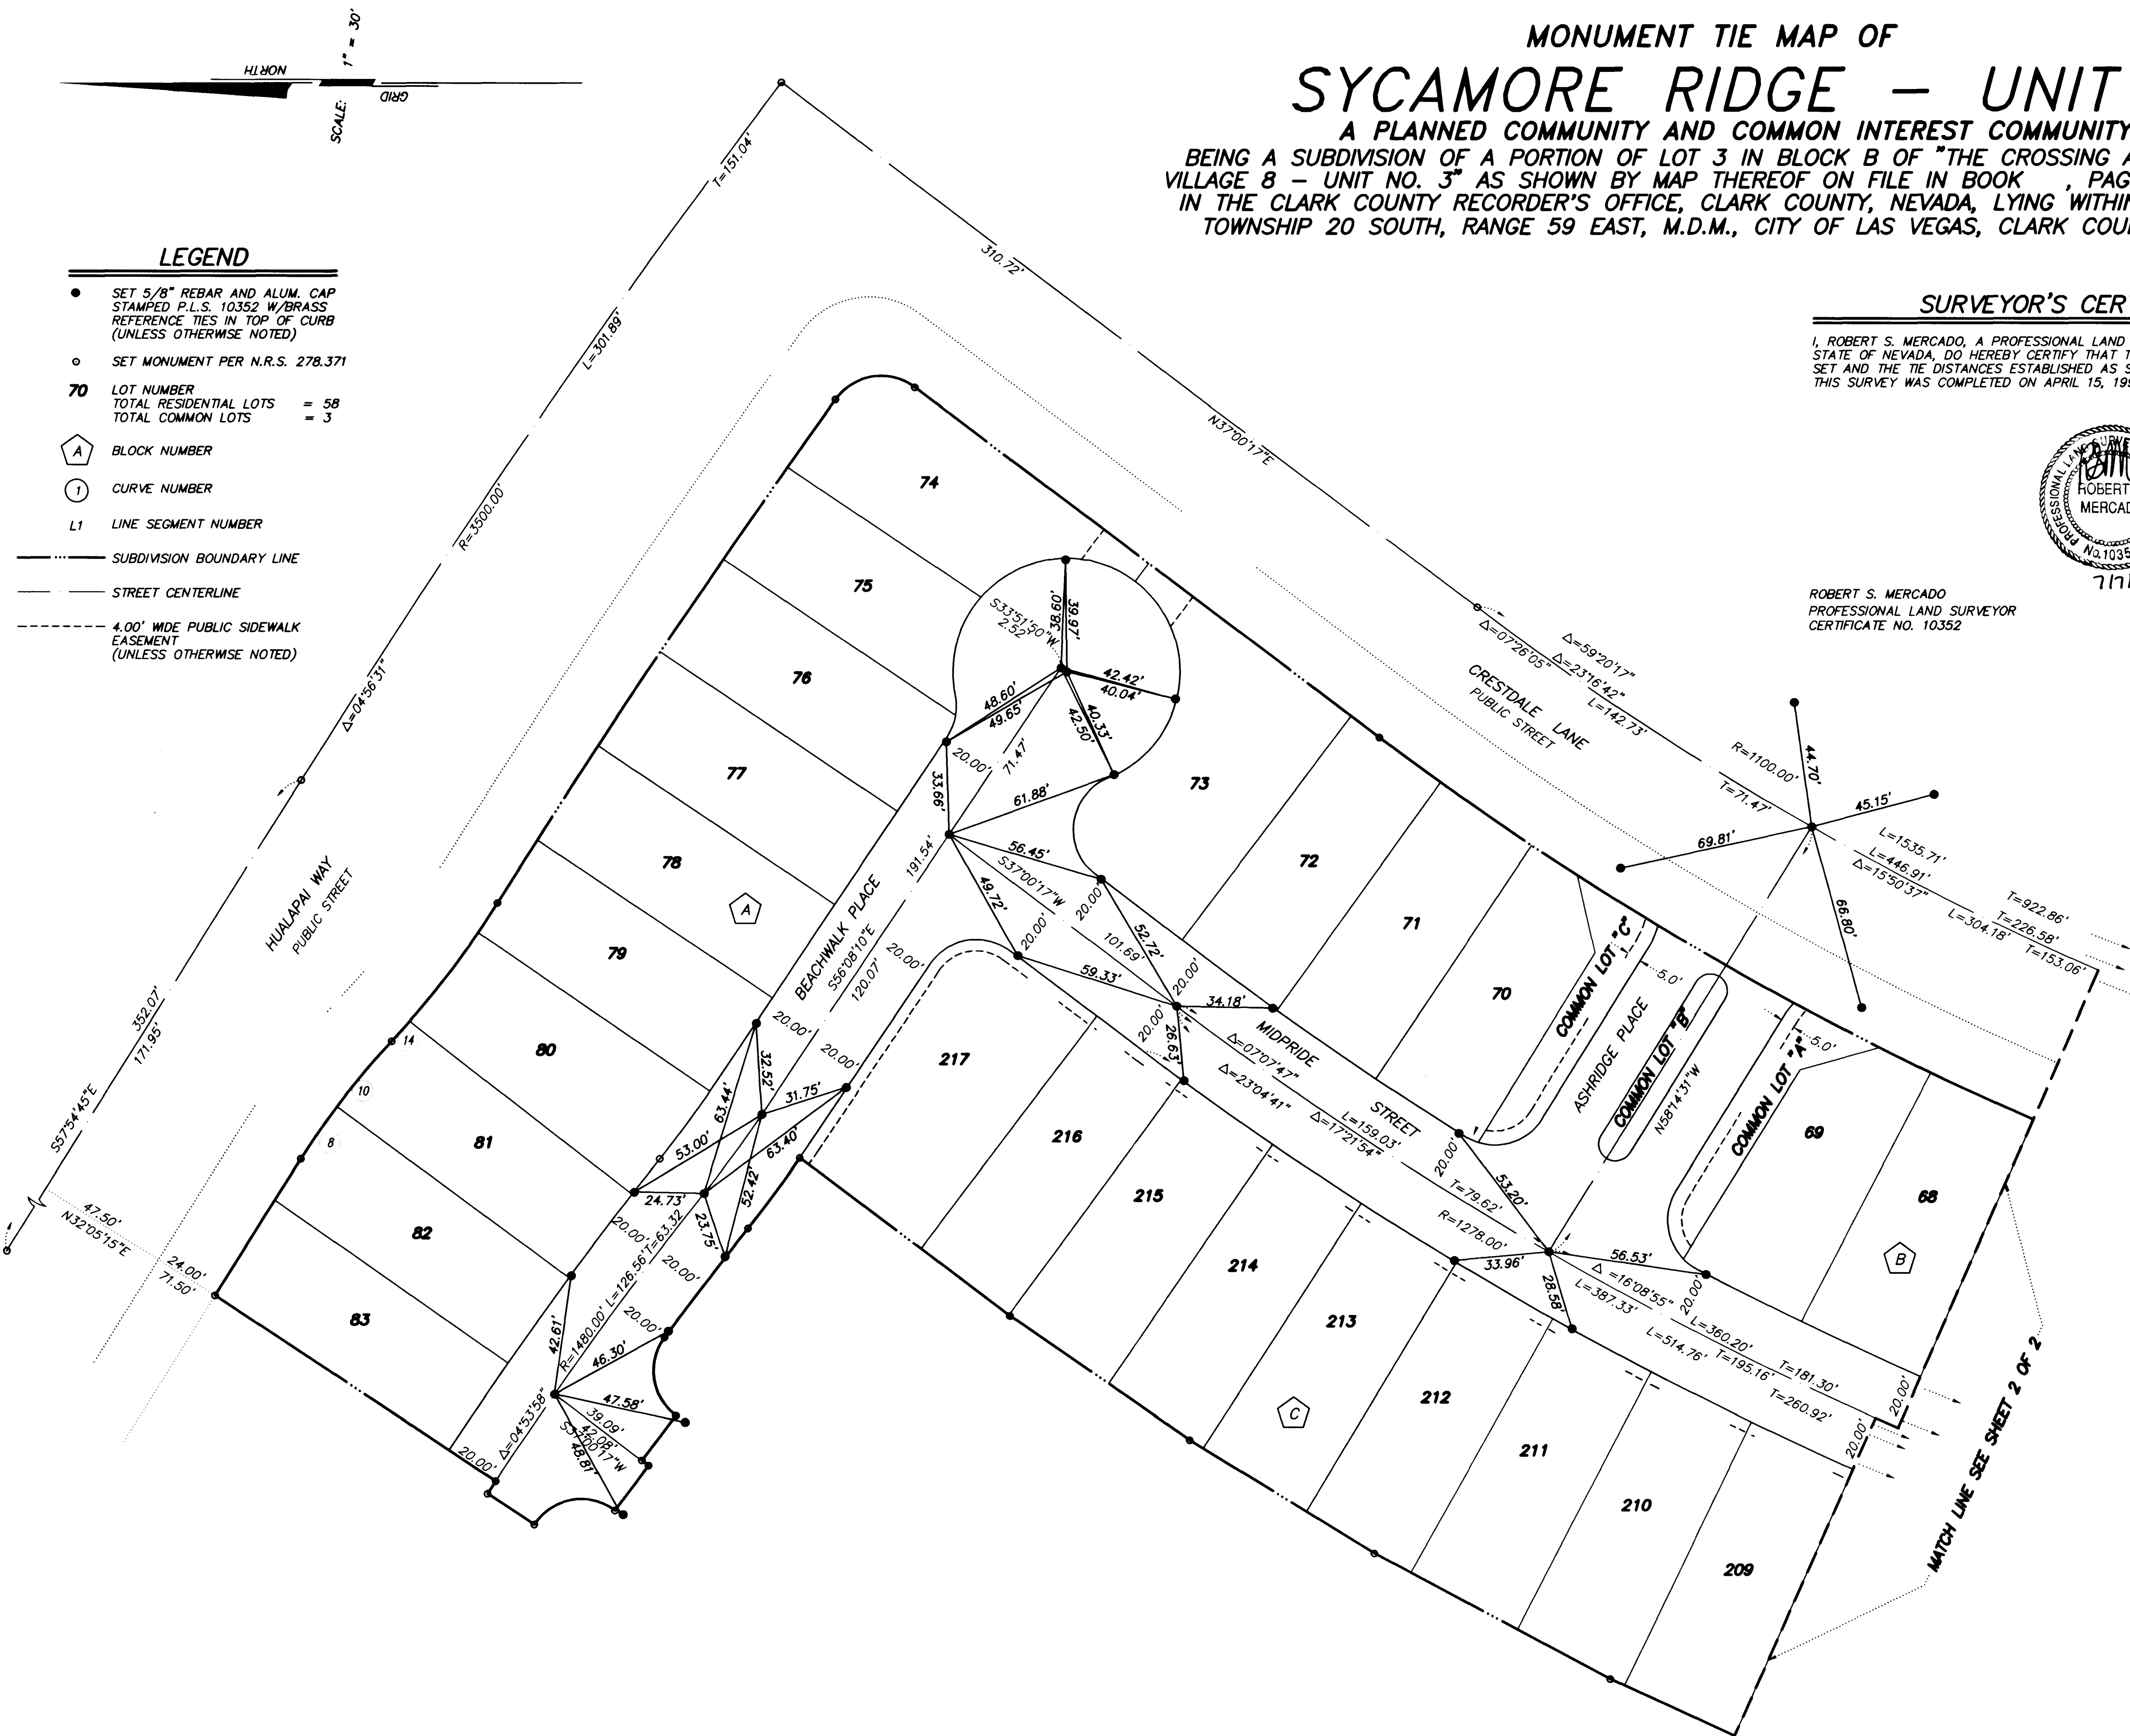

2-169

MONUMENT THE MAP OF SYCAMORE RIDGE - UNIT 1

A PLANNED COMMUNITY AND COMMON INTEREST COMMUNITY

SURVEYOR'S CERTIFICATE





LEGEND

