
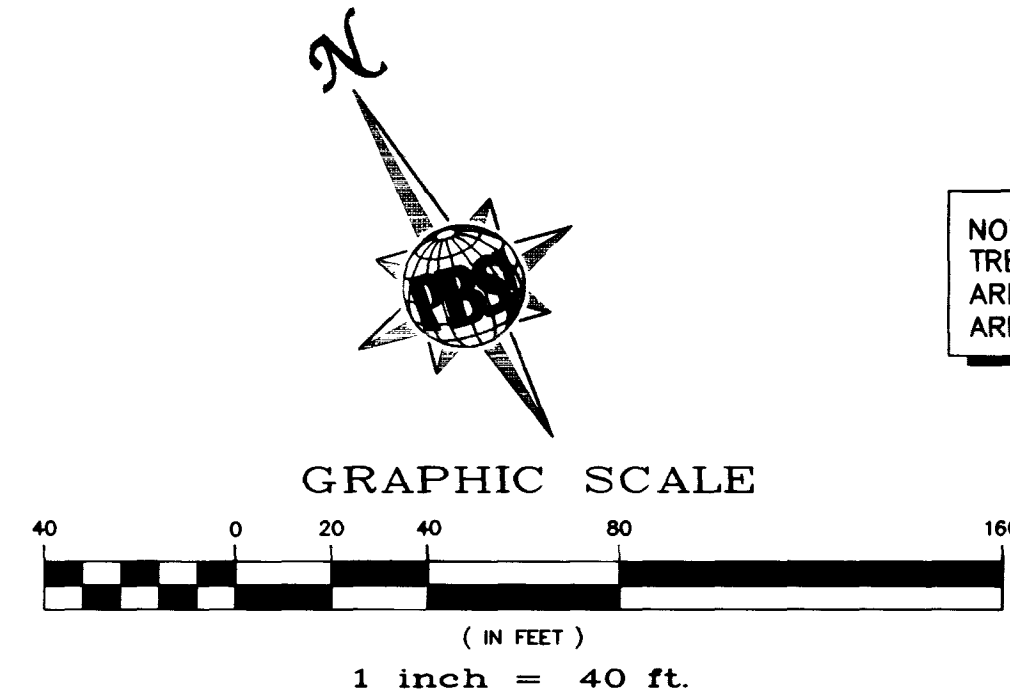


Call before you Dig
1-800-227-2600


Call before you Overhead
1-702-593-6111
Safety Services Department

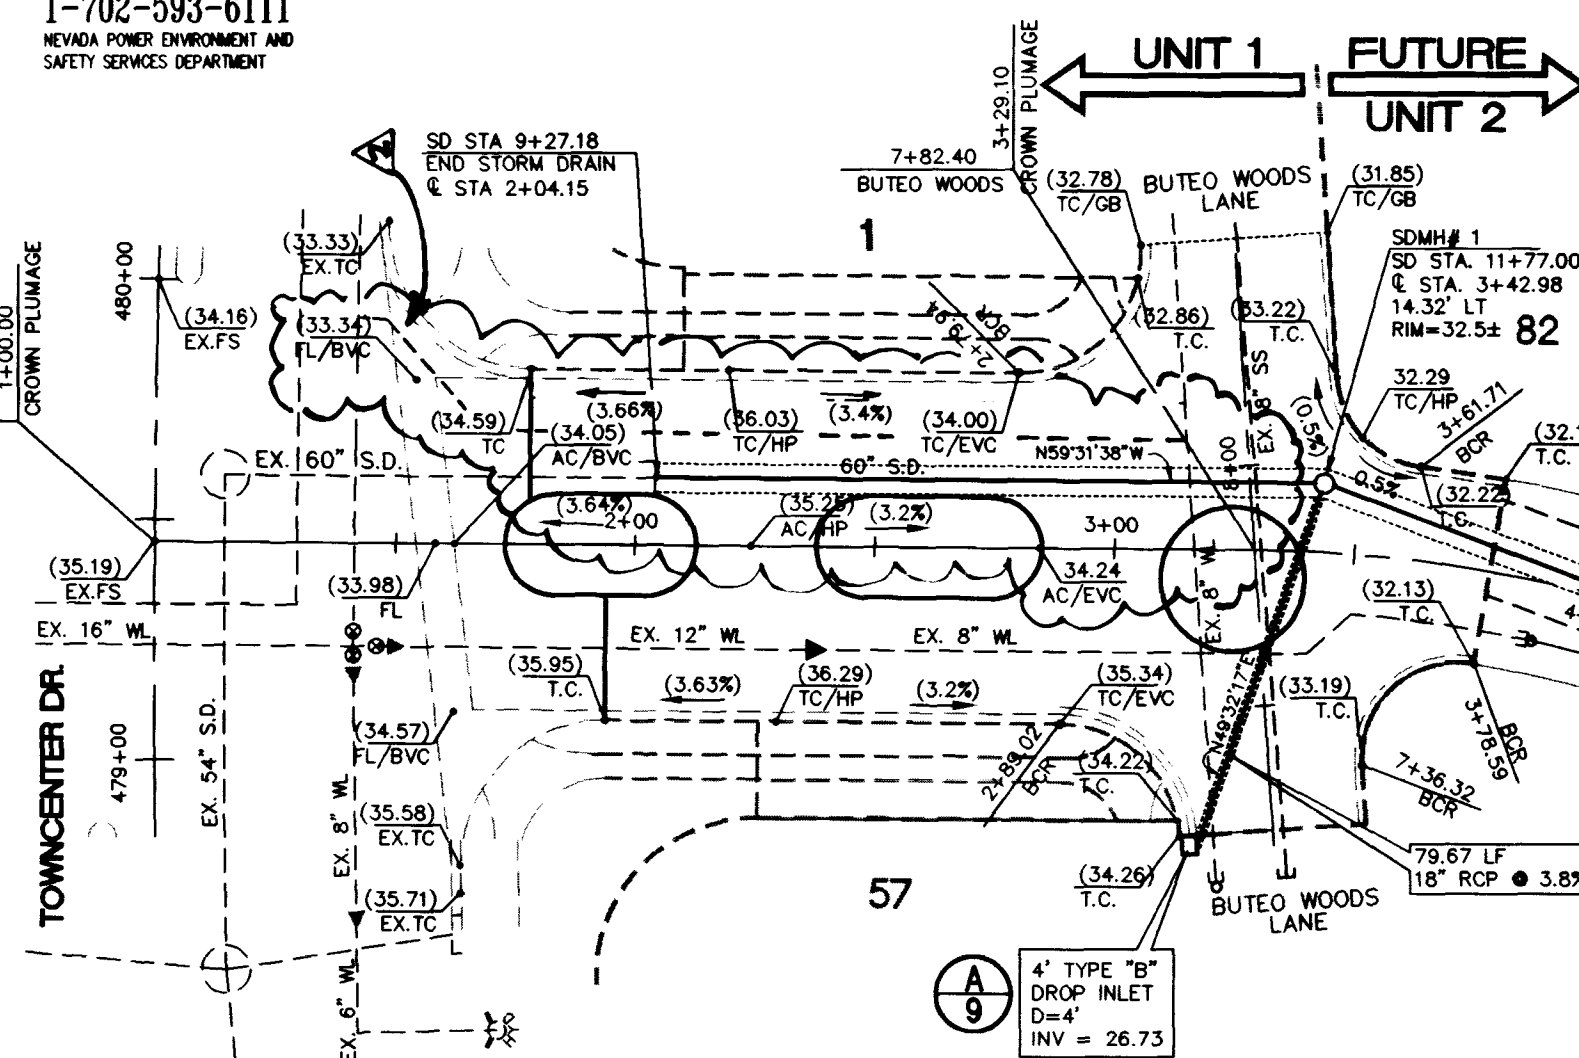


NOTE:
TRENCH BACKFILL UNPAVED
AREAS PER CLARK COUNTY
AREA STD. DWG. No. 502

BENCHMARK
CHISELED "+" IN THE TOP OF CURB AT END OF CURB
ON WEST SIDE OF DURANGO, 250 FT. SOUTH OF WESTCLIFF.
ELEV. PER CITY OF LAS VEGAS DATUM = 2610.16

LEGEND
() EXISTING PER UNIT 1 CONSTRUCTION
[] FUTURE PER UNIT 2 CONSTRUCTION

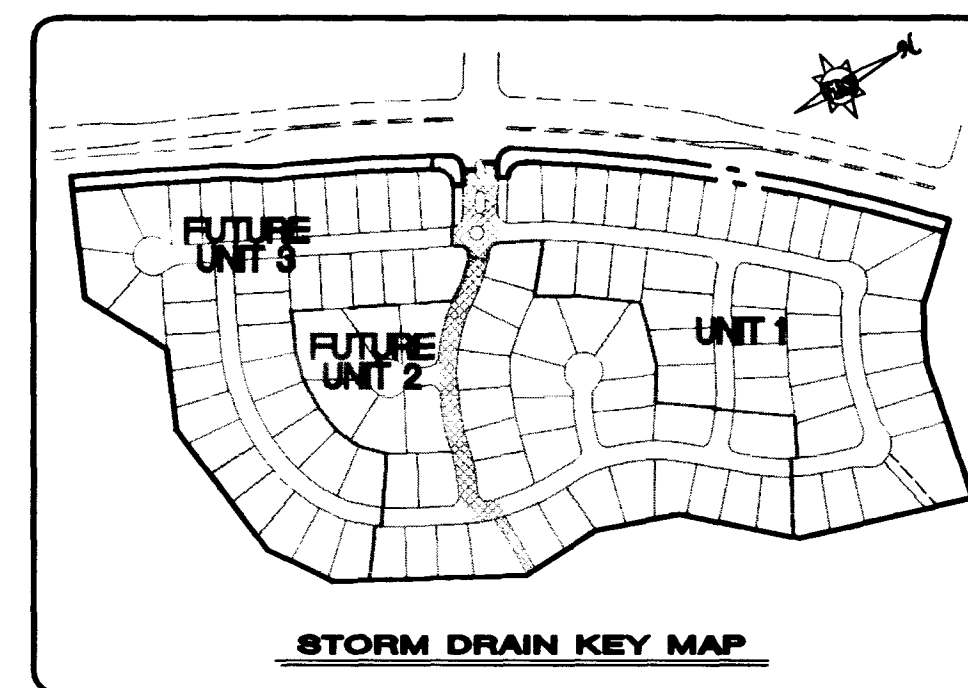

(CROWN PLUMAGE PLACE)
STORM DRAIN - PLAN VIEW
HORIZONTAL SCALE: 1" = 40'

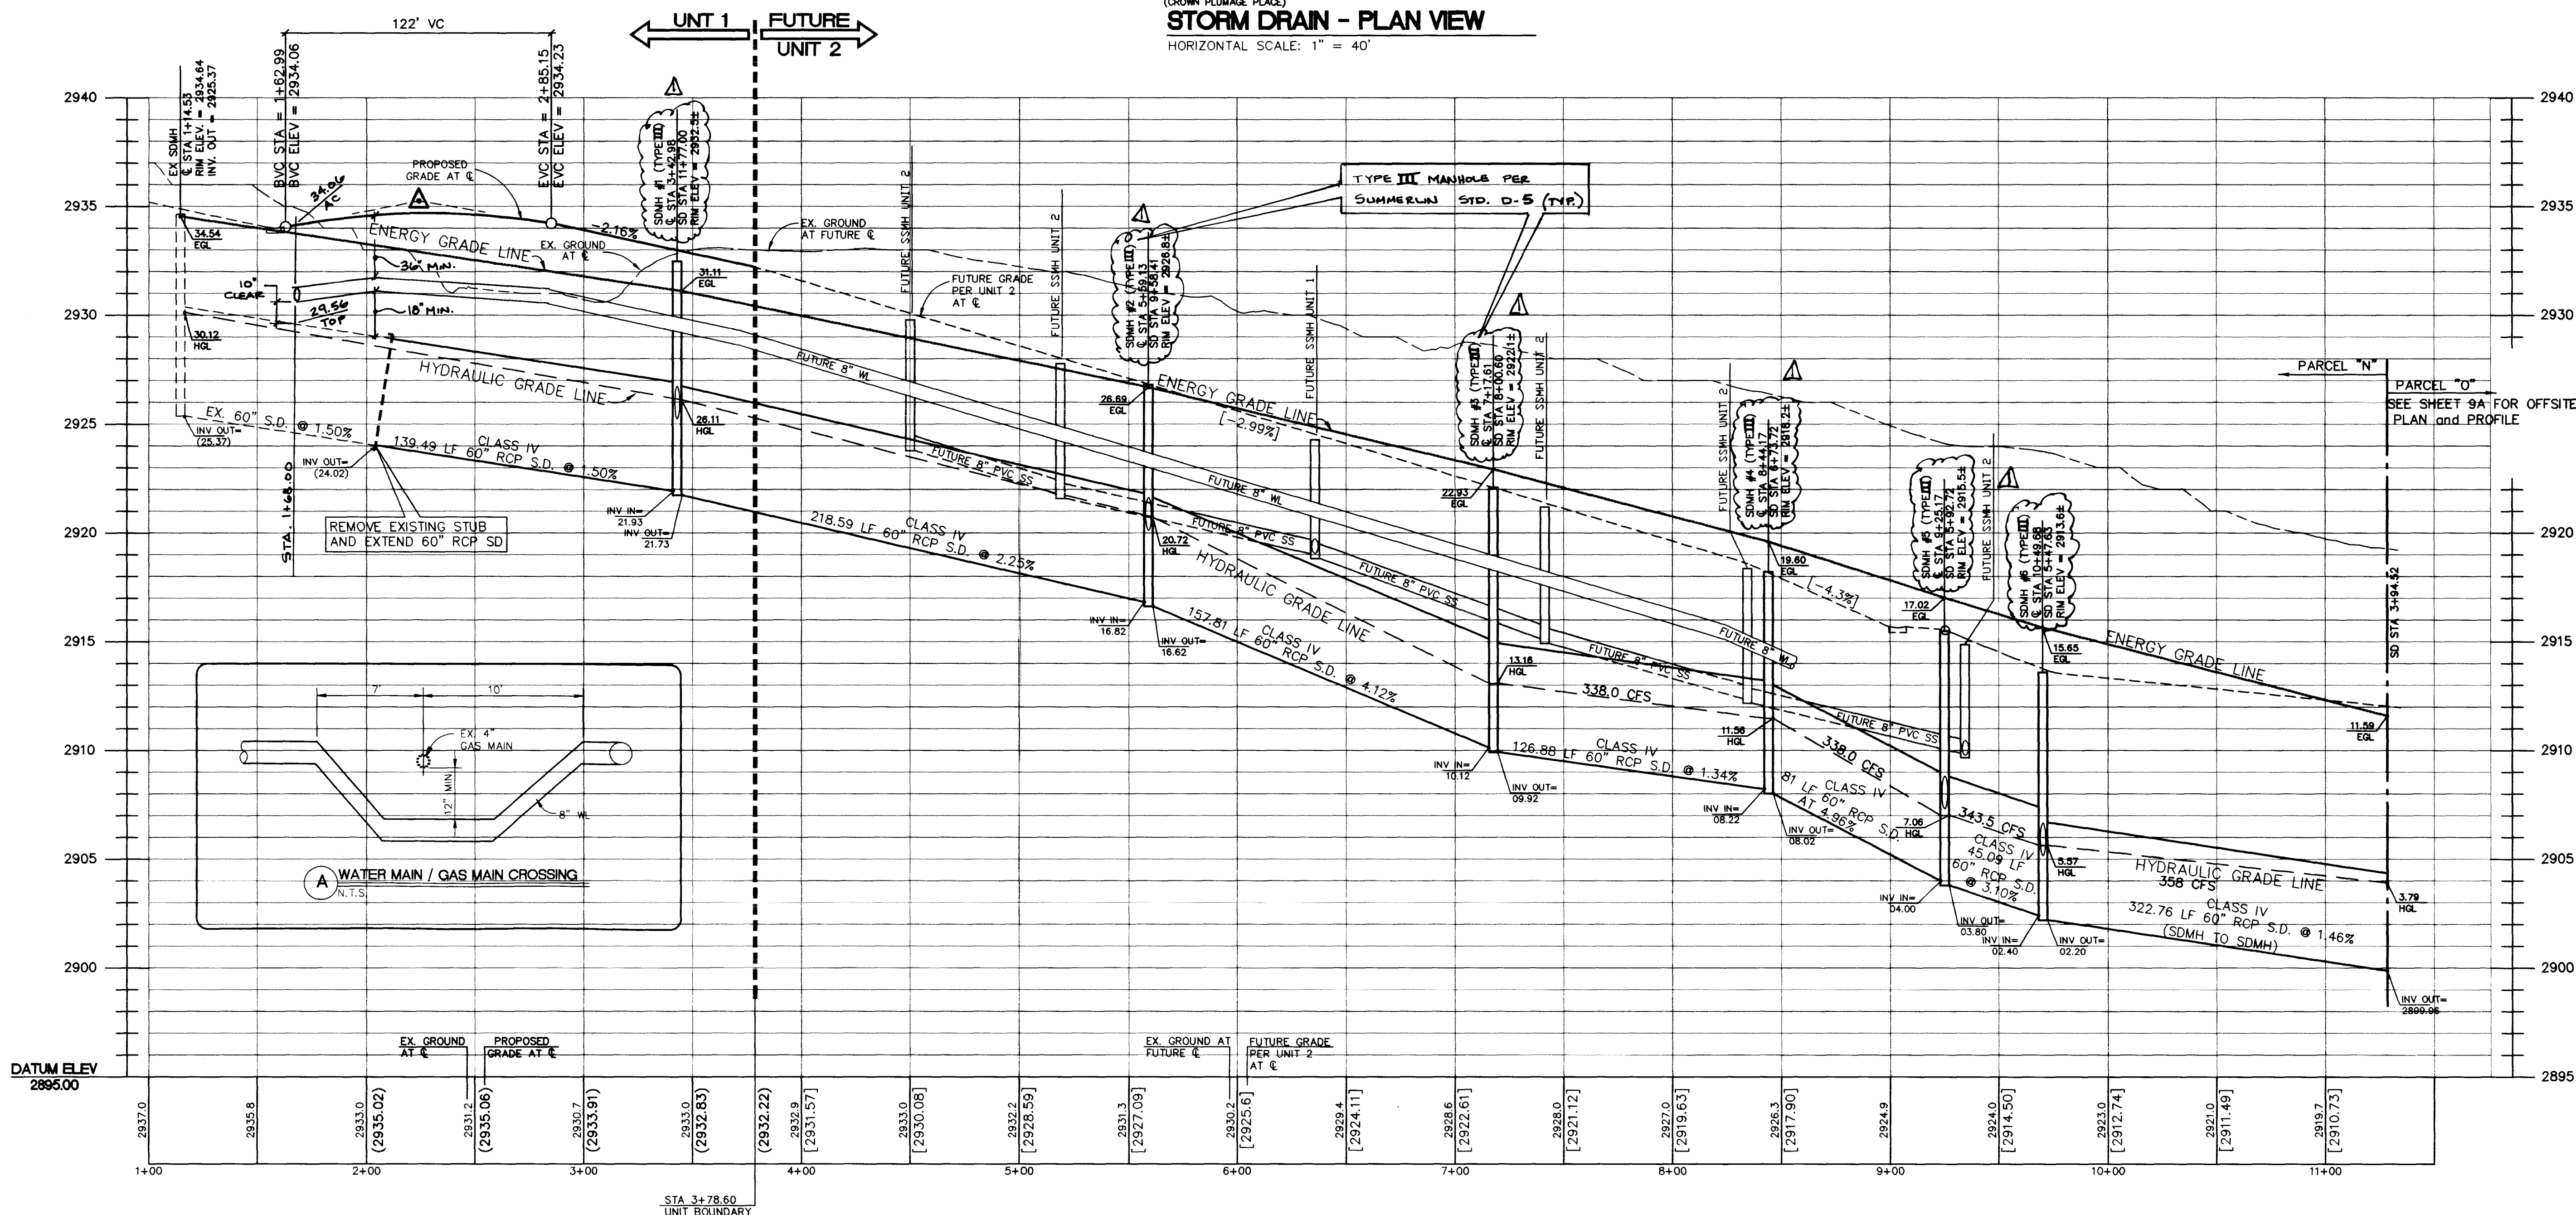

NOTE:
SEE SHEET 9 FOR
18" SD LATERAL PROFILES

[Signature]
2/11/97
ENGINEER'S SEAL

STORM DRAIN - PROFILE
HORIZONTAL SCALE: 1" = 40'
VERTICAL SCALE: 1" = 4'

C:\DWG5\B7B\B7B1-08 P17 Feb 14 13:18:13 1997 P.B.S. & J. - RICK

J.M. PETERS NEVADA		OFF SITE 60" STORM DRAIN PLAN AND PROFILE		Scale 1" = 40'	Drawn by RAM	Checked by MCP	File No. 878MP	Date OCT 96	Plot Date
POST, BUCKLEY, SCHULZ & BERGAN 901 N. Green Valley Pkwy. Suite 100 North Las Vegas, NV 89044 Telephone: 702/263-7275 Fax: 702/263-7260		REVISIONS		No.	Date		Appr.		Date
327X-4492-1

