


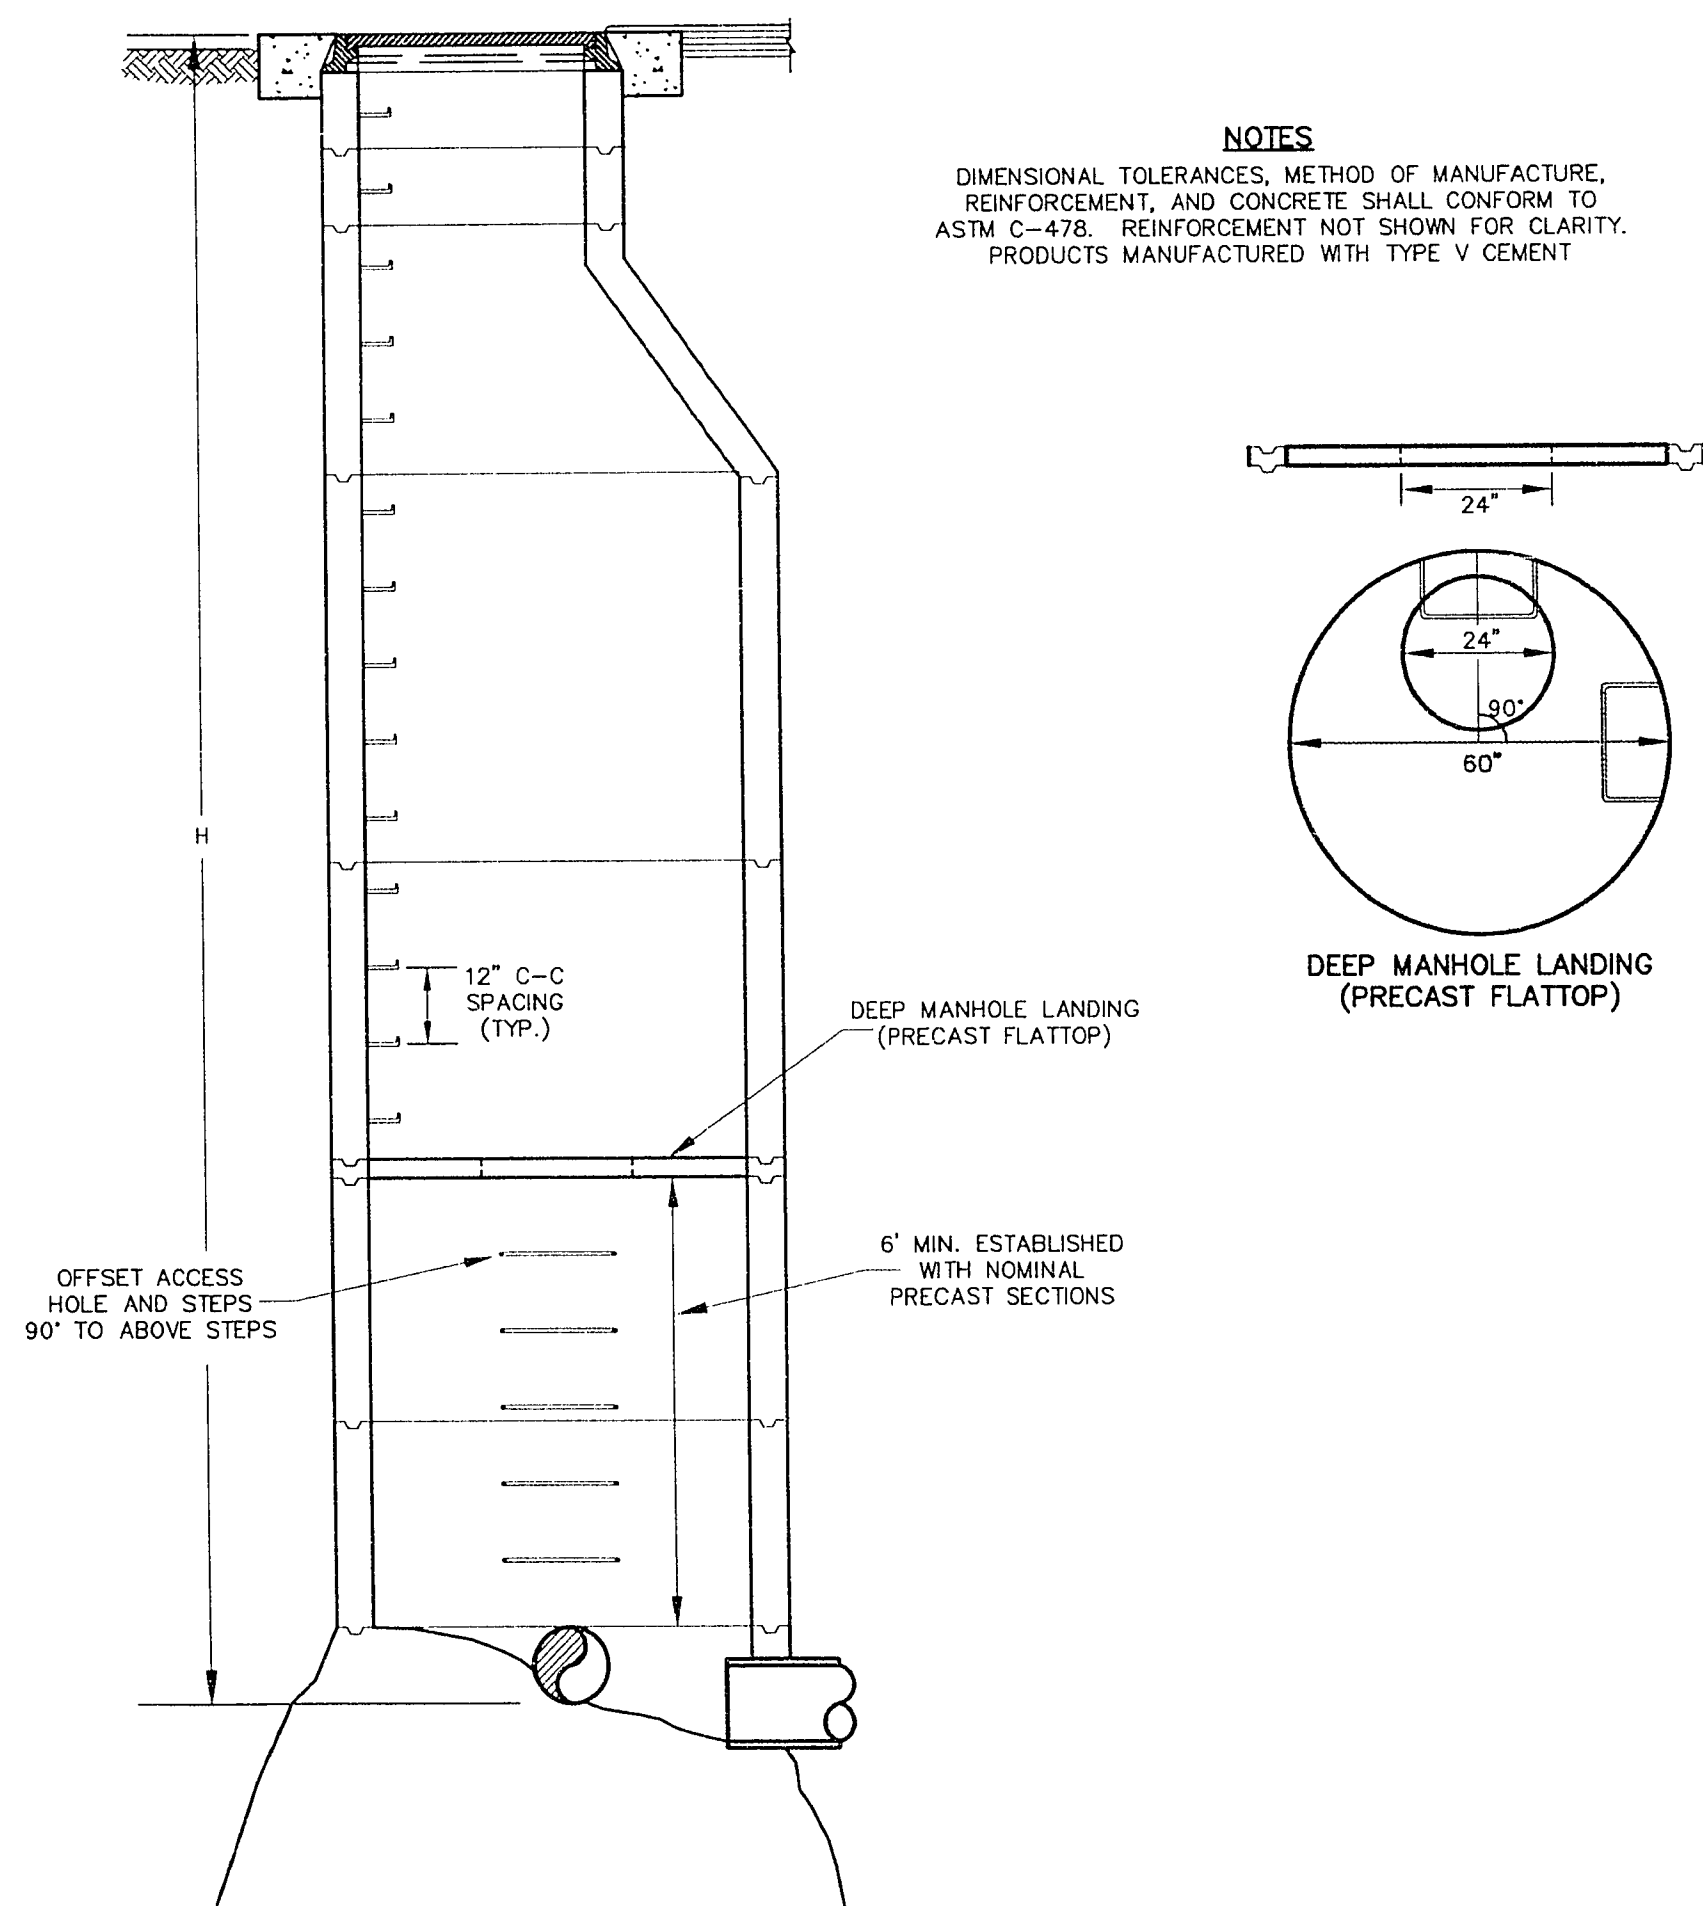


DEEP MANHOLE LANDING DETAIL (H ≥ 18')

NOT TO SCALE

B

13

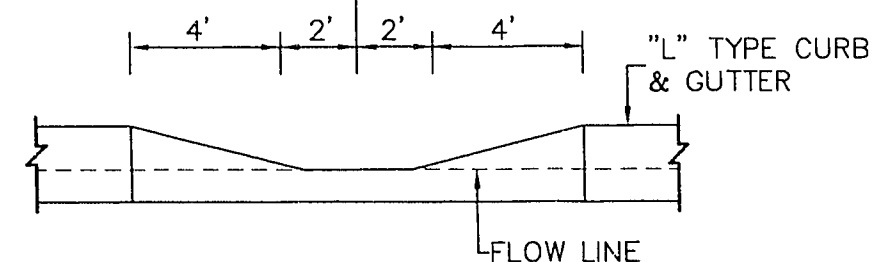


REFER TO SUMMERLIN
DETAIL (S-79) FOR
CURB DEPRESSION

DEPRESSED CURB DETAIL

NOT TO SCALE

A

13

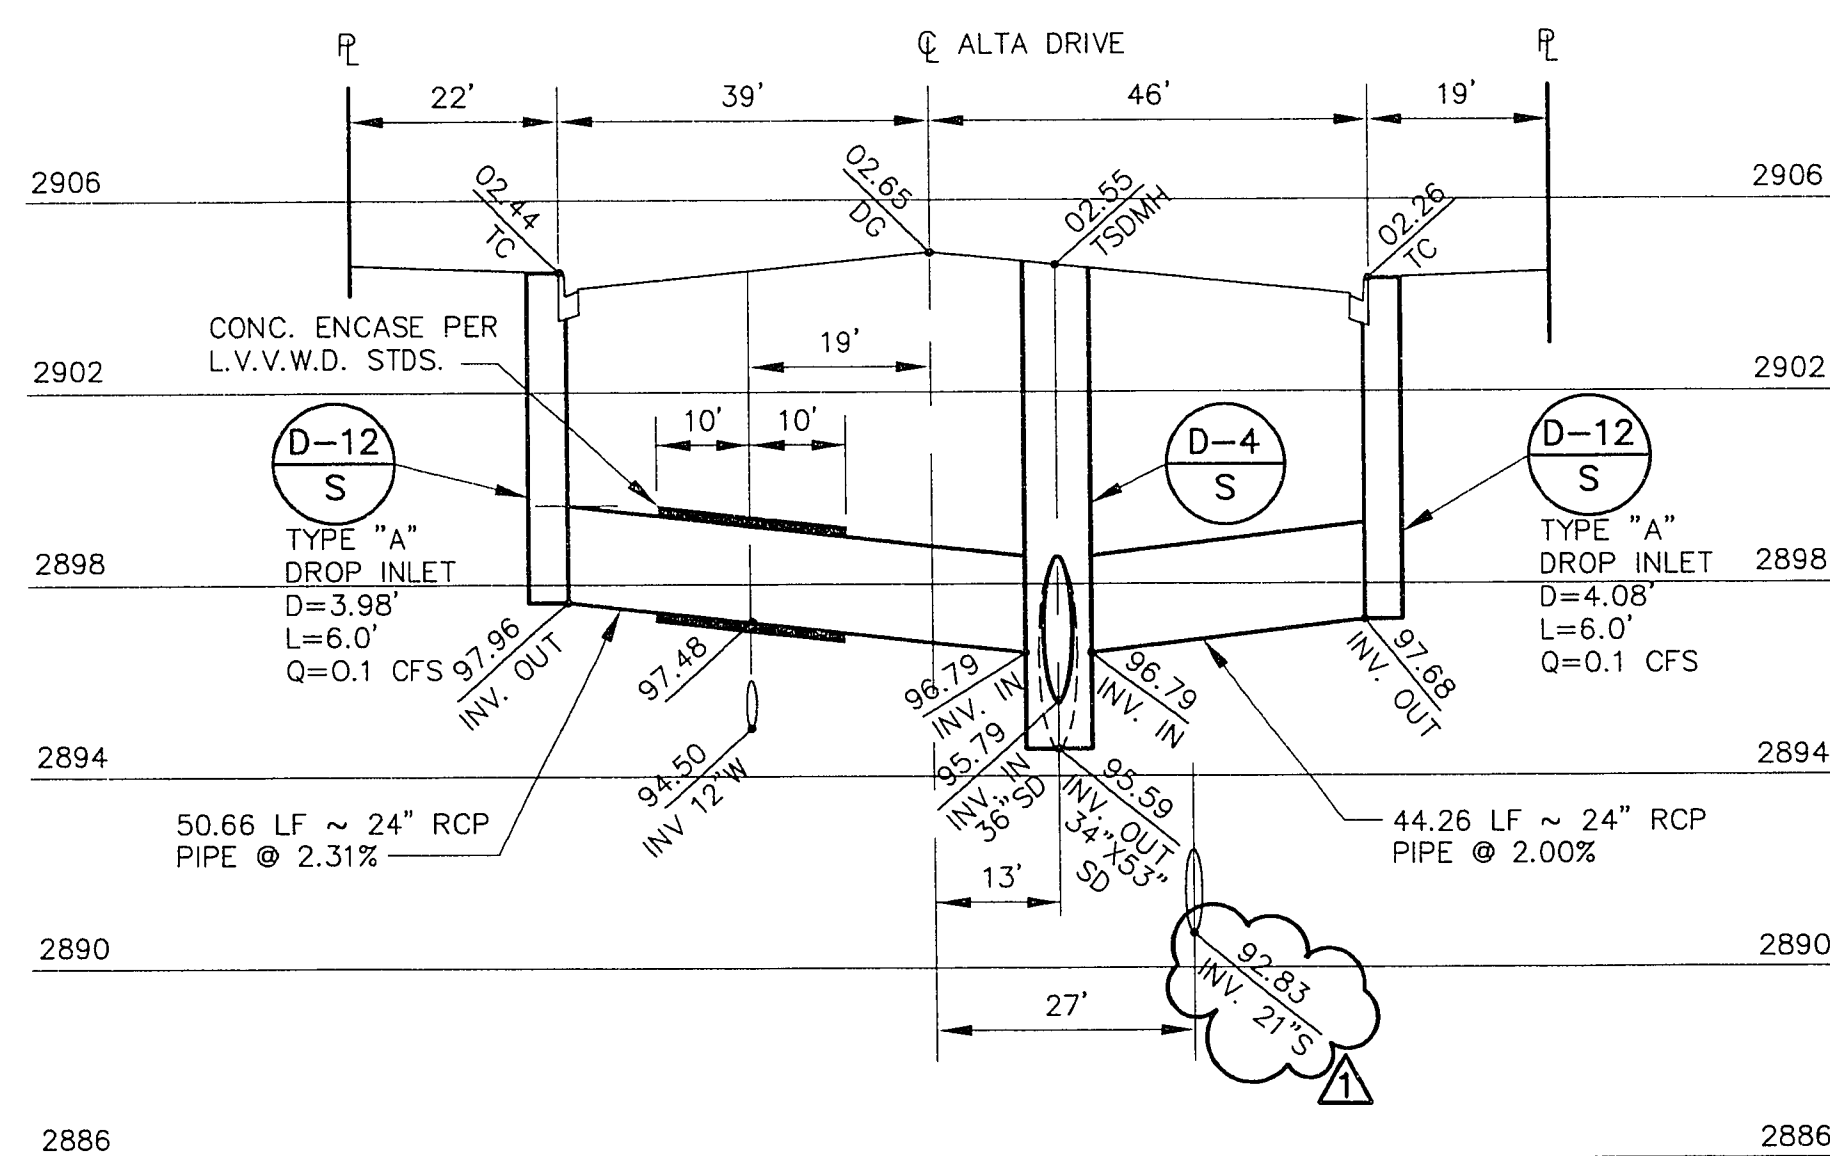


568+16.70 - ALTA DRIVE

S. D. LATERAL PROFILE

SCALE: HORIZ. 1" = 20'
VERT. 1" = 4'

5

13

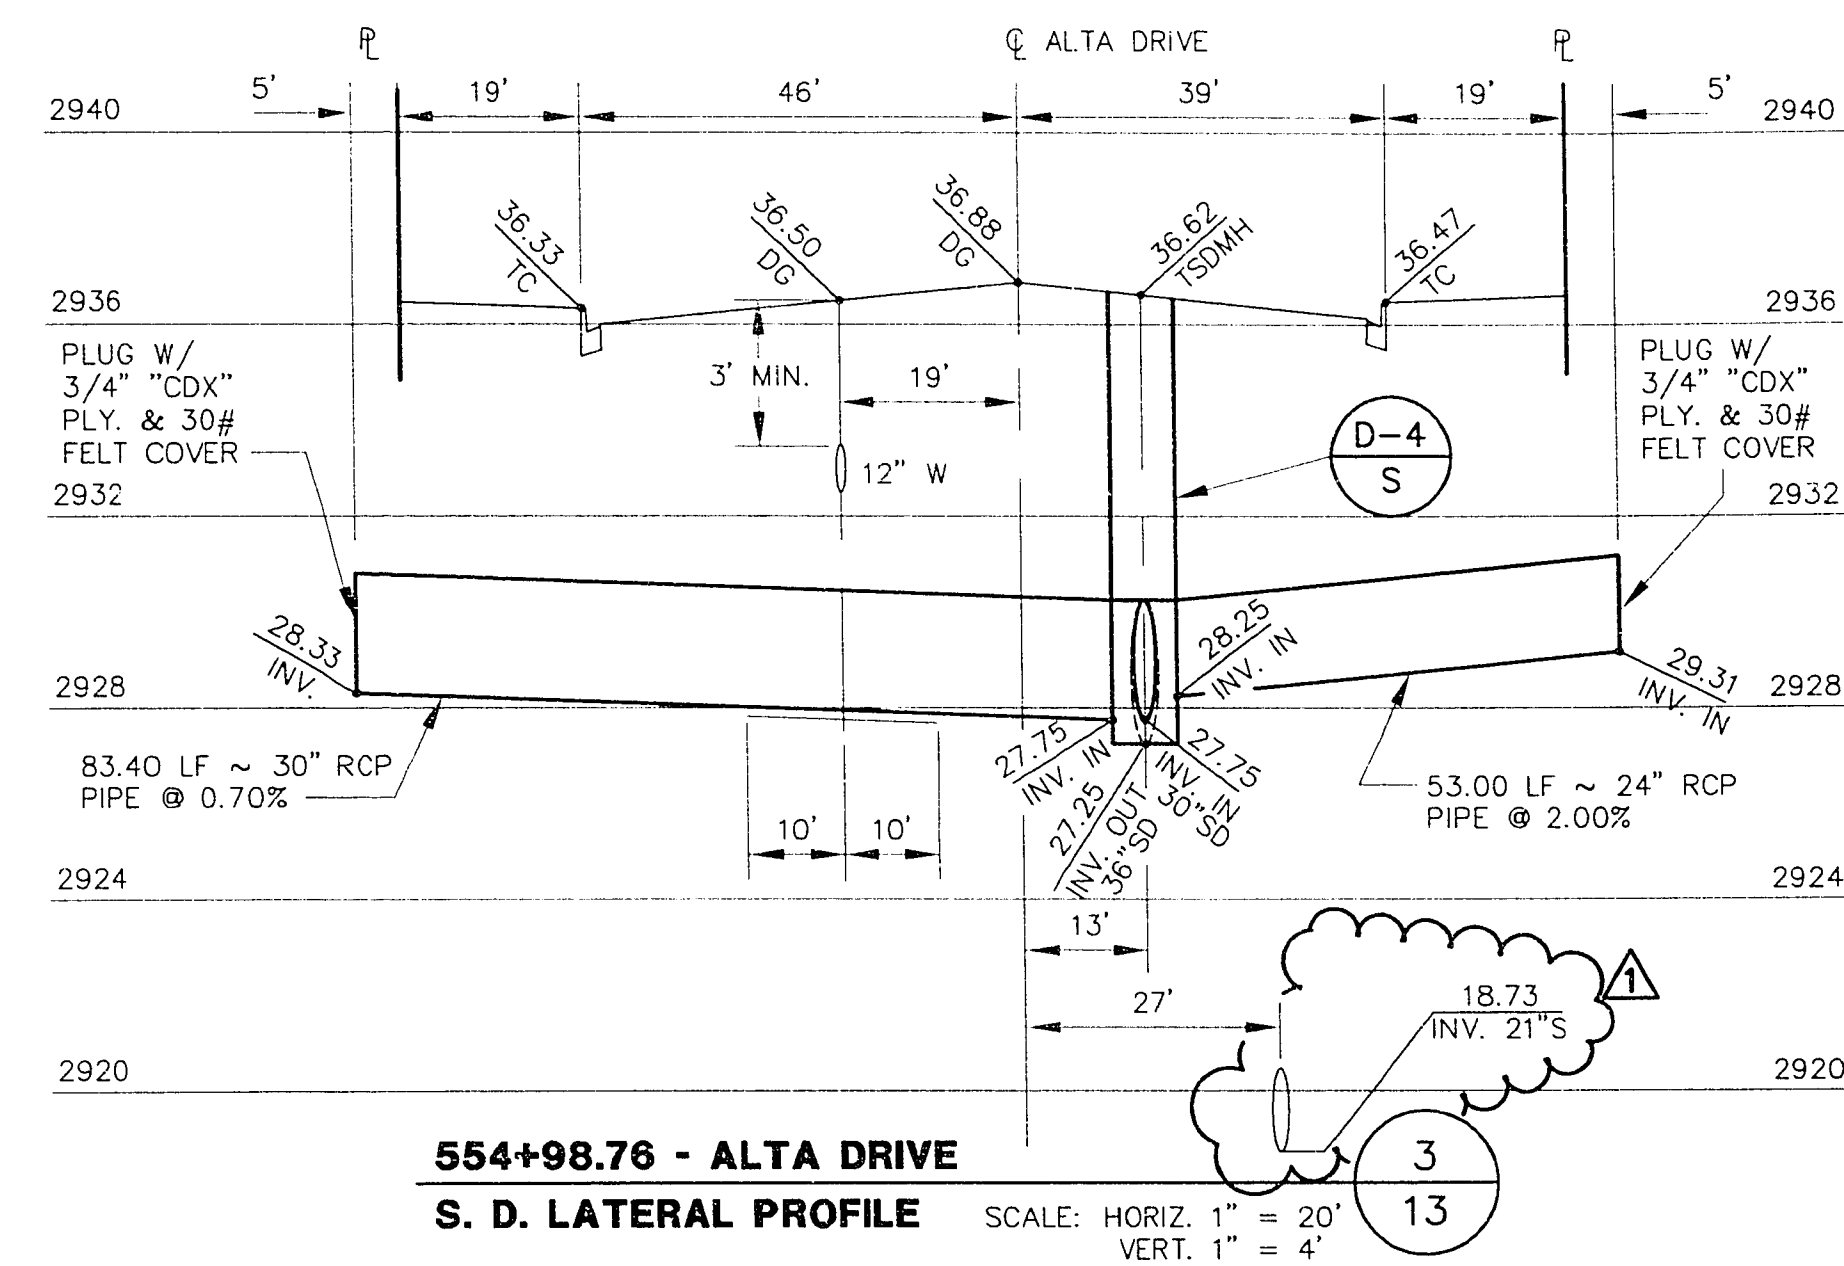


554+98.76 - ALTA DRIVE

S. D. LATERAL PROFILE

SCALE: HORIZ. 1" = 20'
VERT. 1" = 4'

3

13

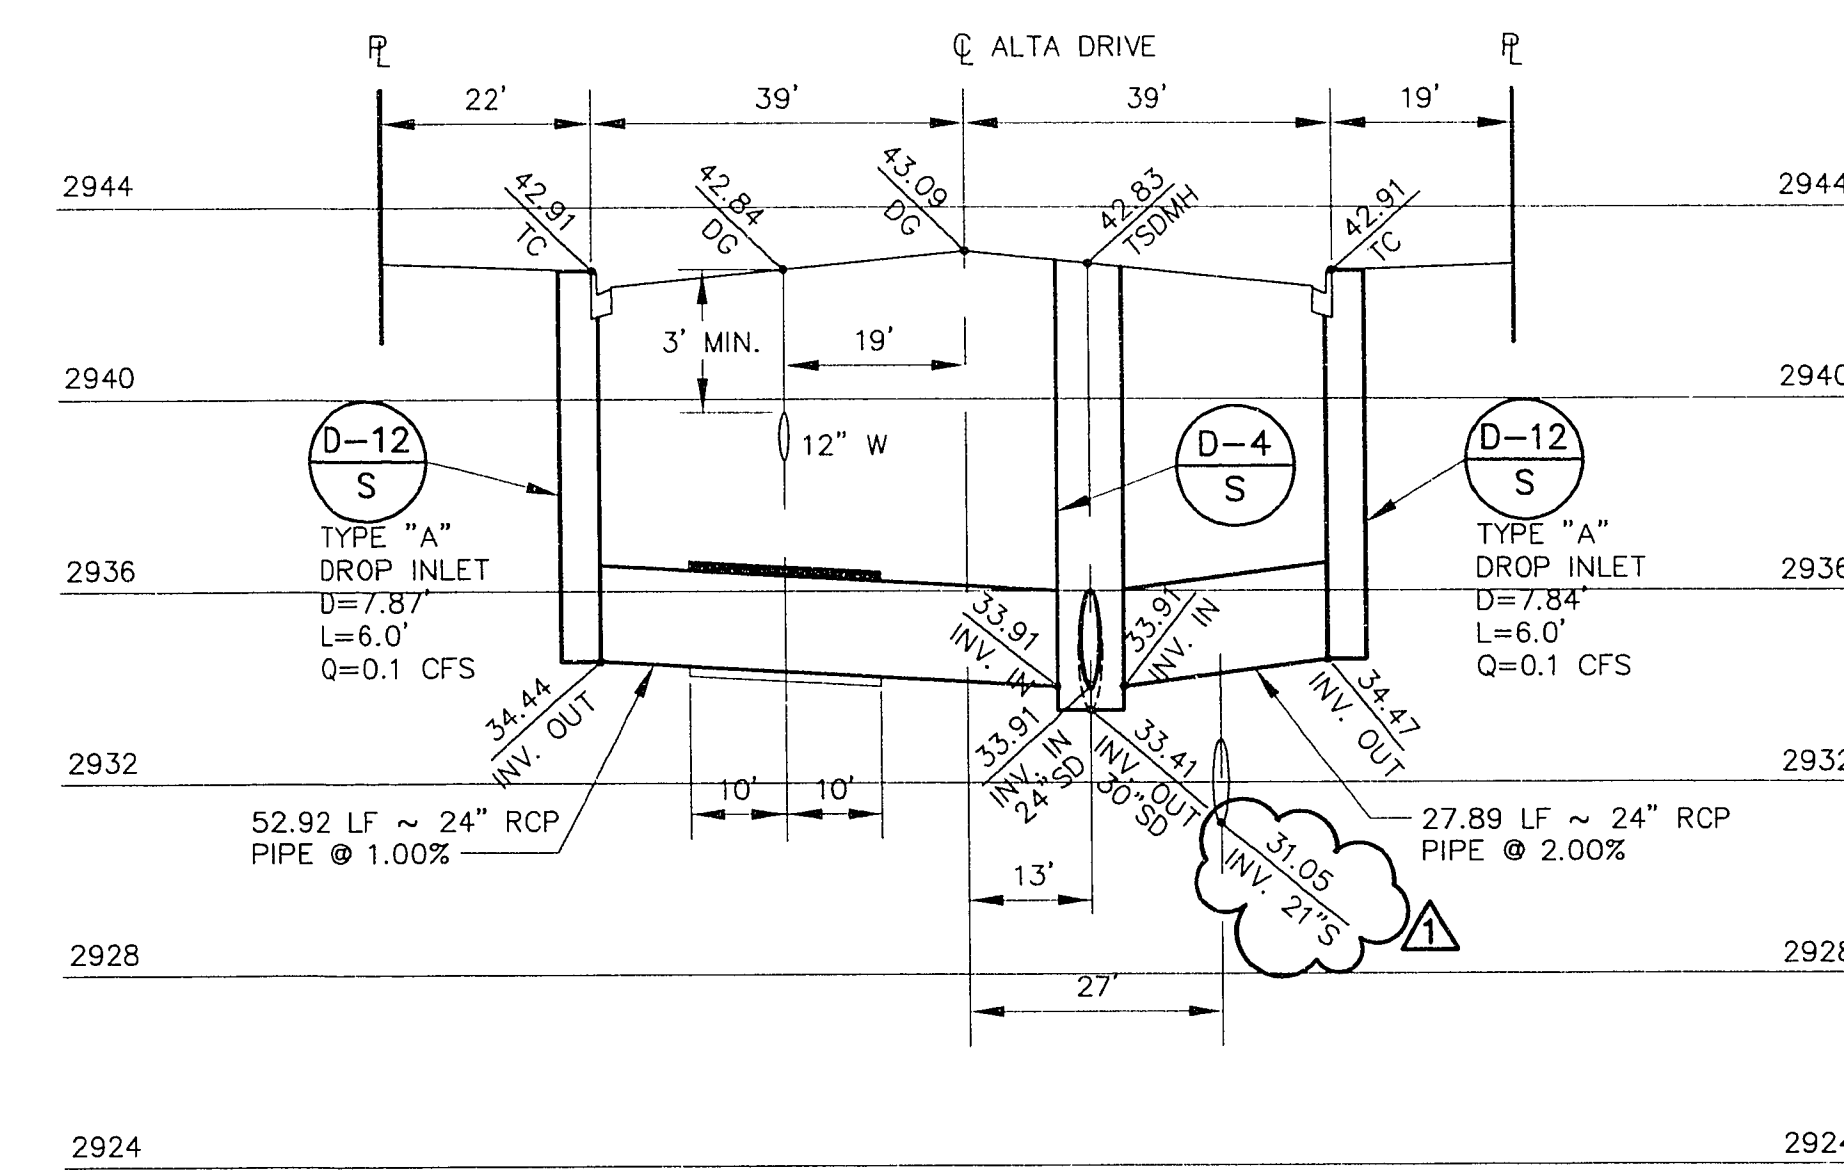


552+22.49 - ALTA DRIVE

S. D. LATERAL PROFILE

SCALE: HORIZ. 1" = 20'
VERT. 1" = 4'

2

13

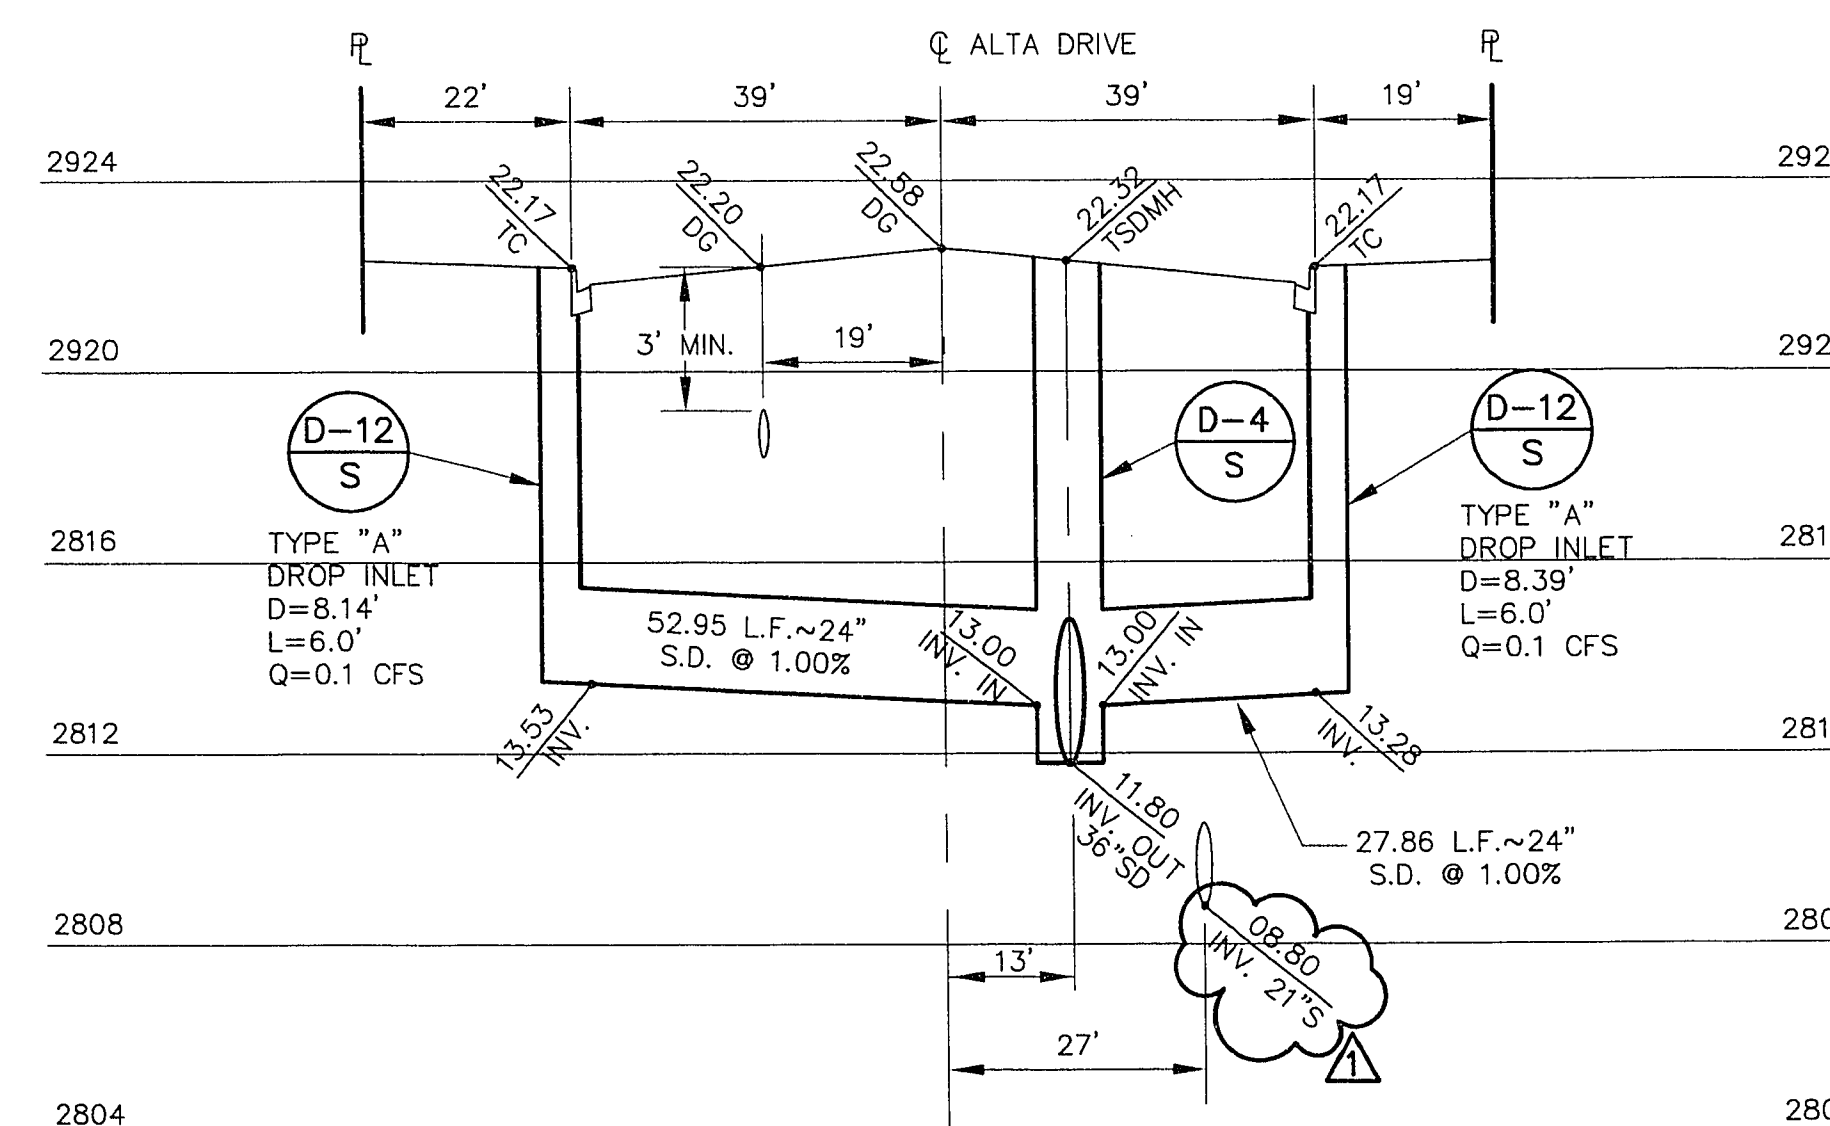


560+80.00 - ALTA DRIVE

S. D. LATERAL PROFILE

SCALE: HORIZ. 1" = 20'
VERT. 1" = 4'

4

13

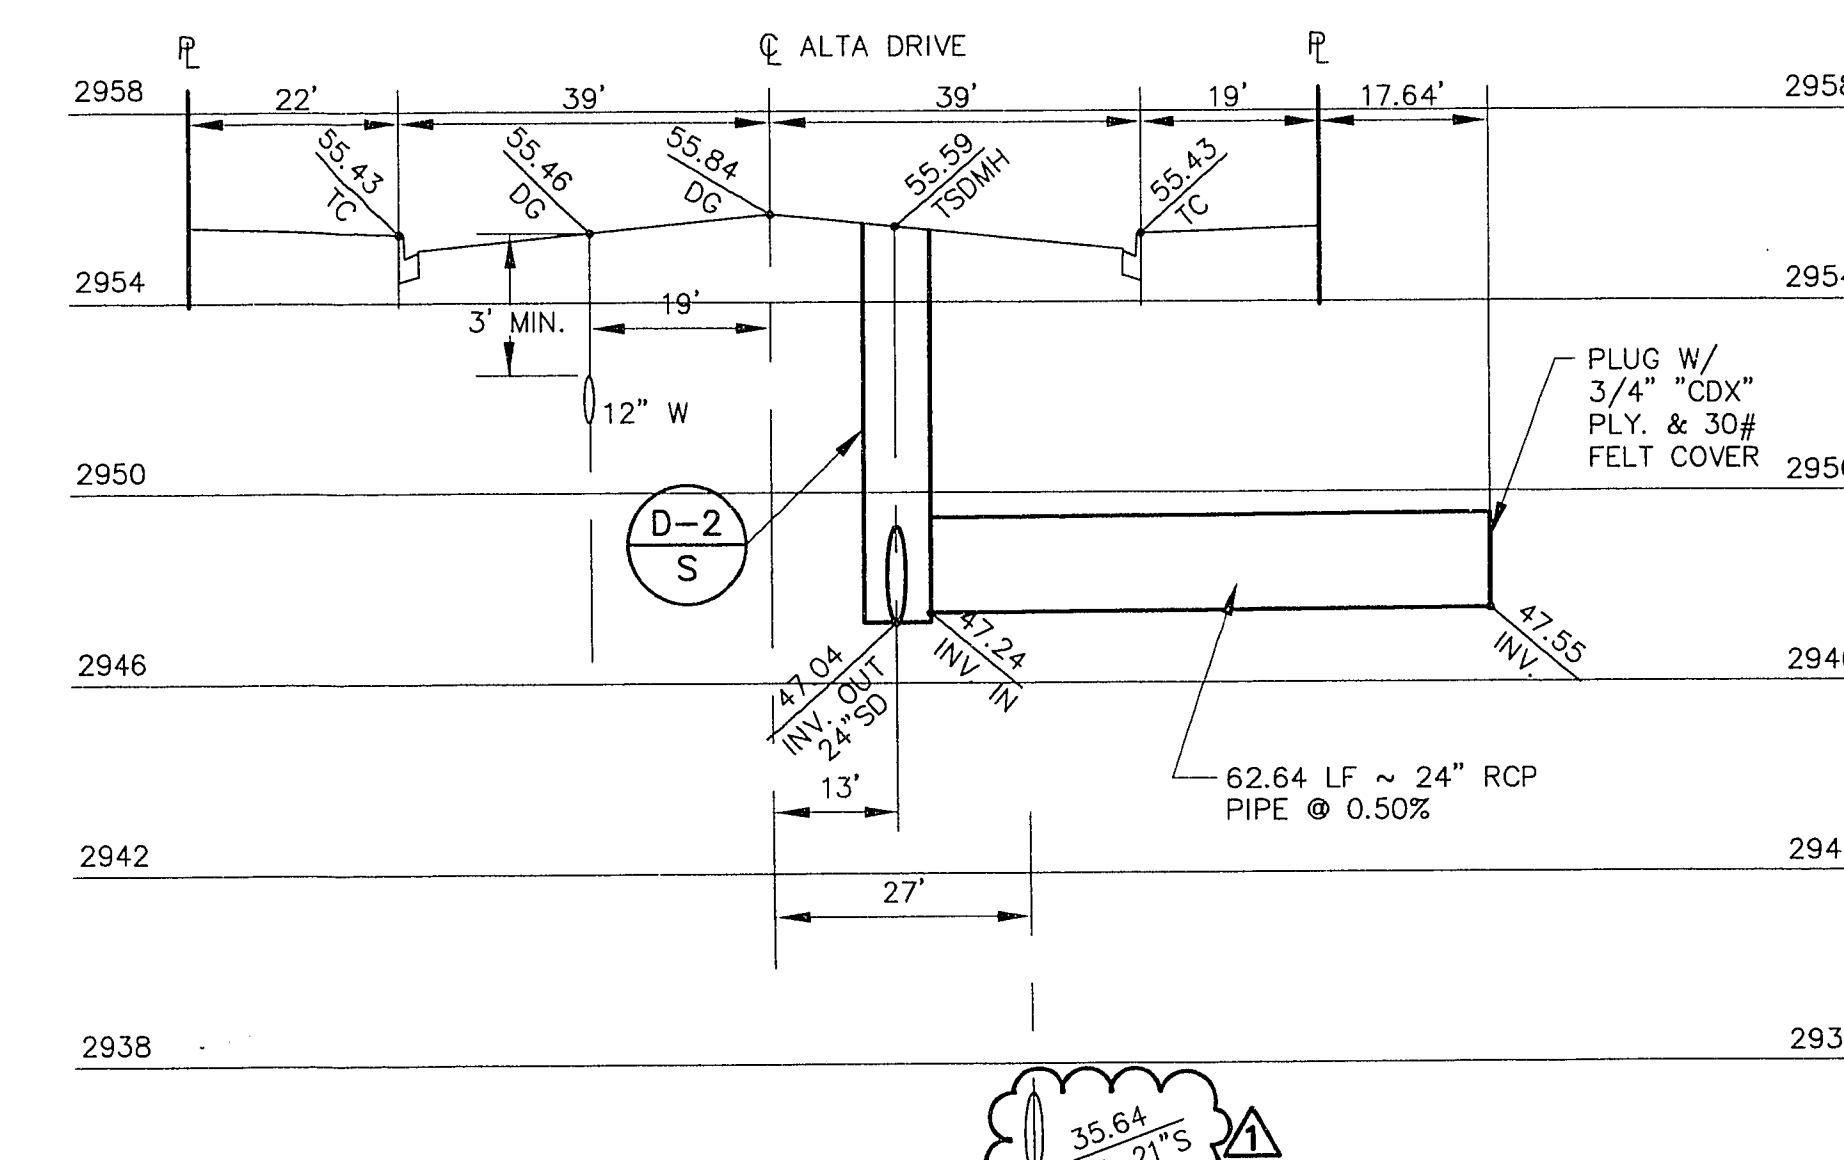

547+00.24 - ALTA DRIVE

S. D. LATERAL PROFILE

SCALE: HORIZ. 1" = 20'
VERT. 1" = 4'

1

13

RECOMMENDED BY: [Signature] DATE: 7/24/96

DESIGNED BY: [Signature] DATE: 7/24/96

CHECKED BY: [Signature] DATE: 7/24/96

APPROVED BY: [Signature] DATE: 7/24/96

REVISIONS: 1. 06/05/96 REVISE SEWER FROM 18" TO 21" DATE: 06/05/96

PROJECT: 107-V2509

SHEET 13 OF 15

DETAILS & STORM DRAIN LATERAL DETAILS

ALTA DRIVE

SUMMERLIN

G.C. WALLACE, INC.
Engineering/Architecture
1555 SOUTH HANBURY BLVD/LAS VEGAS, NEVADA 89102