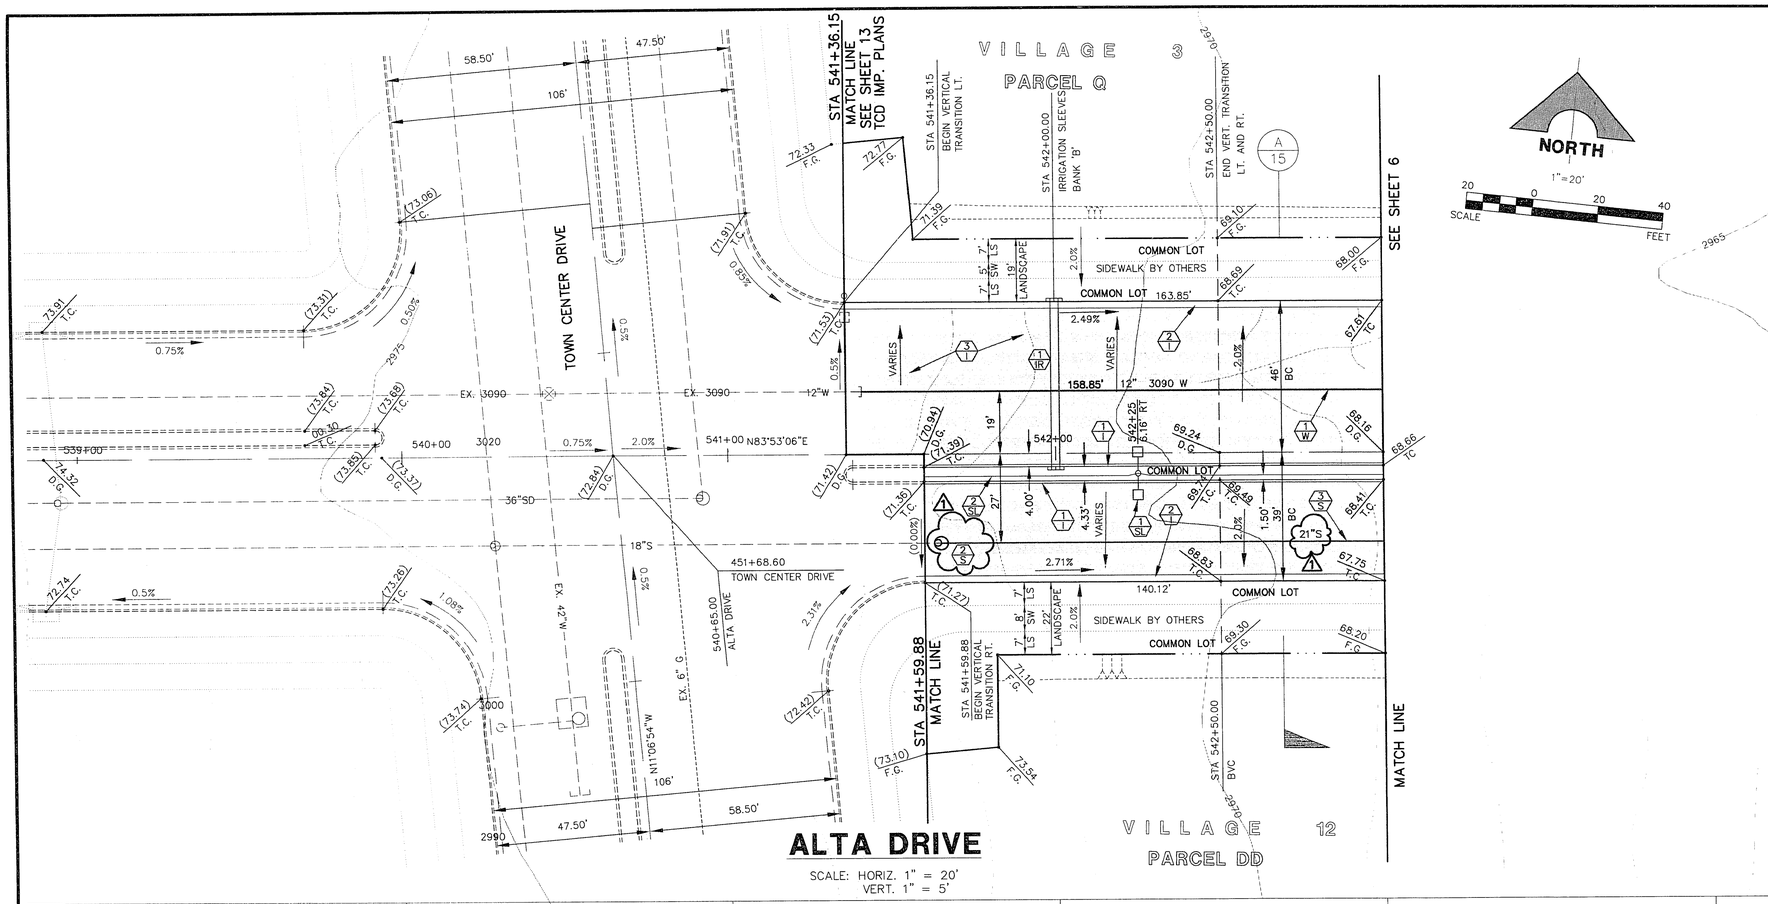

ALTA DRIVE

SCALE: HORIZ. 1" = 20'
VERT. 1" = 5'

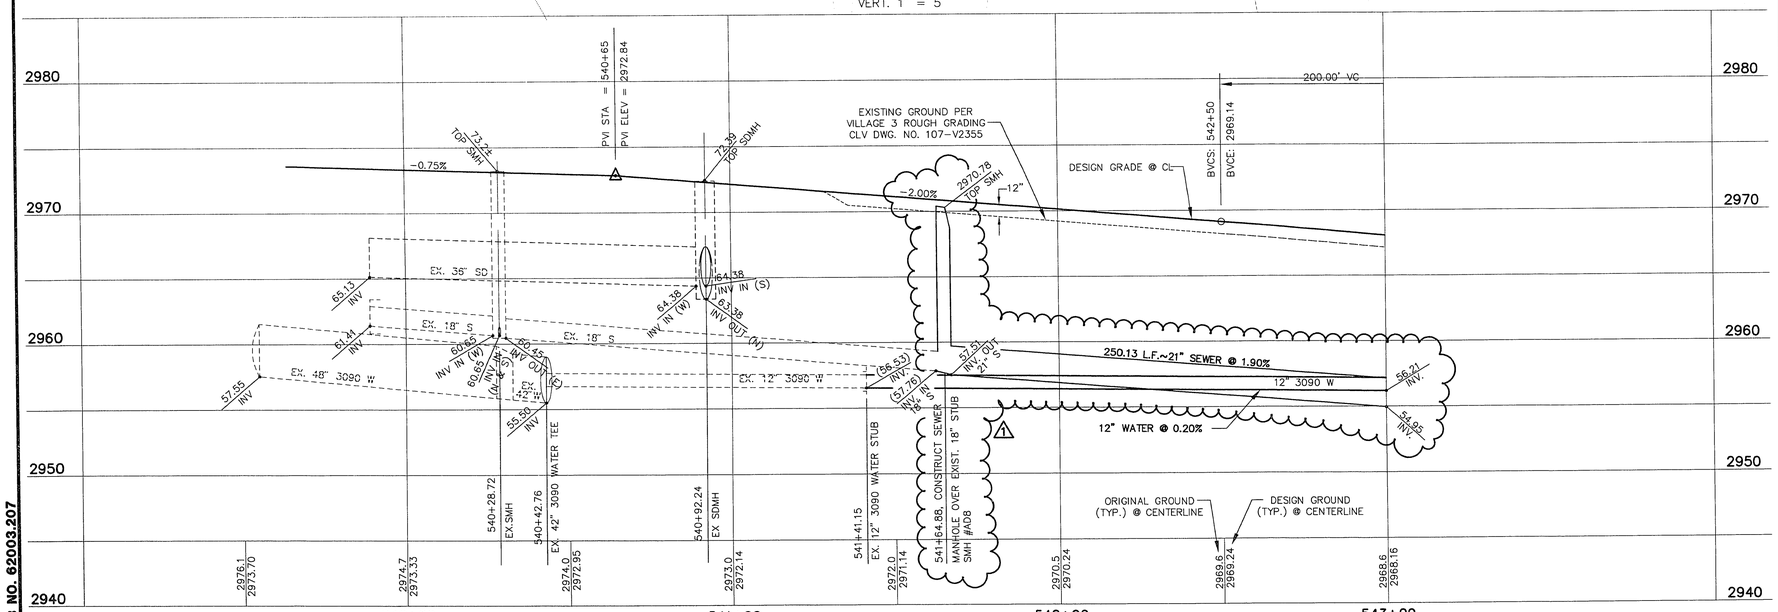

CONSTRUCTION NOTES

IMPROVEMENTS

- 1/1 INSTALL "A" TYPE CURB (S-50/S)
- 2/1 INSTALL "L" TYPE CURB & GUTTER (S-47/S)
- 3/1 INSTALL 4" A.C. PAVEMENT OVER 8" TYPE II BASE
- 4/1 INSTALL CROSSWALK (S-78/S)
- 5/1 INSTALL DEPRESSED CURB (A/13)

WATER

- 1/W INSTALL 12" DIA. WATER PIPE (U-20/S)
- 2/W INSTALL 8" DIA. WATER PIPE (U-20/S)
- 3/W INSTALL 12" DIA. GATE VALVE & BOX (U-34/S)
- 4/W INSTALL 16" DIA. GATE VALVE & BOX (U-34/S)
- 5/W INSTALL 2" TEMP. BLOW-OFF (U-32/S)

STORM DRAIN – ALL S.D. PIPE CLASS 1350-D

- 1/SD INSTALL 24" DIA. STORM DRAIN PIPE (U-20/S)
- 2/SD INSTALL 30" DIA. STORM DRAIN PIPE (U-20/S)
- 3/SD INSTALL 36" DIA. STORM DRAIN PIPE (U-20/S)
- 4/SD INSTALL 54" DIA. STORM DRAIN PIPE (U-20/S)
- 5/SD INSTALL 60" DIA. STORM DRAIN PIPE (U-20/S)
- 6/SD INSTALL STORM DRAIN MANHOLE (D1.05/S)
- 7/SD INSTALL 6' TYPE "A" DROP INLET (D-12/S)

SEWER

- 1/S INSTALL 8" DIA. SEWER PIPE (U-20/S)
- 2/S INSTALL 60" DIA. SEWER MANHOLE (SD1-8/CLV)
- 3/S INSTALL 21" DIA. SEWER PIPE (U-20/S)

STREET LIGHTING

- 1/SL INSTALL STREET LIGHT, SEE ELECTRICAL PLANS (E-2/S)
- 2/SL STREET LIGHT OR COMMON TRENCH, SEE ELECTRICAL PLANS

TRAFFIC

- 1/SIG INSTALL 1-3" CONDUIT
- 2/SIG INSTALL NO. 5 PULLBOX (E-32/S)

IRRIGATION

- 1/IR BANK 'A': 1-6" & 2-4" SLEEVES SDR 35 PVC
  BANK 'B': 2-4" SLEEVES SDR 35 PVC
  BANK 'C': 1-6" & 3-4" SLEEVES SDR 35 PVC (U-18/S)

NOTE: ALL COMMON LOTS AS SHOWN HEREIN TO BE PRIVATELY MAINTAINED BY THE H.O.A.

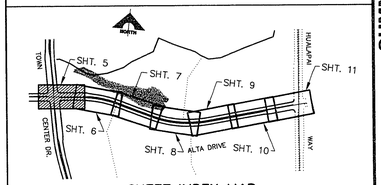

SHEET INDEX MAP

APPROVAL:
1st A/I 2/22/96
LAS VEGAS VALLEY WATER DISTRICT — DATE 4/06/96

REV.	DATE	DESCRIPTION	APPROVAL
1	06/05/96	REVISE SEWER FROM 18" TO 21" AND ADD SEWER MANHOLE	BB 7/24/96

RECOMMENDED FOR APPROVAL: BERT A. HUGHES, P.E. — DATE 6/6/96

PROFESSIONAL ENGINEER — STATE OF NEVADA — BERT A. HUGHES — No. 7853 — 6/6/96

G.C. WALLACE, INC.
Engineering/Architecture
6555 SOUTH RAINBOW BLVD/LAS VEGAS, NEVADA 89118

SUMMERLIN
ALTA DRIVE
ALTA DR. - TOWN CENTER DR. TO HUALAPAI
PLAN & PROFILE
541+36.15 TO 543+00

SHEET 5 OF 15

JOB NO. 62003.207

S.T.S., ALTAPP05.DWG, 06/05/96

S.I.D. 707 PROJECT NO. 8B, 8C, 8D 107-V2509 10-2-29