

CURVE DATA (1 INDICATES CURVE NUMBER)

CURVE	DELTA	RADIUS	LENGTH	TANGENT
1	06°01'36"	1208.33'	127.10'	63.61'
2	07°41'26"	1191.67'	159.95'	80.10'
3	07°41'26"	1239.00'	166.31'	83.28'
4	07°41'26"	1161.00'	155.84'	78.04'
5	07°41'26"	1200.00'	161.07'	80.66'
6	13°07'50"	300.00'	68.69'	34.49'
7	11°27'10"	300.00'	59.67'	30.08'

CONSTRUCTION NOTES

- IMPROVEMENTS**
- 1 INSTALL "A" TYPE CURB (S-50)
 - 2 INSTALL "L" TYPE CURB & GUTTER (S-47)
 - 3 INSTALL 4" A.C. PAVEMENT OVER 8" TYPE II BASE (S)
 - 4 INSTALL CROSSWALK (S-78)
 - 5 INSTALL DEPRESSED CURB (A-13)

- WATER**
- 1 INSTALL 12" DIA. WATER PIPE (U-20)
 - 2 INSTALL 8" DIA. WATER PIPE (U-20)
 - 3 INSTALL 12" DIA. GATE VALVE & BOX (U-34)
 - 4 INSTALL 16" DIA. GATE VALVE & BOX (U-34)
 - 5 INSTALL 2" TEMP. BLOW-OFF (U-32)

- STORM DRAIN** - ALL S.D. PIPE CLASS 1350-D
- 1 INSTALL 24" DIA. STORM DRAIN PIPE (U-20)
 - 2 INSTALL 30" DIA. STORM DRAIN PIPE (U-20)
 - 3 INSTALL 36" DIA. STORM DRAIN PIPE (U-20)
 - 4 INSTALL 54" DIA. STORM DRAIN PIPE (U-20)
 - 5 INSTALL 60" DIA. STORM DRAIN PIPE (U-20)
 - 6 INSTALL STORM DRAIN MANHOLE (D-4)
 - 7 INSTALL 6" TYPE "A" DROP INLET (D-12)


- SEWER**
- 1 INSTALL 8" DIA. SEWER PIPE (U-20)
 - 2 INSTALL 60" DIA. SEWER MANHOLE (SD-8)
 - 3 INSTALL 21" DIA. SEWER PIPE (U-20)

- STREET LIGHTING**
- 1 INSTALL STREET LIGHT, SEE ELECTRICAL PLANS (E-2)
 - 2 STREET LIGHT OR COMMON TRENCH, SEE ELECTRICAL PLANS (S)

- TRAFFIC**
- 1 INSTALL 1-3" CONDUIT (S)
 - 2 INSTALL NO. 5 PULLBOX (E-32)

- IRRIGATION**
- 1 BANK 'A': 1-6" & 2-4" SLEEVES SDR 35 PVC (U-18)
 - 2 BANK 'B': 2-4" SLEEVES SDR 35 PVC (S)
 - 3 BANK 'C': 1-6" & 3-4" SLEEVES SDR 35 PVC (S)

NOTE: ALL COMMON LOTS AS SHOWN HEREIN TO BE PRIVATELY MAINTAINED BY THE H.O.A.

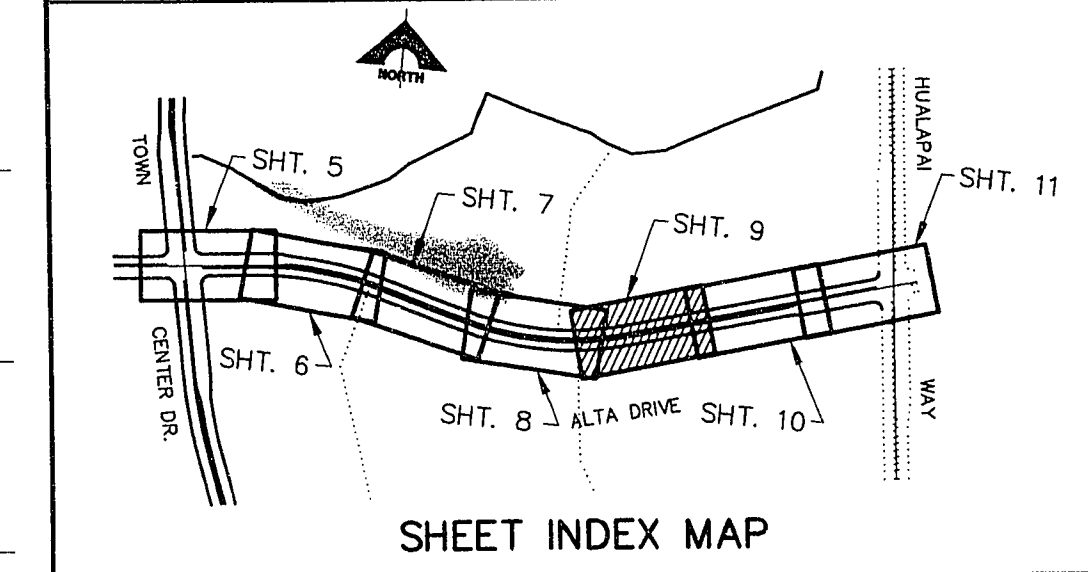


APPROVAL: *[Signature]* 2/22/96
 LAS VEGAS VALLEY WATER DISTRICT DATE 2/22/96

ALTA DRIVE

SCALE: HORIZ. 1" = 20'
 VERT. 1" = 5'

PVI STA = 559+50
 PVI ELEV = 2926.63
 A.D. = 0.94
 K = 106.57

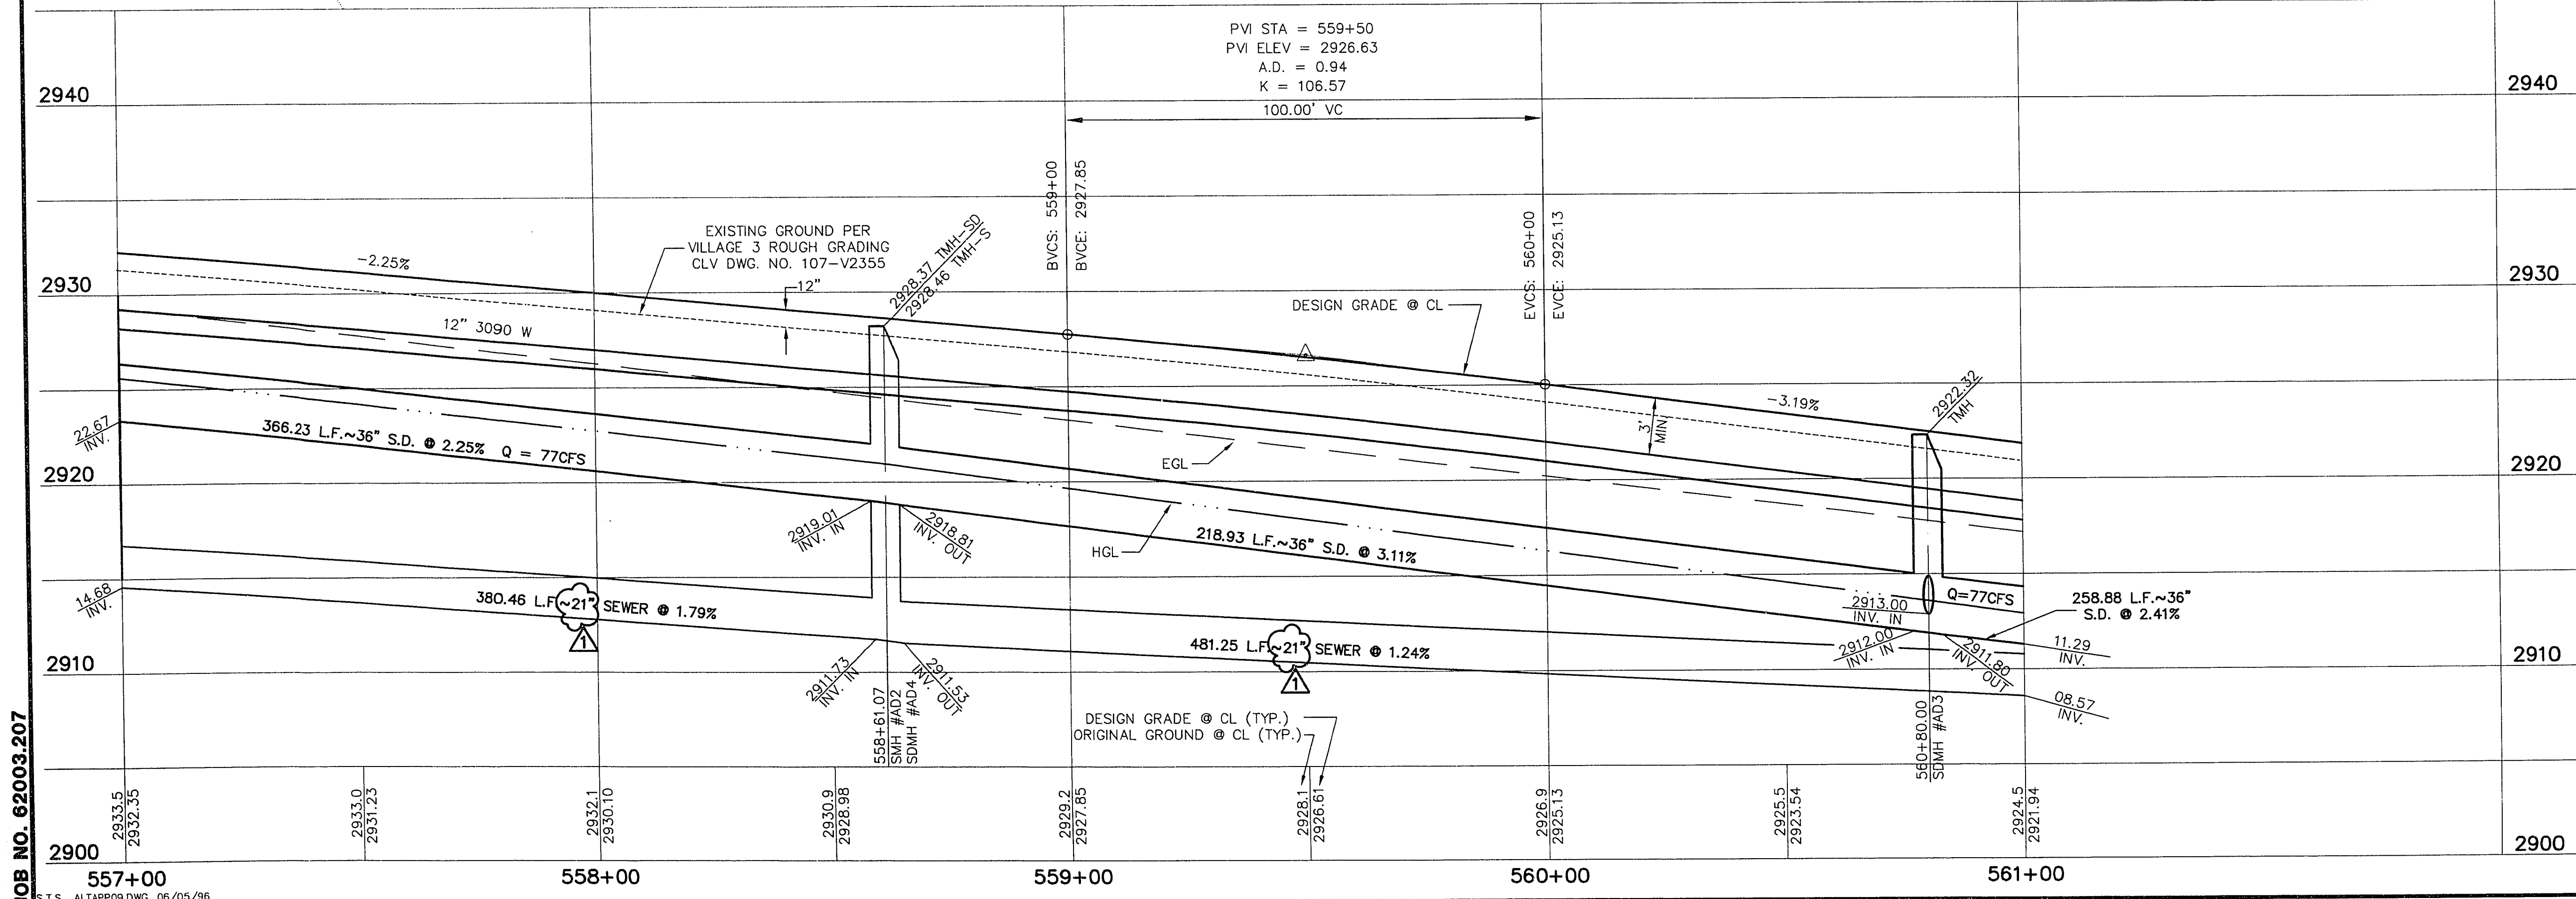

JOB NO. 62003.207

G.C. WALLACE, INC.
 Engineering/Architecture
 1555 SOUTH RANBURY BLVD., LAS VEGAS, NEVADA 89102
 DATE: 2/22/96
 REV. DATE: 7/10/96
 APPROVAL: *[Signature]*
 REVISION: 1
 REVISION: 2
