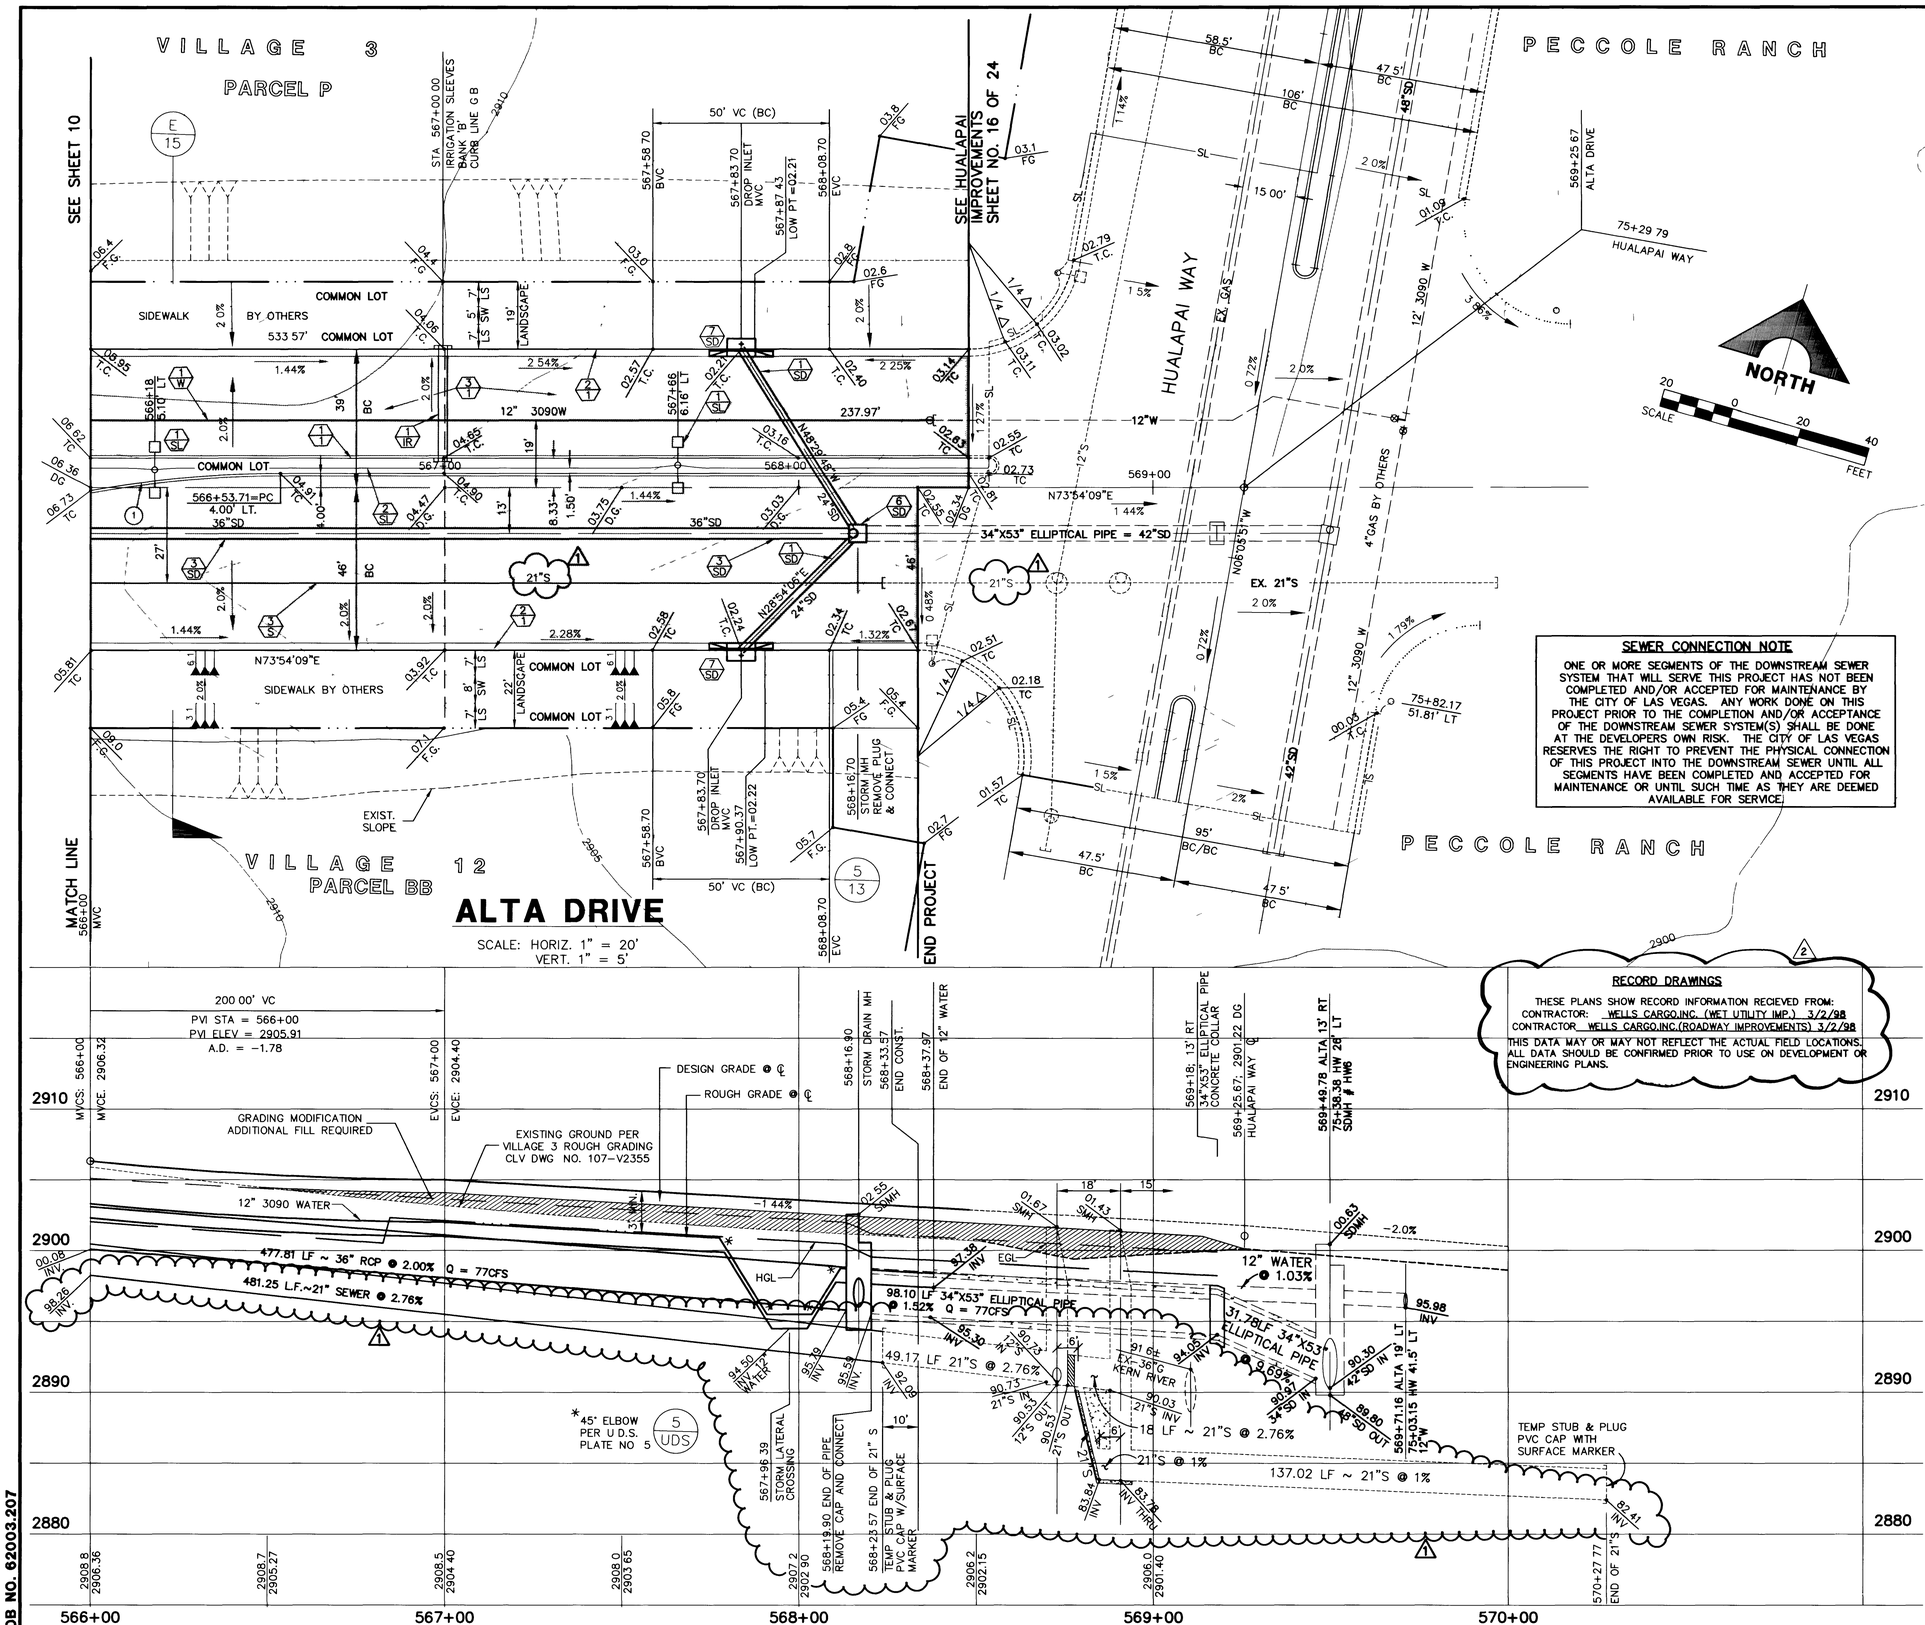

CURVE DATA

(1) INDICATES CURVE NUMBER

CURVE	DELTA	RADIUS	LENGTH	TANGENT
1	10°18'52"	300 00'	54 01'	27 08'

CONSTRUCTION NOTES

IMPROVEMENTS

- (1) INSTALL "A" TYPE CURB (S-50 / S)
- (2) INSTALL "L" TYPE CURB & GUTTER (S-47 / S)
- (3) INSTALL 4" A C PAVEMENT OVER 8" TYPE II BASE
- (4) INSTALL CROSSWALK (S-78 / S)
- (5) INSTALL DEPRESSED CURB (A / 13)

WATER

- (1) W INSTALL 12" DIA. WATER PIPE (U-20 / S)
- (2) W INSTALL 8" DIA WATER PIPE (U-20 / S)
- (3) W INSTALL 12" DIA. GATE VALVE & BOX (U-34 / S)
- (4) W INSTALL 16" DIA. GATE VALVE & BOX (U-34 / S)
- (5) W INSTALL 2" TEMP. BLOW-OFF (U-32 / S)

STORM DRAIN – ALL S.D. PIPE CLASS 1350-D

- (1) SD INSTALL 24" DIA. STORM DRAIN PIPE (U-20 / S)
- (2) SD INSTALL 30" DIA. STORM DRAIN PIPE (U-20 / S)
- (3) SD INSTALL 36" DIA. STORM DRAIN PIPE (U-20 / S)
- (4) SD INSTALL 54" DIA. STORM DRAIN PIPE (U-20 / S)
- (5) SD INSTALL 60" DIA. STORM DRAIN PIPE (U-20 / S)
- (6) SD INSTALL STORM DRAIN MANHOLE (D-4 / S)
- (7) SD INSTALL 10' TYPE "C" DROP INLET (D-12 / S)

SEWER

- (1) S INSTALL 8" DIA. SEWER PIPE (U-20 / S)
- (2) S INSTALL 60" DIA. SEWER MANHOLE (SD1-8 / CLV)
- (3) S INSTALL 21" DIA. SEWER PIPE (U-20 / S)

STREET LIGHTING

- (1) SL INSTALL STREET LIGHT, SEE ELECTRICAL PLANS (E-2 / S)
- (2) SL STREET LIGHT OR COMMON TRENCH, SEE ELECTRICAL PLANS

TRAFFIC

- (1) SIG INSTALL 1-3" CONDUIT
- (2) SIG INSTALL NO. 5 PULLBOX (E-32 / S)

IRRIGATION

- (1) IR BANK 'A': 1-6" & 2-4" SLEEVES SDR 35 PVC
  BANK 'B': 2-4" SLEEVES SDR 35 PVC
  BANK 'C': 1-6" & 3-4" SLEEVES SDR 35 PVC (U-18 / S)

NOTE: ALL COMMON LOTS AS SHOWN HEREIN TO BE PRIVATELY MAINTAINED BY THE H.O.A.

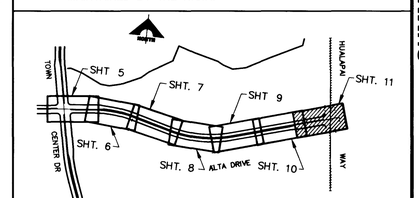

SHEET INDEX MAP

APPROVAL:
1st Approval 8/22/96
LAS VEGAS VALLEY WATER DISTRICT — DATE 6/06/96

REV.	DATE	DESCRIPTION	APPROVAL
2	3/4/98	ADD RECORD DRAWING INFO.	
1	06/05/96	REVISE SEWER FROM 18" TO 21"	7/24/96

RECOMMENDED FOR ACCEPTANCE — BERT A. HUGHES, CIVIL ENGINEER — STATE OF NEVADA — DATE

G.C. WALLACE, INC.
Engineering/Architecture
1555 SOUTH RAINBOW BLVD./LAS VEGAS, NEVADA 89102

SUMMERLIN
ALTA DRIVE
ALTA DR. - TOWN CENTER DR. TO HUALAPAI
PLAN & PROFILE
566+00 TO 569+47.97

SHEET 11 (2)
SHT 11 OF 16

JOB NO. 62003.207
STS, ALTAPP11.DWG, 06/05/96

764

S.I.D. 707 PROJECT NO. 8B, 8C, 8D 107-V2509
20-2-35

PARCEL P

PECCOLE RANCH

HUALAPAI WAY

NORTH

VILLAGE 12
PARCEL BS

ALTA DRIVE

PECCOLE RANCH

CURVE DATA

CURVE	DELTA	RADIUS	LENGTH	TANGENT

DISTRIBUTION NOTES

SHEET INDEX MAP

APPROVALS

G.C. WALLACE, INC.

ALTA DRIVE
PLAN & PROFILE

SHEET 11

