


THESE PLANS SHOW RECORD INFORMATION RECEIVED FROM:
CONTRACTOR: WELLS CARGO, INC. (WET UTILITY IMP.) 3/2/98
CONTRACTOR WELLS CARGO, INC. (ROADWAY IMPROVEMENTS) 3/2/98
THIS DATA MAY OR MAY NOT REFLECT THE ACTUAL FIELD LOCATIONS.
ALL DATA SHOULD BE CONFIRMED PRIOR TO USE ON DEVELOPMENT OF
ENGINEERING PLANS.



DIMENSIONAL TOLERANCES, METHOD OF MANUFACTURE,
REINFORCEMENT, AND CONCRETE SHALL CONFORM TO
ASTM C-478 REINFORCEMENT NOT SHOWN FOR CLARITY
PRODUCTS MANUFACTURED WITH TYPE V CEMENT

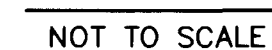

DEEP MANHOLE LANDING
(PRECAST FLATTOP)

13



NOT TO SCALE

13



1




SCALE. HORIZ. 1" = 20'




S. D. LATERAL PROFILE

SCALE: HORIZ 1" = 20'

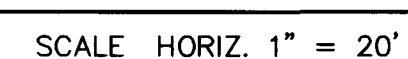


(1)

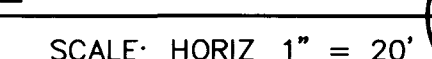

S. D. LATERAL PROFILE

SCALE: HORIZ 1" = 20'


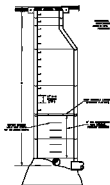










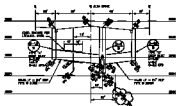




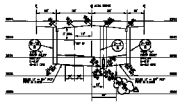




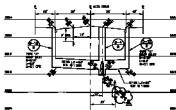



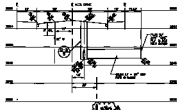


