


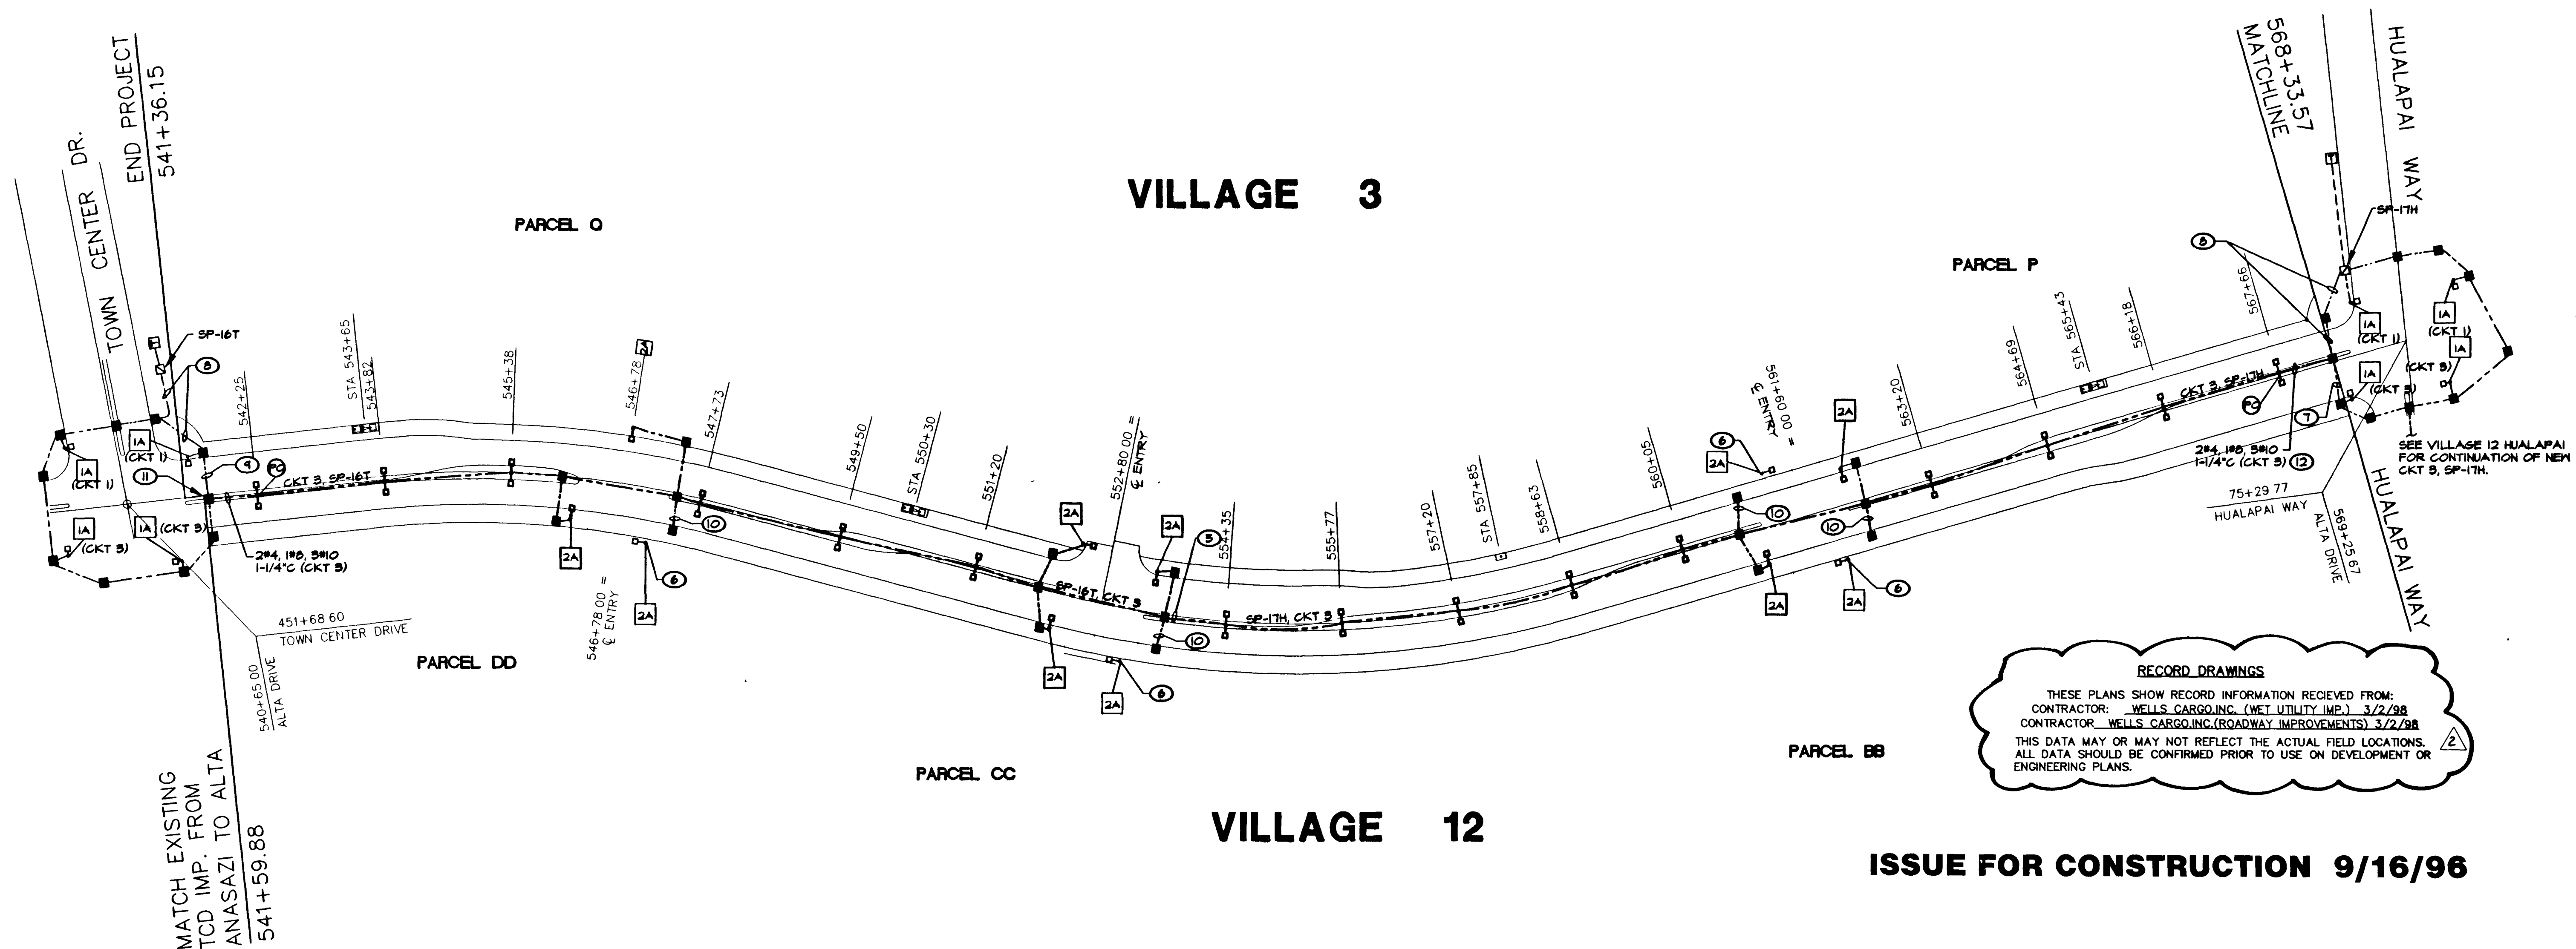

ELECTRICAL STREET LIGHTING PLAN

SCALE: 1"=100'-0"

STREET CLASSIFICATIONS:

ALTA DRIVE
HUALAPAI DRIVE
TOWN CENTER DRIVE
NEIGHBORHOOD ARTERIAL
VILLAGE ARTERIAL
VILLAGE ARTERIAL

GENERAL NOTE:

STREETLIGHT FIXTURES AND ARMS SHALL BE POWDER COATED BRONZE IN LIEU OF ANODIZED PICTURE AND PAINTED ARM AS SHOWN ON STANDARD DRAWINGS.

LEGEND

- TRANSFORMER
- METERED SERVICE PEDESTAL
- 1-1/4" CONDUIT WITH 2#4, 1#6 UNLESS NOTED OTHERWISE
- STREET LIGHT
- PULLBOX SIZE 8-1/2 UNLESS NOTED OTHERWISE
- CONSTRUCTION NOTE
- REVISION
- IRRIGATION CONTROLLER LOCATION
- PHOTOCELL MOUNTED ON LUMINAIRE WITH 3#10 FROM PHOTOCELL TO CONTRACTOR IN SERVICE PEDESTAL

APPROVALS

[Signature] 9-10-96
CITY ENGINEER - DENNIS ANDERSON DATE

[Signature] 8/5/96
SUMMIT DESIGN REVIEW COMMITTEE DATE

[Signature] 8-15-96
NEVADA POWER COMPANY DATE

TJ KROB CONSULTING ENGINEERS, INC.
1919 S. JONES BLVD. SUITE 3
LAS VEGAS, NEVADA 89102
(702) 871-3621
ELECTRICAL ENGINEERING

SHEET

E-1

SHT 16 OF 16

SERVICE PANEL SP-16T 1 PH, 3 WIRE 120/240 VOLTS 200 AMP MAIN CB MIN INTERRUPTING RATINGS 10,000 RMS 5TH AMPS LOCATION: ALTA/TCD NEVA 3R									
POLE SPACE	CIRCUIT USE	CKT BKR	CONNECTED	CKT BKR	CIRCUIT USE	POLE SPACE	CKT BKR	CONNECTED	CKT BKR
ckt #		RATINGS	LOAD VA	RATINGS		ckt #	RATINGS	LOAD VA	RATINGS
1	MAIN				MAIN	2			
3	MAIN				MAIN	4			
5	E-ALTA/TCD L-STREETLIGHTS	60/2	1830	15	E-L-PHOTOCELL, CKT 1	6	2		
7	X		1830	200	N-L-PHOTOCELL, CKT 3	8	4		
9	N-ALTA E OF TCD L-STREETLIGHTS	60/2	2120			10			
11	X		2120			12			
13						14			
15						16			
			4750	6100					
			4500	12200					

CONTRACTOR SCHEDULE

CONTRACTOR #	RATING	No. POLES	CKT #'S
E-C1	60	2	1

EXISTING SERVICE PEDESTAL *

COPYRIGHT (C) 1996 BY TJ KROB CONSULTING ENGINEERS, INC.

SERVICE PANEL SP-1TH 1 PH, 3 WIRE 120/240 VOLTS 200 AMP MAIN CB MIN INTERRUPTING RATINGS 10,000 RMS 5TH AMPS LOCATION: ALTA/HUALAPAI NEVA 3R									
POLE SPACE	CIRCUIT USE	CKT BKR	CONNECTED	CKT BKR	CIRCUIT USE	POLE SPACE	CKT BKR	CONNECTED	CKT BKR
ckt #		RATINGS	LOAD VA	RATINGS		ckt #	RATINGS	LOAD VA	RATINGS
1	MAIN				MAIN	2			
3	MAIN				MAIN	4			
5	E-HUALAPAI NO.	60/2	3030	20	E-L-PHOTOCELL, CKT 1	6	2		
7	X		3030	200	N-L-PHOTOCELL, CKT 3	8	4		
9	N-STREETLIGHTS	60/2	2810			10			
11	X		2810			12			
13						14			
15						16			
			6100	6100					
			12200						

CONTRACTOR SCHEDULE

CONTRACTOR #	RATING	No. POLES	CKT #'S
E-C1	60	2	1
N-C2	60	2	3


EXISTING SERVICE PEDESTAL *

COPYRIGHT (C) 1996 BY TJ KROB CONSULTING ENGINEERS, INC.

NOTES:

- ALL FIXTURES ARE 2B UNLESS NOTED OTHERWISE.
- ALL STREETLIGHT WIRING IS 2#4, 1#6, 1-1/4" UNLESS NOTED OTHERWISE. ALL WIRE IS THW.
- ALL PULLBOXES ARE NO. 8-1/2 UNLESS NOTED OTHERWISE.
- NOT USED.
- PROVIDE 2#4, 1#6, 1-1/4". DO NOT CONNECT WIRES AT EITHER END OF CONDUIT.
- THIS POLE AND LUMINAIRE ARE TO BE INSTALLED IN FUTURE AND ARE SHOWN FOR REFERENCE ONLY. PROVIDE WIRING, CONDUIT AND PULLBOXES AS SHOWN.
- DISCONNECT EXISTING WIRING FROM CIRCUIT 1, SP-1TH AND CONNECT TO NEW CIRCUIT 3. ADD 3#10 IN EXISTING CONDUIT FOR PHOTOCELL.
- ADD 2#4, 1#6, 3#10 IN EXISTING 1-1/4" CONDUIT FOR NEW CIRCUIT 3.
- DISCONNECT EXISTING WIRING FROM CIRCUIT 1, SP-16T AND CONNECT TO NEW CIRCUIT 3. ADD 3#10 IN EXISTING CONDUIT FOR PHOTOCELL.
- PROVIDE 1-1/4" CONDUIT WITH PULLSTRINGS.
- INTERCEPT EXISTING CONDUITS AND WIRING AND INSTALL NEW PULLBOX. RECONNECT EXISTING CIRCUIT AND ADD NEW CIRCUIT AS SHOWN.
- CONNECT TO EXISTING 1-1/4" CONDUIT FROM EXISTING PULLBOX (INSTALLED IN VILLAGE 3 CONTRACT).

* ADD NEW 8i-PASS SWITCH FOR NEW CIRCUIT.

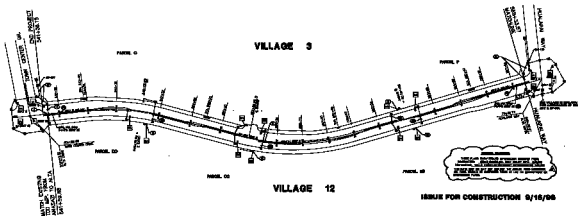
















KROB
