


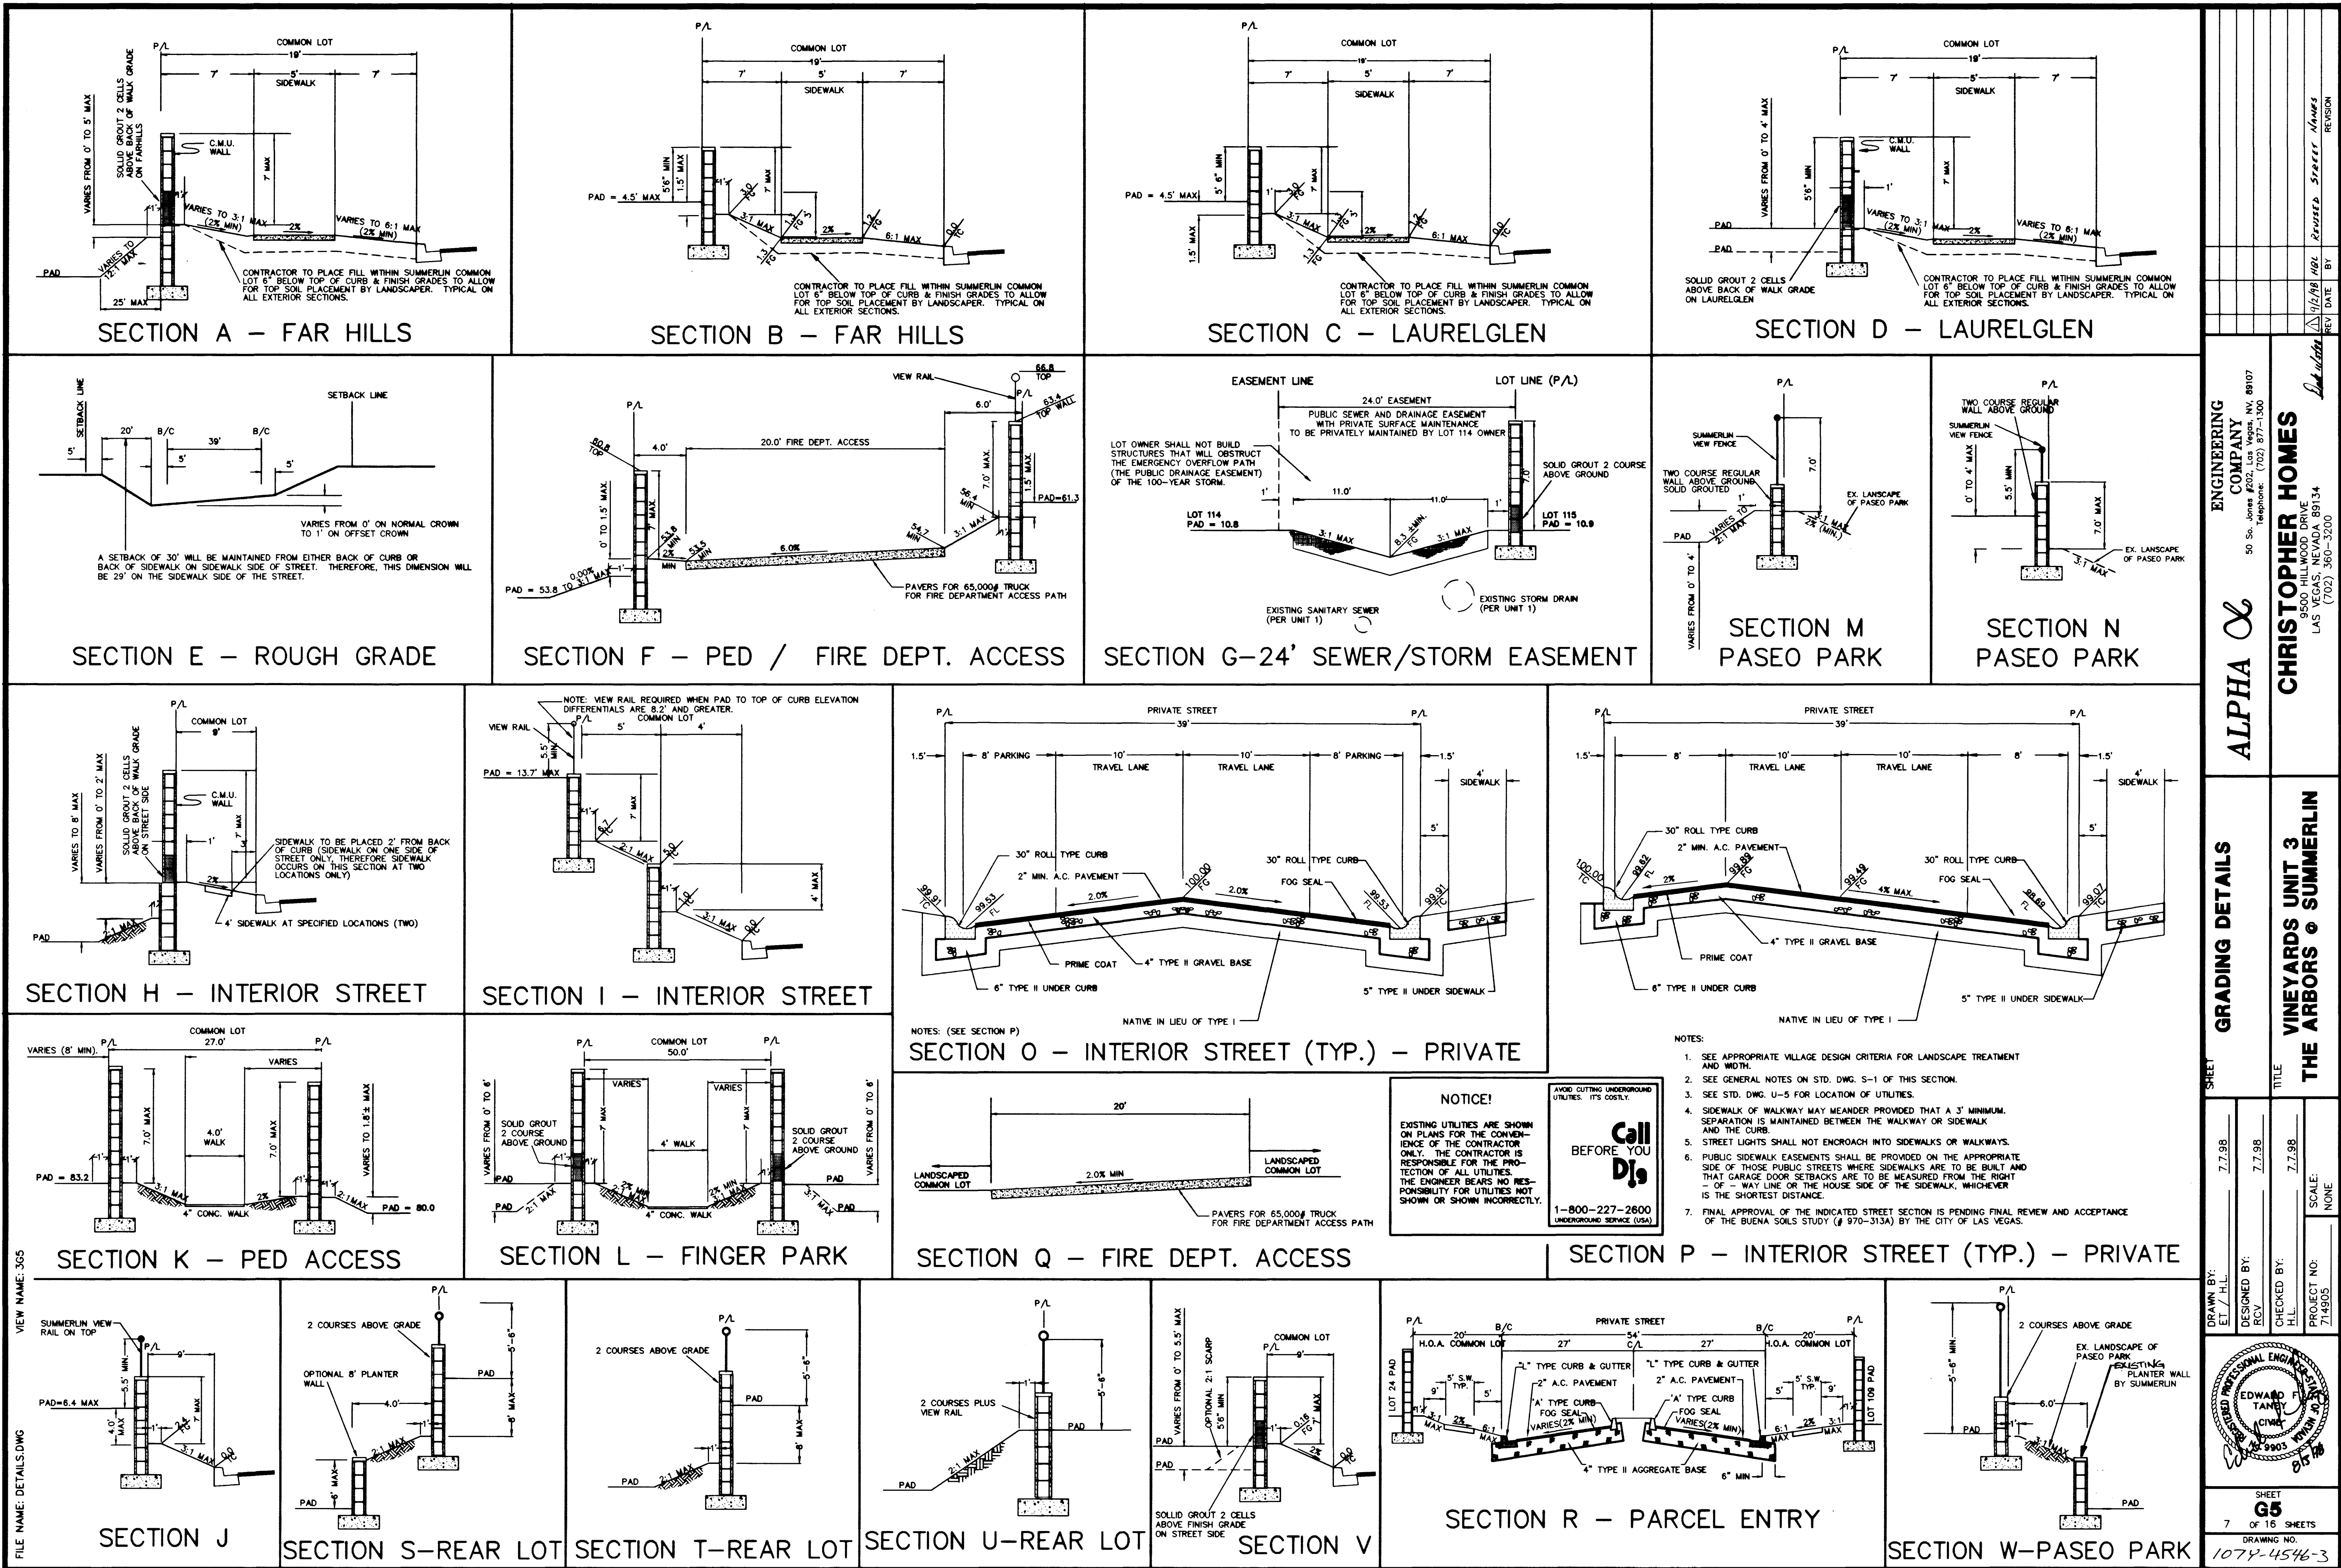

VIEW NAME: 365
FILE NAME: DETAILS.DWG

ENGINEERING COMPANY ALPHA & CHRISTOPHER HOMES 50 So. Jones #202, Las Vegas, NV 89107 Telephone: (702) 877-1300		REVISION BY DATE
SHEET THE ARBORS @ SUMMERLIN VINEYARDS UNIT 3		SCALE: NONE
DRAWN BY: ET / H.L. DESIGNED BY: RCV CHECKED BY: H.L. PROJECT NO: 714905		7.7.98 7.7.98 7.7.98 7.7.98
SHEET G5 7 OF 16 SHEETS DRAWING NO. 1074-4546-3		

