
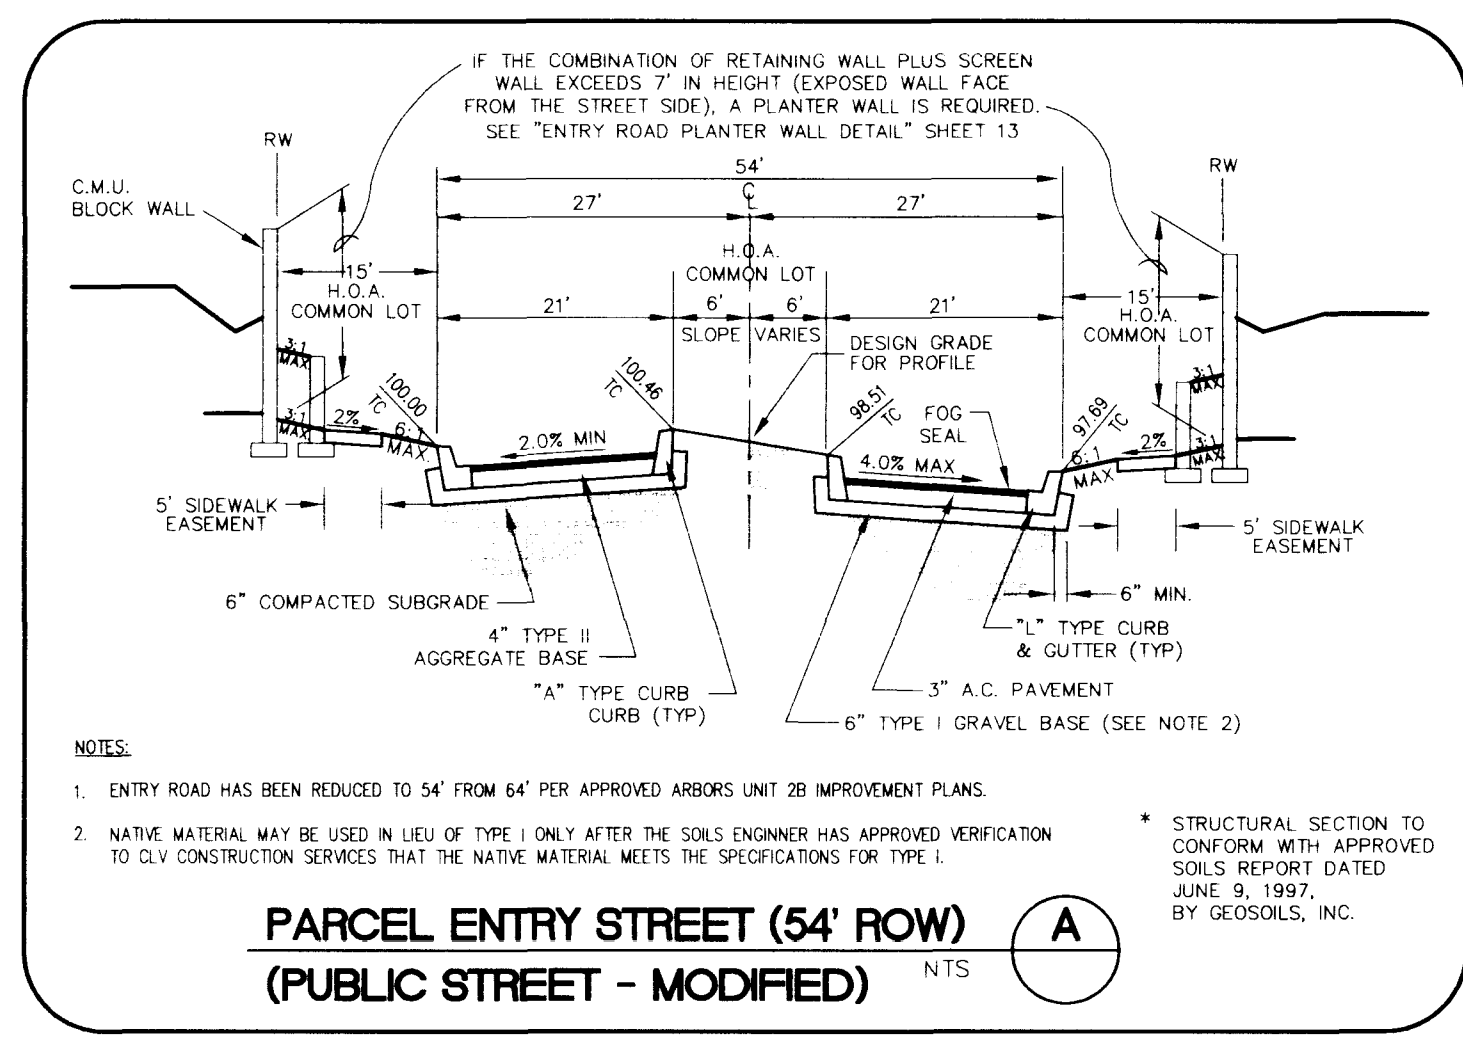


Call before you Dig
1-800-227-2600
UNDERGROUND SERVICE ALERT (USA)

SAFETY ALERT
Call before you Overhead
593-6111
OVERHEAD SERVICE ALERT

BASIS OF BEARINGS:
NORTH 15°23'46" EAST BEING THE BEARING OF THE CENTERLINE OF ANASAZI DRIVE AS SHOWN BY MAP THEREOF ON FILE IN BOOK 64, PAGE 67 OF PLATS IN THE CLARK COUNTY RECORDER'S OFFICE, CLARK COUNTY, NEVADA.



BENCHMARK:
CITY OF LAS VEGAS BENCHMARK
OLV001954 RIVET & PLATE IN TOP OF CURB NW SIDE OF TOWN CENTER DRIVE & SOUTH CIRCLE ISLAND
2728.37 NAVD 1988 DATUM (831.6074 M)

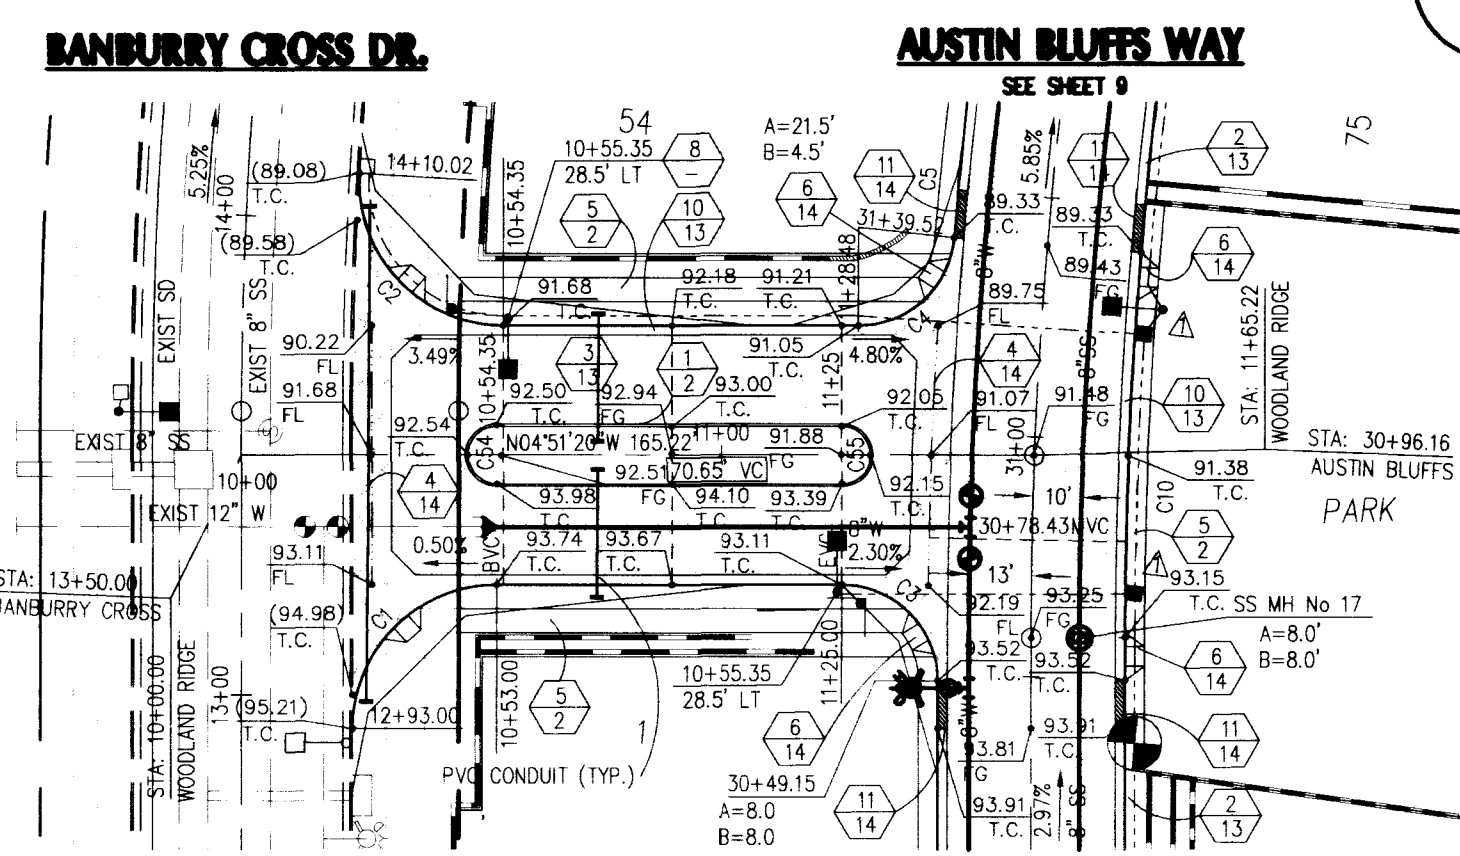


CURVE DATA

CURVE	RADIUS	LENGTH	TANGENT	DELTA
C1	30.00'	47.12'	30.00'	90°00'00"
C2	30.00'	48.82'	31.74'	93°14'06"
C3	20.00'	31.42'	20.00'	90°00'00"
C4	20.00'	29.78'	18.43'	85°18'27"
C5	1019.50'	277.35'	139.54'	15°35'14"
C6	50.00'	23.67'	12.06'	27°07'36"
C7	50.00'	125.88'	155.05'	144°15'13"
C9	30.00'	47.12'	30.00'	90°00'00"
C10	980.50'	346.57'	175.11'	20°15'06"
C54	6.00'	18.85'	<INFINITE>	180°00'00"
C55	6.00'	18.85'	<INFINITE>	180°00'00"
C56	30.00'	47.12'	30.00'	90°00'00"

NOTE: CURVE DATA ON CURB IS BACK OF CURB

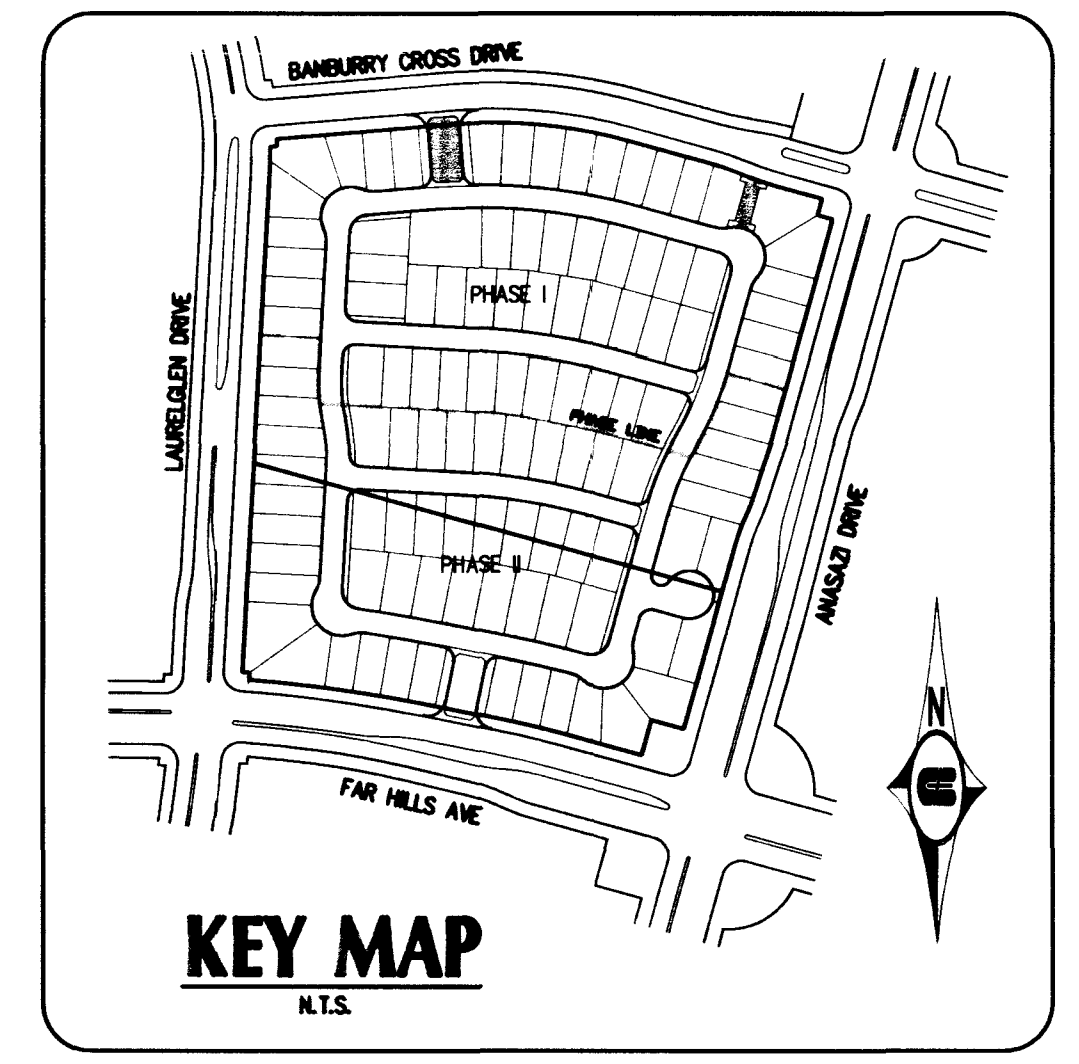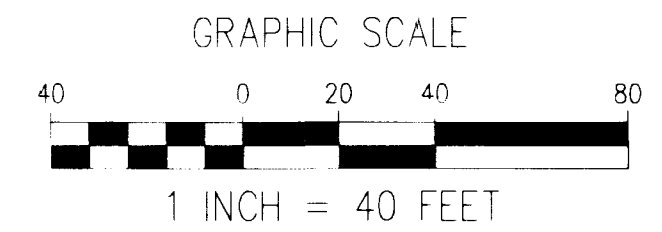

- CONSTRUCTION NOTES:**
- 1. INSTALL "A" TYPE CURB PER SIS # S-50
 - 2. INSTALL "ROLL" TYPE CURB PER SIS # S-48
 - 3. INSTALL AC PAVEMENT PER TYPICAL SECTION(S) PER THIS SHEET
 - 4. INSTALL CROSS GUTTER PER PER SIS # S-64
 - 5. INSTALL SIDEWALK PER SIS # S-72
 - 6. INSTALL SIDEWALK RAMP PER SIS # S-77 CASE 1
 - 7. INSTALL STREET NAME SIGN PER SIS # RS-1
 - 8. INSTALL STREET LIGHT PER SIS # E-27
 - 9. INSTALL NO. 3 1/2 PULLBOX PER SIS # E-31
 - 10. INSTALL "L" CURB PER DETAIL SHEET 14
 - 11. "L" TO ROLL CURB PER SIS # S-47


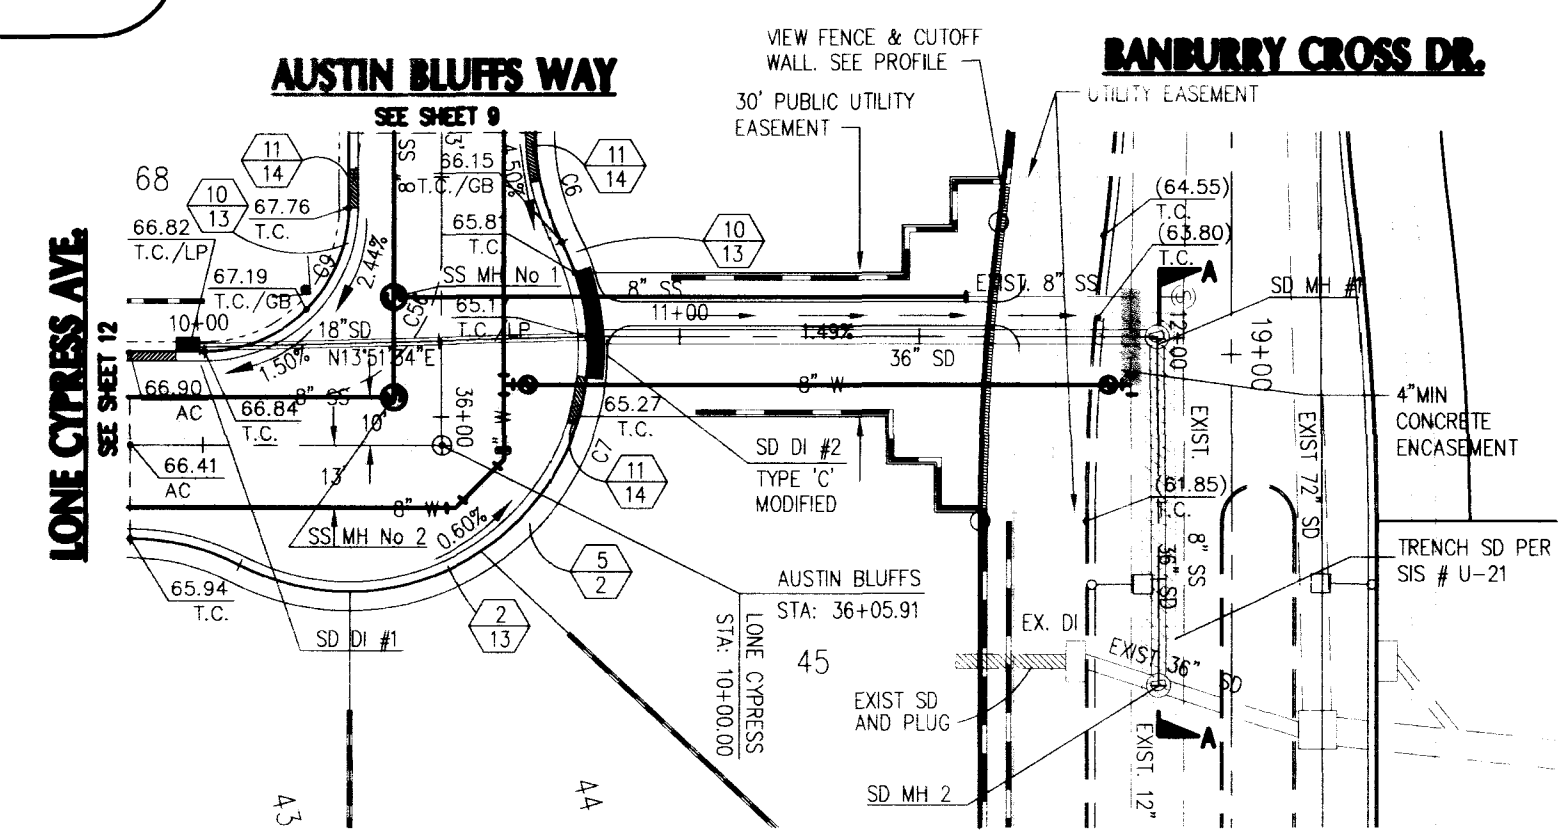


WOODLAND RIDGE WAY

(PUBLIC STREET)

UTILITY EASEMENT

(PUBLIC EASEMENT)

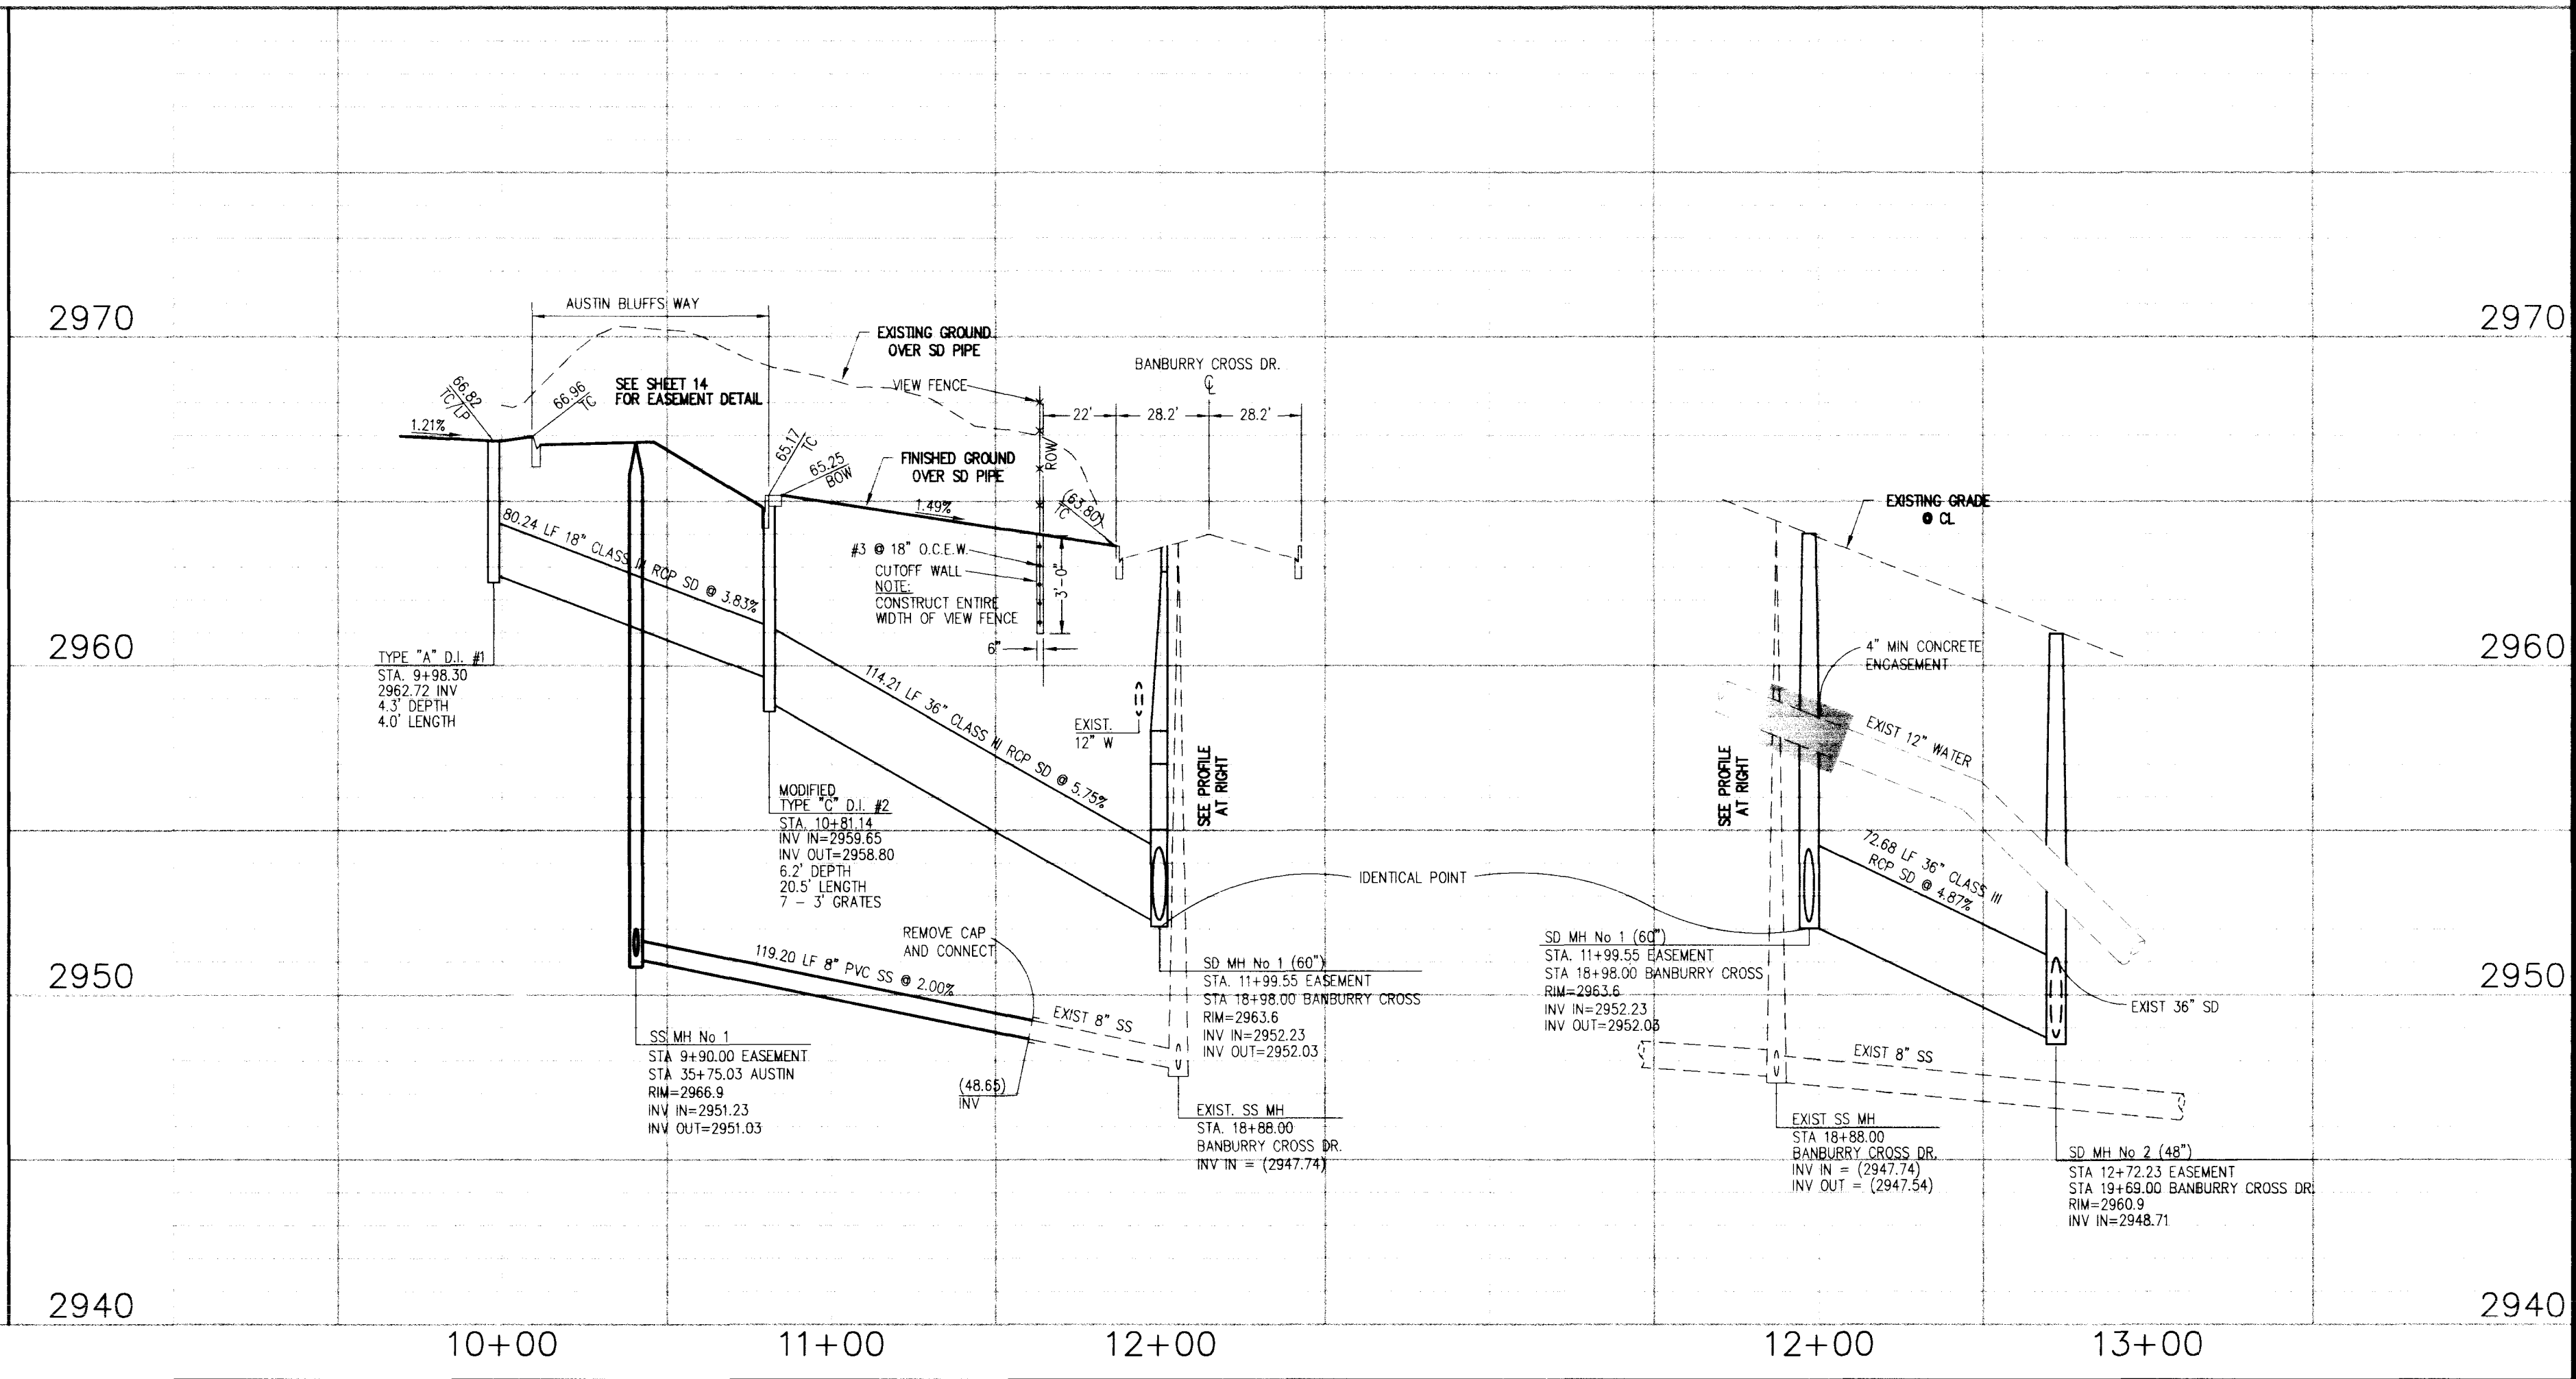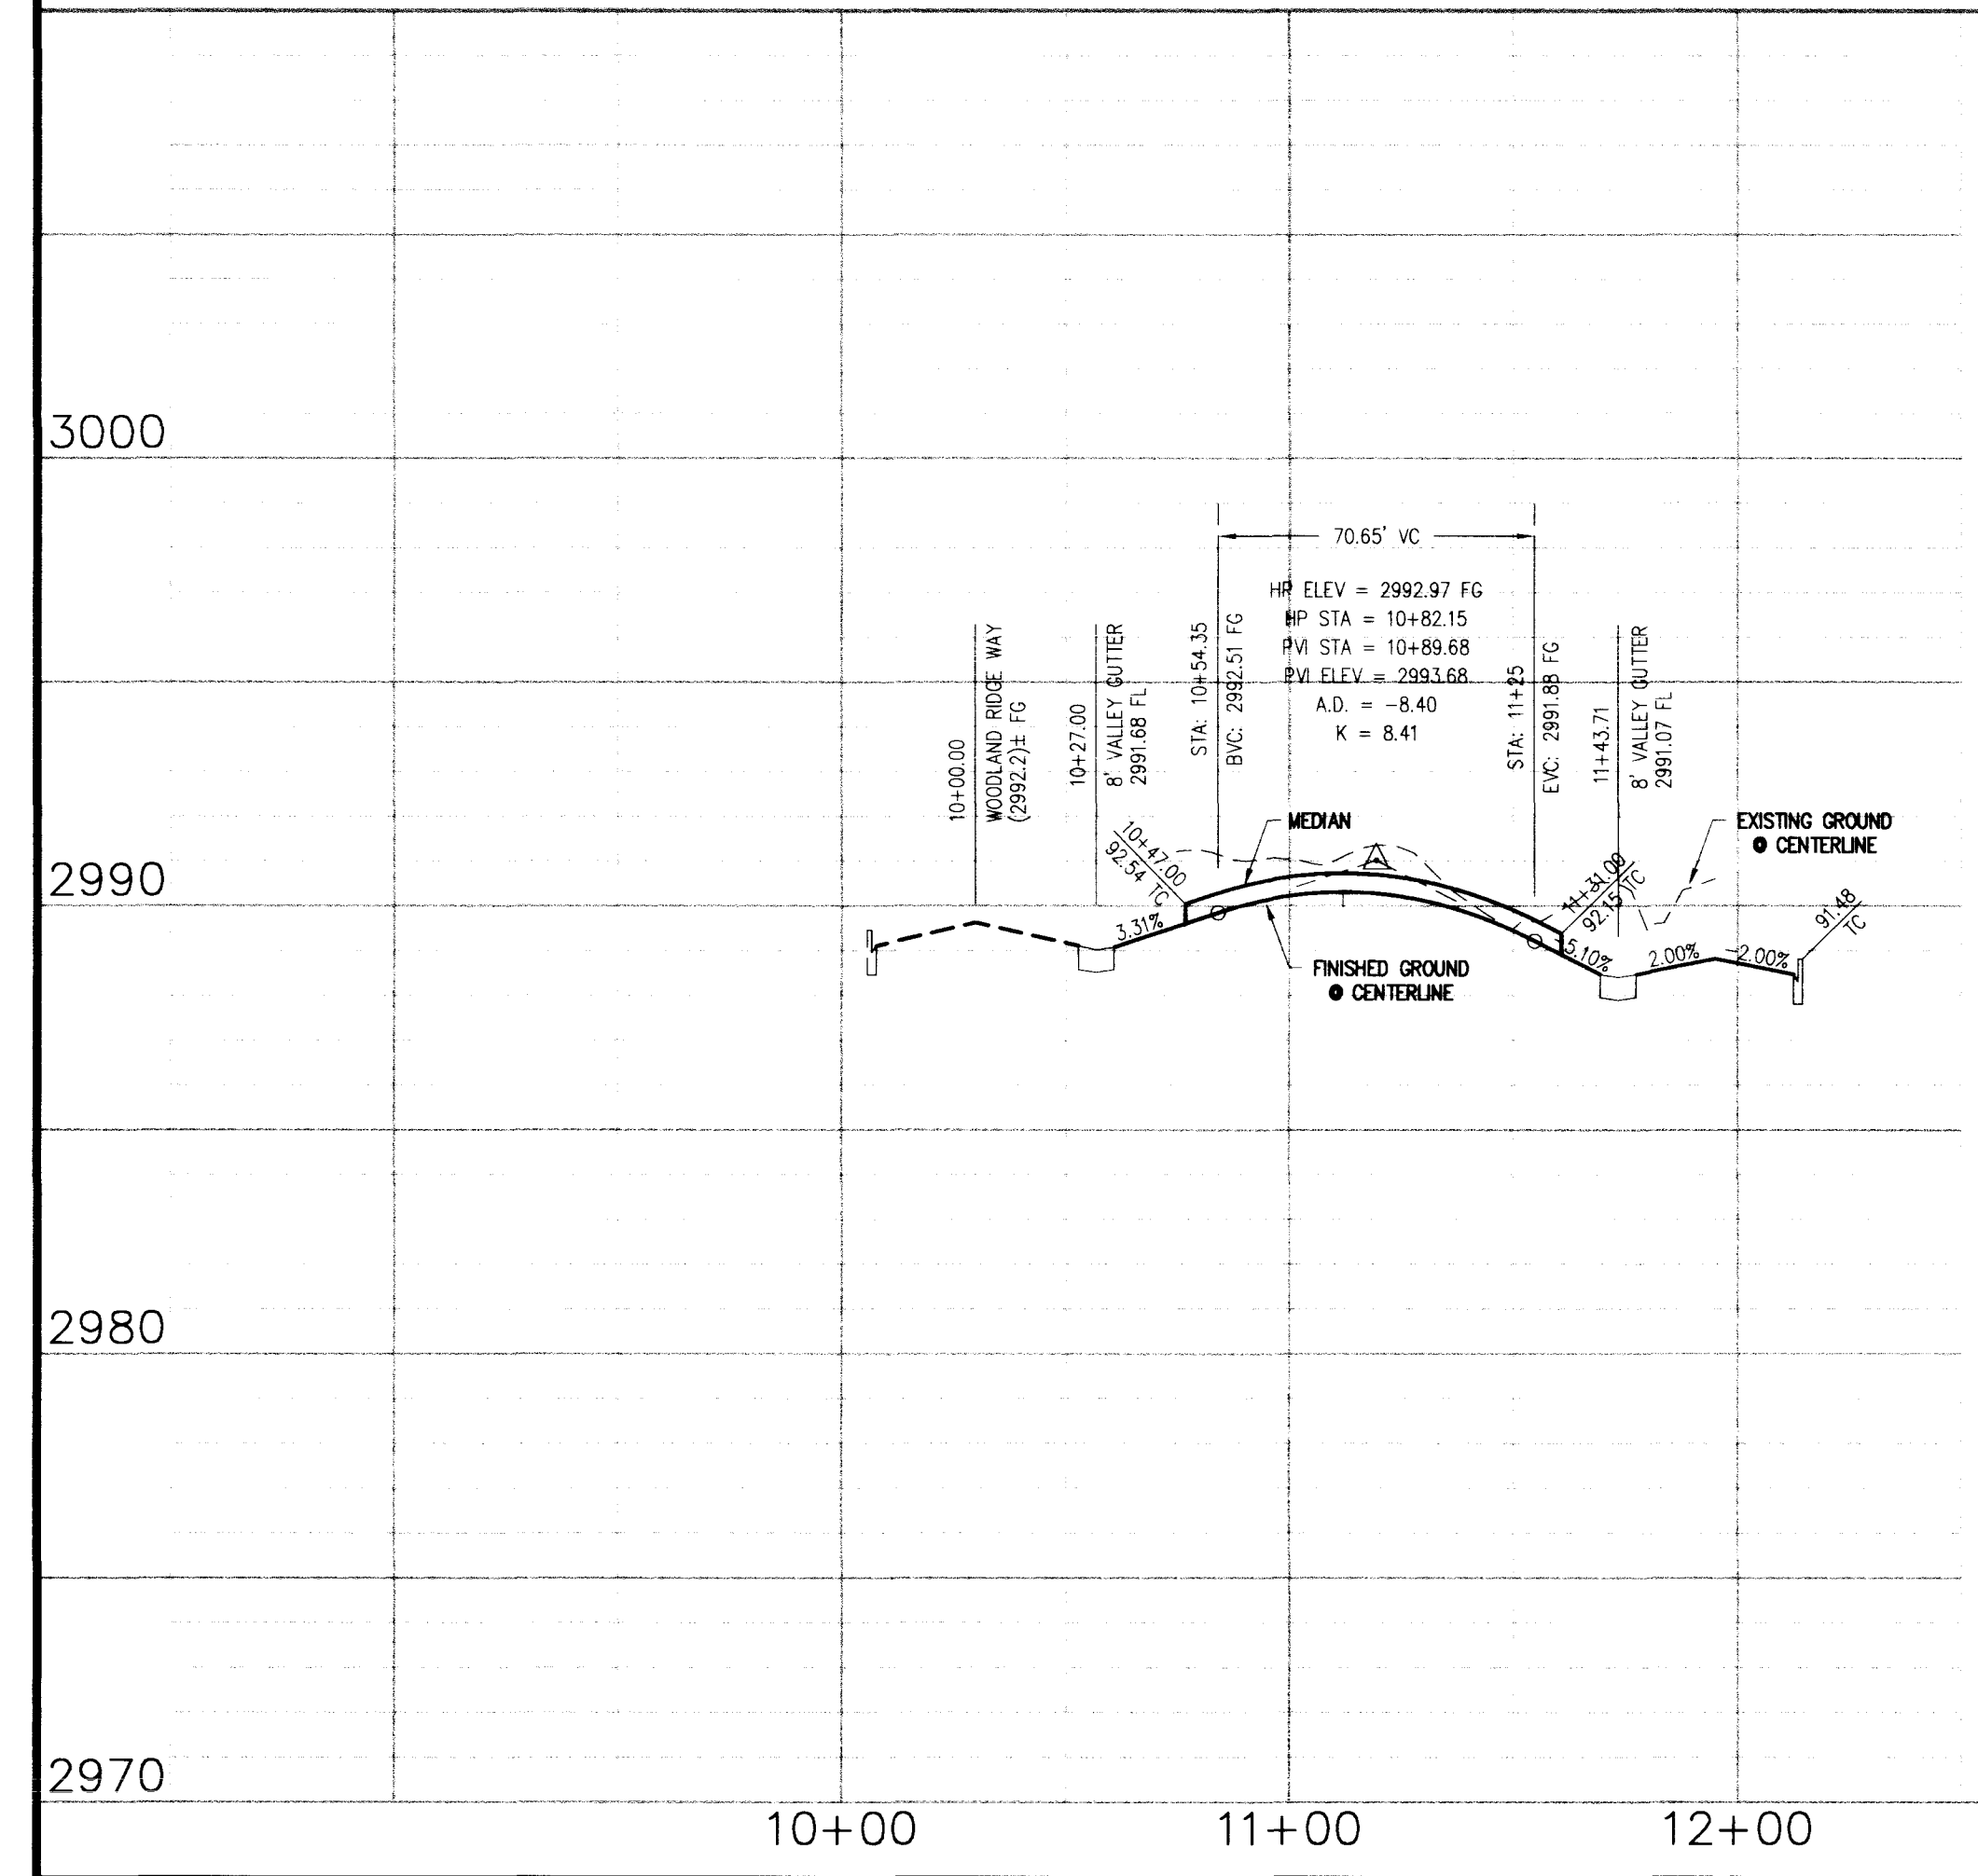

REVISIONS

No.	Date	By	Rev.	Reason
1	4/98	DL	1	MOVED STREETLIGHTS

DESIGNED: DL
DRAWN: DL
CHECKED: SW
JOB NO.: 971107010
HORIZ.: 1"=40'
VERT.: 1"=4'
DATE: 6/2/97

THE ARBORS
PARCEL H & I
WESTBROOK PHASE I
PLAN AND PROFILE

PROJECT: 8
SHEET: 8 OF 14

8355

1079-4541-1





