
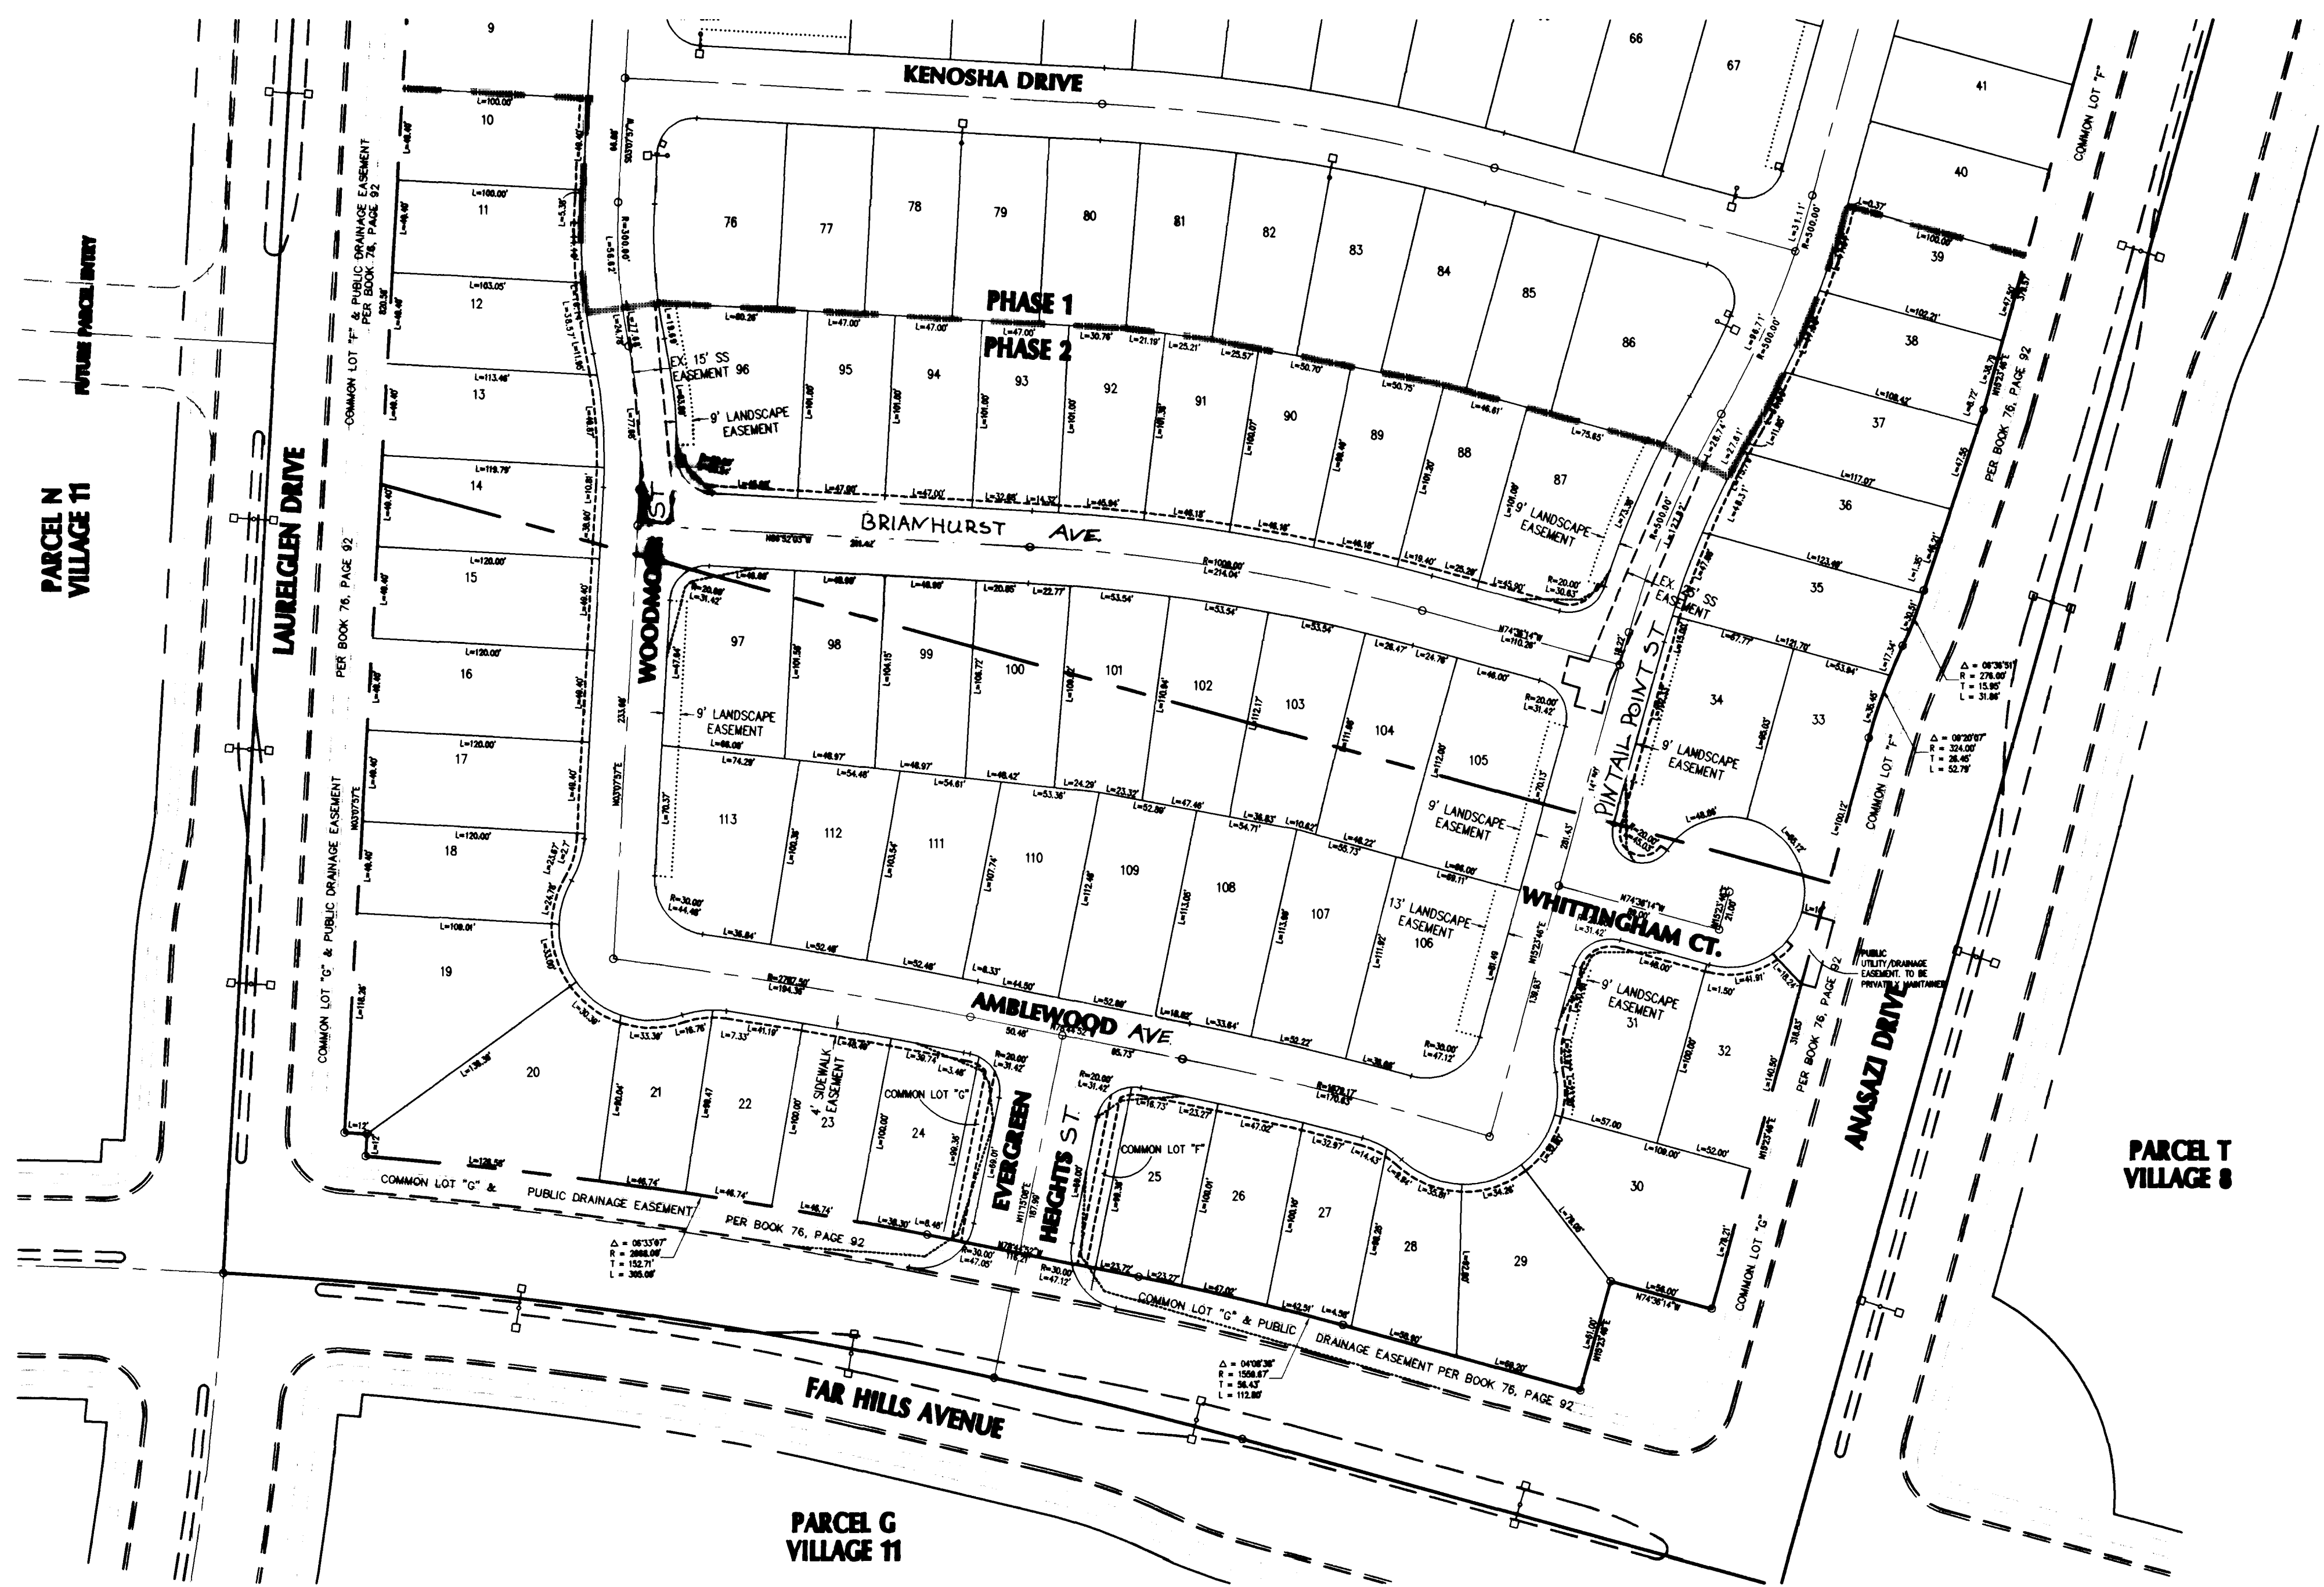
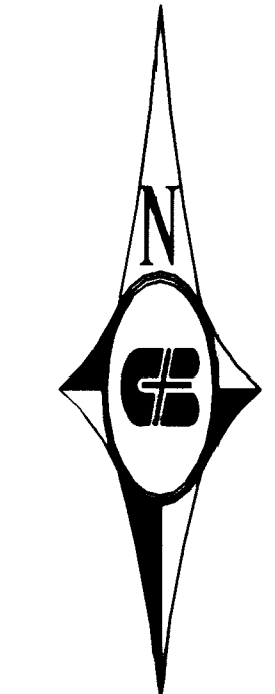


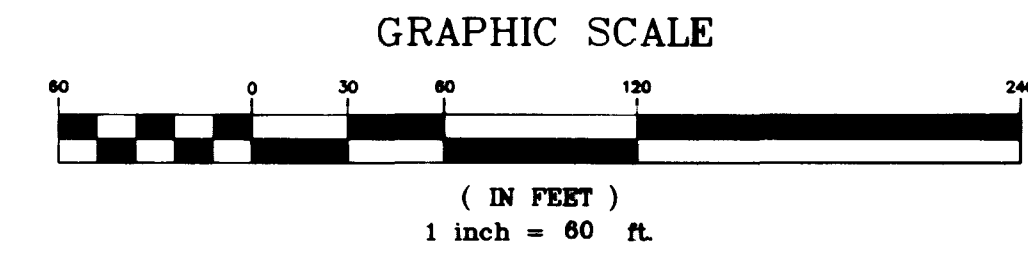

EASEMENT LEGEND

---	SIGHT VISIBILITY RESTRICTION EASEMENT
---	TEMPORARY SEWER EASEMENT
---	LANDSCAPE EASEMENT
---	SIDEWALK EASEMENT

NOTE:
THIS PLAN IS FOR REFERENCE
ONLY. REFER TO RECORDED
FINAL MAP FOR ALL STAKING.

BENCHMARK:
CITY OF LAS VEGAS BENCHMARK
OLV001954 RIVET & PLATE IN TOP OF CURB NW
SIDE OF TOWN CENTER DRIVE & SOUTH CIRCLE ISLAND
2728.37 NAVD 1988 DATUM (831.6074 M)

BASIS OF BEARINGS:
NORTH 15°23'46" EAST BEING THE BEARING OF THE
CENTERLINE OF ANASAZI DRIVE AS SHOWN BY MAP THEREOF
ON FILE IN BOOK 64, PAGE 67 OF PLATS IN THE CLARK
COUNTY RECORDER'S OFFICE, CLARK COUNTY, NEVADA.

PROJECT:	THE ARBORS	
	PARCEL H & I	
SHEET:	3	
	14	
DESCRIPTION:	WESTBROOK PHASE II	
	DIMENSION & EASEMENT PLAN	
DESIGNED:	DES	CS
	DRAWN:	CS
CHECKED:	CS	CS
	JOB NO:	97107010
HORIZ:	1"=40'	N/A
	VERT:	N/A
DATE:	8/11/97	
	Carter Burgess	
6855 Bermuda Road Las Vegas, NV 89119 (702) 938-5400 Fax (702) 938-5454		
REVISIONS		
No.	Date	CHD APPD

Avoid cutting underground
utility lines. It's costly.

Call before you Dig.

1-800-227-2600

UNDERGROUND SERVICE ALERT (USA)

SAFETY ALERT

Call before you Overhead

593-6111

OVERHEAD SERVICE ALERT

