



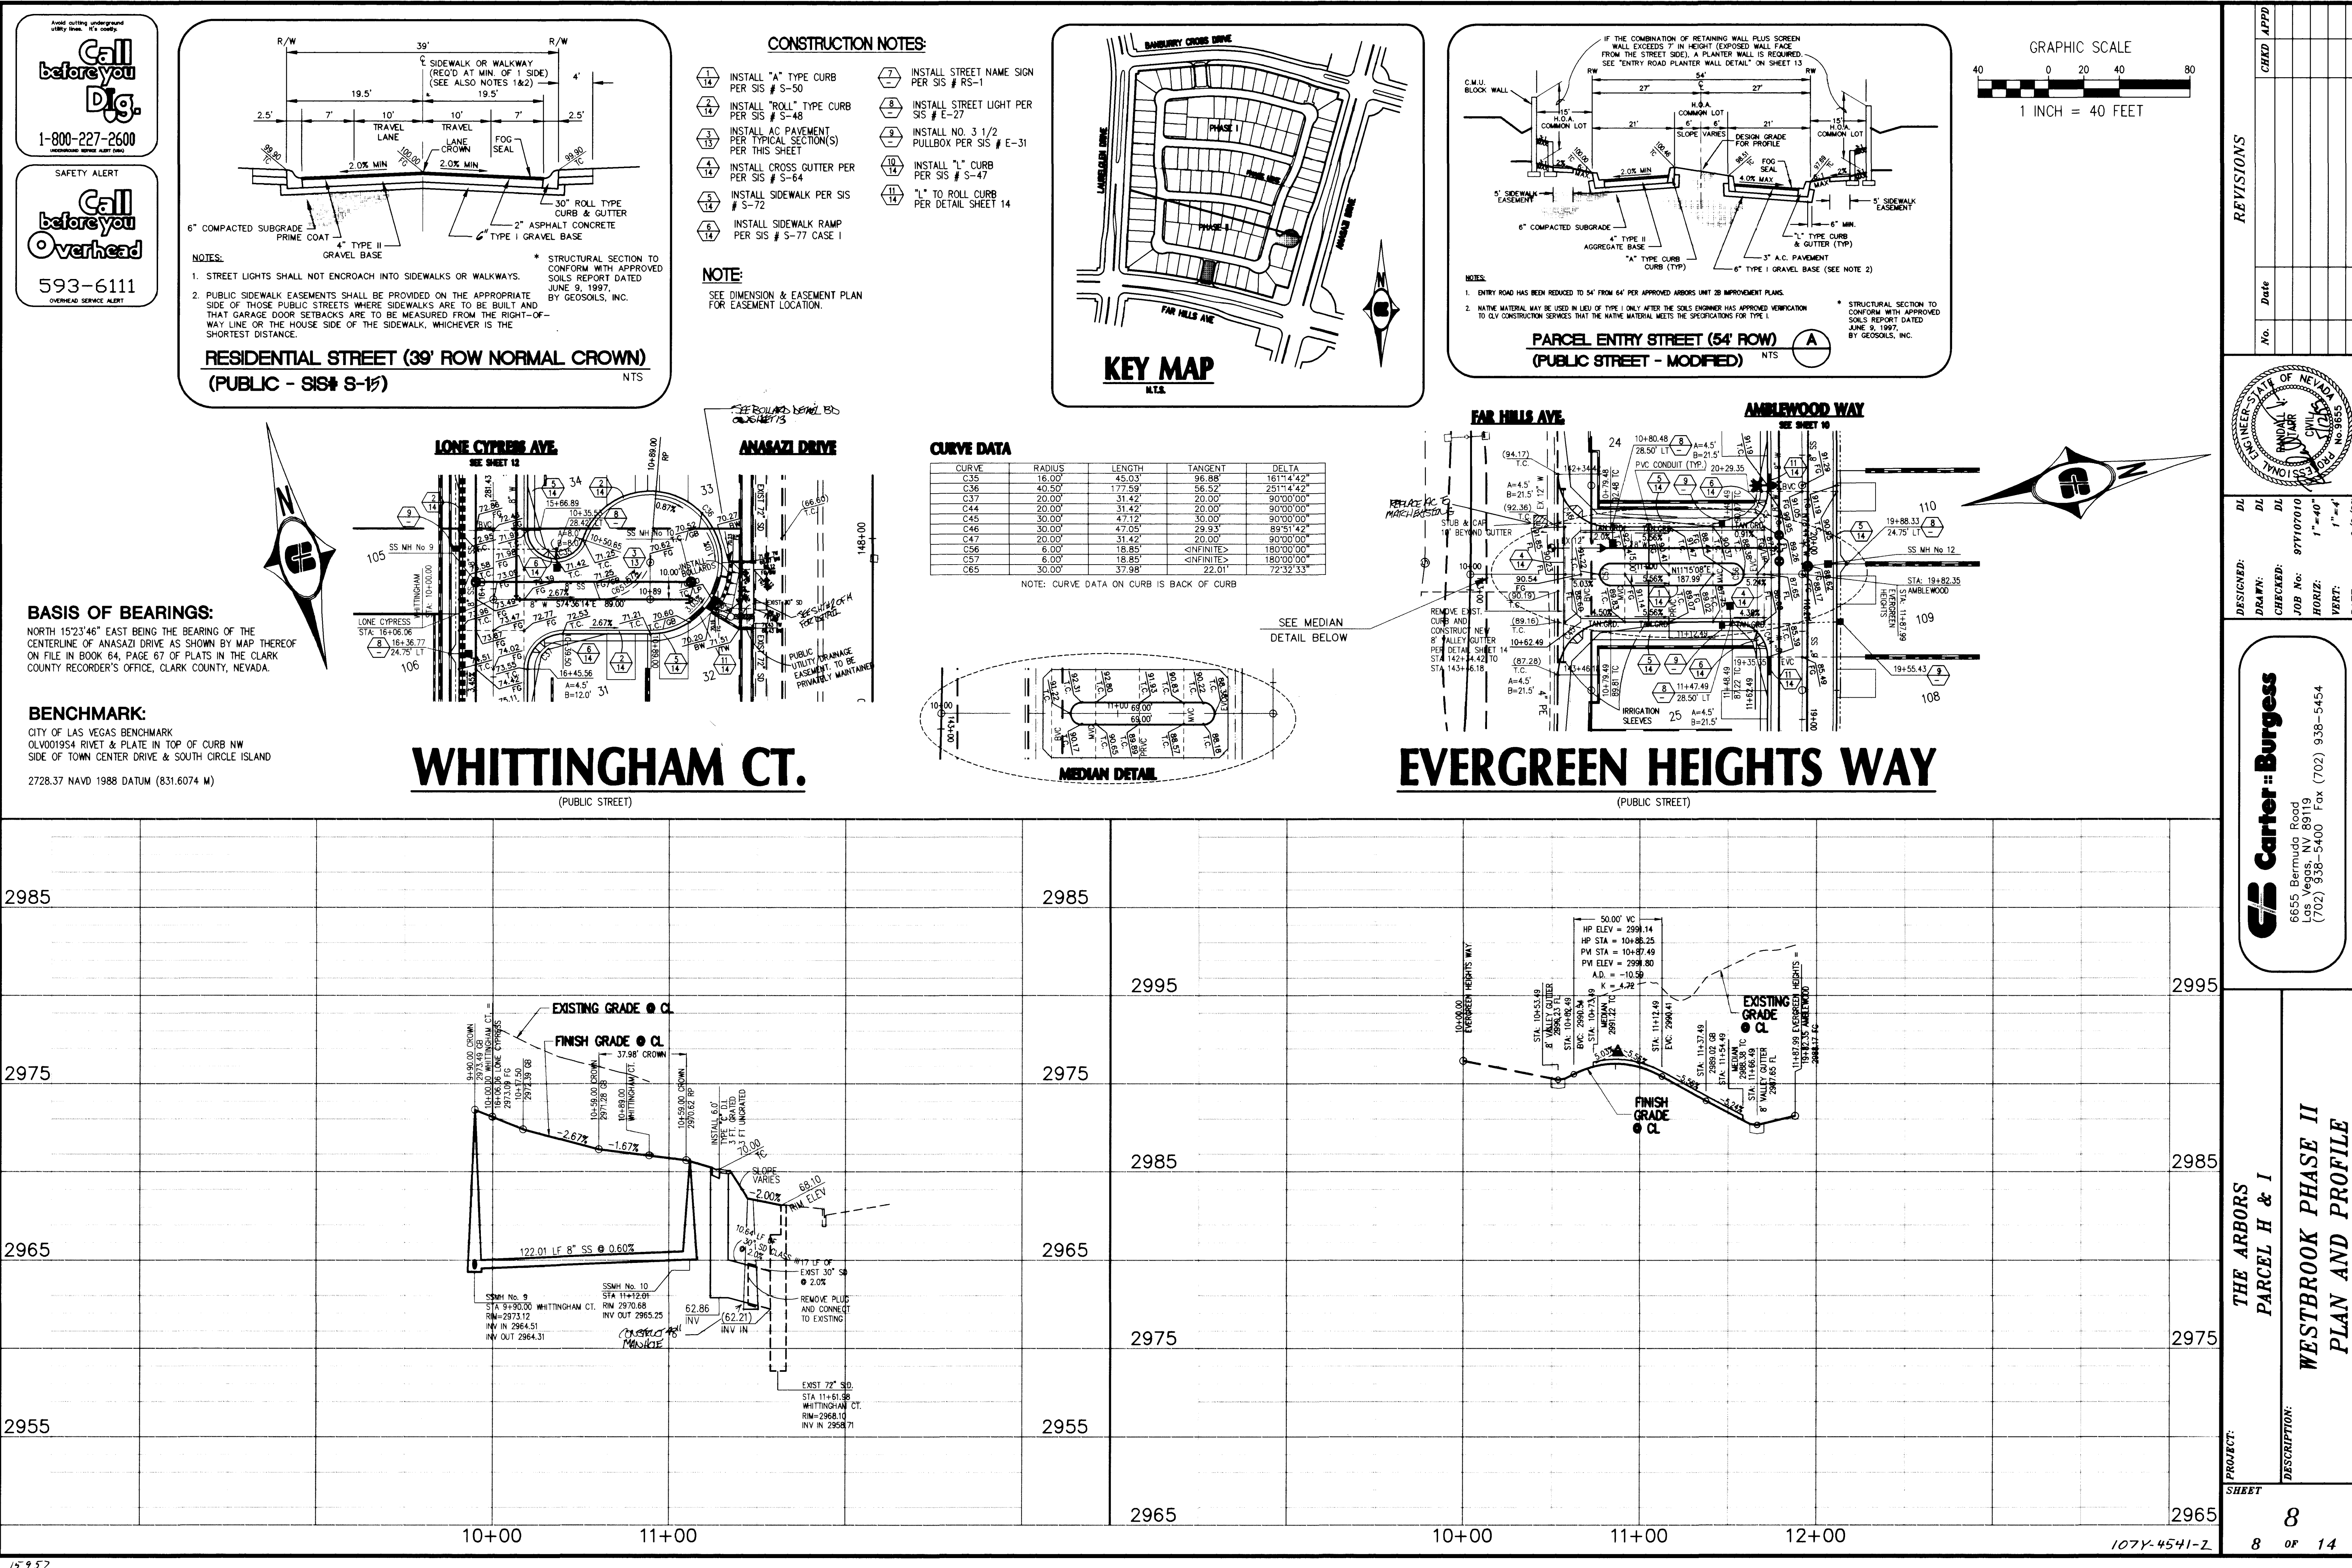


REVISIONS: APPD, CKD, Date, No.

DESIGNED: DL, DRAWN: DL, CHECKED: DL, JOB No: 97107010, HORIZ: 1"=40', VERT: 1"=4', DATE: 6/2/97

Carter Burgess, 6655 Bermuda Road, Las Vegas, NV 89119, (702) 938-5400 Fax (702) 938-5454

PROJECT: THE ARBORS PARCEL H & I, DESCRIPTION: WESTBROOK PHASE II PLAN AND PROFILE, SHEET: 8 OF 14

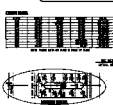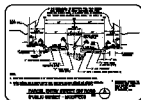




